

O.D.O.T. DISTRICT 2 SURVEY OFFICE (USE ONLY)

PERSONNEL

REFERENCE NO. 32 A

SHEET 16 OF 18

NOTES RHODES
H.C. NIESE
R.C. ASTON

DATE 11/27/23
WEATHER CLOUDY
TEMP. 30° F

ROUTE SR 49
COUNTY WILLIAMS
TOWNSHIP FLORENCE
SECTION 3
T 10 N R 4 E

DWG BY BARRIERE PID 114849

TYPE MONUMENT MAG/WASHER

ON SURFACE - BELOW ON

OFFSET Q PAVEMENT 1.2' LT

10' TO LT EDGE PAVEMENT

STATION: 778+78.37

HORIZ.DATUM: NAD83 (2011)


GEOID: 18

GRID: NORTHING: 722581.971


EASTING: 1349018.650

LDP: NORTHING: _____

EASTING: _____

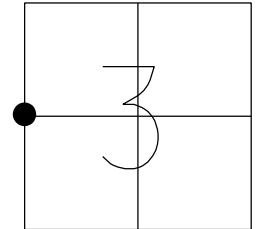

RECORD:
SET SM.R.R.SPIKE
7/6/88, IRS
FD R.R.SPIKE
2" DOWN
5/20/97, MB
FD SQ.HEADED
SM.R.R.SPIKE
REF33
2/8/11
FD R.R.SPIKE
2" DOWN
5/11/12, MC
SET MAG/WASHER
9/12/12, SAH
FD MAG/WASHER
REF33
10/27/14, EBW
FD MAG/WASHER
NEWREF33
7/28/22,
3/8/23, JMR
FD MAG/WASHER
REF33, 11/27/23-TDN

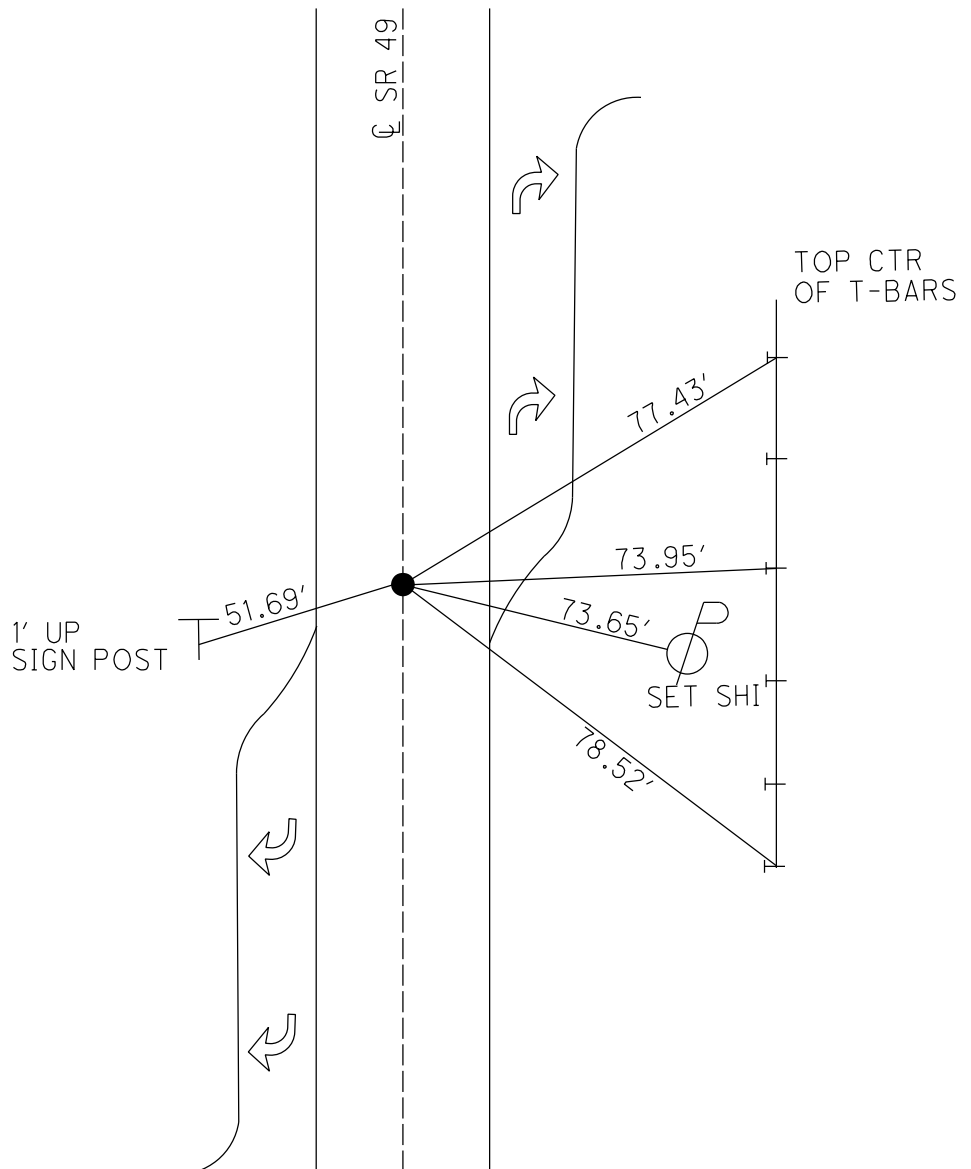

O.D.O.T. DISTRICT 2 SURVEY OFFICE (USE ONLY)

PERSONNEL

REFERENCE NO. 33

SHEET 16 OF 18

NOTES RHOADES

DATE 7/28/22

ROUTE SR 49

H.C. RHOADES

WEATHER CLOUDY

COUNTY WILLIAMS

R.C. WHITAKER

TEMP. 75°

TOWNSHIP NORTHWEST

DWG BY RHOADES

PID PAVETRAIN

SECTION 3

T 10 N R 4 E

TYPE MONUMENT MAG/WASHER

ON SURFACE - ~~BELOW~~ ON

OFFSET Q PAVEMENT ON LT : RT

10' TO LT EDGE PAVEMENT


STATION: 778+78.37

HORIZ.DATUM: NAD83 2011

GEOID: NAVD88 2018


GRID: NORTHING: 722581.971

EASTING: 1349018.650

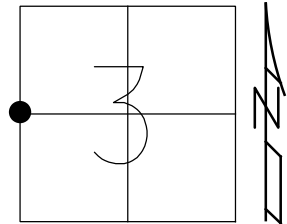

RECORD:
SET SM.R.R.SPIKE
7/6/88, IRS
FD R.R.SPIKE
2" DOWN
5/20/97, MB
FD SQ.HEADED
SM.R.R.SPIKE
REF33
2/8/11
FD R.R.SPIKE
2" DOWN
5/11/12, MC
SET MAG/WASHER
9/12/12, SAH
FD MAG/WASHER
REF33
10/27/14, EBW
FD MAG/WASHER
NEWREF33
7/28/22,
3/8/23, JMR

Q SR 49

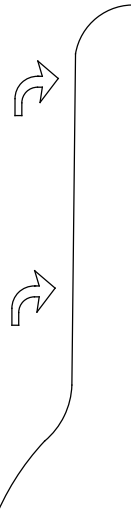

O.D.O.T. DISTRICT 2 SURVEY OFFICE (USE ONLY)

PERSONNEL

REFERENCE NO. 33

SHEET 16 OF 18

NOTES HUSS

DATE 5/11/12

ROUTE SR 49

H.C. HUSS

WEATHER CLEAR/FAIR

COUNTY WILLIAMS

R.C. CANTERBURY

TEMP. 63°

TOWNSHIP NORTHWEST

DWG BY WHITAKER PID 98653

SECTION 3

T 10 N R 4 E

TYPE MONUMENT R.R. SPIKE

~~ON SURFACE~~ - BELOW 2"

OFFSET Q PAVEMENT ON LT : RT

10' TO LT EDGE PAVEMENT


STATION: 778+78.37

HORZ.DATUM: NAD83 2011

GEOID: NAVD88 2012A

GRID: NORTHING: 722581.929

EASTING: 1349018.641

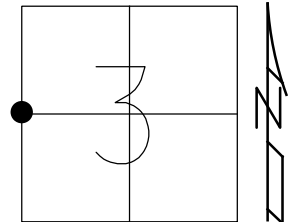

RECORD:
SET SM.R.R.SPIKE
7/6/88, IRS
FD R.R.SPIKE
2" DOWN
5/20/97, MB
FD SQ.HEADED
SM.R.R.SPIKE
REF33
2/8/11
SET MAG/WASHER
9/12/12, SAH
FD MAG/WASHER
REF33
10/27/14, EBW

CUT "+" IN
DRIVE RCP

Q SR 49

47.15'
22.93'

31.34'

FD CUT NOTCH
1.3' UP
I-BEAM SIGN POST

FD CUT NOTCH
1.3' UP
SIGN POST
55 MPH

80.41'

O.D.O.T. DISTRICT 2 SURVEY OFFICE (USE ONLY)

PERSONNEL _____ REFERENCE NO. 33 SHEET 16 OF 18
 NOTES HUSS DATE 5/11/12 ROUTE SR 49
 H.C. HUSS WEATHER CLEAR/FAIR COUNTY WILLIAMS
 R.C. CANTERBURY TEMP. 63° TOWNSHIP NORTHWEST
 _____ SECTION 3
 _____ T 10 S R 4 W

TYPE MONUMENT R.R.SPIKE


~~ON SURFACE~~ - BELOW 2"

LEFT - ℄ PAV'T - RIGHT ON


10.0' TO LT EDGE PAVEMENT

S.L.M. 778+78.50

Grid: Northing: 722582.093 Easting: 1349018.619

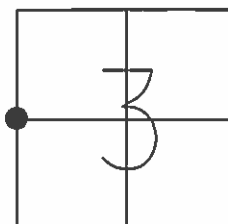

CUT "+" IN
BOTH ENDS
OF CONC.
DRIVE PIPE

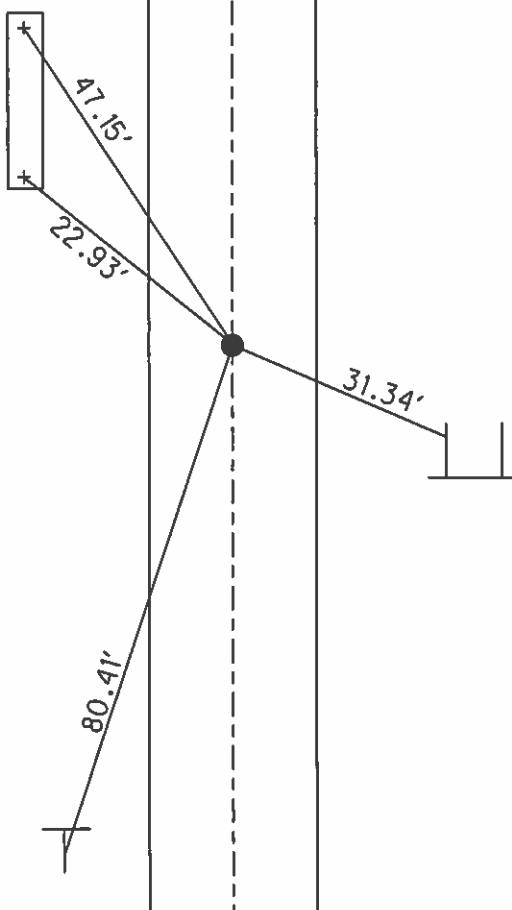

SET SM.R.R.SPIKE
7/6/88, IRS

FD R.R.SPIKE
2" BELOW
5/20/97, MB

FD SQ.HEADED
SM.R.R.SPIKE
GPS, REF33
2/8/11

SET MAG/WASHER
9/12/12, SAH

FD CUT NOTCH
IN W.LEG I-BEAM
SIGN POST. 1.3' UP

FD CUT NOTCH
1.3' UP SIGN POST
55 MPH