

O.D.O.T. DISTRICT 2 SURVEY OFFICE (USE ONLY)

PERSONNEL

REFERENCE NO. 1

SHEET 1 OF 15

NOTES RHOADES

DATE 7-29-14

ROUTE SR 18

H.C. RHOADES

WEATHER CLEAR

COUNTY WOOD

R.C. MEYER

TEMP. 53°F

TOWNSHIP BARTLOW

SECTION 19

DWG BY MAHLER

PID

T 3 N R 8 E

TYPE MONUMENT LG. RR. SPIKE

~~ON SURFACE~~ - BELOW 0.2'

OFFSET $\varnothing$ PAVEMENT - LT : RT

- TO - EDGE PAVEMENT


STATION: 0+00

HORZ.DATUM: NAD83 (2011)


GEOID: NAVD88-2012A

GRID: NORTHING: 563192.821

EASTING: 1588313.060

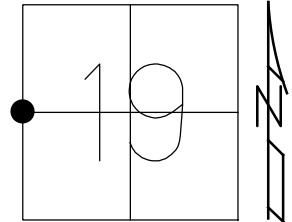

RECORD:
FD LG. RR. SPIKE
4-6-05, DCH
NEWREF1
7-29-14, JMR
FD LG.R.R.SPIKE
9-2-15, DCH

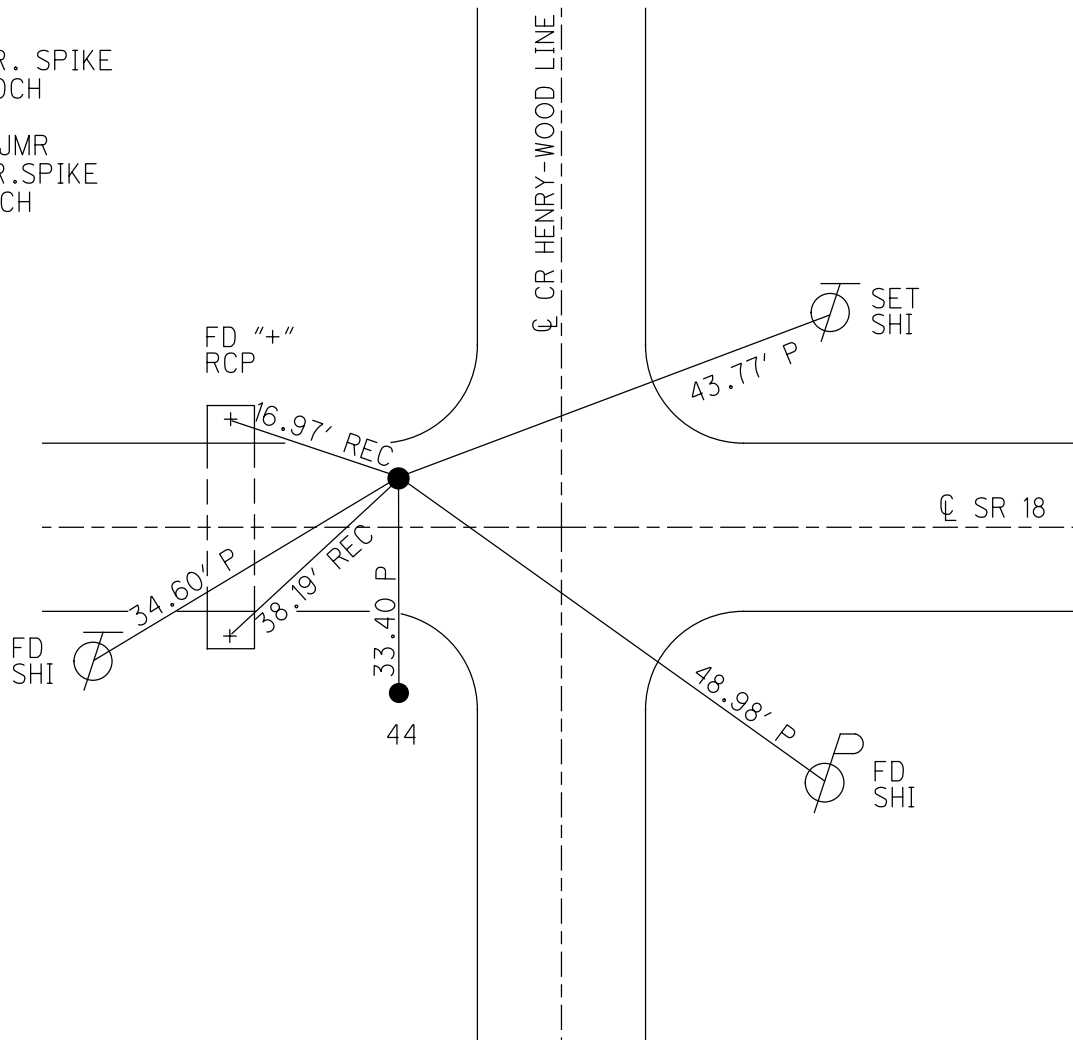

O.D.O.T. DISTRICT 2 SURVEY OFFICE (USE ONLY)

PERSONNEL

REFERENCE NO. 2

SHEET 2 OF 15

NOTES RHOADES

DATE 6-12-20

ROUTE SR 18

H.C. AUBLE

WEATHER SUNNY

COUNTY WOOD

R.C. MAHLER

TEMP. 66°F

TOWNSHIP JACKSON

O'DONNELL

SECTION 19

DWG BY MAHLER

PID PAVE TRAIN

T 3 N R 9 E

TYPE MONUMENT MAG/WASHER

ON SURFACE - ~~BELOW~~ ON

OFFSET CL PAVEMENT 4.3' LT : RT

5.4' TO RT EDGE PAVEMENT


STATION: 28+00

HORIZ.DATUM: NAD83 (2011)


GEOID: NAVD88-2012A

GRID: NORTHING: 563182.308

EASTING: 1591109.130

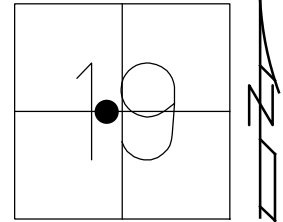

RECORD:
SET MAG/WASHER
7-25-05, DCH
FD MAG NAIL
REF2
9-2-15, DCH
FD MAG/WASHER
REF2
6-12-20
9-16-21, JFO

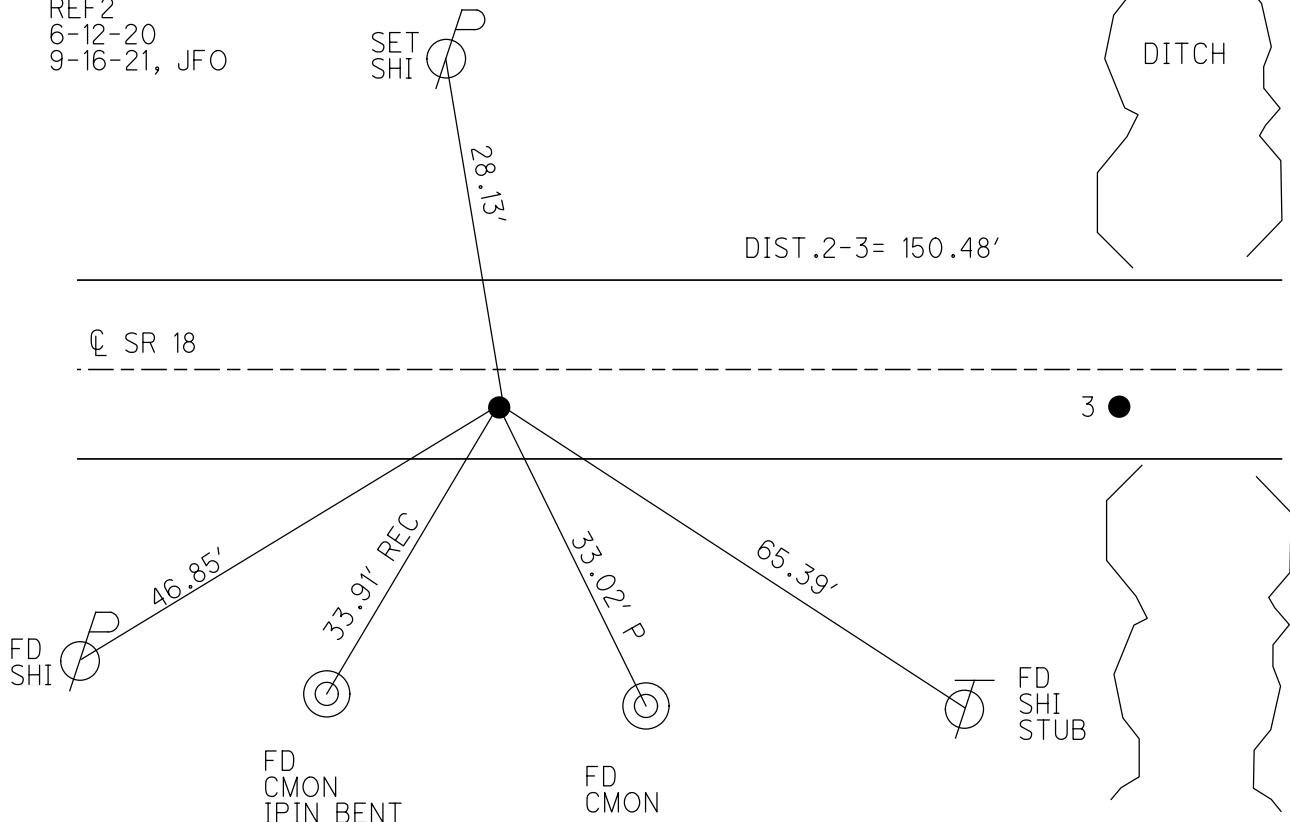

O.D.O.T. DISTRICT 2 SURVEY OFFICE (USE ONLY)

PERSONNEL

REFERENCE NO. 3

SHEET 3 OF 15

NOTES HUSS

DATE 4-6-05

ROUTE SR 18

H.C. HOMAN

WEATHER SUNNY

COUNTY WOOD

R.C. JOE

TEMP. 67°F

TOWNSHIP JACKSON

SECTION 19

DWG BY MAHLER

PID PAVE TRAIN

T 3 N R 9 E

TYPE MONUMENT P.K./WASHER

ON SURFACE - ~~BELOW~~ ON

OFFSET Q PAVEMENT 4.3' ~~LT~~ : RT

5.4' TO RT EDGE PAVEMENT


STATION: 29+50

HORZ.DATUM: -

GEOID: -

GRID: NORTHING: -

EASTING: -

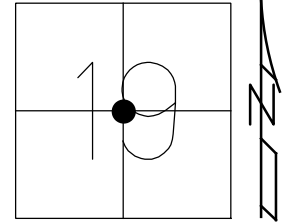

RECORD:


DNF

NEW CULVERT
7-25-05, DCH

DNF

6-12-20

9-16-21, JFO

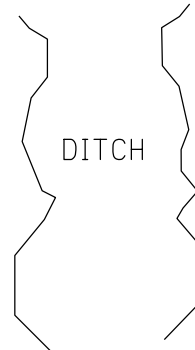


DIST.2-3= 150.48'

Q SR 18

2A ●

FD
SHI
STUB

91.49' REC

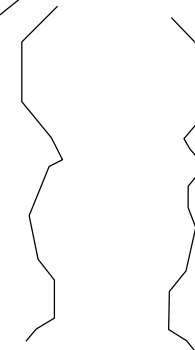

O.D.O.T. DISTRICT 2 SURVEY OFFICE (USE ONLY)

PERSONNEL

REFERENCE NO. 4

SHEET 4 OF 15

NOTES RHOADES

DATE 6-12-20

ROUTE SR 18

H.C. AUBLE

WEATHER SUNNY

COUNTY WOOD

R.C. MAHLER

TEMP. 66°F

TOWNSHIP JACKSON

O'DONNELL

SECTION 19

DWG BY MAHLER

PID PAVE TRAIN

T 3 N R 9 E

TYPE MONUMENT MAG/WASHER

ON SURFACE - ~~BELOW~~ ON

OFFSET CL PAVEMENT 18.2' ~~LT~~ : RT

- TO - EDGE PAVEMENT


STATION: 56+09

HORZ.DATUM: NAD83 (2011)

GEOID: NAVD88-2012A

GRID: NORTHING: 563168.439

EASTING: 1593906.314

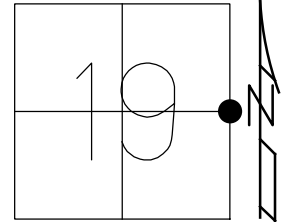

RECORD:

FD P.K.NAIL

ATOP P.K./WASHER

1.5" DOWN

ATOP LG.RR.SPIKE

3" DOWN

ATOP STONE

10.5" DOWN

SET MAG/WASHER

7-25-05, DCH

FD MAG/WASHER

REF3


9-02-15, DCH

FD MAG/WASHER

REF4

6-12-20

9-16-21, JFO

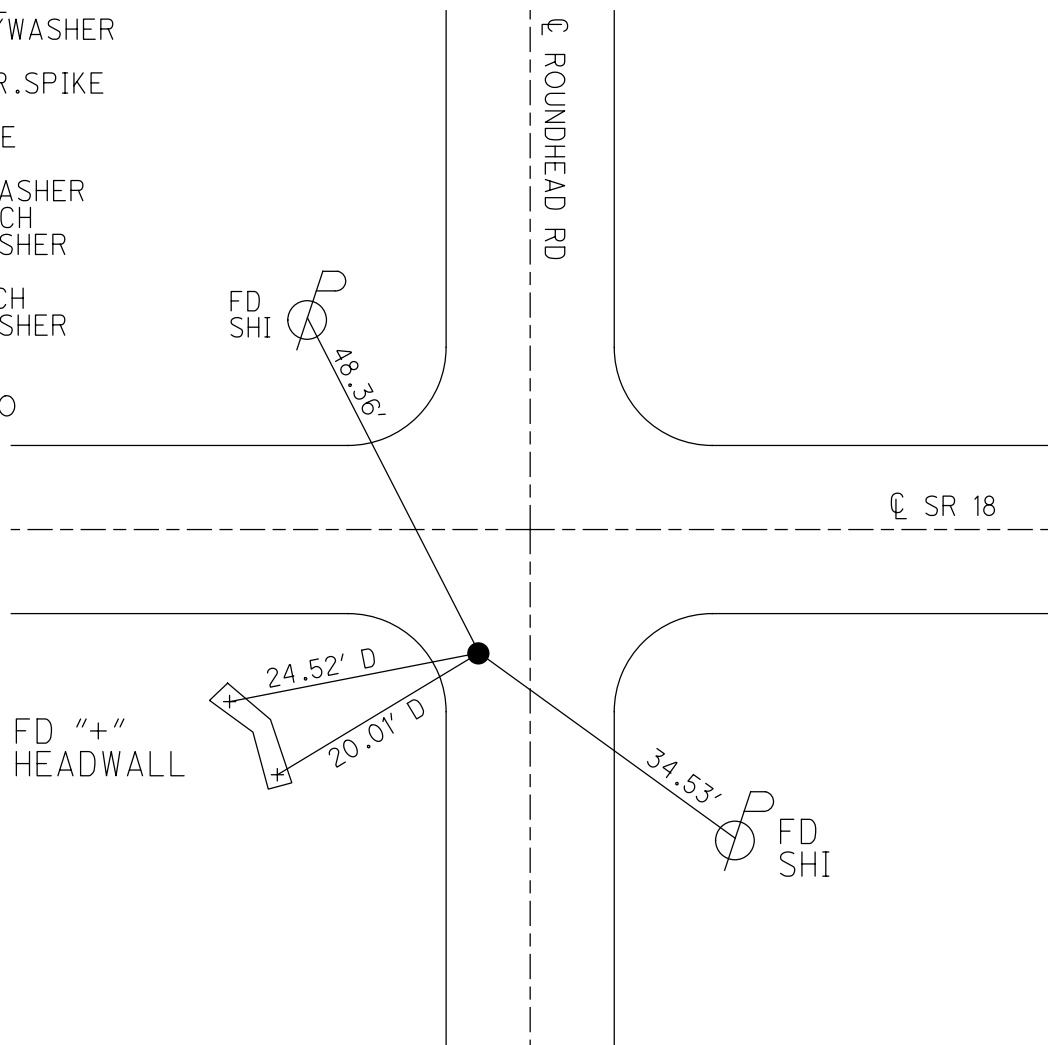

O.D.O.T. DISTRICT 2 SURVEY OFFICE (USE ONLY)

PERSONNEL

REFERENCE NO. 5

SHEET 5 OF 15

NOTES RHOADES

DATE 6-12-20

ROUTE SR 18

H.C. AUBLE

WEATHER SUNNY

COUNTY WOOD

R.C. MAHLER

TEMP. 66°F

TOWNSHIP JACKSON

O'DONNELL

SECTION 20

DWG BY MAHLER

PID PAVE TRAIN

T 3 N R 9 E

TYPE MONUMENT MAG/WASHER

ON SURFACE - ~~BELOW~~ ON

OFFSET CL PAVEMENT 6.6' ~~LT~~ : RT

3.1' TO RT EDGE PAVEMENT



STATION: 82+62

HORIZ.DATUM: NAD83 (2011)

GEOID: NAVD88-2012A

GRID: NORTHING: 563154.306

EASTING: 1596559.680

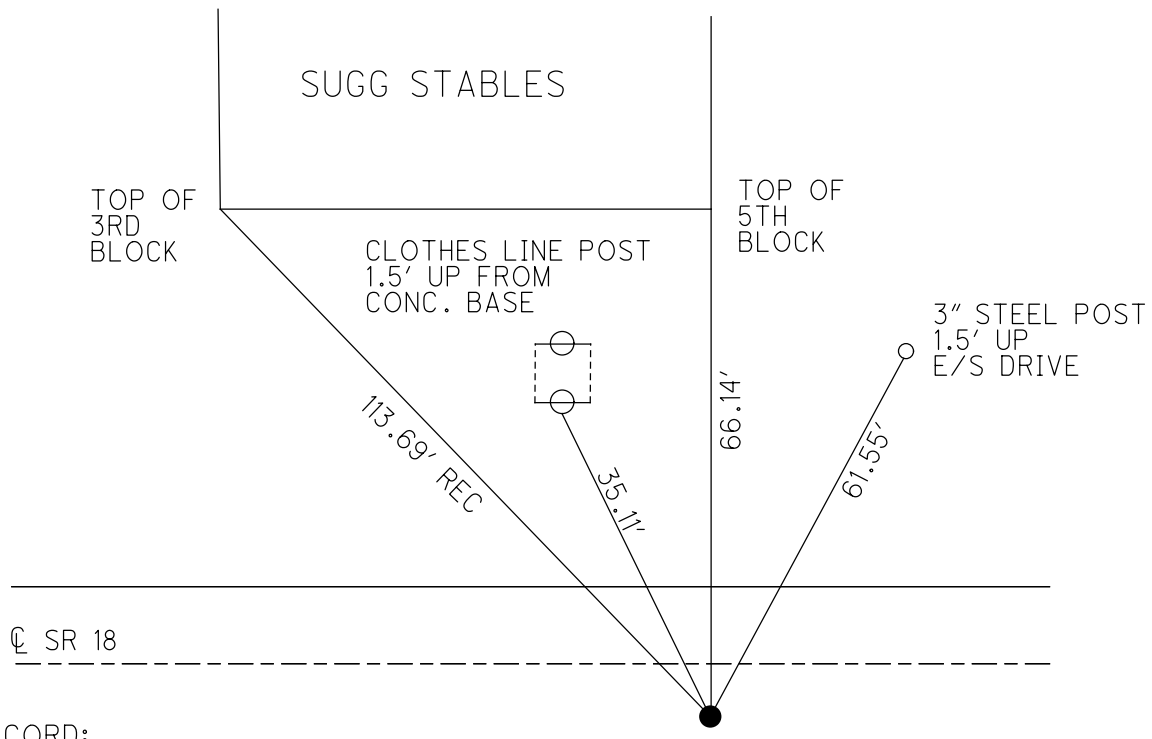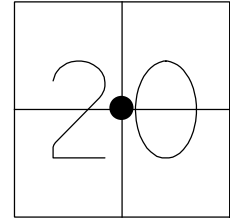

RECORD:
FD SM.R.R.SPIKE
4" DOWN
SET MAG/WASHER
6-29-05, DCH
REF4
9-04-15, DCH
FD MAG/WASHER
REF5
6-12-20, JFO
SET MAG/WASHER
NEWREF5
9-16-21, JFO

O.D.O.T. DISTRICT 2 SURVEY OFFICE (USE ONLY)

PERSONNEL

REFERENCE NO. 6

SHEET 6 OF 15

NOTES RHOADES

DATE 6-12-20

ROUTE SR 18

H.C. AUBLE

WEATHER SUNNY

COUNTY WOOD

R.C. MAHLER

TEMP. 66°F

TOWNSHIP JACKSON

O'DONNELL

SECTION 20

DWG BY MAHLER PID PAVE TRAIN

T 3 N R 9 E

TYPE MONUMENT MAG/WASHER

ON SURFACE - ~~BELOW~~ ON

OFFSET $\varnothing$ PAVEMENT 0.3' LT : RT

- TO - EDGE PAVEMENT


STATION: 108+86

HORIZ.DATUM: NAD83 (2011)


GEOID: NAVD88-2012A

GRID: NORTHING: 563140.467

EASTING: 1599181.257

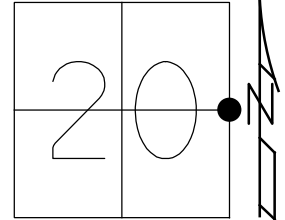

RECORD:
FD LG.R.R.SPIKE
3.5" DOWN
SET MAG/WASHER
7-25-05, DCH
REF5
9-04-15
FD MAG/WASHER
REF6
6-12-20
9-16-21, JFO

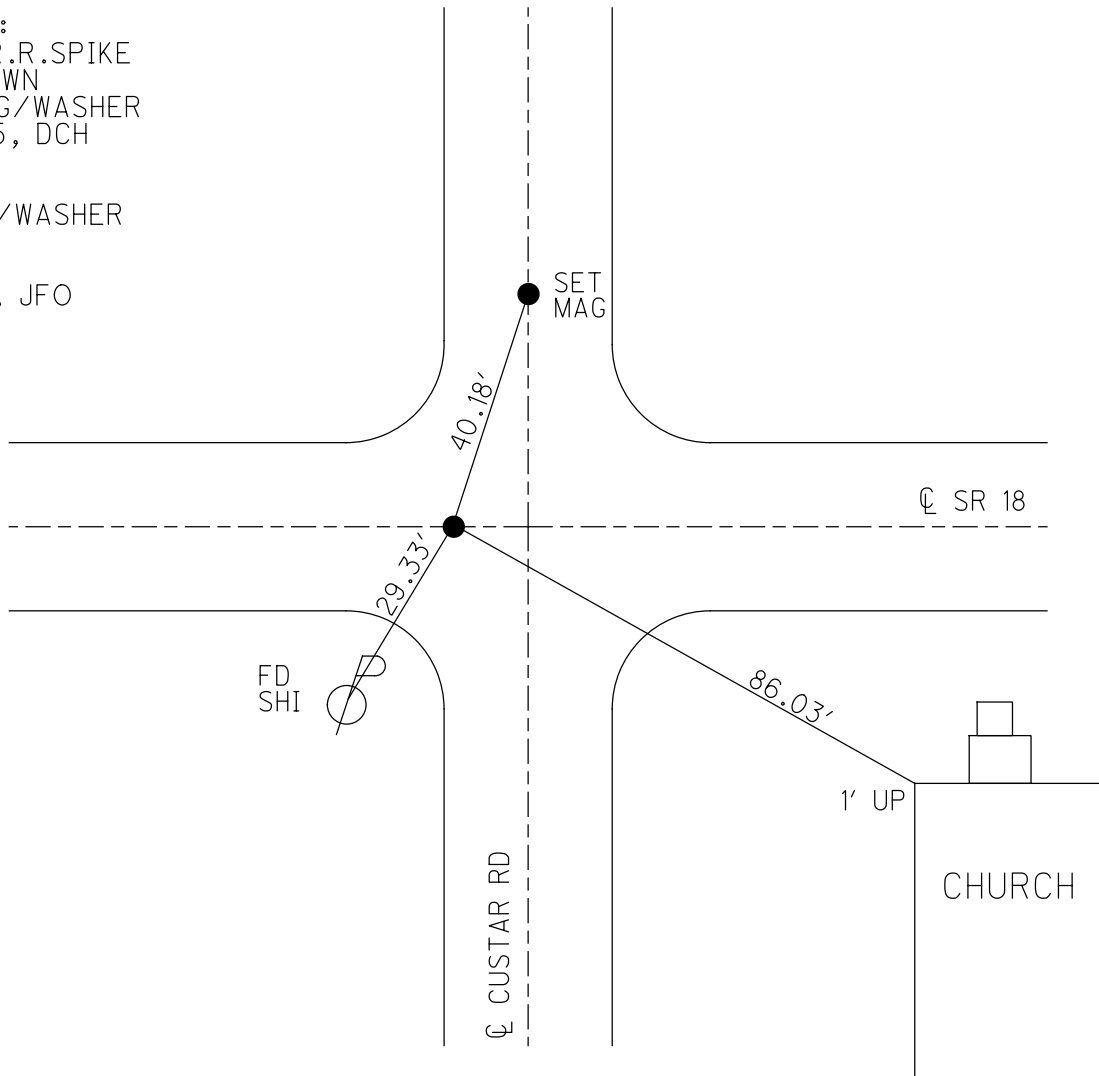

O.D.O.T. DISTRICT 2 SURVEY OFFICE (USE ONLY)

PERSONNEL

REFERENCE NO. 7

SHEET 7 OF 15

NOTES RHOADES

DATE 6-12-20

ROUTE SR 18

H.C. AUBLE

WEATHER SUNNY

COUNTY WOOD

R.C. MAHLER

TEMP. 66°F

TOWNSHIP JACKSON

O'DONNELL

SECTION 21

DWG BY MAHLER

PID PAVE TRAIN

T 3 N R 9 E

TYPE MONUMENT MAG/WASHER

ON SURFACE - ~~BELOW~~ ON

OFFSET CL PAVEMENT 11.4" ~~LT~~ : RT

0.7' TO RT EDGE PAVEMENT



STATION: 135+39

HORIZ.DATUM: NAD83 (2011)

GEOID: NAVD88-2012A

GRID: NORTHING: 563094.399

EASTING: 1601844.840

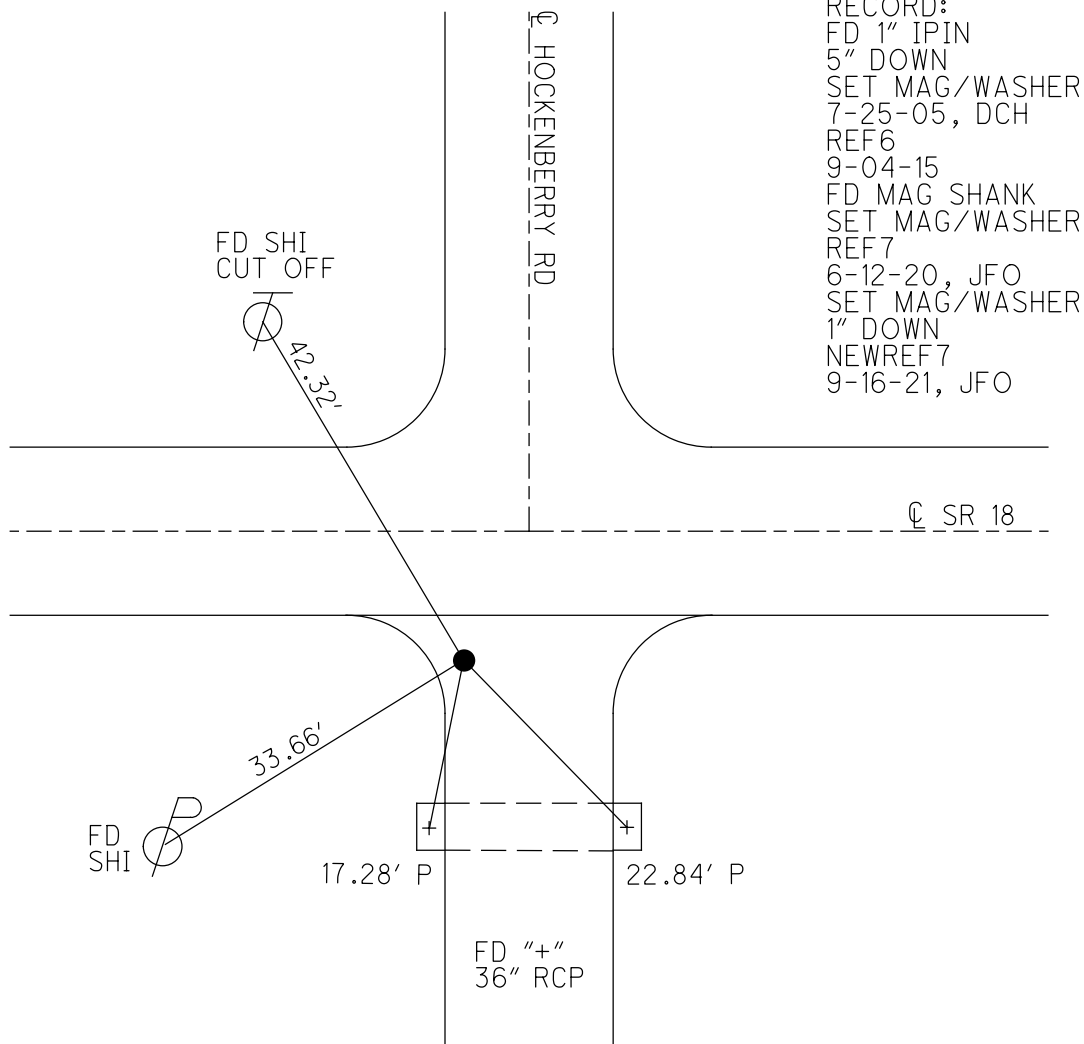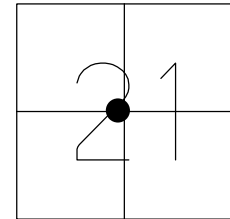

RECORD:
FD 1" IPIN
5" DOWN
SET MAG/WASHER
7-25-05, DCH
REF6
9-04-15
FD MAG SHANK
SET MAG/WASHER
REF7
6-12-20, JFO
SET MAG/WASHER
1" DOWN
NEWREF7
9-16-21, JFO

O.D.O.T. DISTRICT 2 SURVEY OFFICE (USE ONLY)

PERSONNEL

REFERENCE NO. 7 A

SHEET 8 OF 15

NOTES RHOADES

DATE 6-12-20

ROUTE SR 18

H.C. AUBLE

WEATHER SUNNY

COUNTY WOOD

R.C. MAHLER

TEMP. 66°F

TOWNSHIP JACKSON

O'DONNELL

SECTION 21

DWG BY MAHLER

PID PAVE TRAIN

T 3 N R 9 E

TYPE MONUMENT MAG/WASHER

ON SURFACE - ~~BELOW~~ ON

OFFSET CL PAVEMENT 8.4' LT : RT

1.1' TO RT EDGE PAVEMENT



STATION: 148+80

HORIZ.DATUM: NAD83 (2011)

GEOID: NAVD88-2012A

GRID: NORTHING: 563070.560

EASTING: 1603182.738

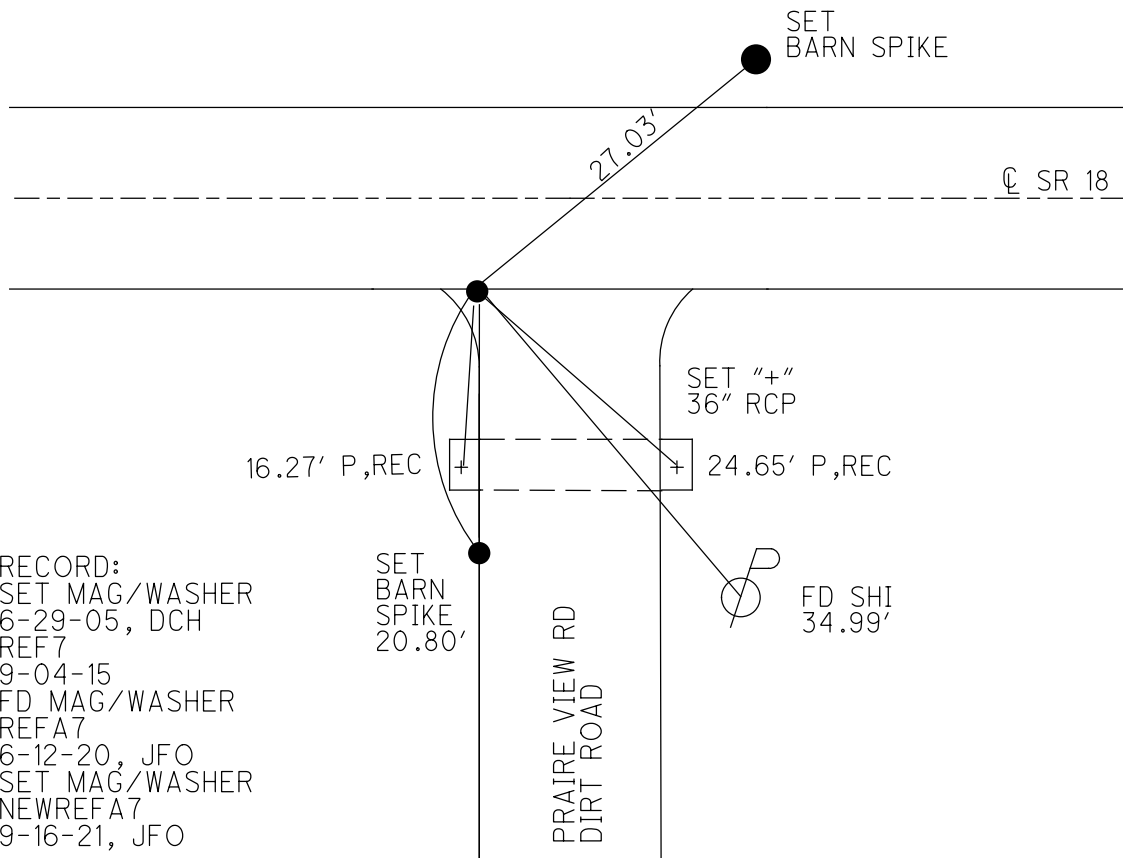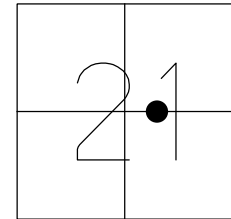

RECORD:
SET MAG/WASHER
6-29-05, DCH
REF 7
9-04-15
FD MAG/WASHER
REFA 7
6-12-20, JFO
SET MAG/WASHER
NEWREFA 7
9-16-21, JFO

O.D.O.T. DISTRICT 2 SURVEY OFFICE (USE ONLY)

PERSONNEL

REFERENCE NO. 8

SHEET 9 OF 15

NOTES RHOADES

DATE 6-12-20

ROUTE SR 18

H.C. AUBLE

WEATHER SUNNY

COUNTY WOOD

R.C. MAHLER

TEMP. 66°F

TOWNSHIP JACKSON

O'DONNELL

SECTION 22

DWG BY MAHLER

PID PAVE TRAIN

T 3 N R 9 E

TYPE MONUMENT MAG/WASHER

ON SURFACE - ~~BELOW~~ ON

OFFSET Q PAVEMENT 4.6'

~~LT~~ : RT

4.7' TO RT EDGE PAVEMENT


STATION: 162+22

HORZ.DATUM: NAD83 (2011)


GEOID: NAVD88-2012A

GRID: NORTHING: 563047.284

EASTING: 1604520.399

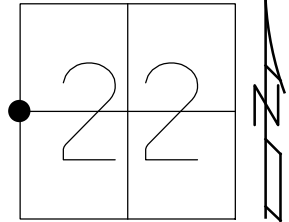

RECORD:
SET MAG/WASHER
7-25-05, DCH
REF8
9-4-15
FD MAG/WASHER
REF8
6-12-20
9-16-21, JFO

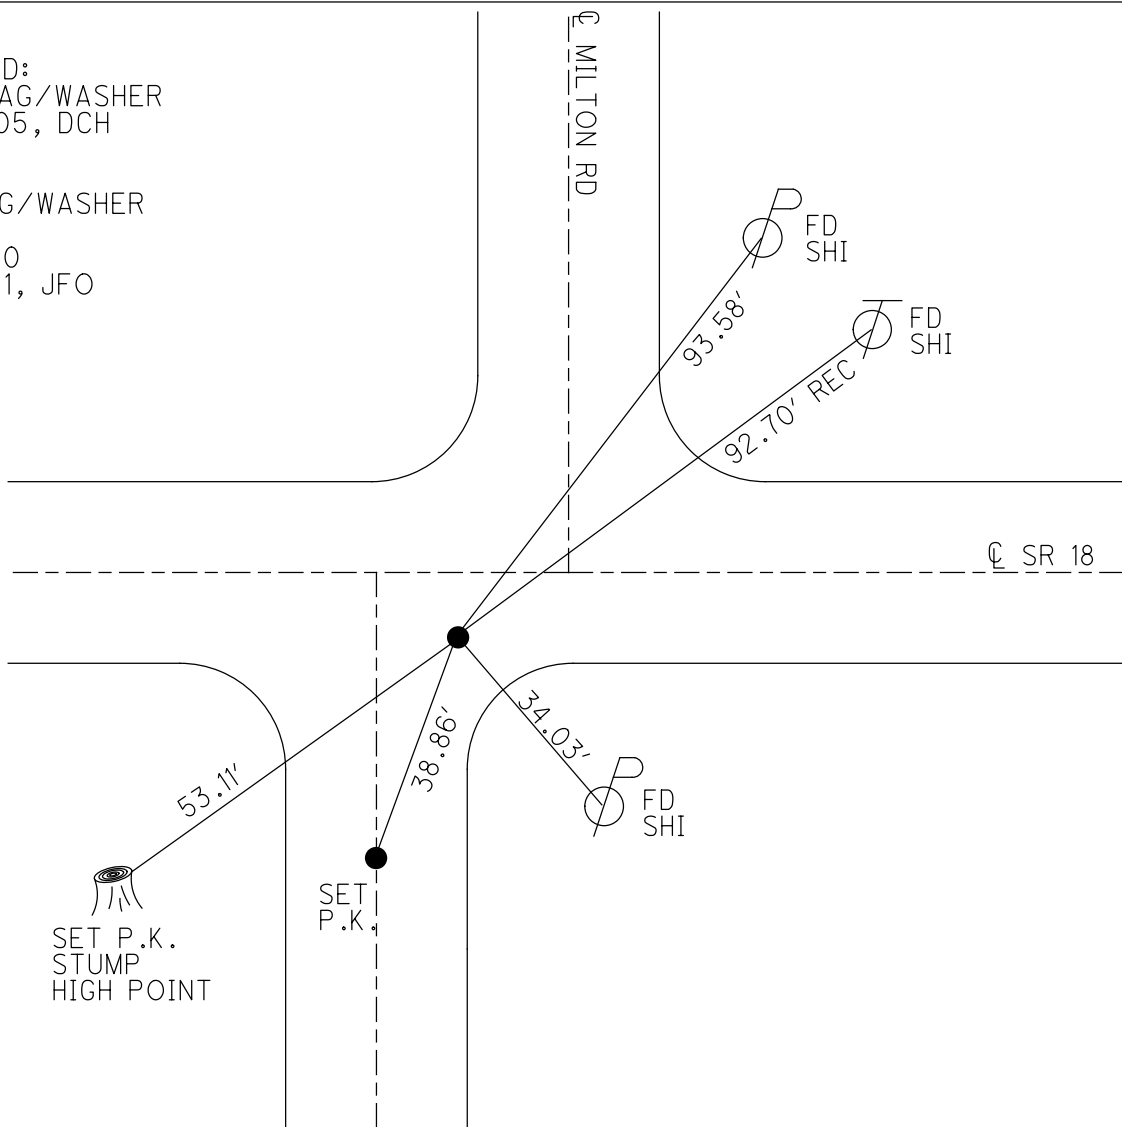

O.D.O.T. DISTRICT 2 SURVEY OFFICE (USE ONLY)

PERSONNEL

REFERENCE NO. 9

SHEET 10 OF 15

NOTES RHOADES

DATE 6-12-20

ROUTE SR 18

H.C. AUBLE

WEATHER SUNNY

COUNTY WOOD

R.C. MAHLER

TEMP. 66°F

TOWNSHIP JACKSON

O'DONNELL

SECTION 22

DWG BY MAHLER

PID PAVE TRAIN

T 3 N R 9 E

TYPE MONUMENT MAG/WASHER

ON SURFACE - ~~BELOW~~ ON

OFFSET CL PAVEMENT 2.9' ~~LT~~ : RT

6.9' TO RT EDGE PAVEMENT


STATION: 188+63

HORZ.DATUM: NAD83 (2011)


GEOID: NAVD88-2012A

GRID: NORTHING: 563020.417

EASTING: 1607159.272

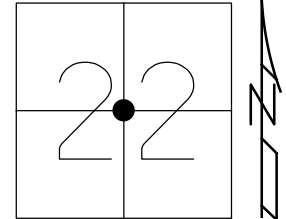

RECORD:
SET MAG/WASHER
6-29-05, DCH
REF9
9-04-15
FD MAG/WASHER
REF9
6-12-20
9-16-21, JFO

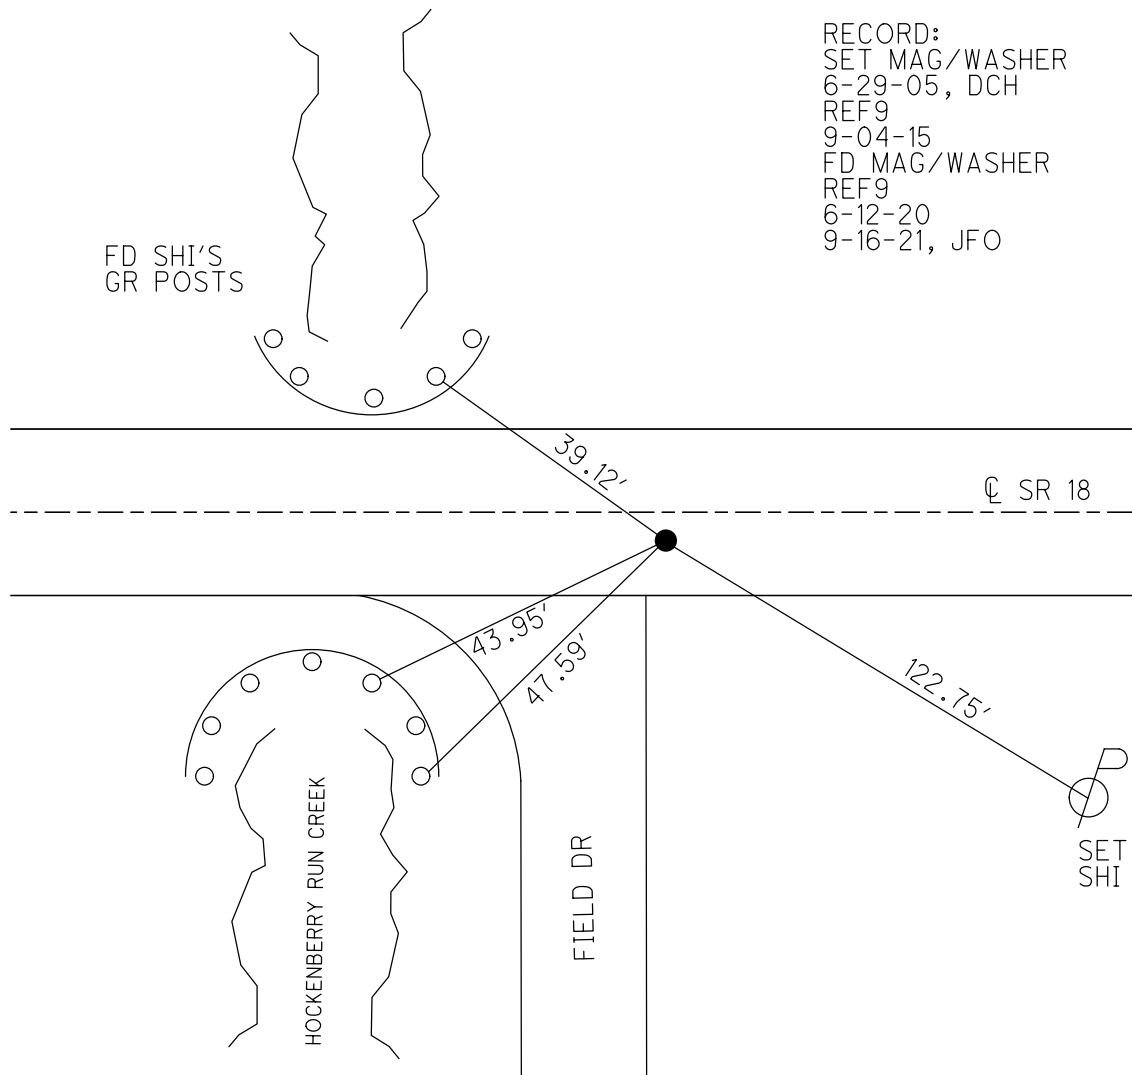

O.D.O.T. DISTRICT 2 SURVEY OFFICE (USE ONLY)

PERSONNEL

REFERENCE NO. 10

SHEET 11 OF 15

NOTES RHOADES

DATE 6-12-20

ROUTE SR 18

H.C. AUBLE

WEATHER SUNNY

COUNTY WOOD

R.C. MAHLER

TEMP. 66°F

TOWNSHIP JACKSON

O'DONNELL

SECTION 23

DWG BY MAHLER

PID PAVE TRAIN

T 3 N R 9 E

TYPE MONUMENT MAG/WASHER

ON SURFACE - ~~BELOW~~ ON

OFFSET 0.3'

- TO - EDGE PAVEMENT


STATION: 214+98

HORIZ.DATUM: NAD83 (2011)


GEOID: NAVD88-2012A

GRID: NORTHING: 562999.894

EASTING: 1609800.234

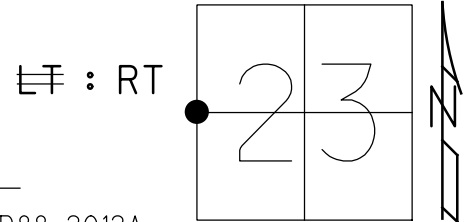

RECORD:
SET MAG/WASHER
7-26-05, DCH
FD P.K./WASHER
FD LG.R.R.SPIKE
3" DOWN
REF10
9-04-15
FD MAG/WASHER
REF10
6-12-20
FD 9-16-21, JFO

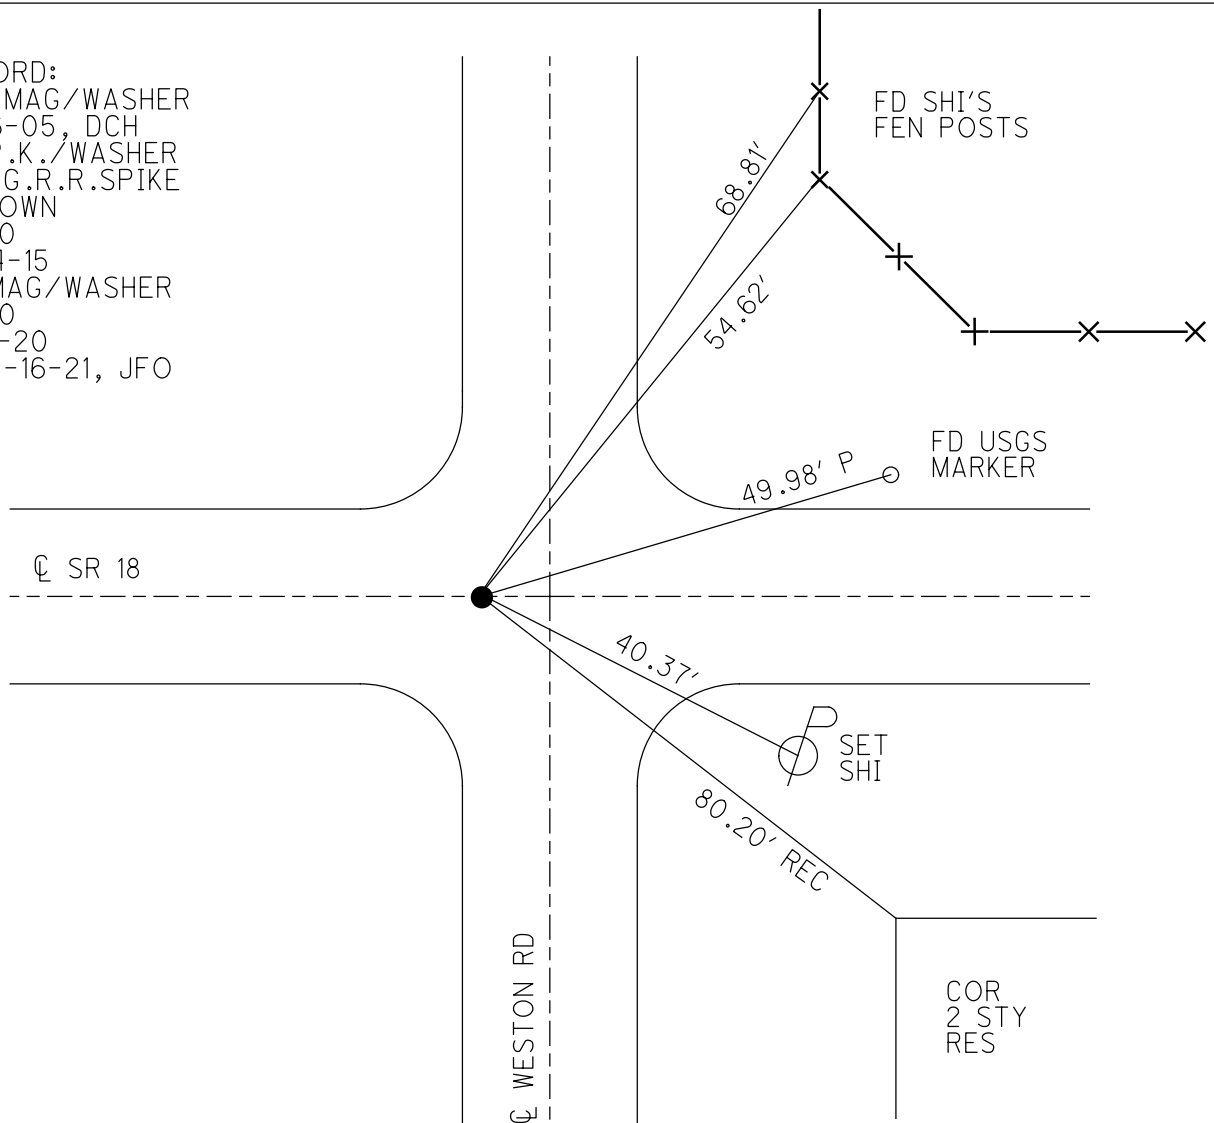

O.D.O.T. DISTRICT 2 SURVEY OFFICE (USE ONLY)

PERSONNEL

REFERENCE NO. 11

SHEET 12 OF 15

NOTES RHOADES

DATE 6-12-20

ROUTE SR 18

H.C. AUBLE

WEATHER SUNNY

COUNTY WOOD

R.C. MAHLER

TEMP. 66°F

TOWNSHIP JACKSON

O'DONNELL

SECTION 23

DWG BY MAHLER PID PAVE TRAIN

T 3 N R 9 E

TYPE MONUMENT MAG/WASHER

ON SURFACE - ~~BELOW~~ ON

OFFSET CL PAVEMENT 5.7' ~~LT~~ : RT

4.0' TO RT EDGE PAVEMENT


STATION: 241+43

HORIZ.DATUM: NAD83 (2011)


GEOID: NAVD88-2012A

GRID: NORTHING: 562922.421

EASTING: 1612443.484

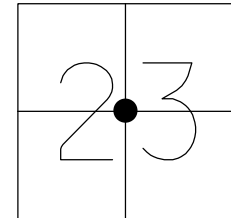

RECORD:
SET MAG/WASHER
6-19-05, DCH
REF11, 9-04-15
FD MAG/WASHER
REF11
6-12-20
9-16-21, JFO

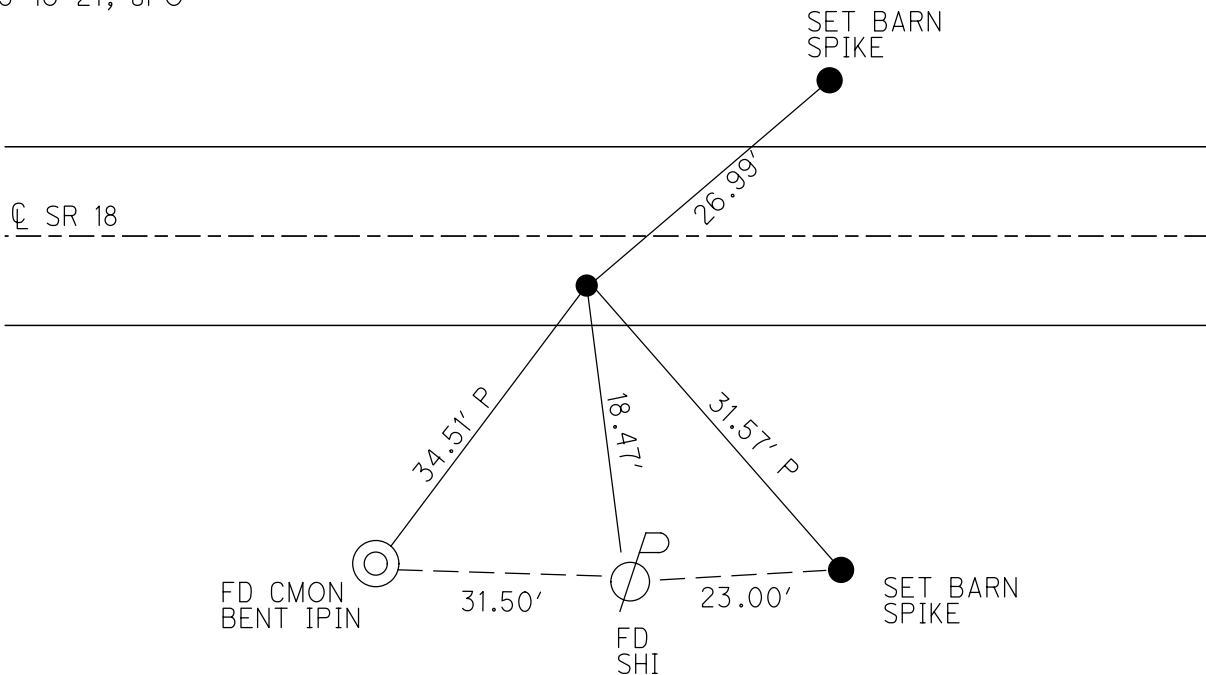

O.D.O.T. DISTRICT 2 SURVEY OFFICE (USE ONLY)

PERSONNEL

REFERENCE NO. 12

SHEET 13 OF 15

NOTES RHOADES
H.C. O'DONNELL
R.C. MAHLER

DATE 6-12-20
WEATHER SUNNY
TEMP. 73°F

ROUTE SR 18
COUNTY WOOD
TOWNSHIP JACKSON
SECTION 23

DWG BY MAHLER PID PAVE TRAIN

T 3 N R 9 E

TYPE MONUMENT MAG/WASHER


ON SURFACE - ~~BELOW~~ ON

OFFSET CL PAVEMENT 1.0'

- TO - EDGE PAVEMENT

STATION: 267+94

RT : RT

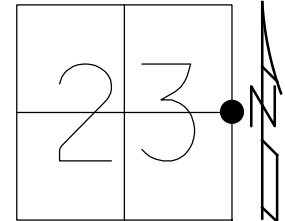


HORIZ.DATUM: NAD83 (2011)

GEOID: NAVD88-2012A

GRID: NORTHING: 562849.858

EASTING: 1615087.899

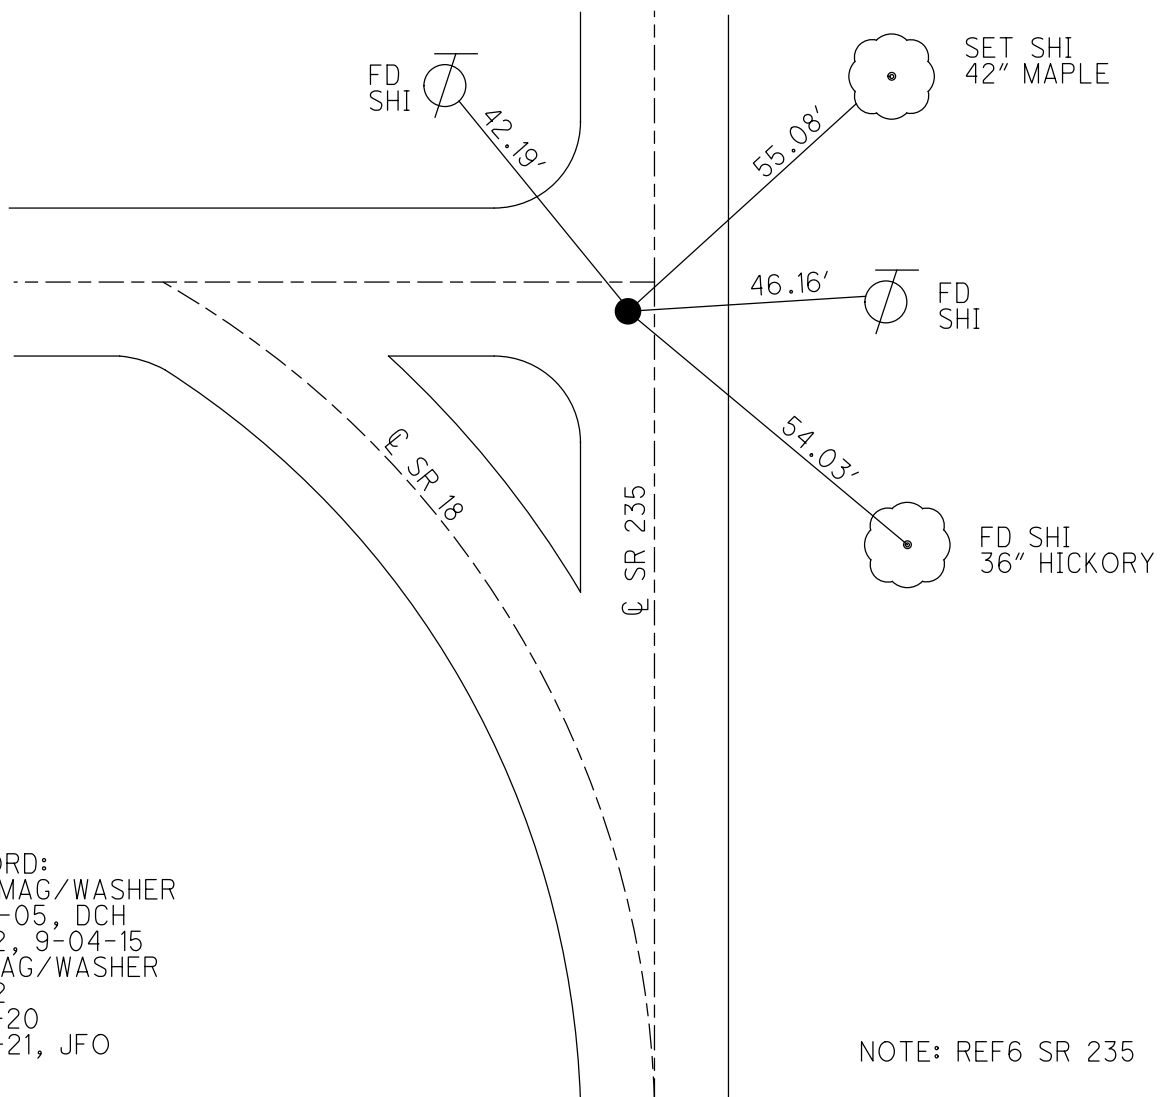

RECORD:
SET MAG/WASHER
7-26-05, DCH
REF12, 9-04-15
FD MAG/WASHER
REF12
6-12-20
9-16-21, JFO

O.D.O.T. DISTRICT 2 SURVEY OFFICE (USE ONLY)

PERSONNEL

REFERENCE NO. 13

SHEET 5 OF 52

NOTES NIESE

DATE 10/28/24

ROUTE SR 18

H.C. NIESE

WEATHER CLEAR

COUNTY WOOD

R.C. PRESTON-COLVIN

TEMP. 42°F

TOWNSHIP JACKSON

SECTION 23

DWG BY BARRIERE

PID 101290

T 3 N R 9 E

TYPE MONUMENT MAGNAIL/WASHER

ON SURFACE - BELOW ON

OFFSET $\varnothing$ PAVEMENT 1' LT LT : RT

TO EDGE PAVEMENT

STATION: 293+41

HORIZ.DATUM: WOOD LDP


GEOID: 18

GRID: NORTHING: 381555.564

EASTING: 127071.129


LDP: NORTHING: 560205.168

EASTING: 1615073.130

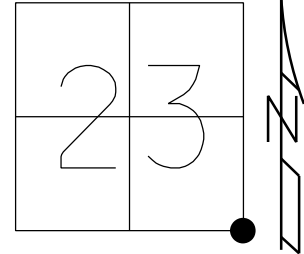

RECORD:
SET MAG/WASHER
7-26-05, DCH
FD MAG/WASHER
REF13
6-12-20
9-16-21, JFO
5/21/24, TDN
SET MAG/WASHER
10/28/24, TDN

NOTE: REF5 SR 235

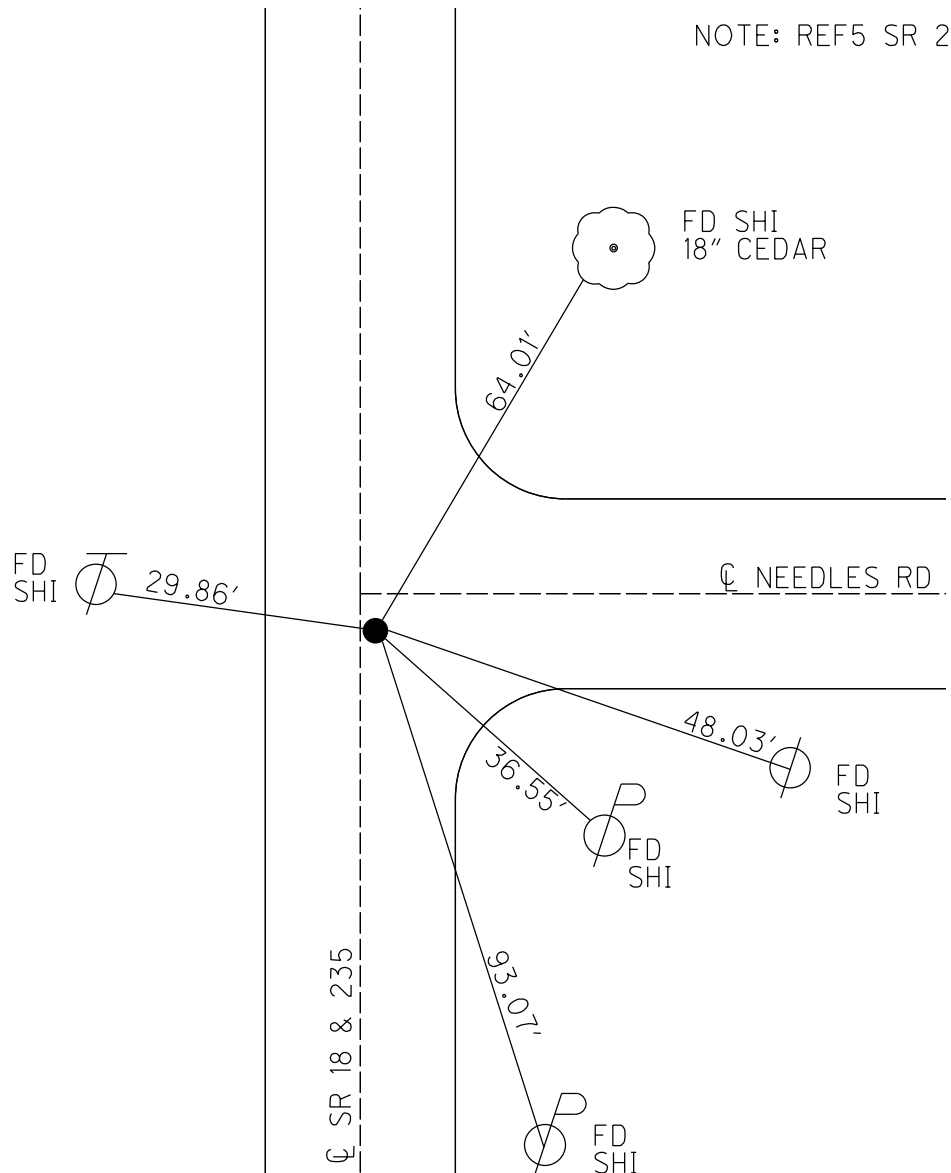

O.D.O.T. DISTRICT 2 SURVEY OFFICE (USE ONLY)

PERSONNEL

REFERENCE NO. 13A

SHEET 5 OF 52

NOTES NIESE DATE 10/28/24
H.C. NIESE WEATHER CLEAR
R.C. PRESTON-COLVIN TEMP. 42°F

ROUTE SR 18
COUNTY WOOD
TOWNSHIP JACKSON
SECTION 25
T 3 N R 9 E

DWG BY BARRIERE PID 101290

TYPE MONUMENT MAGNAIL/WASHER

ON SURFACE - BELOW ON

OFFSET $\varnothing$ PAVEMENT 1' LT LT : RT

TO EDGE PAVEMENT

STATION:

HORIZ.DATUM: WOOD LDP


GEOID: 18

GRID: NORTHING: 378924.939

EASTING: 127076.686


LDP: NORTHING: 557574.922

EASTING: 1615044.014

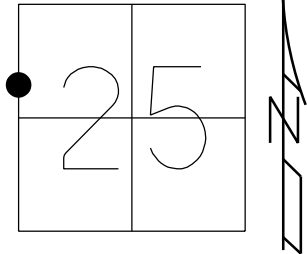

RECORD:
FD MAG
2/1/23, JAM
5/21/24, TDN
SET MAG/WASHER
10/28/24, TDN

NOTE: REF4A SR 235

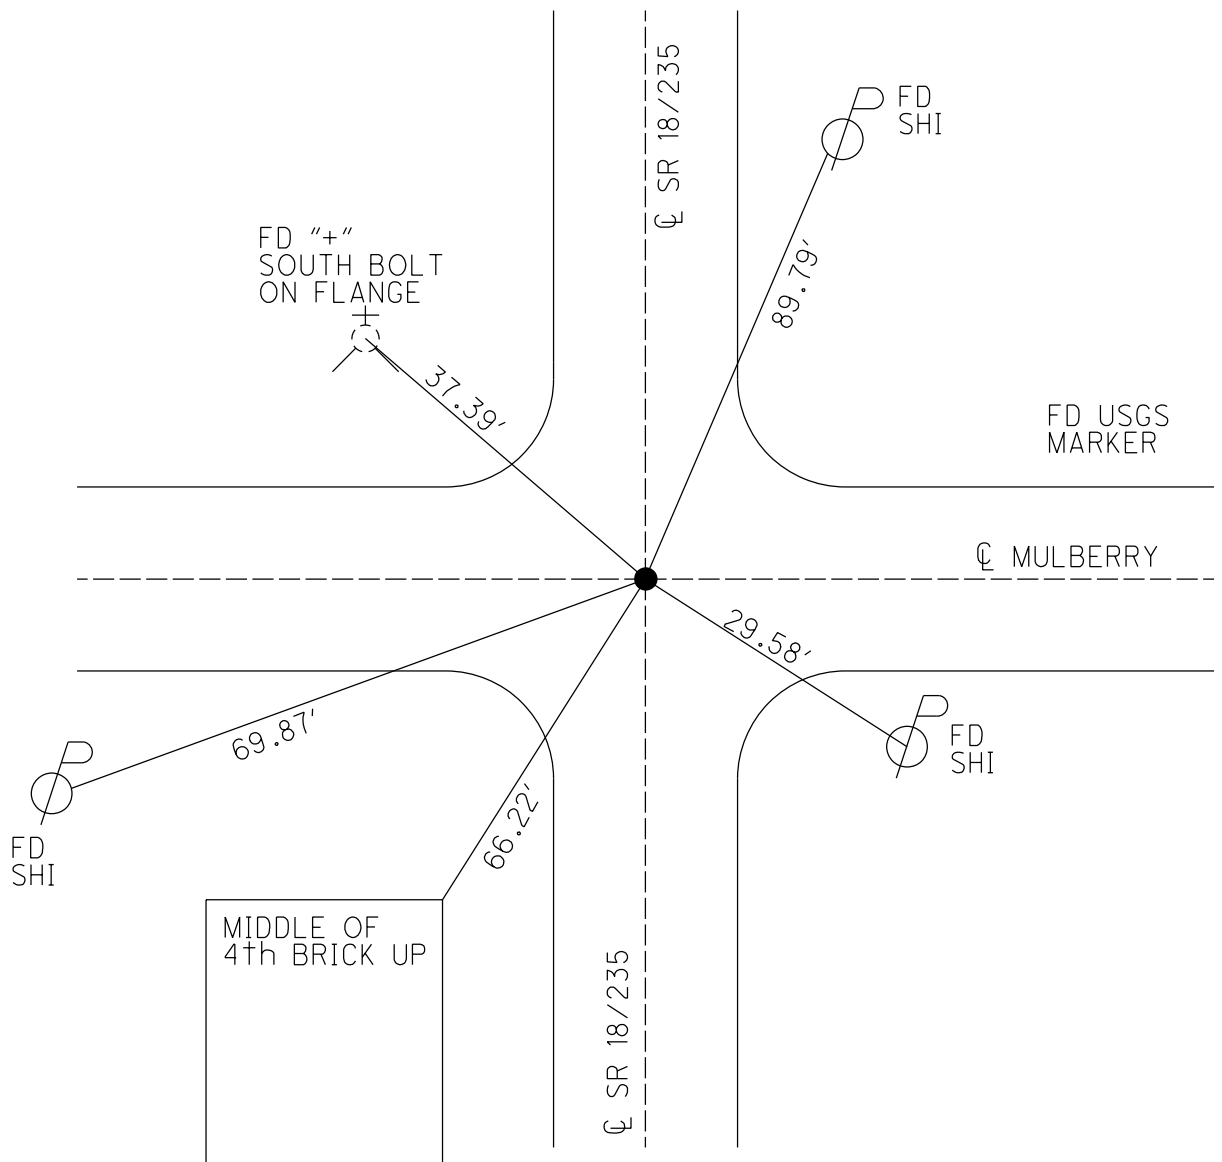

PERSONNEL

SHEET 5 OF 52

ROUTE	SR 18
COUNTY	WOOD
TOWNSHIP	JACKSON
SECTION	25

T_3_N R_9_E

ON SURFACE - BELOW ON


_____TO_____EDGE PAVEMENT

STATION: 319+72


HORZ.DATUM: WOOD LDP GEOID: 18

GRID: NORTHING: 378924.939 EASTING: 127076.686

LDP: NORTHING: 557574.922 EASTING: 1615044.014

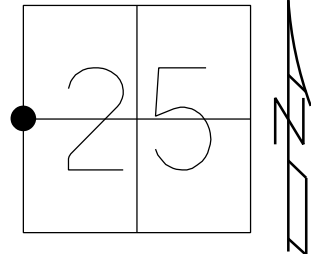

NOTE: REF4 SR 235

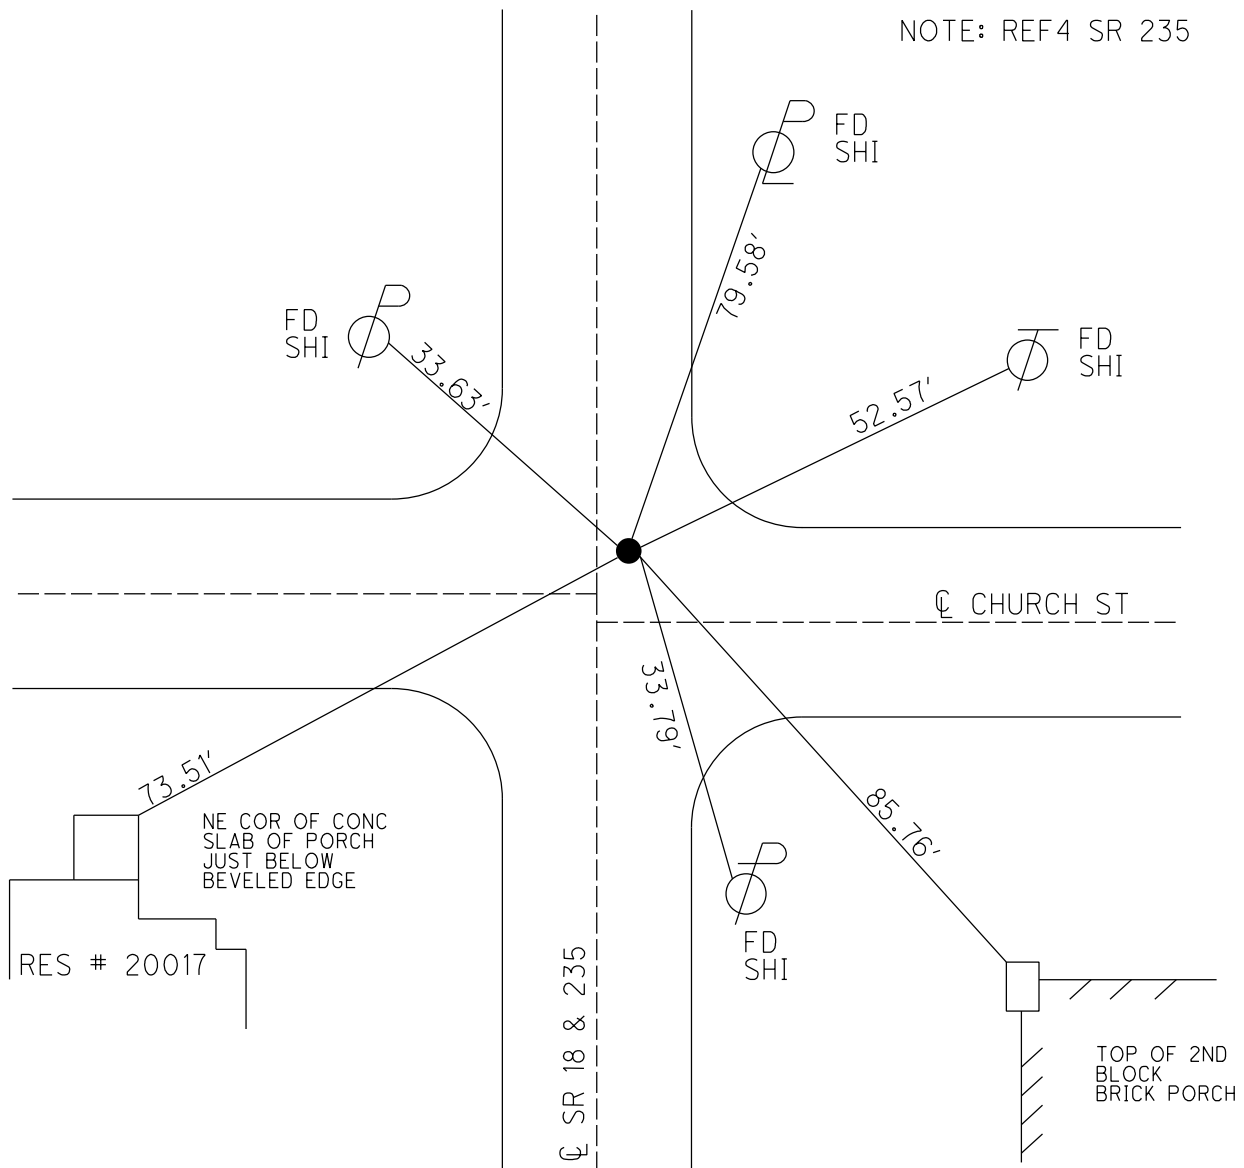

DISTANCE:

15-15A=	11.03'
15-15B=	32.68'
15-15C=	30.85'
15A-15B=	29.60'
15A-15C=	31.67'
15B-15C=	10.99'

O.D.O.T. DISTRICT 2 SURVEY OFFICE (USE ONLY)

PERSONNEL

REFERENCE NO. 15A

SHEET 5 OF 52

NOTES NIESE

DATE 10/28/24

ROUTE SR 18

H.C. NIESE

WEATHER CLEAR

COUNTY WOOD

R.C. PRESTON-COLVIN

TEMP. 42°F

TOWNSHIP JACKSON

DWG BY BARRIERE

PID 101290

SECTION 25

T 3 N R 9 E

TYPE MONUMENT MAGNAIL/WASHER

ON SURFACE - BELOW ON

OFFSET Q PAVEMENT LT : RT

 TO EDGE PAVEMENT

STATION: 343+18

HORZ.DATUM: WOOD LDP

GEOID: 18

GRID: NORTHING: 376295.312

EASTING: 127046.020

LDP: NORTHING: 554946.152

EASTING: 1614978.692

26	25
35	36




P.I. FOR APPROACHES
STA 346+43.13
(1927 PLANS)

FD MAG/WASHER
GPS, SV C15
6/16/10, BC
FD MAG/WASHER
REFA15
6/15/20, JFO
5/21/24, TDN
SET MAG/WASHER
10/28/24, TDN

NOTE: 2.5' W. OF Q SR 235

****SR 235 REF A3****

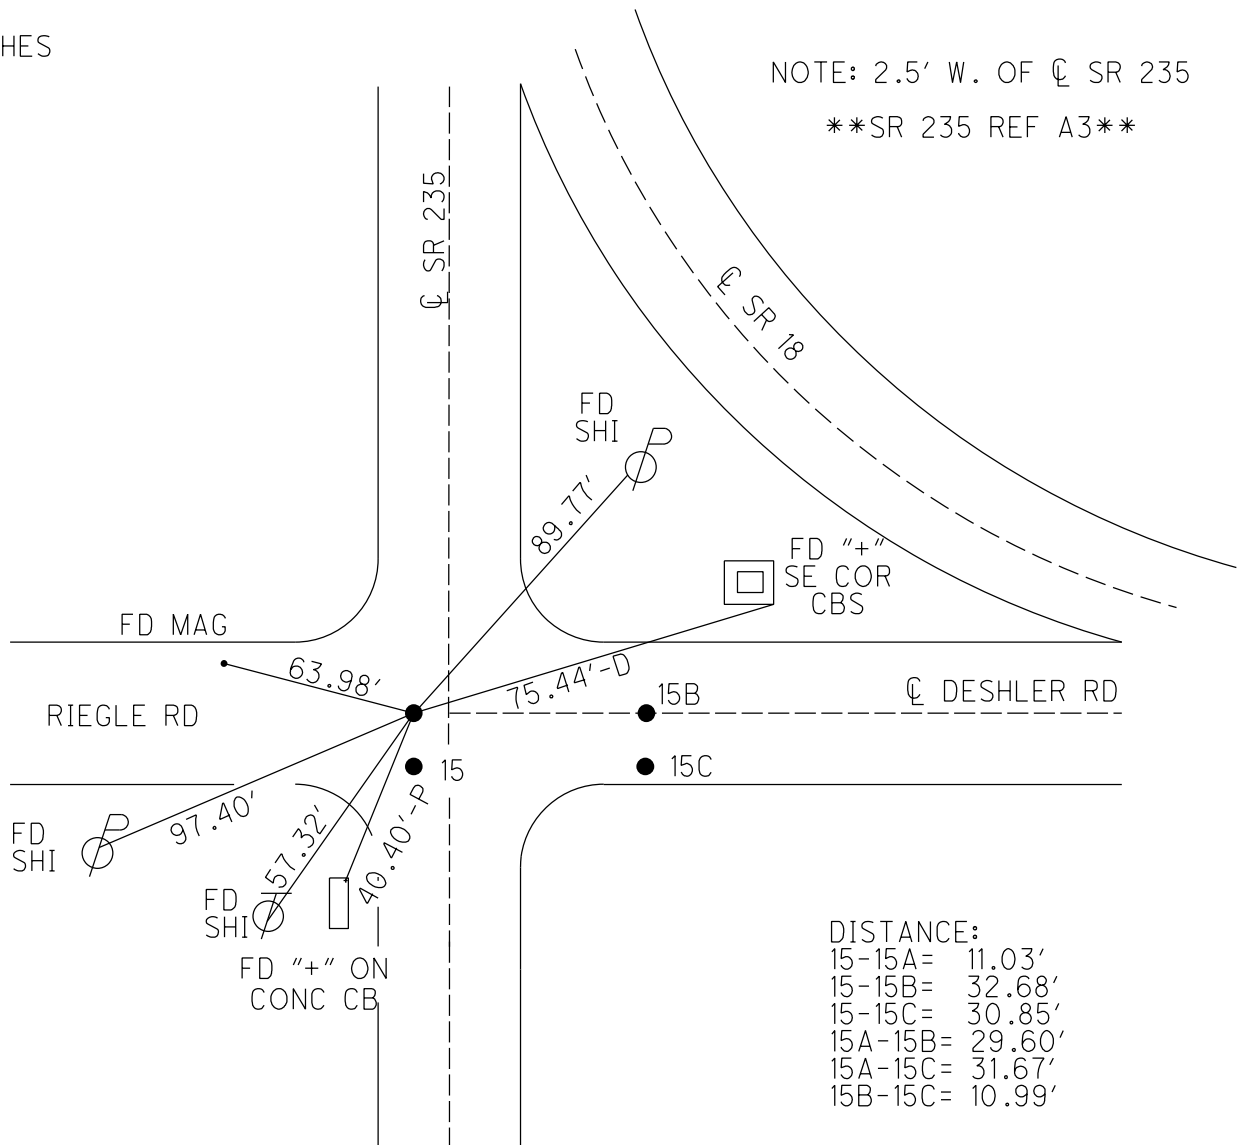

DISTANCE:

15-15A=	11.03'
15-15B=	32.68'
15-15C=	30.85'
15A-15B=	29.60'
15A-15C=	31.67'
15B-15C=	10.99'

O.D.O.T. DISTRICT 2 SURVEY OFFICE (USE ONLY)

PERSONNEL

REFERENCE NO. 15B

SHEET 5 OF 52

NOTES NIESE

DATE 10/28/24

ROUTE SR 18

H.C. NIESE

WEATHER CLEAR

COUNTY WOOD

R.C. PRESTON-COLVIN

TEMP. 42°F

TOWNSHIP JACKSON

SECTION 25

DWG BY BARRIERE

PID 101290

T 3 N R 9 E

TYPE MONUMENT MAGNAIL/WASHER

ON SURFACE - BELOW ON

OFFSET $\varnothing$ PAVEMENT _____ LT : RT

_____ TO _____ EDGE PAVEMENT

STATION: 343+47.58

HORZ.DATUM: WOOD LDP

GEOID: 18

GRID: NORTHING: 376295.587

EASTING: 127075.615

LDP: NORTHING: 554946.037

EASTING: 1615008.286

26	25
35	36


RECORD:

FD MAG/WASHER
GPS, SV B15
6/16/10, BG
FD MAG NAIL
REFB15
6/15/20, JFO
5/21/24, TDN
SET MAG/WASHER
10/28/24, TDN

RECORD: P.I.
STA 346+42
 $\Delta = 90^\circ 39'$
D = 19°
R = 302.943
T = 306.423
L = 477.105
E = 127.932
(1927 PLANS)

NOTE: 2.5' W. OF $\varnothing$ SR 235

****SR 235 REF C3****

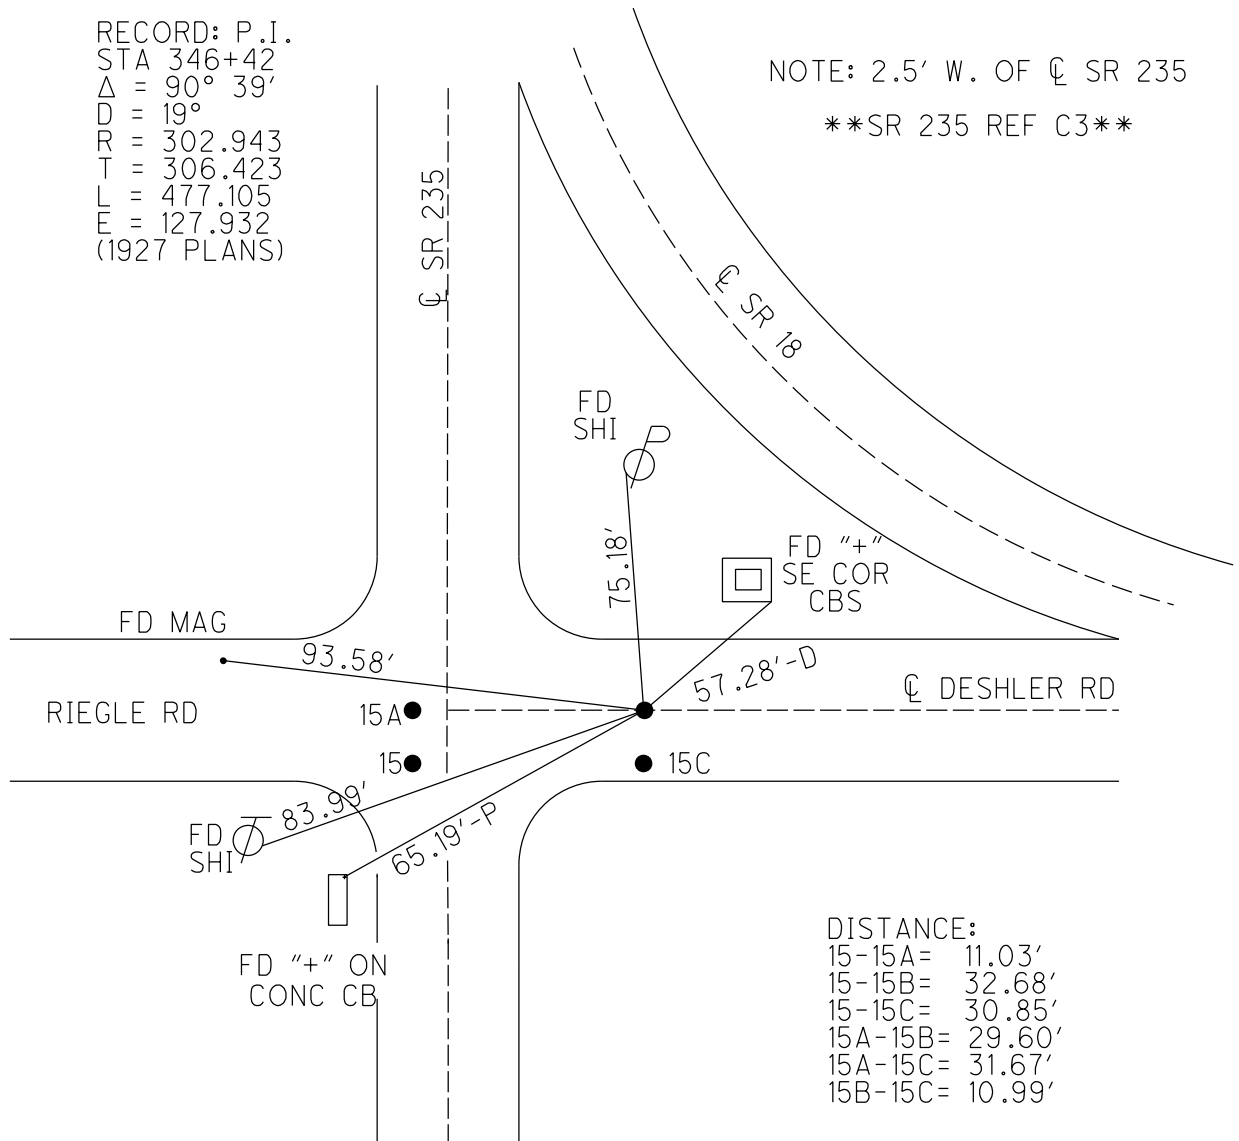

DISTANCE:

15-15A= 11.03'
15-15B= 32.68'
15-15C= 30.85'
15A-15B= 29.60'
15A-15C= 31.67'
15B-15C= 10.99'

DISTANCE:

15-15A=	11.03'
15-15B=	32.68'
15-15C=	30.85'
15A-15B=	29.60'
15A-15C=	31.67'
15B-15C=	10.99'

O.D.O.T. DISTRICT 2 SURVEY OFFICE (USE ONLY)

PERSONNEL

REFERENCE NO. 16

SHEET 5 OF 52

NOTES ASTON

DATE 5/22/24

ROUTE SR 18

H.C. NIESE

WEATHER WINDY

COUNTY WOOD

R.C. PRESTON-COLVIN

TEMP. 78°F

TOWNSHIP JACKSON

DWG BY BARRIERE

PID PAVING TRAIN

SECTION 25

T 3 N R 9 E

TYPE MONUMENT PK NAIL, 3/4" IRON PIPE

ON SURFACE - BELOW 1' BELOW

OFFSET $\varnothing$ PAVEMENT _____ LT : RT

_____ TO _____ EDGE PAVEMENT

STATION: 369+80.32

HORIZ.DATUM: NAD83 (2011)


GEOID: 18

GRID: NORTHING: 554927.219


EASTING: 1617640.526

LDP: NORTHING: _____

EASTING: _____

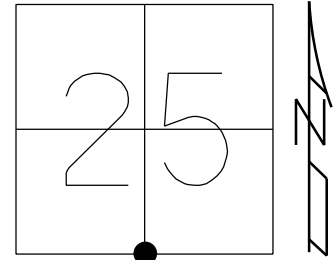

RECORD:
 FD STONE
 1' DOWN
 3/4" IPIPE ATOP
 3/19/91. CL
 FD P.K. NAIL IN PIPE
 BENT OVER STONE
 1.0' DOWN
 6/3/11, SAH
 FD P.K. NAIL IN 3/4" IPIPE
 BENT SE
 REF16
 6/15/20, JFO
 4/30/21, JFO
 FD IPIN
 8-10-23, TDN
 FD P.K. NAIL IN 3/4" IPIPE
 5/22/24, TDN

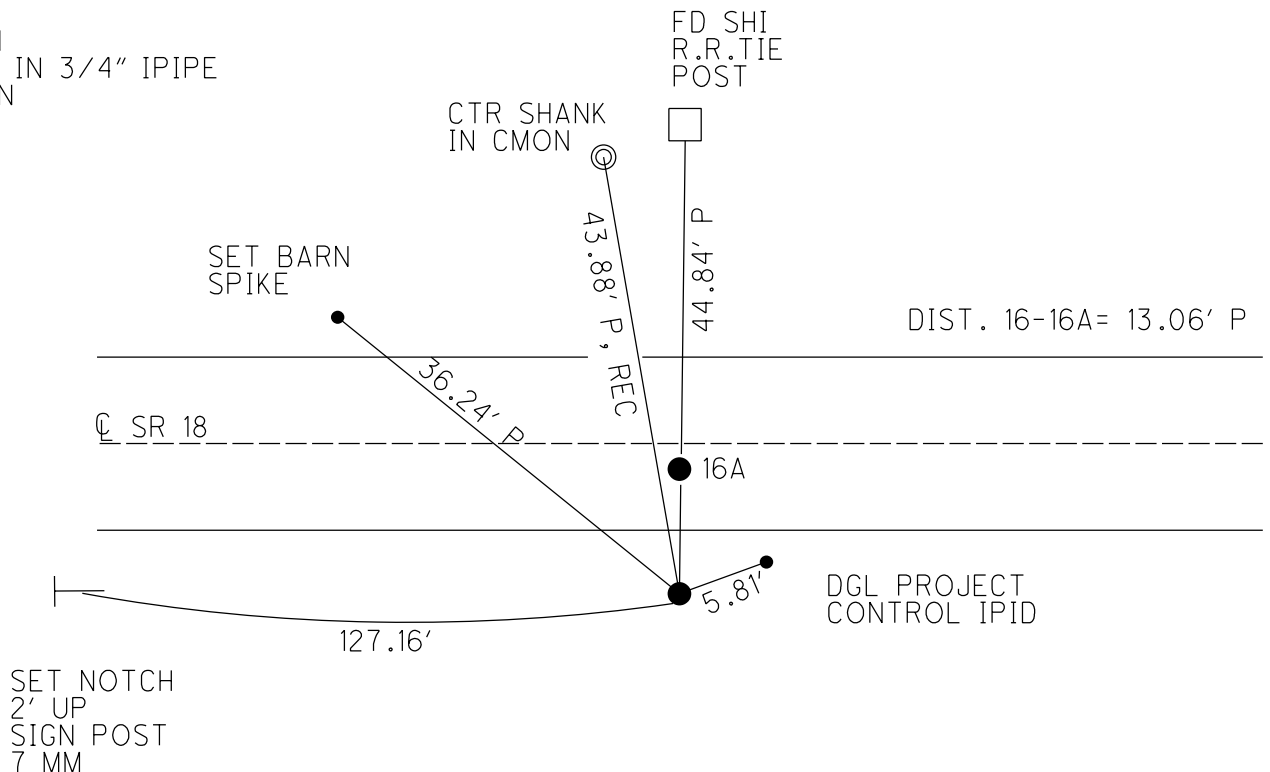

O.D.O.T. DISTRICT 2 SURVEY OFFICE (USE ONLY)

PERSONNEL

REFERENCE NO. 16 A

SHEET 5 OF 52

NOTES ASTON
H.C. NIESE
R.C. PRESTON-COLVIN

DATE 5/22/24
WEATHER WINDY
TEMP. 78°F

ROUTE SR 18
COUNTY WOOD
TOWNSHIP JACKSON
SECTION 25

DWG BY BARRIERE PID PAVING TRAIN

T 3 N R 9 E

TYPE MONUMENT MAGNAIL/WASHER

ON SURFACE - BELOW ON

OFFSET Q PAVEMENT LT : RT

 TO EDGE PAVEMENT

STATION: 369+80.32

HORIZ.DATUM: NAD83 (2011)


GEOID: 18

GRID: NORTHING: 554940.188


EASTING: 1617641.073

LDP: NORTHING:

EASTING:

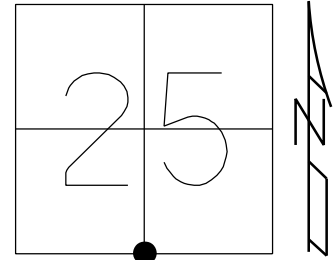

RECORD:
SET SM.CONC.NAIL
11/21/83, HOFFMAN
FD SM.CONC.NAIL
3/19/91
SET P.K./WASHER
4/17/91, MB
FD P.K./WASHER
6/3/11, SAH
SET MAG/WASHER
9/1/11, SAH
FD MAG/WASHER
REFA16
6/15/20, JFO
4/30/21, JFO
1/21/22, TDN
8-10-23, TDN
9/22/24, TDN

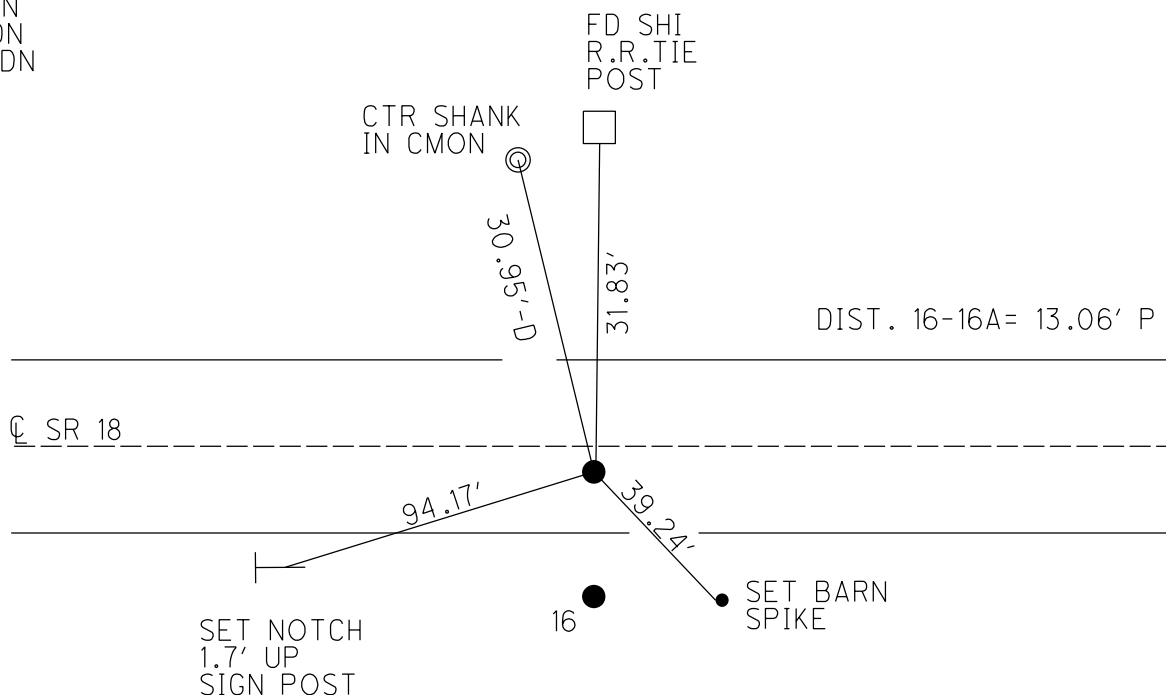

O.D.O.T. DISTRICT 2 SURVEY OFFICE (USE ONLY)

PERSONNEL

REFERENCE NO. 16 B

SHEET 5 OF 52

NOTES ASTON

DATE 5/22/24

ROUTE SR 18

H.C. NIESE

WEATHER WINDY

COUNTY WOOD

R.C. PRESTON-COLVIN

TEMP. 78°F

TOWNSHIP JACKSON

SECTION 25

DWG BY BARRIERE

PID 101290

T 3 N R 9 E

TYPE MONUMENT MAGNAIL/WASHER

ON SURFACE - BELOW ON

OFFSET CL PAVEMENT LT : RT

 TO EDGE PAVEMENT

STATION: 382+91

HORIZ.DATUM: WOOD LDP


GEOID: 18

GRID: NORTHING: 554940.188

EASTING: 1617641.073

LDP: NORTHING: 376332.059

EASTING: 131018.368

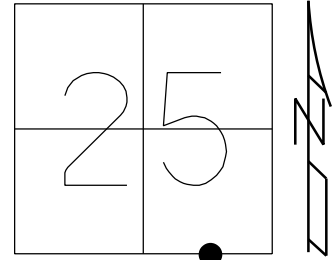

RECORD:

SET P.K.NAIL

11/21/83

FD P.K.NAIL

6/16/87

SET P.K.NAIL

7/7/87, CL

FD P.K./WASHER

6/3/11, SAH

SET MAG/WASHER

9/1/11, MC

FD MAG/WASHER

REFB16

6/15/20, JFO

4/30/21, JFO


1/21/22, TDN

8-10-23, TDN

REF16B

5/22/24, TDN

10/5/24, TDN

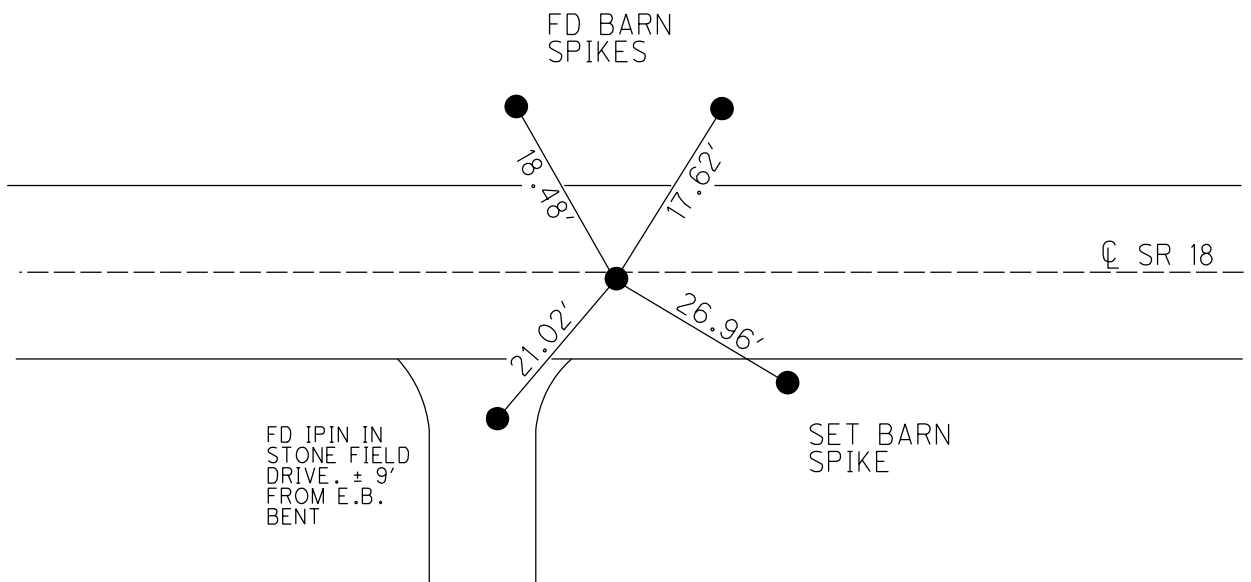

O.D.O.T. DISTRICT 2 SURVEY OFFICE (USE ONLY)

PERSONNEL

REFERENCE NO. 16 C

SHEET 5 OF 52

NOTES ASTON

DATE 5/22/24

ROUTE SR 18

H.C. NIESE

WEATHER WINDY

COUNTY WOOD

R.C. PRESTON-COLVIN

TEMP. 78°F

TOWNSHIP JACKSON

SECTION 25

DWG BY BARRIERE

PID 101290

T 3 N R 9 E

TYPE MONUMENT MAGNAIL / WASHER

ON SURFACE - BELOW ON

OFFSET CL PAVEMENT LT : RT

TO EDGE PAVEMENT

STATION: 391+26.96

HORIZ.DATUM: WOOD LDP


GEOID: 18

GRID: NORTHING: 554922.364

EASTING: 1619787.621

LDP: NORTHING: 376334.906

EASTING: 131855.237

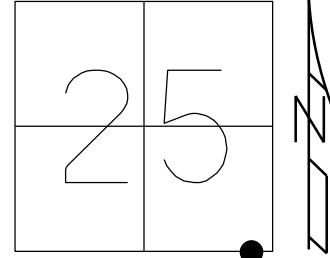

RECORD:

FD SM.P.K.NAIL

SET BY OTHERS

6/16/87

SET P.K./WASHER

7/7/87, CL

FD P.K.NAIL

6/16/10, BG

FD P.K./WASHER

7/28/11, MC

SET MAG/WASHER

9/1/11, MC

FD MAG/WASHER

REFC16

6/15/20, JFO

4/30/21, JFO

1/21/21, TDN


5-23-23, TDN

8-10-23, TDN

REF16C

5/22/24, TDN

10/25/24, TDN

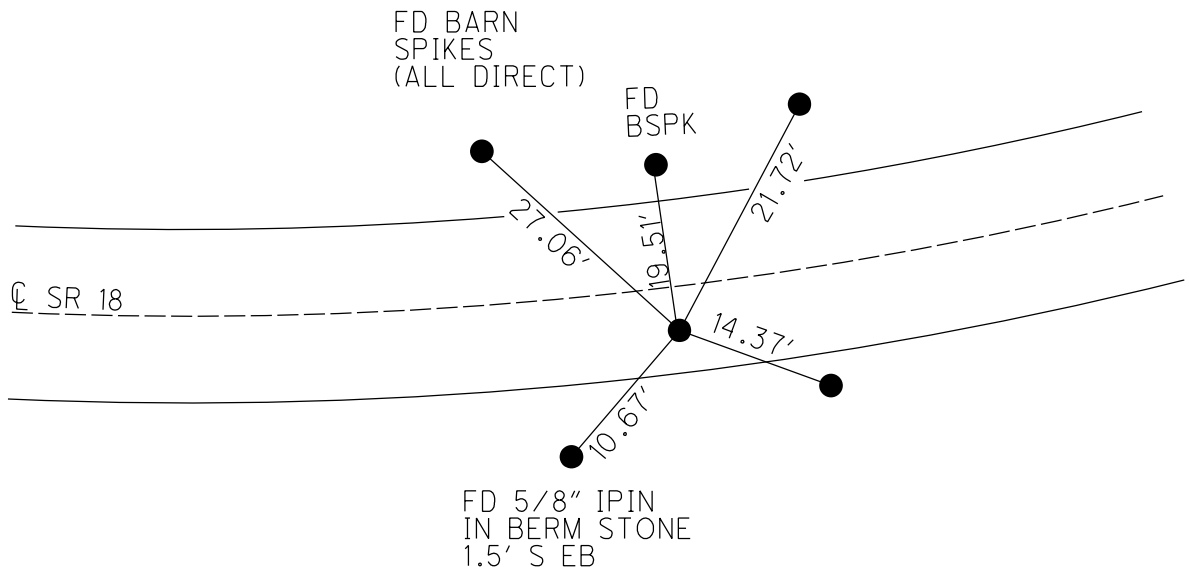

O.D.O.T. DISTRICT 2 SURVEY OFFICE (USE ONLY)

PERSONNEL

REFERENCE NO. 16 D

SHEET 5 OF 52

NOTES ASTON

DATE 5/22/24

ROUTE SR 18

H.C. NIESE

WEATHER WINDY

COUNTY WOOD

R.C. PRESTON-COLVIN

TEMP. 78°F

TOWNSHIP JACKSON

DWG BY BARRIERE

PID 101290

SECTION 25

T 3 N R 9 E

TYPE MONUMENT MAGNAIL/WASHER

ON SURFACE - BELOW ON

OFFSET $\varnothing$ PAVEMENT _____ LT : RT

_____ TO _____ EDGE PAVEMENT

STATION: 394+24.51

HORZ.DATUM: WOOD LDP


GEOID: 18

GRID: NORTHING: 554955.024


EASTING: 1620083.350

LDP: NORTHING: 376371.444

EASTING: 132150.538

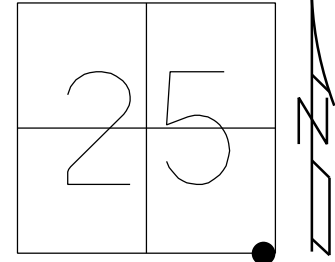

RECORD:
 FD SM.P.K.NAIL
 SET BY OTHERS
 6/16/87
 FD P.K. NAIL
 6/16/10, BG
 SET MAG/WASHER
 9/1/11, MC
 FD MAG/WASHER
 REF16
 6/15/20, JFO
 4/30/21, JFO
 1/21/22, TDN
 8-10-23, TDN
 REF16D
 5/22/24, TDN
 10/25/24, TDN

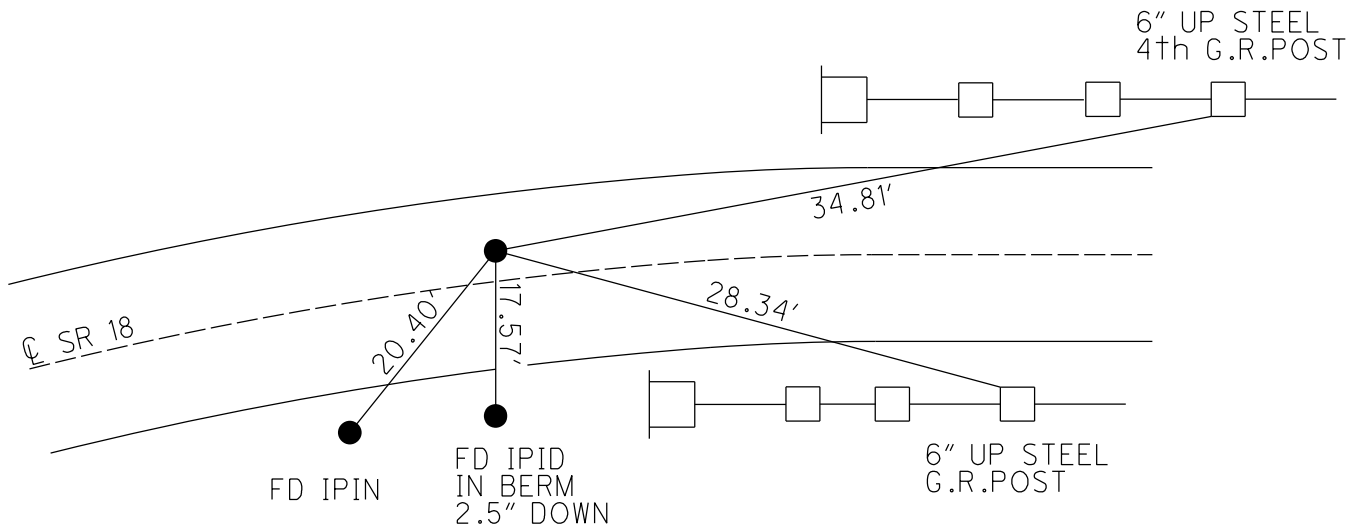

O.D.O.T. DISTRICT 2 SURVEY OFFICE (USE ONLY)

PERSONNEL

REFERENCE NO. 17

SHEET 10 OF 52

NOTES CANTERBURY

DATE 7/28/11

ROUTE SR 18

H.C. CANTERBURY

WEATHER OVERCAST

COUNTY WOOD

R.C. HARBAUGH

TEMP. 83°

TOWNSHIP JACKSON

DWG BY NIESE

PID PAVETRAIN

SECTION 25

T 3 N R 9 E

TYPE MONUMENT 1" IPIN, D.N.F.

~~ON SURFACE~~ - BELOW 6"

OFFSET Q PAVEMENT LT : RT

- TO - EDGE PAVEMENT 12.0' W.CO.RD. SOUTH


STATION: 396+08.50

HORIZ.DATUM:

GEOID:

GRID: NORTHING:

EASTING:

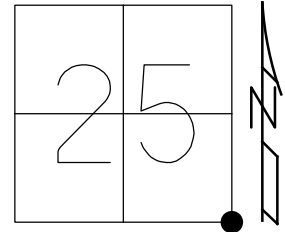

RECORD:
SET SM.P.K.NAIL
SET BY OTHERS
FOR BRIDGE SURVEY
SET P.K./WASHER
6/16/87, CL
D.N.F.
6/15/10
7/28/11, MC
6/15/20, JFO

Q RANGE LINE RD

DIST. 17-17A=2.12' REC
DIST. 17-17B=42.38' REC

Q SR 18

17A

SEC.25
SEC.36

M
17B

O.D.O.T. DISTRICT 2 SURVEY OFFICE (USE ONLY)

PERSONNEL

REFERENCE NO. 17 A

SHEET 5 OF 52

NOTES ASTON

DATE 5/22/24

ROUTE SR 18

H.C. NIESE

WEATHER WINDY

COUNTY WOOD

R.C. PRESTON-COLVIN

TEMP. 80°F

TOWNSHIP JACKSON

SECTION 25

DWG BY BARRIERE

PID 101290

T 3 N R 9 E

TYPE MONUMENT MAGNAIL / WASHER

ON SURFACE - BELOW ON

OFFSET Q PAVEMENT LT : RT

TO EDGE PAVEMENT

STATION: 396+08.5

HORIZ.DATUM: WOOD LDP


GEOID: 18

GRID: NORTHING: 554949.624

EASTING: 1620267.238

LDP: NORTHING: 376368.478

EASTING: 132334.517

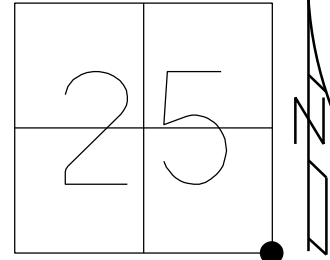

RECORD:

SET SM.P.K.NAIL

SET BY OTHERS

6/16/87

SET P.K./WASHER

7/7/87, CL

FD 1" IPIN

BENT SOUTHERLY

6/16/10, BC

FD 1" IPIN

7/28/11, MC

SET MAG/WASHER

1/25/12, SAH

FD MAG/WASHER

REFA17

6/15/20, JFO


FD MAG/WASHER

1/21/22, TDN

8-10-23, TDN

5/23/24, TDN

10/25/24, TDN

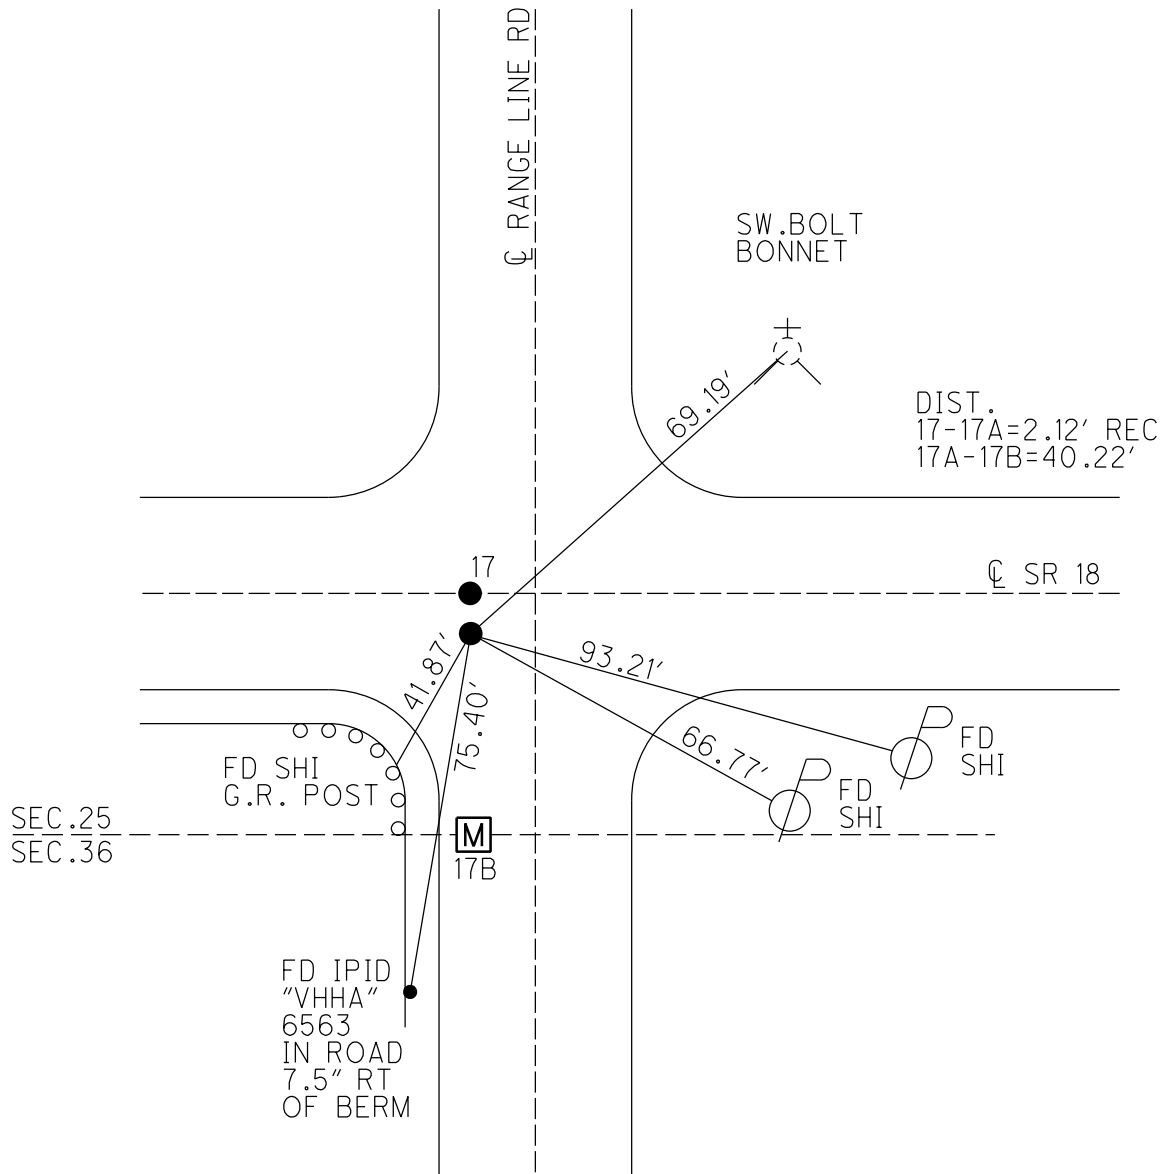

O.D.O.T. DISTRICT 2 SURVEY OFFICE (USE ONLY)

PERSONNEL

REFERENCE NO. 17 B

SHEET 5 OF 52

NOTES ASTON DATE 5/22/24
H.C. NIESE WEATHER WINDY
R.C. PRESTON-COLVIN TEMP. 80°F

ROUTE SR 18
COUNTY WOOD
TOWNSHIP JACKSON
SECTION 25

DWG BY BARRIERE PID 101290

T 3 N R 9 E

TYPE MONUMENT MONBOX W/ 1" IPIN

ON SURFACE - BELOW ON

OFFSET $\angle$ PAVEMENT _____ LT : RT

_____ TO _____ EDGE PAVEMENT

STATION: 396+08.5

HORIZ.DATUM: WOOD LDP


GEOID: 18

GRID: NORTHING: 554909.411


EASTING: 1620266.932

LDP: NORTHING: 376328.284

EASTING: 132334.680

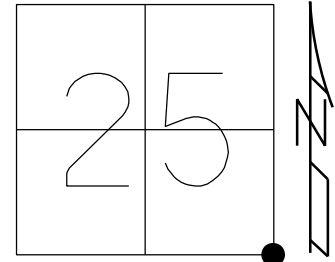

RECORD:
FD 1" IPIN
6/16/87, CL
FD MONBOX
6/16/10, BG
7/28/11, MC
FD MONBOX
W/1" IPIN
REFB17
6/15/20, JFO
4/30/21, JFO
1/21/22, TDN
FD MONBOX
W/1" IPIN
REF17B
5/23/24, TDN

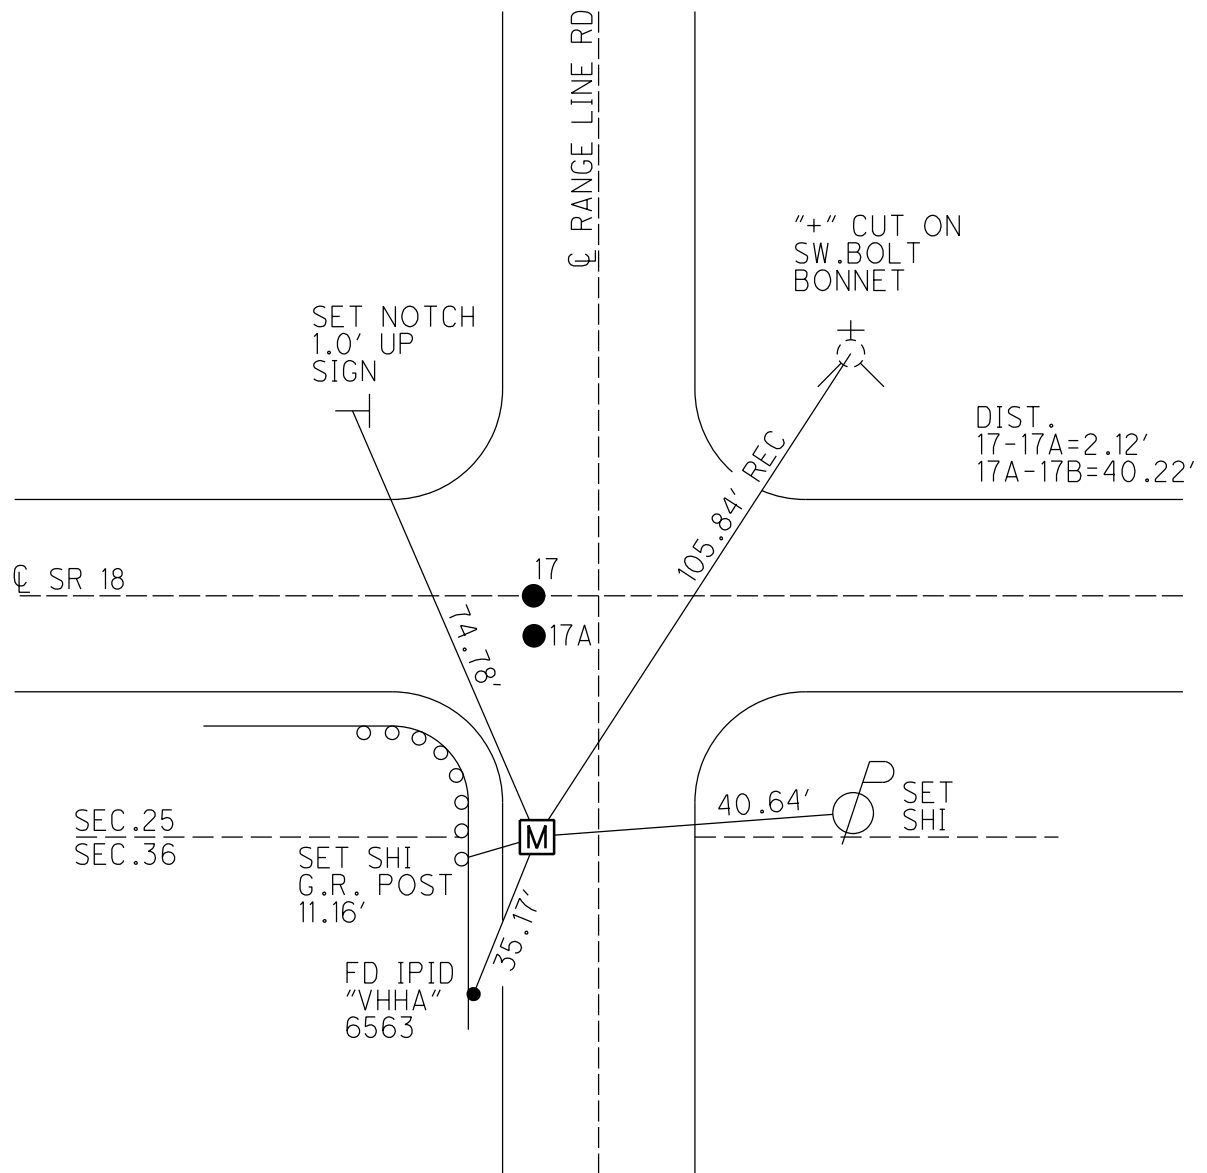

O.D.O.T. DISTRICT 2 SURVEY OFFICE (USE ONLY)

PERSONNEL

REFERENCE NO. 18

SHEET 5 OF 52

NOTES ASTON

DATE 5/23/24

ROUTE SR 18

H.C. NIESE

WEATHER WINDY

COUNTY WOOD

R.C. PRESTON-COLVIN

TEMP. 80°F

TOWNSHIP HENRY

SECTION 30

DWG BY BARRIERE

PID 101290

T 3 N R 10 E

TYPE MONUMENT MAG/WASHER

ON SURFACE - BELOW ON

OFFSET $\varnothing$ PAVEMENT _____ LT : RT

_____ TO _____ EDGE PAVEMENT

STATION: 422+75.33

HORIZ.DATUM: WOOD LDP


GEOID: 18

GRID: NORTHING: 554903.637


EASTING: 1622933.535


LDP: NORTHING: 376357.677

EASTING: 135001.421

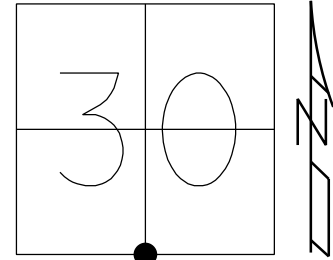

RECORD:
 SET P.K./WASHER
 7/7/87, CL
 FD P.K.NAIL
 6/16/10, BG
 7/28/11, MC
 SET MAG/WASHER
 1/25/12, SAH
 FD MAG/WASHER
 REF18
 6/15/20, JFO
 4/30/21, JFO
 1/21/22, TDN
 8-10-23, TDN
 REF18
 5/22/24, TDN
 10/25/24, TDN

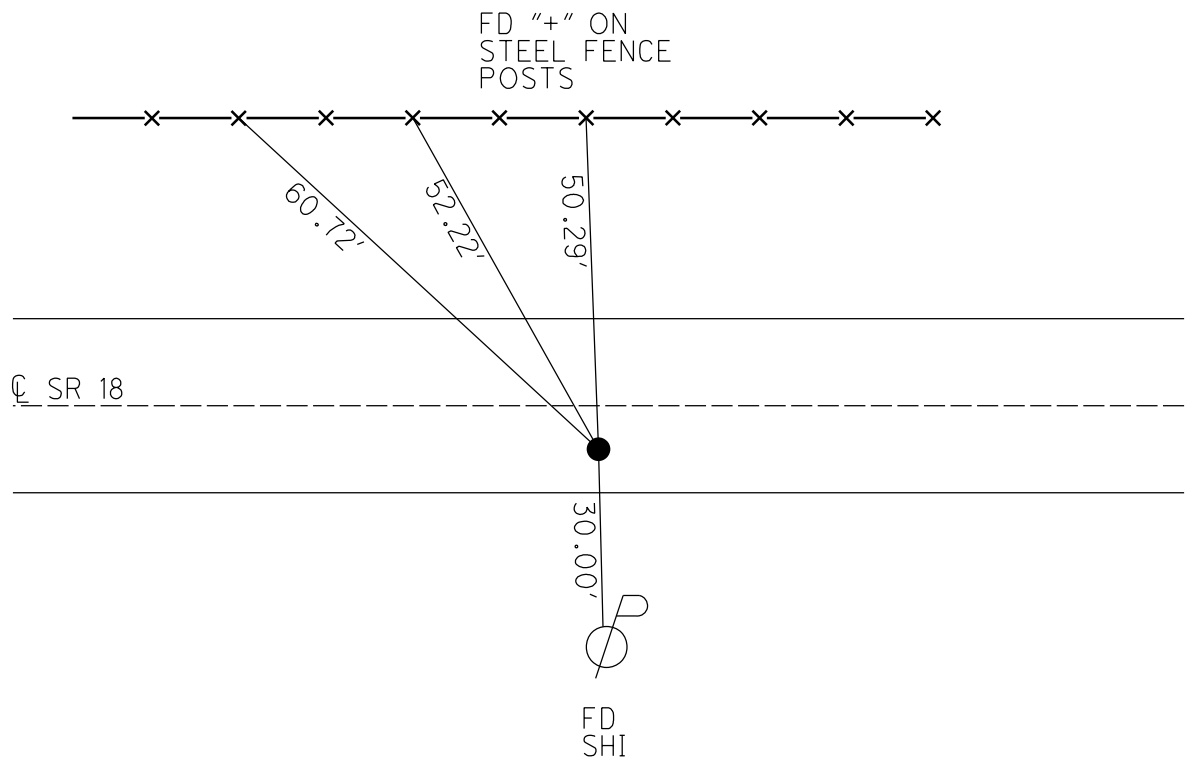

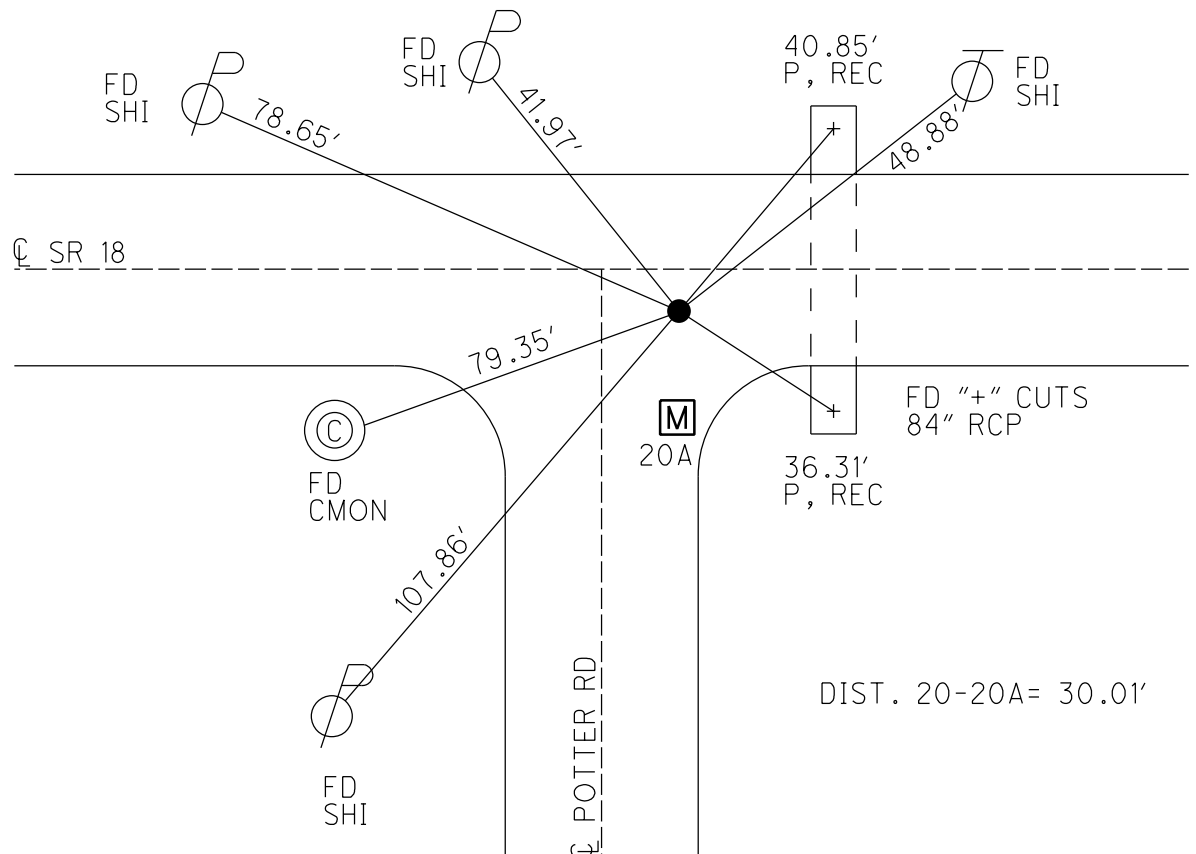

O.D.O.T. DISTRICT 2 SURVEY OFFICE (USE ONLY)

PERSONNEL

REFERENCE NO. 20 A

SHEET 5 OF 52

NOTES ASTON

DATE 5/23/24

ROUTE SR 18

H.C. NIESE

WEATHER WINDY

COUNTY WOOD

R.C. PRESTON-COLVIN

TEMP. 80°F

TOWNSHIP HENRY

SECTION 30

DWG BY BARRIERE

PID 101290

T 3 N R 10 E

TYPE MONUMENT MONBOX W/ 1" IPIN

ON SURFACE - BELOW ON

OFFSET Q PAVEMENT LT : RT

 TO EDGE PAVEMENT

STATION: 449+14.34

HORIZ.DATUM: WOOD LDP


GEOID: 18

GRID: NORTHING: 554828.910


EASTING: 1625571.963

LDP: NORTHING: 376317.714

EASTING: 137640.832

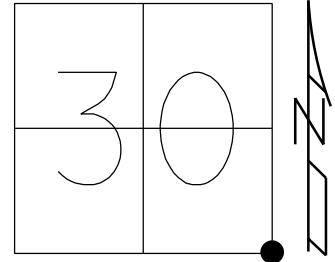

RECORD:
FD MONBOX
W/1" IPIN
5/5/21, JFO
1/21/22, TDN
REF20A
5/23/24, TDN

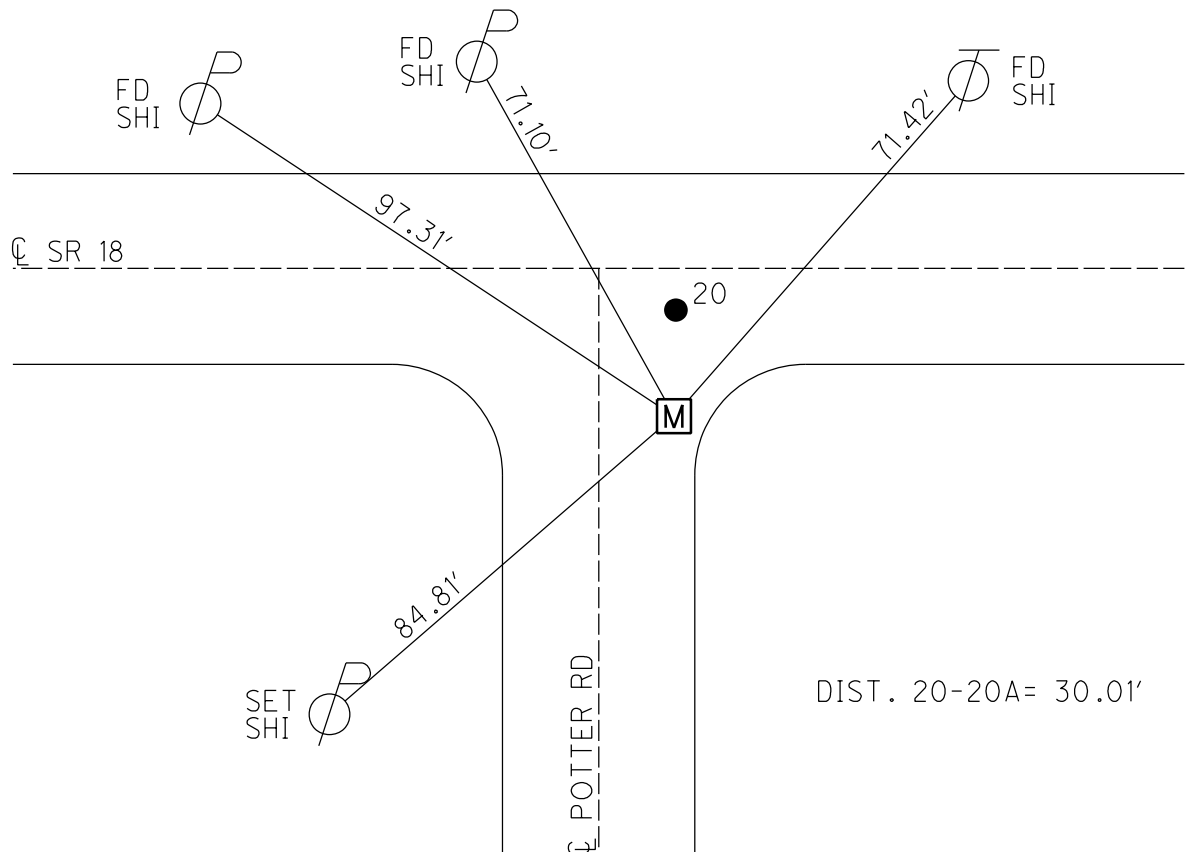

O.D.O.T. DISTRICT 2 SURVEY OFFICE (USE ONLY)

PERSONNEL

REFERENCE NO. 21

SHEET 5 OF 52

NOTES ASTON DATE 5/23/24
H.C. NIESE WEATHER WINDY
R.C. PRESTON-COLVIN TEMP. 80°F

ROUTE SR 18
COUNTY WOOD
TOWNSHIP HENRY
SECTION 29
T 3 N R 10 E

DWG BY BARRIERE PID 101290

TYPE MONUMENT MAG NAIL/WASHER

ON SURFACE - BELOW ON

OFFSET Q PAVEMENT LT : RT

TO EDGE PAVEMENT

STATION: 474+27.68

HORIZ.DATUM: WOOD LDP


GEOID: 18

GRID: NORTHING: 554816.369


EASTING: 1628085.260

LDP: NORTHING: 376338.314

EASTING: 140154.3

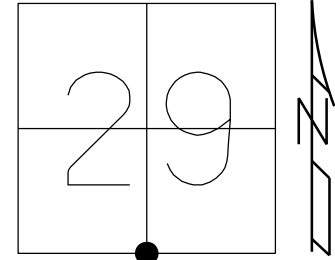

RECORD:
SET P.K./WASHER
7/7/87, CL
FD P.K. SHANK
6/16/10, BG
7/28/11, MC
SET MAG/WASHER
1/25/12, SAH
FD MAG/WASHER
REF21
6/15/20, JFO
5/5/21, JFO
1/21/22, TDN
SET MAG/WASHER
8-10-23, TDN
FD MAG/WASHER
REF21
5/23/24, TDN
10/25/24, TDN

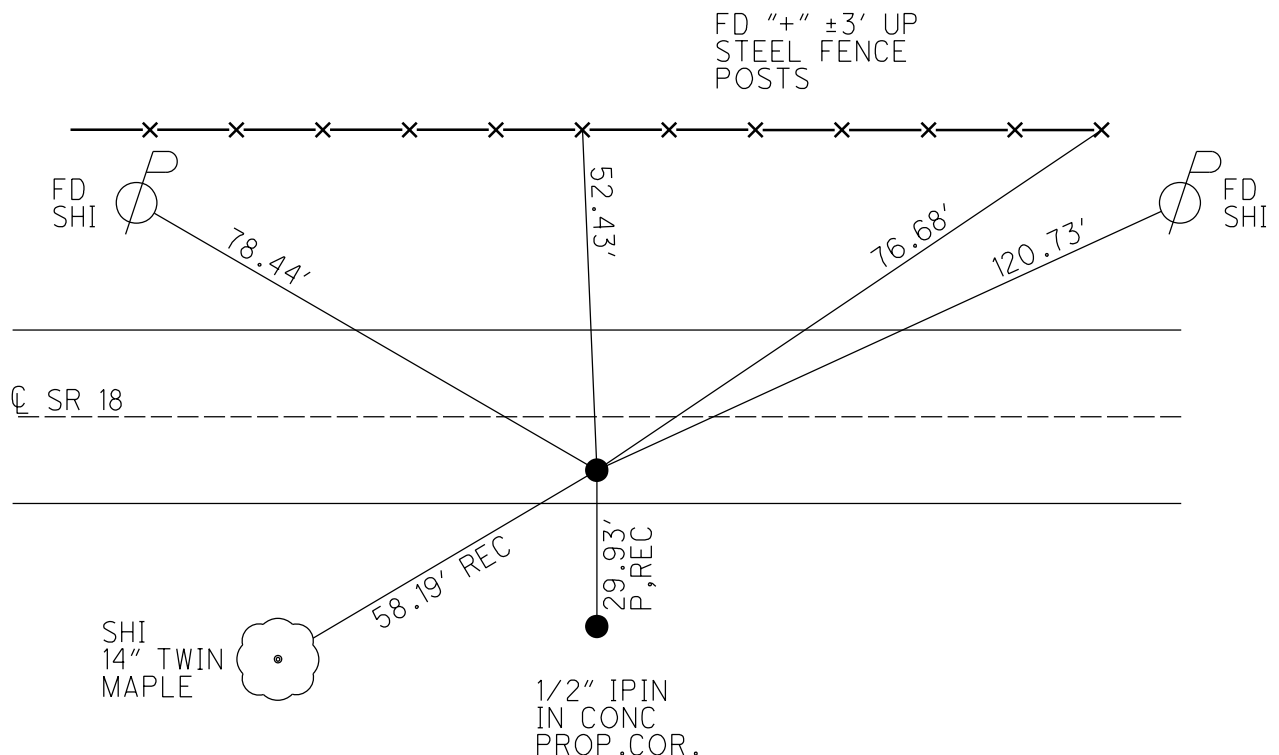

O.D.O.T. DISTRICT 2 SURVEY OFFICE (USE ONLY)

PERSONNEL

REFERENCE NO. 21 A

SHEET 5 OF 52

NOTES ASTON

DATE 5/23/24

ROUTE SR 18

H.C. NIESE

WEATHER WINDY

COUNTY WOOD

R.C. PRESTON-COLVIN

TEMP. 80°F

TOWNSHIP HENRY

SECTION 29

DWG BY BARRIERE

PID 101290

T 3 N R 10 E

TYPE MONUMENT MAG NAIL/WASHER

ON SURFACE - BELOW ON

OFFSET $\varnothing$ PAVEMENT _____ LT : RT

_____ TO _____ EDGE PAVEMENT

STATION: 475+27

HORZ.DATUM: WOOD LDP


GEOID: 18

GRID: NORTHING: 554816.442


EASTING: 1628204.518

LDP: NORTHING: 376339.923

EASTING: 140273.537

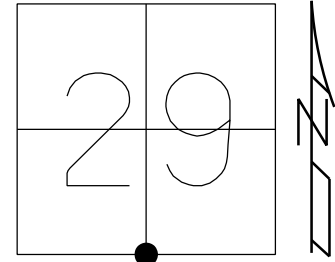

RECORD:
 SET MAG NAIL
 7/7/87, MB
 FD MAG NAIL
 7/28/11, MC
 SET MAG/WASHER
 1/31/12, SAH
 FD MAG/WASHER
 REFA21
 6/15/20, JFO
 5/5/21, JFO
 1/21/21, TDN
 8-10-23, TDN
 REF21A
 5/23/24, TDN
 10/25/24, TDN

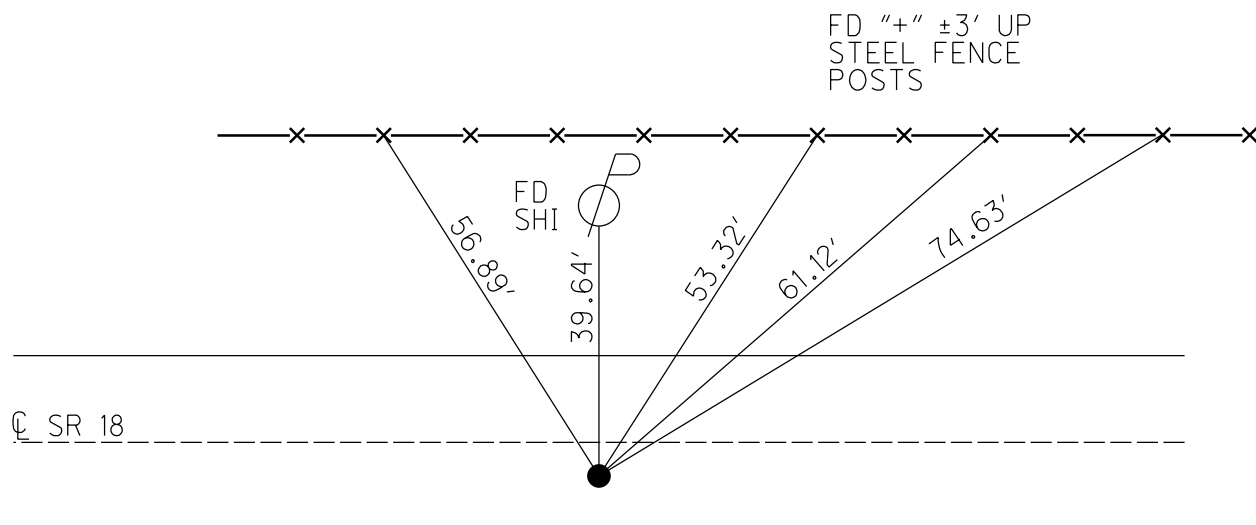

O.D.O.T. DISTRICT 2 SURVEY OFFICE (USE ONLY)

PERSONNEL

REFERENCE NO. 22

SHEET 5 OF 52

NOTES ASTON DATE 5/23/24
H.C. NIESE WEATHER SUNNY
R.C. PRESTON-COLVIN TEMP. 80°F

ROUTE SR 18
COUNTY WOOD
TOWNSHIP HENRY
SECTION 29
T 3 N R 10 E

DWG BY BARRIERE PID 101290

TYPE MONUMENT MAG NAIL/WASHER

ON SURFACE - BELOW ON

OFFSET $\odot$ PAVEMENT LT : RT


 TO EDGE PAVEMENT

STATION: 501+87.7


HORIZ.DATUM: WOOD LDP GEOID: 18

GRID: NORTHING: 554808.585 EASTING: 1630845.172

LDP: NORTHING: 376366.932 EASTING: 142914.349

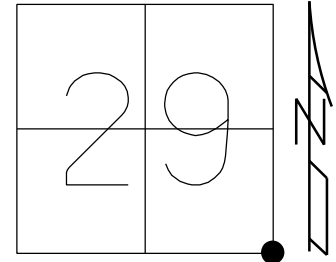

RECORD:
SET P.K./WASHER
7/7/87, CL
FD MAG NAIL
6/3/11, MC
SET MAG/WASHER
1/31/12, SAH
FD MAG/WASHER
REF22
6/15/20, JFO
SET MAG/WASHER
5/5/21, JFO
FD MAG/WASHER
1/21/21, TDN
8-10-23, TDN
REF22
5/23/24, TDN
10/25/24, TDN

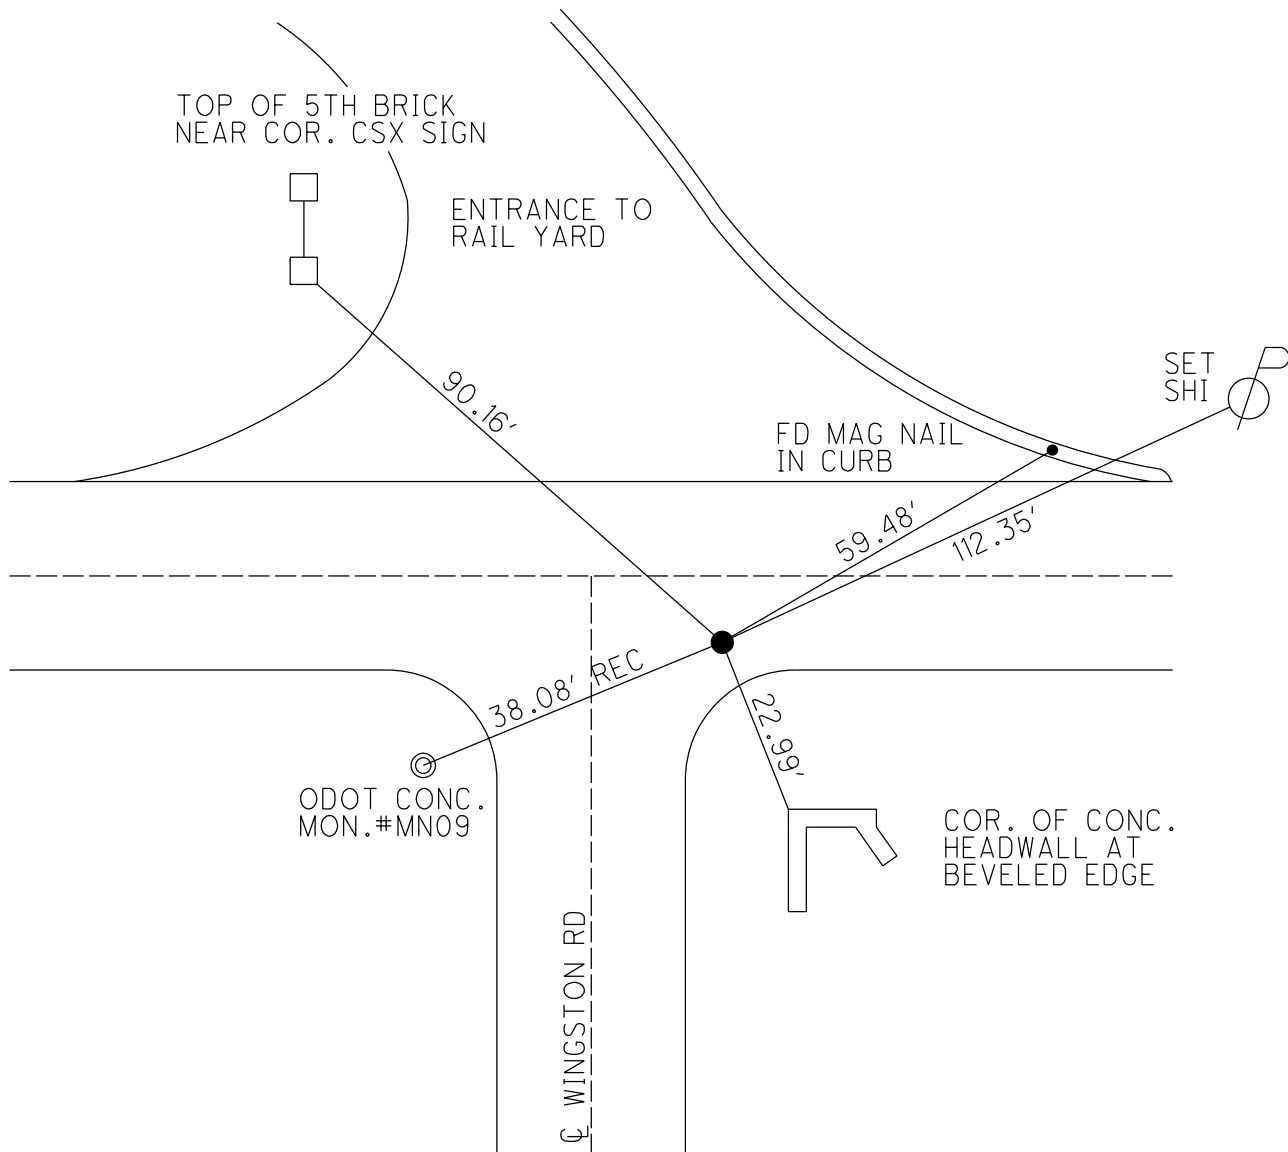

O.D.O.T. DISTRICT 2 SURVEY OFFICE (USE ONLY)

PERSONNEL

REFERENCE NO. 22 A

SHEET 5 OF 52

NOTES ASTON

DATE 5/23/24

ROUTE SR 18

H.C. NIESE

WEATHER SUNNY

COUNTY WOOD

R.C. PRESTON-COLVIN

TEMP. 80°F

TOWNSHIP HENRY

SECTION 33

DWG BY BARRIERE

PID 101290

T 3 N R 10 E

TYPE MONUMENT MAG NAIL/WASHER

ON SURFACE - BELOW ON

OFFSET Q PAVEMENT LT : RT

 TO EDGE PAVEMENT

STATION: 505+03.87

HORIZ.DATUM: WOOD LDP


GEOID: 18

GRID: NORTHING: 554804.748


EASTING: 1631161.5

LDP: NORTHING: 376367.267

EASTING: 143230.639

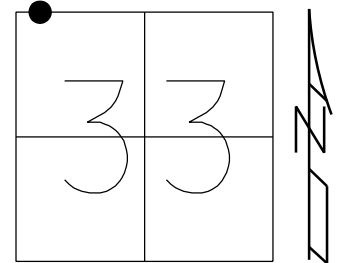

RECORD:
 SET P.K./WASHER
 7/7/87, CL
 FD P.K./WASHER
 SVA22
 6/15/10, MC
 6/3/11, MC
 SET MAG/WASHER
 REFA22
 1/31/12, SAH
 FD MAG/WASHER
 REFA21
 4/30/21, JMR
 8/19/22, DSA
 1/11/23, JMR
 8-10-23, TDN
 FD MAG/WASHER
 REF22A
 5/23/24, TDN
 SET MAG/WASHER
 10/25/24, TDN

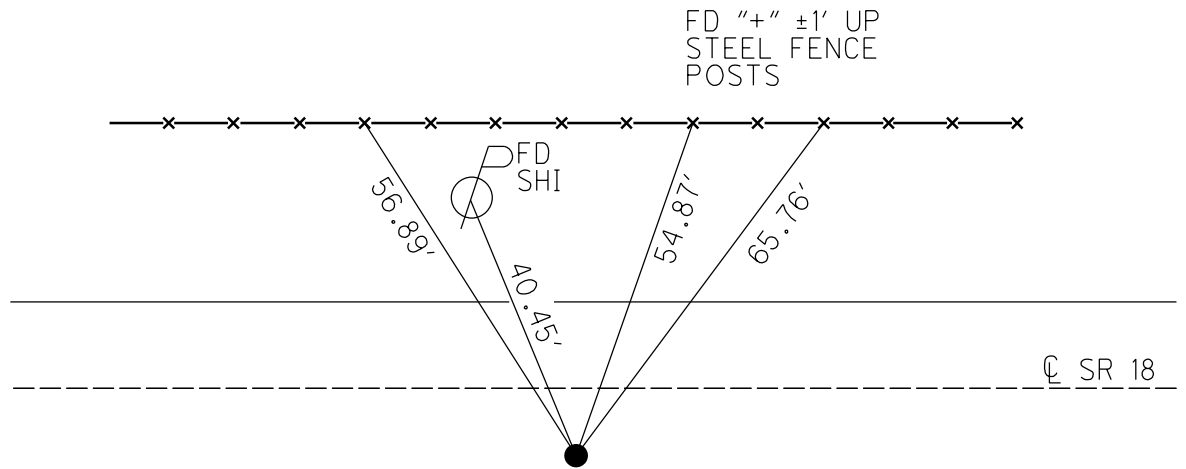

O.D.O.T. DISTRICT 2 SURVEY OFFICE (USE ONLY)

PERSONNEL

REFERENCE NO. 22 B

SHEET 5 OF 52

NOTES ASTON DATE 5/23/24
H.C. NIESE WEATHER SUNNY
R.C. PRESTON-COLVIN TEMP. 80°F

ROUTE SR 18
COUNTY WOOD
TOWNSHIP HENRY
SECTION 33

DWG BY BARRIERE PID 101290

T 3 N R 10 E

TYPE MONUMENT MAG NAIL/WASHER

ON SURFACE - BELOW ON

OFFSET $\angle$ PAVEMENT _____ LT : RT

_____ TO _____ EDGE PAVEMENT

STATION: 515+16.4

HORIZ.DATUM: WOOD LDP


GEOID: 18

GRID: NORTHING: 554792.886


EASTING: 1632173.872

LDP: NORTHING: 376368.692

EASTING: 144243.172

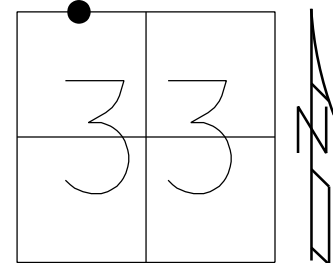

SET P.K./WASHER
7/2/87, CL
FD P.K./WASHER
AT SURFACE
6/15/10
GPS, SVB22
6/17/10, MC
SET MAG/WASHER
1/30/12
REFA22
1/31/12, SAH
FD HOLE
5-30-23, JMR
SET MAG/WASHER
BY COORD.
REF22B
8-10-23, TDN
FD MAG/WASHER
REF22B
5/23/24, TDN
SET MAG/WASHER
NEWREF22B
10/25/24, TDN

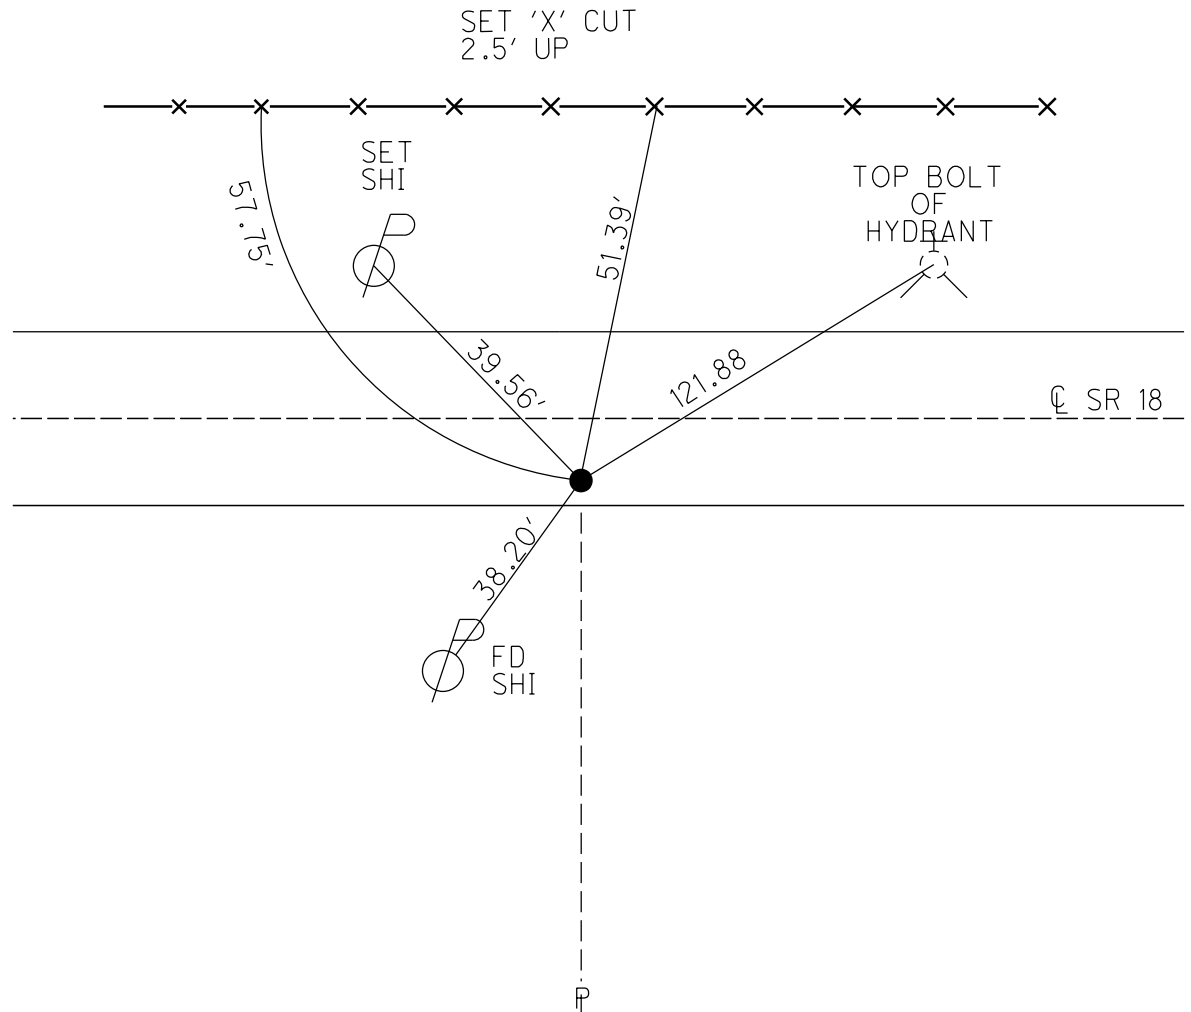

O.D.O.T. DISTRICT 2 SURVEY OFFICE (USE ONLY)

PERSONNEL

REFERENCE NO. 23

SHEET 5 OF 52

NOTES ASTON

DATE 5/23/24

ROUTE SR 18

H.C. NIESE

WEATHER SUNNY

COUNTY WOOD

R.C. PRESTON-COLVIN

TEMP. 80°F

TOWNSHIP HENRY

SECTION 33

DWG BY BARRIERE

PID 101290

T 3 N R 10 E

TYPE MONUMENT MAG NAIL/WASHER

ON SURFACE - BELOW ON

OFFSET $\varnothing$ PAVEMENT LT : RT

 TO EDGE PAVEMENT

STATION: 528+45.11

HORIZ.DATUM: WOOD LDP


GEOID: 18

GRID: NORTHING: 554776.971


EASTING: 1633502.541

LDP: NORTHING: 376370.347

EASTING: 145572.051

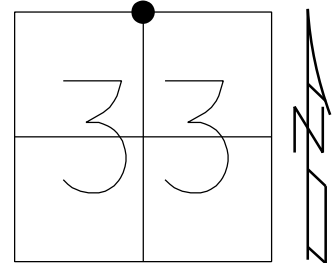

FD SM.R.R.SPIKE
AT SURFACE
6/17/87, CL
SET P.K./WASHER
7/21/87, CL
FD SM.R.R.SPIKE
0.2' BELOW
6/15/10
GPS, SV23
6/17/10, MC
SET MAG/WASHER
GPS, REF3
1/31/12, SAH
D.N.F.
5-30-23, JMR
SET MAG/WASHER
REF23
8-10-23, TDN
FD MAG/WASHER
REF23
5/23/24, TDN
10/25/24, TDN

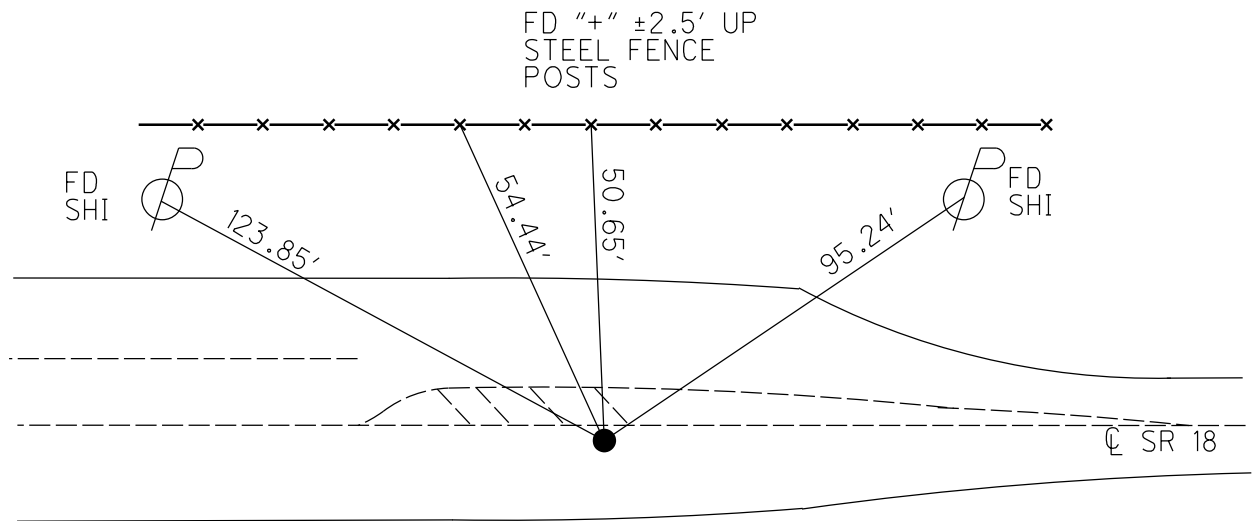

O.D.O.T. DISTRICT 2 SURVEY OFFICE (USE ONLY)

PERSONNEL

REFERENCE NO. 23 A

SHEET 5 OF 52

NOTES ASTON DATE 5/23/24
H.C. NIESE WEATHER SUNNY
R.C. PRESTON-COLVIN TEMP. 80°F

ROUTE SR 18
COUNTY WOOD
TOWNSHIP HENRY
SECTION 33

DWG BY BARRIERE PID 101290

T 3 N R 10 E

TYPE MONUMENT MONBOX W/ 1" IPIN

ON SURFACE - BELOW ON

OFFSET Q PAVEMENT LT : RT

 TO EDGE PAVEMENT

STATION: 538+36.70

HORZ.DATUM: WOOD LDP


GEOID: 18

GRID: NORTHING: 554775.330


EASTING: 1634401.870

LDP: NORTHING: 376380.576

EASTING: 146471.378

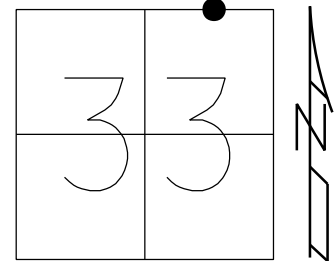

RECORD: T.S
STA. 538+36.70
FD MONBOX
W/1" IPIN
REFA23
6-15-20, JFO
FD MONBOX
W/1" IPIN
REFA23
5/23/24, TDN

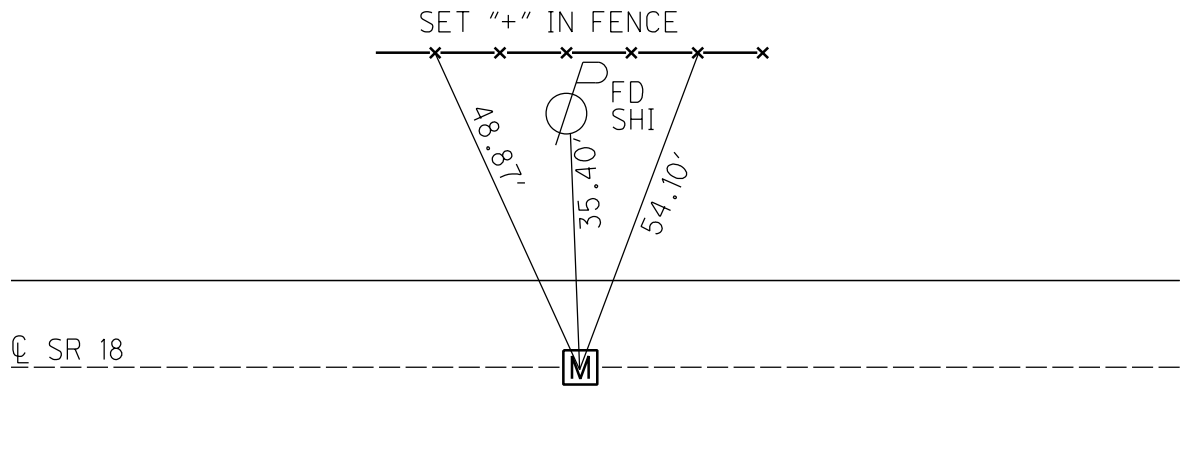

O.D.O.T. DISTRICT 2 SURVEY OFFICE (USE ONLY)

PERSONNEL

REFERENCE NO. 24

SHEET 5 OF 52

NOTES ASTON

DATE 5/23/24

ROUTE SR 18

H.C. NIESE

WEATHER SUNNY

COUNTY WOOD

R.C. PRESTON-COLVIN

TEMP. 80°F

TOWNSHIP HENRY

DWG BY BARRIERE

PID 101290

SECTION 33

T 3 N R 10 E

TYPE MONUMENT MONBOX W/ 1" IPIN

ON SURFACE - BELOW ON

OFFSET CL PAVEMENT LT : RT

 TO EDGE PAVEMENT

STATION: 540+50.70

HORZ.DATUM: WOOD LDP


GEOID: 18

GRID: NORTHING: 554768.301


EASTING: 1634615.622

LDP: NORTHING: 376376.325

EASTING: 146685.263

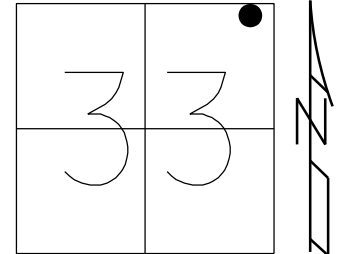

RECORD: S.C.
STA. 540+50.70
FD MONBOX
W/1" IPIN
REF24
6-15-20, JFO
FD MONBOX
W/1" IPIN
REF24
5/23/24, TDN

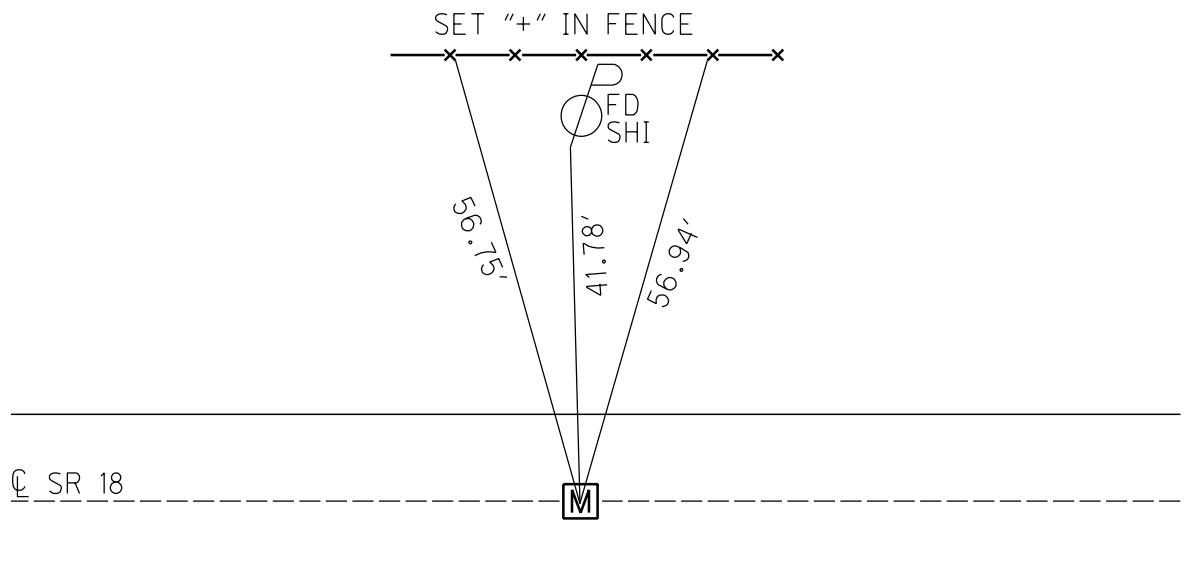

O.D.O.T. DISTRICT 2 SURVEY OFFICE (USE ONLY)

PERSONNEL

REFERENCE NO. 24 A

SHEET 5 OF 52

NOTES ASTON DATE 5/22/24
H.C. NIESE WEATHER SUNNY
R.C. PRESTON-COLVIN TEMP. 80°F

ROUTE SR 18
COUNTY WOOD
TOWNSHIP HENRY
SECTION 33

DWG BY BARRIERE PID 101290

T 3 N R 10 E

TYPE MONUMENT MONBOX W/ 1" IPIN

ON SURFACE - BELOW ON

OFFSET $\varnothing$ PAVEMENT _____ LT : RT

_____ TO _____ EDGE PAVEMENT

STATION: 543+69.18

HORZ.DATUM: WOOD LDP


GEOID: 18

GRID: NORTHING: 554700.829


EASTING: 1634925.999

LDP: NORTHING: 376312.942

EASTING: 146996.510

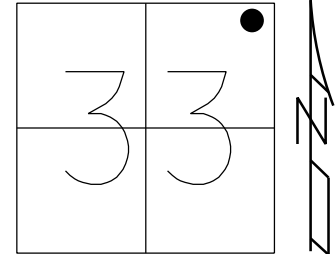

RECORD: CS
STA. 543+69.18
FD MONBOX
W/1" IPIN
REFA24
6-15-20, JFO
FD MONBOX, NO LID
W/1" IPIN
REF42A
5/22/24, TDN

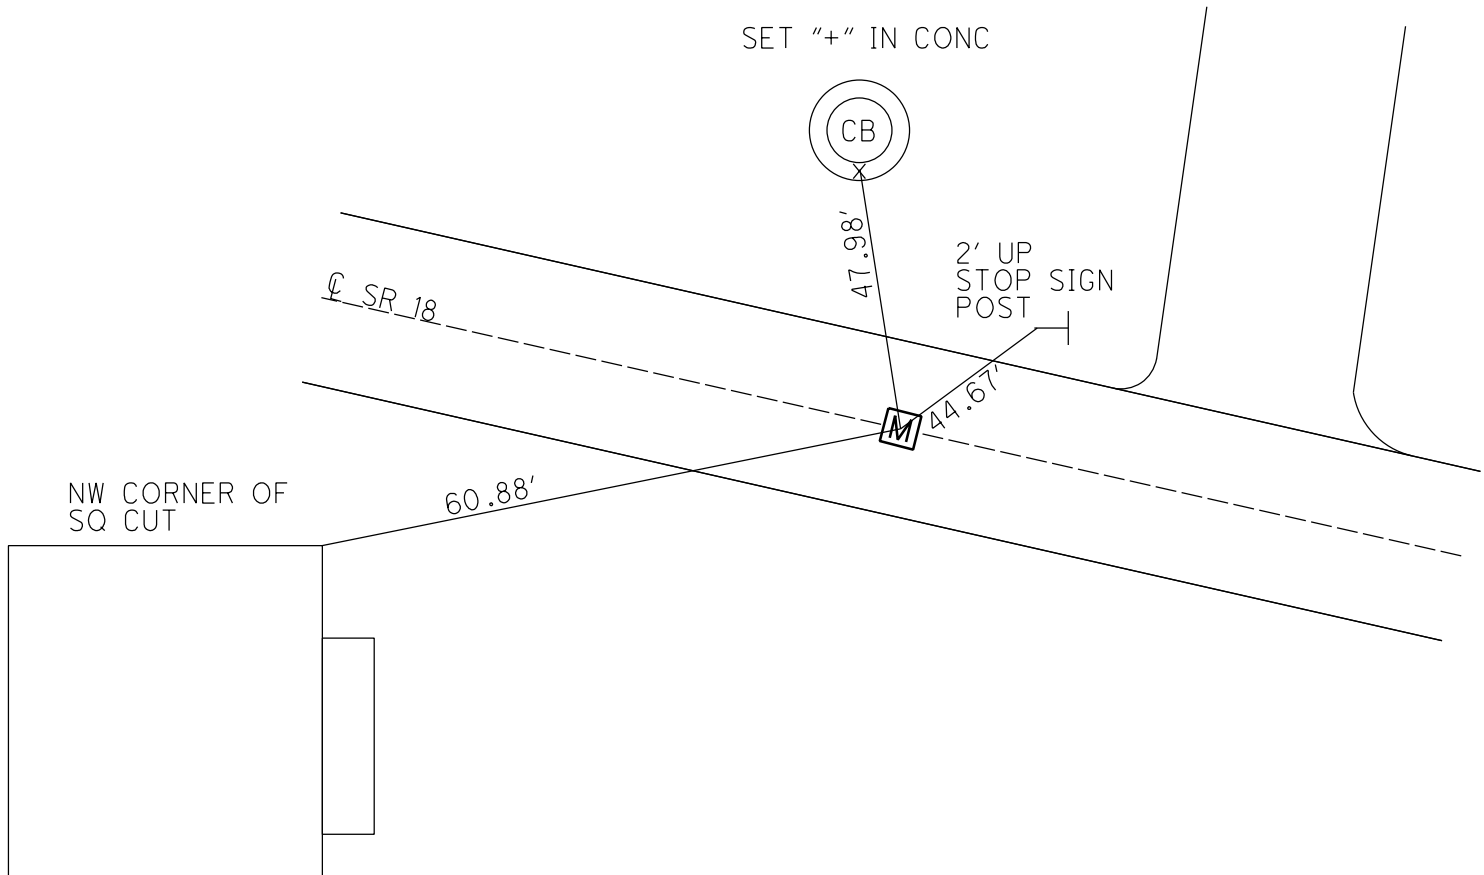

O.D.O.T. DISTRICT 2 SURVEY OFFICE (USE ONLY)

PERSONNEL

REFERENCE NO. 24 B

SHEET 24 OF 51

NOTES RHOADES

DATE 6-15-20

ROUTE SR 18

H.C. O'DONNELL

WEATHER SUNNY

COUNTY WOOD

R.C. MAHLER

TEMP. 75°F

TOWNSHIP HENRY

SECTION 33

DWG BY MAHLER

PID PAVETRAIN

T 3 N R 10 E

TYPE MONUMENT MONBOX W/1" IPIN

ON SURFACE - ~~BELOW~~ ON

OFFSET Q PAVEMENT LT : RT

 TO EDGE PAVEMENT


STATION: 544+69.21

HORZ.DATUM: NAD83 (2011)

GEOID: NAVD88-2012A


GRID: NORTHING: 554618.418

EASTING: 1635123.507

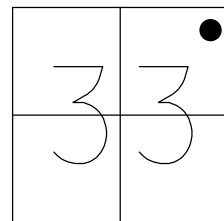

RECORD:
CULVERT Q
STA. 544+69.21
FD MONBOX
W/1" IPIN
REFB24
6-15-20, JFO

DIST. 24B-24C=27.28'

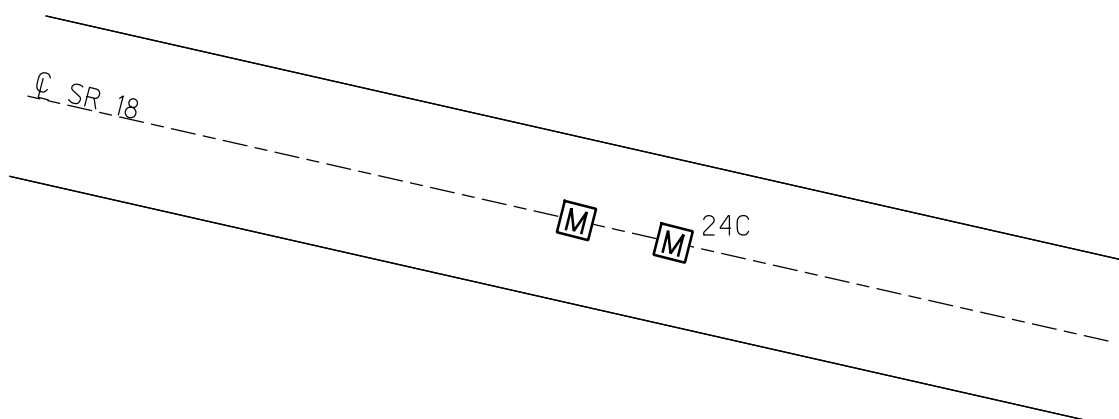

O.D.O.T. DISTRICT 2 SURVEY OFFICE (USE ONLY)

PERSONNEL

REFERENCE NO. 24 C

SHEET 25 OF 51

NOTES RHOADES

DATE 6-15-20

ROUTE SR 18

H.C. O'DONNELL

WEATHER SUNNY

COUNTY WOOD

R.C. MAHLER

TEMP. 75°F

TOWNSHIP HENRY

SECTION 33

DWG BY MAHLER

PID PAVETRAIN

T 3 N R 10 E

TYPE MONUMENT MONBOX W/1" IPIN

ON SURFACE - ~~BELOW~~ ON

OFFSET CL PAVEMENT LT : RT

- TO - EDGE PAVEMENT


STATION: 545+96.99

HORIZ.DATUM: NAD83 (2011)

GEOID: NAVD88-2012A


GRID: NORTHING: 554612.765

EASTING: 1635136.079

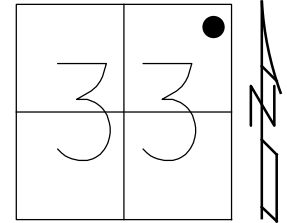

RECORD: TS
STA. 545+96.99
FD MONBOX
W/1" IPIN
REFC24
6-15-20, JFO

DIST. 24B-24C=27.28'

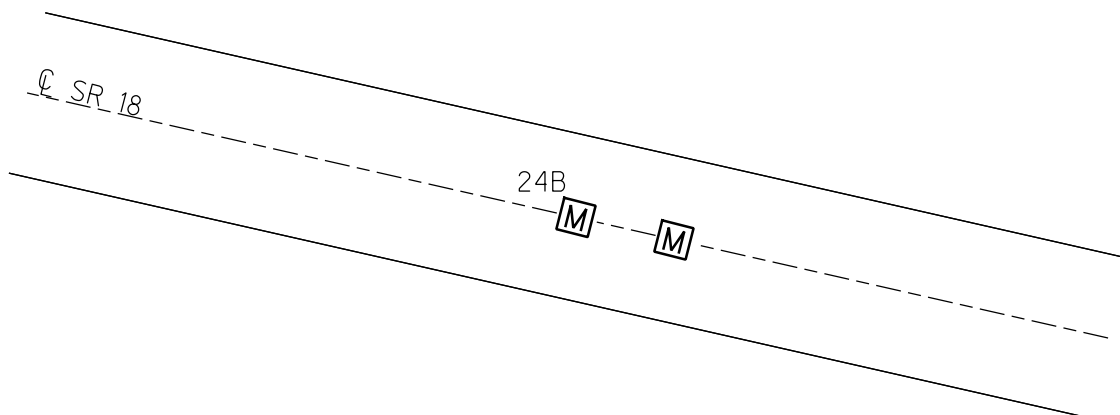

O.D.O.T. DISTRICT 2 SURVEY OFFICE (USE ONLY)

PERSONNEL

REFERENCE NO. 24 D

SHEET 26 OF 51

NOTES RHOADES

DATE 6-15-20

ROUTE SR 18

H.C. O'DONNELL

WEATHER SUNNY

COUNTY WOOD

R.C. MAHLER

TEMP. 75°F

TOWNSHIP HENRY

SECTION 33

DWG BY MAHLER

PID PAVETRAIN

T 3 N R 10 E

TYPE MONUMENT MONBOX W/1" IPIN

ON SURFACE - ~~BELOW~~ ON

OFFSET Q PAVEMENT LT : RT

- TO - EDGE PAVEMENT


STATION: 548+10.99

HORZ.DATUM: NAD83 (2011)


GEOID: NAVD88-2012A

GRID: NORTHING: 554530.462

EASTING: 1635333.510

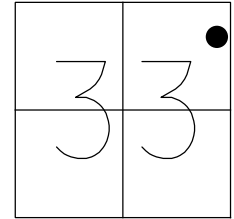

RECORD: SC
STA. 548+10.99
FD MONBOX
W/1" IPIN
REFD24
6-15-20, JFO

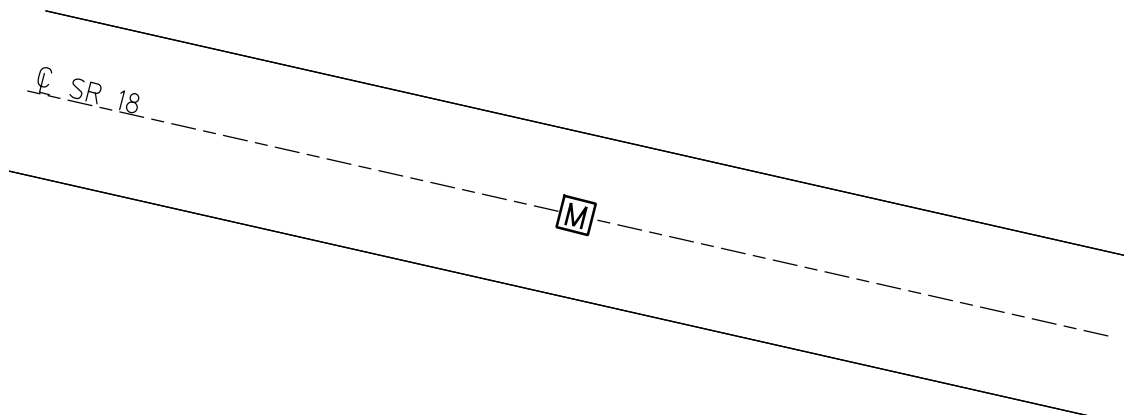

O.D.O.T. DISTRICT 2 SURVEY OFFICE (USE ONLY)

PERSONNEL

REFERENCE NO. 24 E

SHEET 27 OF 51

NOTES RHOADES

DATE 6-15-20

ROUTE SR 18

H.C. O'DONNELL

WEATHER SUNNY

COUNTY WOOD

R.C. MAHLER

TEMP. 75°F

TOWNSHIP HENRY

SECTION 33

DWG BY MAHLER

PID PAVETRAIN

T 3 N R 10 E

TYPE MONUMENT MONBOX W/1" IPIN

ON SURFACE - ~~BELOW~~ ON

OFFSET ☉ PAVEMENT LT : RT

- TO - EDGE PAVEMENT


STATION: 551+18.78

HORZ.DATUM: NAD83 (2011)

GEOID: NAVD88-2012A

GRID: NORTHING: 554464.004

EASTING: 1635633.186

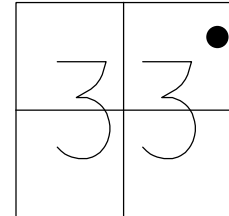

RECORD: CS
STA. 551+18.78
FD MONBOX
W/1" IPIN
REFE24
6-15-20, JFO

☉ SR 18 [M]

O.D.O.T. DISTRICT 2 SURVEY OFFICE (USE ONLY)

PERSONNEL

REFERENCE NO. 24 F

SHEET 28 OF 51

NOTES RHOADES

DATE 6-15-20

ROUTE SR 18

H.C. O'DONNELL

WEATHER SUNNY

COUNTY WOOD

R.C. MAHLER

TEMP. 75°F

TOWNSHIP HENRY

SECTION 33

DWG BY MAHLER

PID PAVETRAIN

T 3 N R 10 E

TYPE MONUMENT MONBOX W/1" IPIN

ON SURFACE - ~~BELOW~~ ON

OFFSET Q PAVEMENT LT : RT

- TO - EDGE PAVEMENT


STATION: 553+32.78

HORZ.DATUM: NAD83 (2011)

GEOID: NAVD88-2012A

GRID: NORTHING: 554455.078

EASTING: 1635847.078

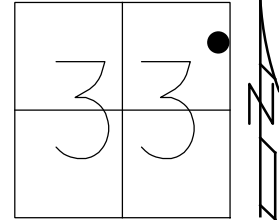

RECORD: ST
STA. 553+32.78
FD MONBOX
W/1" IPIN
REFF24
6-15-20, JFO

Q SR 18



O.D.O.T. DISTRICT 2 SURVEY OFFICE (USE ONLY)

PERSONNEL

REFERENCE NO. 25

SHEET 29 OF 51

NOTES RHOADES

DATE 6-15-20

ROUTE SR 18

H.C. O'DONNELL

WEATHER SUNNY

COUNTY WOOD

R.C. MAHLER

TEMP. 75°F

TOWNSHIP HENRY

SECTION 33

DWG BY MAHLER

PID PAVETRAIN

T 3 N R 10 E

TYPE MONUMENT MONBOX

ON SURFACE - ~~BELOW~~ ON

OFFSET CL PAVEMENT LT : RT

- TO - EDGE PAVEMENT


STATION: 556+84.21

HORZ.DATUM: NAD83 (2011)

GEOID: NAVD88-2012A

GRID: NORTHING: 554450.361

EASTING: 1636198.323

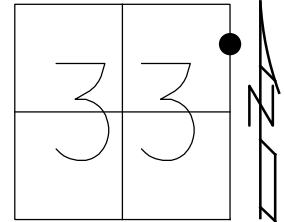

RECORD: P.O.T.
STA. 556+84.21-W
FD MONBOX
W/HOLE, NO IPIN
REF25
6-15-20, JFO

DIST. 25-25A=6.18'

CL SR 18

M

M

25A

CL LIBERTY HI RD

O.D.O.T. DISTRICT 2 SURVEY OFFICE (USE ONLY)

PERSONNEL

REFERENCE NO. 25 A

SHEET 30 OF 51

NOTES RHOADES

DATE 6-15-20

ROUTE SR 18

H.C. O'DONNELL

WEATHER SUNNY

COUNTY WOOD

R.C. MAHLER

TEMP. 75°F

TOWNSHIP HENRY

SECTION 33

DWG BY MAHLER PID PAVETRAIN

T 3 N R 10 E

TYPE MONUMENT MONBOX

ON SURFACE - ~~BELOW~~ ON

OFFSET CL PAVEMENT LT : RT

- TO - EDGE PAVEMENT


STATION: 100+00 (2011 PLAN)

HORIZ.DATUM: NAD83 (2011)

GEOID: NAVD88-2012A


GRID: NORTHING: 554444.183

EASTING: 1636197.781

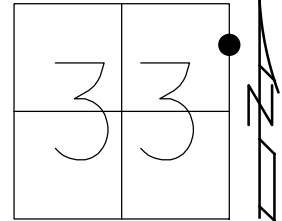

RECORD: P.O.T.
2011 PLAN
STA. 100+00-E
FD MONBOX
SHOT LID
REFA25
6-15-20, JFO

DIST. 25-25A=6.18'

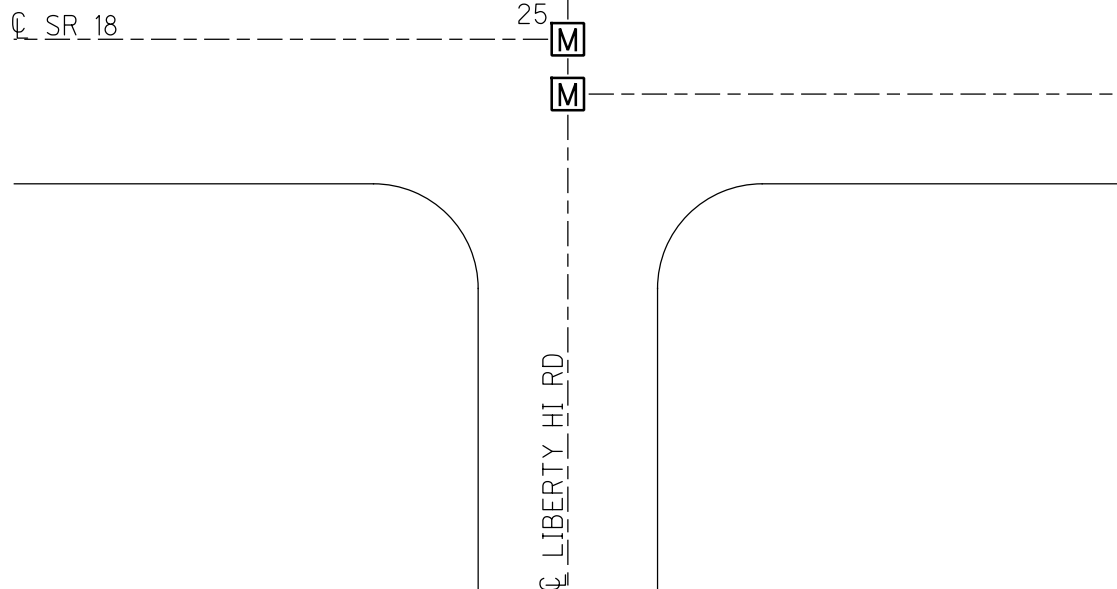

O.D.O.T. DISTRICT 2 SURVEY OFFICE (USE ONLY)

PERSONNEL

REFERENCE NO. 25 B

SHEET 31 OF 51

NOTES RHOADES

DATE 6-16-20

ROUTE SR 18

H.C. O'DONNELL

WEATHER SUNNY

COUNTY WOOD

R.C. MAHLER

TEMP. 75°F

TOWNSHIP HENRY

SECTION 34

DWG BY MAHLER

PID PAVETRAIN

T 3 N R 10 E

TYPE MONUMENT MONBOX W/ 3/4" IPIN

ON SURFACE - ~~BELOW~~ ON

OFFSET ℄ PAVEMENT LT : RT

 TO EDGE PAVEMENT


STATION: 101+80.47 (2011 PLAN)

HORZ.DATUM: NAD83 (2011)

GEOID: NAVD88-2012A

GRID: NORTHING: 554441.825

EASTING: 1636378.156

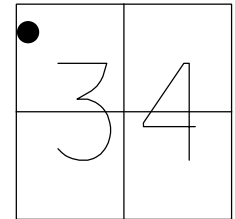

RECORD: T.S.
2011 PLAN
STA. 101+80.47
FD MONBOX
W/ 3/4" IPIN
REFB25
6-16-20,JFO

℄ SR 18

M

O.D.O.T. DISTRICT 2 SURVEY OFFICE (USE ONLY)

PERSONNEL

REFERENCE NO. 25 C

SHEET 32 OF 51

NOTES RHOADES
H.C. O'DONNELL
R.C. MAHLER

DATE 6-16-20
WEATHER SUNNY
TEMP. 75°F

ROUTE SR 18
COUNTY WOOD
TOWNSHIP HENRY
SECTION 34

DWG BY MAHLER PID PAVETRAIN

T 3 N R 10 E

TYPE MONUMENT MONBOX W/ 3/4" IPIN

ON SURFACE - ~~BELOW~~ ON

OFFSET Q PAVEMENT LT : RT

- TO - EDGE PAVEMENT


STATION: 105+10.47 (2011 PLAN)

HORZ.DATUM: NAD83 (2011)


GEOID: NAVD88-2012A

GRID: NORTHING: 554423.147

EASTING: 1636707.378

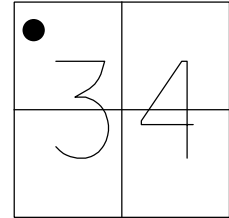

RECORD: S.C.
2011 PLAN
STA. 105+10.47
FD MONBOX
W/ 3/4" IPIN
REFC25
6-16-20, JFO

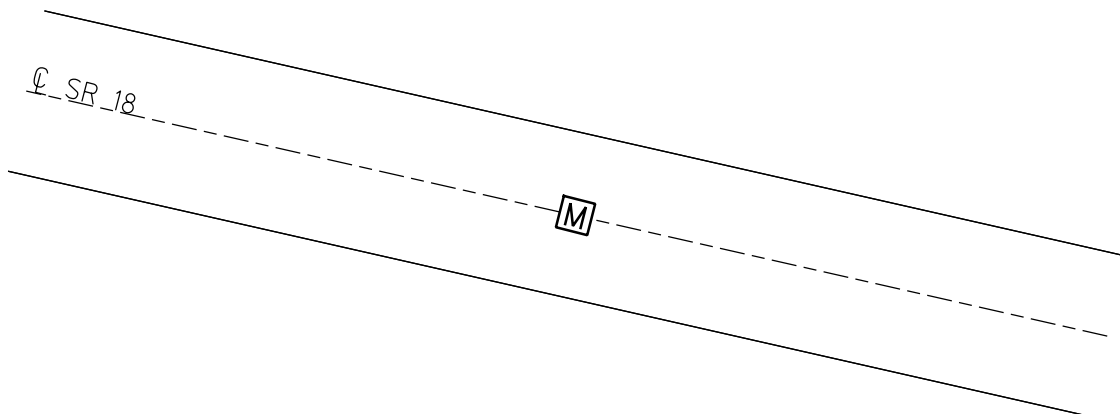

O.D.O.T. DISTRICT 2 SURVEY OFFICE (USE ONLY)

PERSONNEL

REFERENCE NO. 26

SHEET 33 OF 51

NOTES RHOADES

DATE 6-16-20

ROUTE SR 18

H.C. O'DONNELL

WEATHER SUNNY

COUNTY WOOD

R.C. MAHLER

TEMP. 75°F

TOWNSHIP HENRY

SECTION 34

DWG BY MAHLER PID PAVETRAIN

T 3 N R 10 E

TYPE MONUMENT MONBOX W/ 3/4" IPIN

ON SURFACE - ~~BELOW~~ ON

OFFSET CL PAVEMENT LT : RT

- TO - EDGE PAVEMENT


STATION: 110+00 (2011 PLAN)

HORZ.DATUM: NAD83 (2011)


GEOID: NAVD88-2012A

GRID: NORTHING: 554263.059

EASTING: 1637166.728

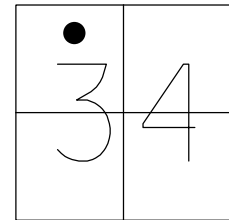

RECORD:
2011 PLAN
STA. 110+00
FD MONBOX
W/ 3/4" IPIN
REF26
6-16-20, JFO

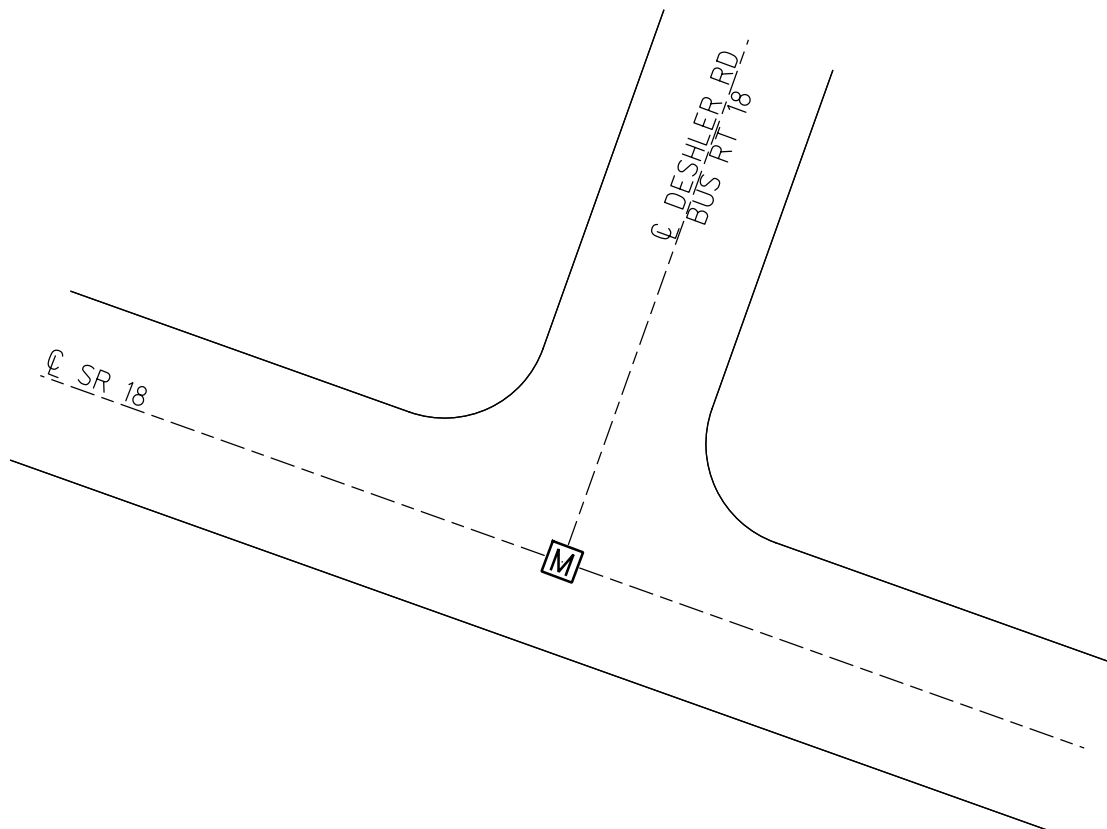

O.D.O.T. DISTRICT 2 SURVEY OFFICE (USE ONLY)

PERSONNEL

REFERENCE NO. 26 A

SHEET 34 OF 51

NOTES RHOADES

DATE 6-16-20

ROUTE SR 18

H.C. O'DONNELL

WEATHER SUNNY

COUNTY WOOD

R.C. MAHLER

TEMP. 75°F

TOWNSHIP HENRY

SECTION 34

DWG BY MAHLER PID PAVETRAIN

T 3 N R 10 E

TYPE MONUMENT MONBOX

ON SURFACE - ~~BELOW~~ ON

OFFSET Q PAVEMENT LT : RT

- TO - EDGE PAVEMENT


STATION: 12+15.70 (2011 PLAN)

HORZ.DATUM: NAD83 (2011)


GEOID: NAVD88-2012A

GRID: NORTHING: 553374.678

EASTING: 1637781.220

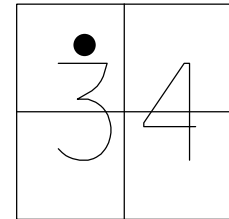

RECORD: C.S.
2011 PLAN
STA. 12+15.70
FD MONBOX
STRATS PULLED
TOP BOX SHOT
REFA26
6-16-20, JFO

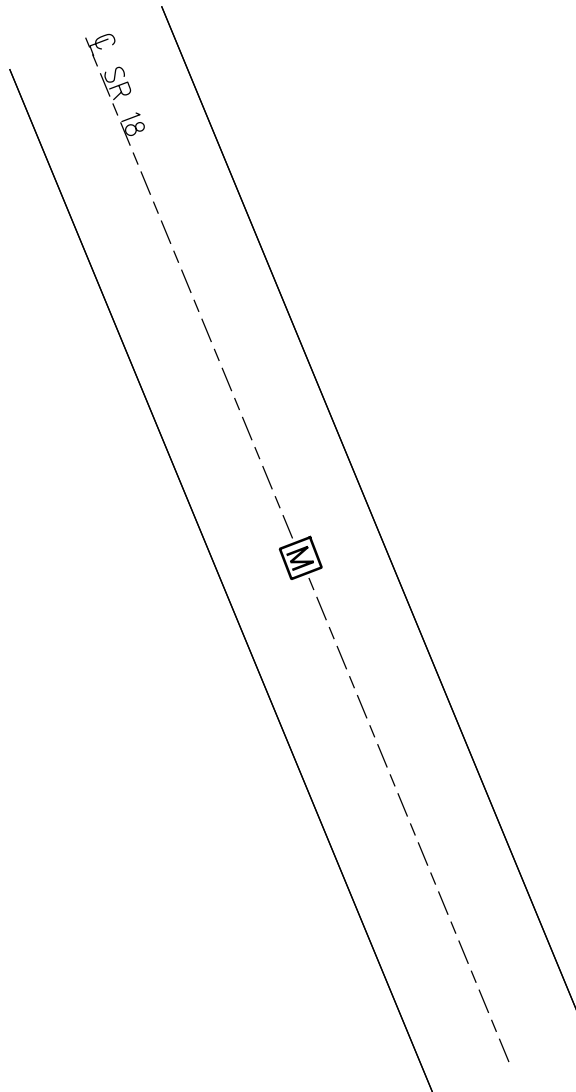

O.D.O.T. DISTRICT 2 SURVEY OFFICE (USE ONLY)

PERSONNEL

REFERENCE NO. 26 B

SHEET 35 OF 51

NOTES RHOADES

DATE 6-16-20

ROUTE SR 18

H.C. O'DONNELL

WEATHER SUNNY

COUNTY WOOD

R.C. MAHLER

TEMP. 75°F

TOWNSHIP HENRY

SECTION 34

DWG BY MAHLER PID PAVETRAIN

T 3 N R 10 E

TYPE MONUMENT MONBOX

ON SURFACE - ~~BELOW~~ ON

OFFSET Q PAVEMENT LT : RT

 TO EDGE PAVEMENT


STATION: 124+45.70 (2011 PLAN)

HORZ.DATUM: NAD83 (2011)


GEOID: NAVD88-2012A

GRID: NORTHING: 553045.971

EASTING: 1637807.763

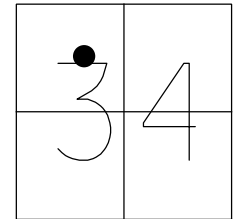

RECORD: S.T.
2011 PLAN
STA. 124+45.70
FD MONBOX
STRATS PULLED
SHOT TOP BOX
REFB26
6-16-20, JFO

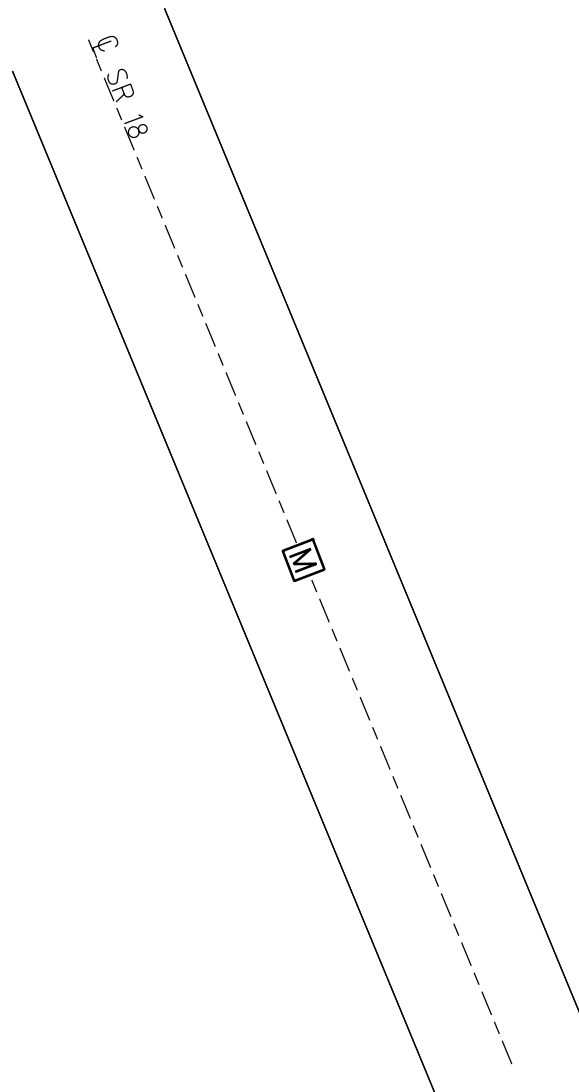

O.D.O.T. DISTRICT 2 SURVEY OFFICE (USE ONLY)

PERSONNEL

REFERENCE NO. 26 C

SHEET 36 OF 51

NOTES RHOADES

DATE 6-16-20

ROUTE SR 18

H.C. O'DONNELL

WEATHER SUNNY

COUNTY WOOD

R.C. MAHLER

TEMP. 75°F

TOWNSHIP HENRY

DWG BY MAHLER

PID PAVETRAIN

SECTION 34

T 3 N R 10 E

TYPE MONUMENT MONBOX W/STRATS

ON SURFACE - ~~BELOW~~ ON

OFFSET Q PAVEMENT LT : RT

- TO - EDGE PAVEMENT


STATION: 127+46.20 (2011 PLAN)

HORZ.DATUM: NAD83 (2011)


GEOID: NAVD88-2012A

GRID: NORTHING: 552745.749

EASTING: 1637818.937

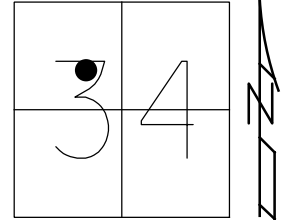

RECORD: T.S.
2011 PLAN
STA. 127+46.20
FD MONBOX
STRATS PULLED
SHOT TOP BOX
REFC26
6-16-20, JFO

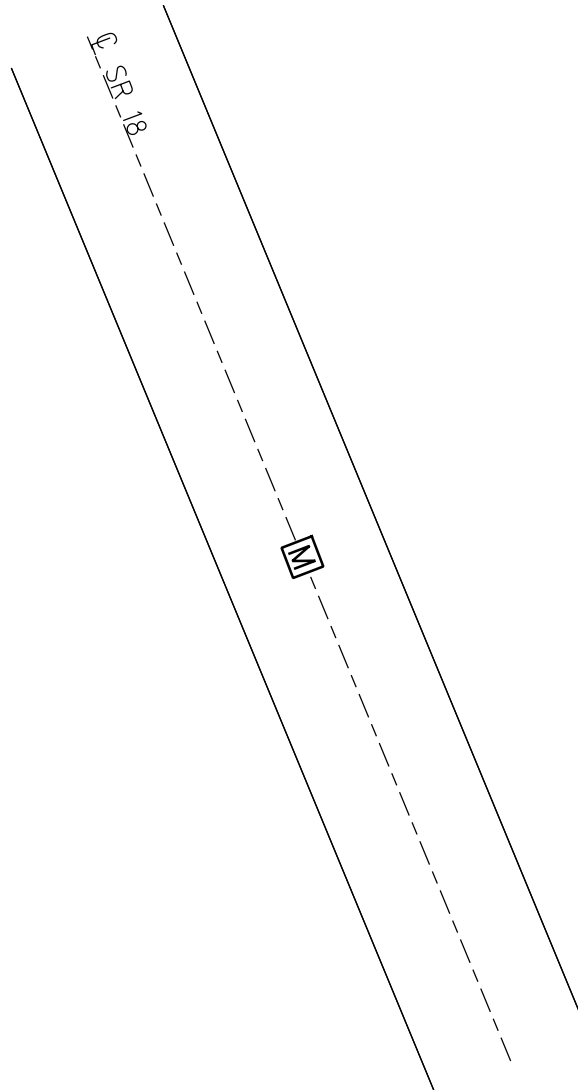

O.D.O.T. DISTRICT 2 SURVEY OFFICE (USE ONLY)

PERSONNEL

REFERENCE NO. 26 D

SHEET 37 OF 51

NOTES RHOADES

DATE 6-16-20

ROUTE SR 18

H.C. O'DONNELL

WEATHER SUNNY

COUNTY WOOD

R.C. MAHLER

TEMP. 75°F

TOWNSHIP HENRY

DWG BY MAHLER

PID PAVETRAIN

SECTION 34

T 3 N R 10 E

TYPE MONUMENT MONBOX W/STRATS

ON SURFACE - ~~BELOW~~ ON

OFFSET 0 PAVEMENT LT : RT

- TO - EDGE PAVEMENT


STATION: 130+76.20 (2011 PLAN)

HORIZ.DATUM: NAD83 (2011)


GEOID: NAVD88-2012A

GRID: NORTHING: 552417.080

EASTING: 1637845.530

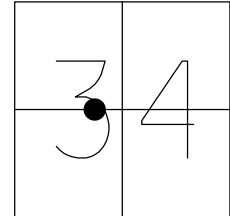

RECORD: S.C.
2011 PLAN
STA. 130+76.20
FD MONBOX
STRATS PULLED
SHOT TOP BOX
REFD26
6-16-20, JFO

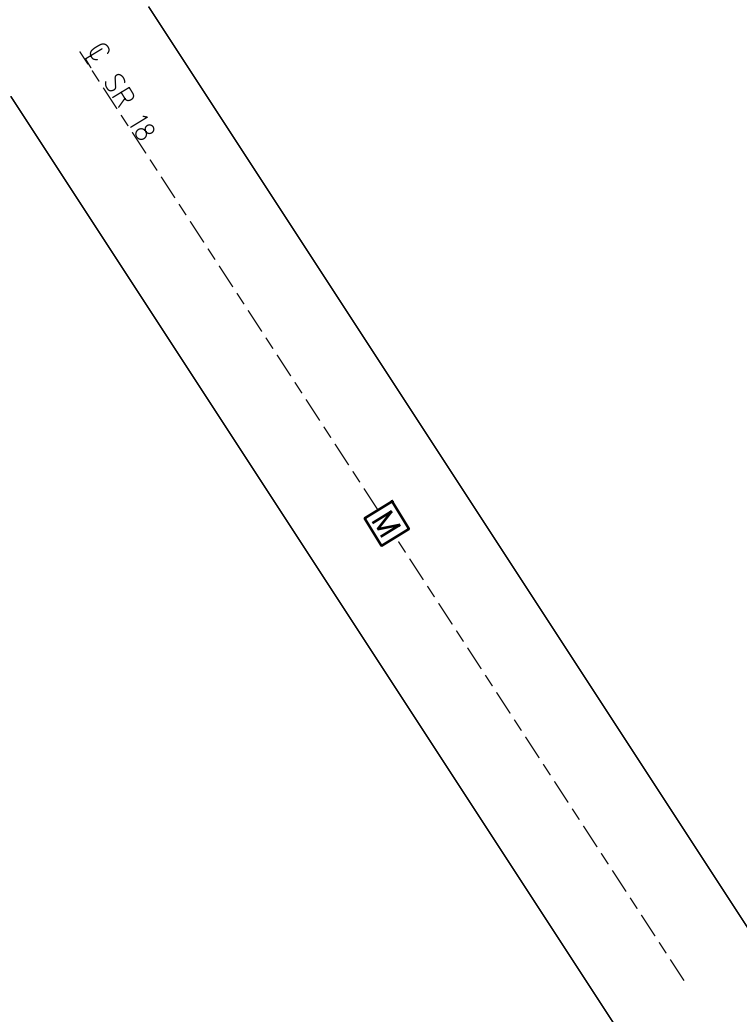

O.D.O.T. DISTRICT 2 SURVEY OFFICE (USE ONLY)

PERSONNEL

REFERENCE NO. 27

SHEET 38 OF 51

NOTES RHOADES

DATE 6-16-20

ROUTE SR 18

H.C. O'DONNELL

WEATHER SUNNY

COUNTY WOOD

R.C. MAHLER

TEMP. 75°F

TOWNSHIP HENRY

DWG BY MAHLER

PID PAVETRAIN

SECTION 34

T 3 N R 10 E

TYPE MONUMENT MONBOX W/STRATS

ON SURFACE - ~~BELOW~~ ON

OFFSET Q PAVEMENT LT : RT

- TO - EDGE PAVEMENT


STATION: 145+70.16 (2011 PLAN)

HORIZ.DATUM: NAD83 (2011)

GEOID: NAVD88-2012A


GRID: NORTHING: 551388.233

EASTING: 1638814.070

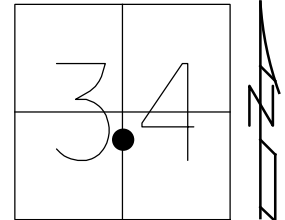

RECORD:
2011 PLAN
STA. 145+70.16
FD MONBOX
PULLED STRATS
SHOT TOP BOX
REF27
6-16-20, JFO

DIST. 27-27A=85.44'

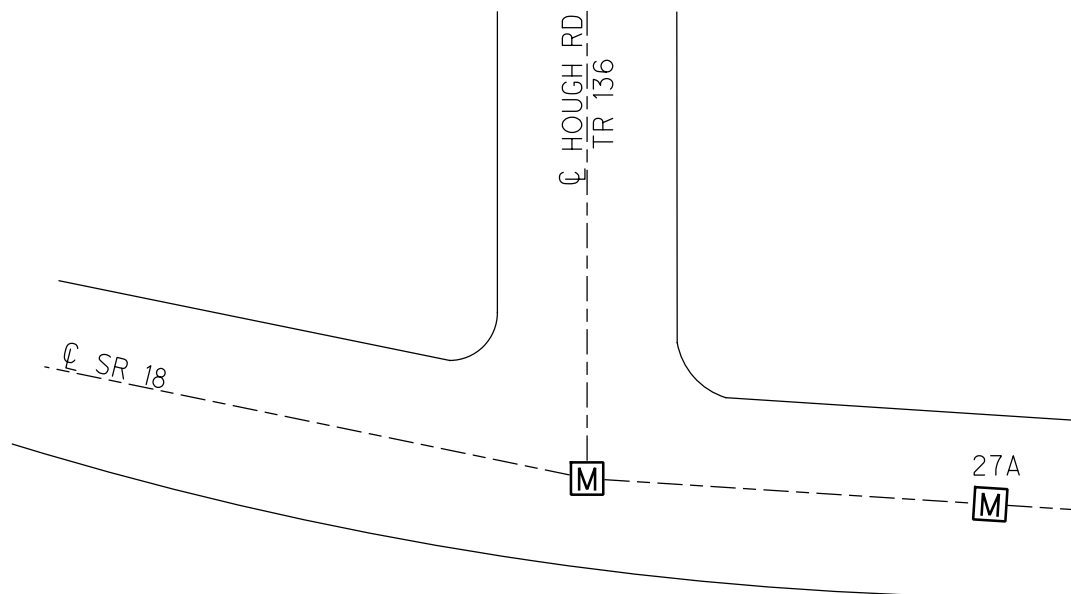

O.D.O.T. DISTRICT 2 SURVEY OFFICE (USE ONLY)

PERSONNEL

REFERENCE NO. 27 A

SHEET 39 OF 51

NOTES RHOADES

DATE 6-16-20

ROUTE SR 18

H.C. O'DONNELL

WEATHER SUNNY

COUNTY WOOD

R.C. MAHLER

TEMP. 75°F

TOWNSHIP HENRY

DWG BY MAHLER

PID PAVETRAIN

SECTION 34

T 3 N R 10 E

TYPE MONUMENT MONBOX W/STRATS

ON SURFACE - ~~BELOW~~ ON

OFFSET Q PAVEMENT LT : RT

 TO EDGE PAVEMENT


STATION: 146+55.60 (2011 PLAN)

HORZ.DATUM: NAD83 (2011)

GEOID: NAVD88-2012A


GRID: NORTHING: 551372.444

EASTING: 1638893.895

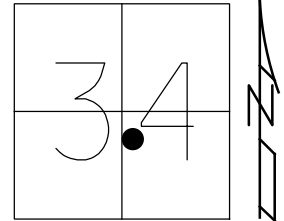

RECORD: C.S.
2011 PLAN
STA. 146+55.60
FD MONBOX
STRATS PULLED
SHOT TOP BOX
REFA27
6-16-20, JFO

DIST. 27-27A=85.44'

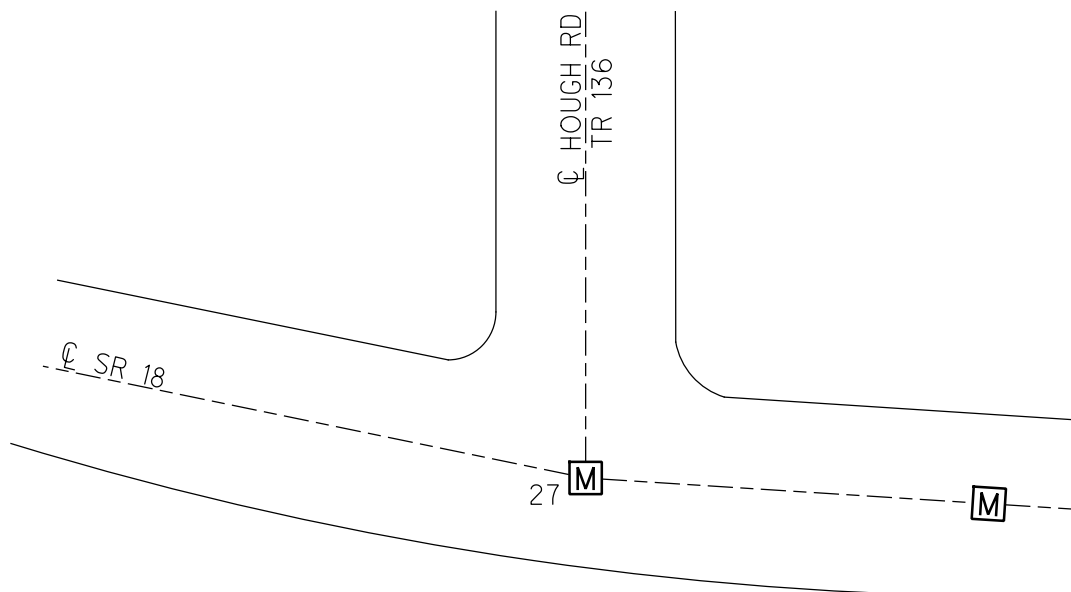

O.D.O.T. DISTRICT 2 SURVEY OFFICE (USE ONLY)

PERSONNEL

REFERENCE NO. 27 B

SHEET 40 OF 51

NOTES RHOADES

DATE 6-16-20

ROUTE SR 18

H.C. O'DONNELL

WEATHER SUNNY

COUNTY WOOD

R.C. MAHLER

TEMP. 75°F

TOWNSHIP HENRY

DWG BY MAHLER

PID PAVETRAIN

SECTION 34

T 3 N R 10 E

TYPE MONUMENT MONBOX W/STRATS

ON SURFACE - ~~BELOW~~ ON

OFFSET Q PAVEMENT LT : RT

- TO - EDGE PAVEMENT


STATION: 149+85.60 (2011 PLAN)

HORZ.DATUM: NAD83 (2011)

GEOID: NAVD88-2012A

GRID: NORTHING: 551347.108

EASTING: 1639222.640

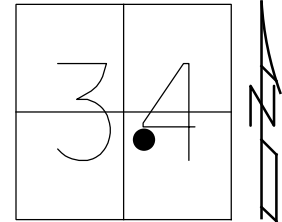

RECORD: S.T.
2011 PLAN
STA. 149+85.60
FD MONBOX
STRATS PULLED
SHOT TOP BOX
REFB27
6-16-20, JFO

Q SR 18 ----- M -----

O.D.O.T. DISTRICT 2 SURVEY OFFICE (USE ONLY)

PERSONNEL

REFERENCE NO. 27 C

SHEET 41 OF 51

NOTES RHOADES

DATE 6-16-20

ROUTE SR 18

H.C. O'DONNELL

WEATHER SUNNY

COUNTY WOOD

R.C. MAHLER

TEMP. 75°F

TOWNSHIP HENRY

DWG BY MAHLER

PID PAVETRAIN

SECTION 34

T 3 N R 10 E

TYPE MONUMENT MONBOX W/STRATS

ON SURFACE - ~~BELOW~~ ON

OFFSET Q PAVEMENT LT : RT

- TO - EDGE PAVEMENT


STATION: 172+27.95 (2011 PLAN)

HORIZ.DATUM: NAD83 (2011)

GEOID: NAVD88-2012A

GRID: NORTHING: 551271.133

EASTING: 1641468.336

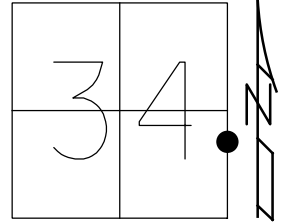

RECORD:
2011 PLAN
STA. 172+27.95
FD MONBOX
STRATS PULLED
SHOT TOP BOX
REFC27
6-16-20, JFO

Q MITCHELL RD
TR 81

Q SR 18

M

O.D.O.T. DISTRICT 2 SURVEY OFFICE (USE ONLY)

PERSONNEL

REFERENCE NO. 27 D

SHEET 42 OF 51

NOTES RHOADES

DATE 6-16-20

ROUTE SR 18

H.C. O'DONNELL

WEATHER SUNNY

COUNTY WOOD

R.C. MAHLER

TEMP. 75°F

TOWNSHIP HENRY

DWG BY MAHLER

PID PAVETRAIN

SECTION 35

T 3 N R 10 E

TYPE MONUMENT MONBOX W/STRATS

ON SURFACE - ~~BELOW~~ ON

OFFSET ℄ PAVEMENT LT : RT

- TO - EDGE PAVEMENT


STATION: 191+73.75 (2011 PLAN)

HORIZ.DATUM: NAD83 (2011)

GEOID: NAVD88-2012A

GRID: NORTHING: 551205.541

EASTING: 1643407.942

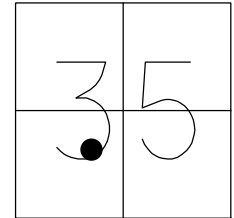

RECORD:
2011 PLAN
STA. 191+73.75
FD MONBOX
STRATS PULLED
SHOT TOP BOX
REFD27
6-16-20, JFO

℄ SR 18 ----- M -----

O.D.O.T. DISTRICT 2 SURVEY OFFICE (USE ONLY)

PERSONNEL

REFERENCE NO. 27 E

SHEET 43 OF 51

NOTES RHOADES

DATE 6-16-20

ROUTE SR 18

H.C. O'DONNELL

WEATHER SUNNY

COUNTY WOOD

R.C. MAHLER

TEMP. 75°F

TOWNSHIP HENRY

SECTION 35

DWG BY MAHLER PID PAVETRAIN

T 3 N R 10 E

TYPE MONUMENT MONBOX W/STRATS

ON SURFACE - ~~BELOW~~ ON

OFFSET ℄ PAVEMENT LT : RT

- TO - EDGE PAVEMENT


STATION: 193+60.19 (2011 PLAN)

HORZ.DATUM: NAD83 (2011)


GEOID: NAVD88-2012A

GRID: NORTHING: 551181.939

EASTING: 1643592.605

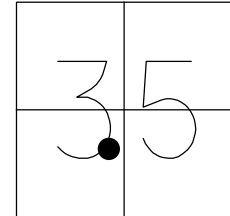

RECORD: P.T.
2011 PLAN
STA. 193+60.19
FD MONBOX
STRATS PULLED
SHOT TOP BOX
REFE27
6-16-20, JFO

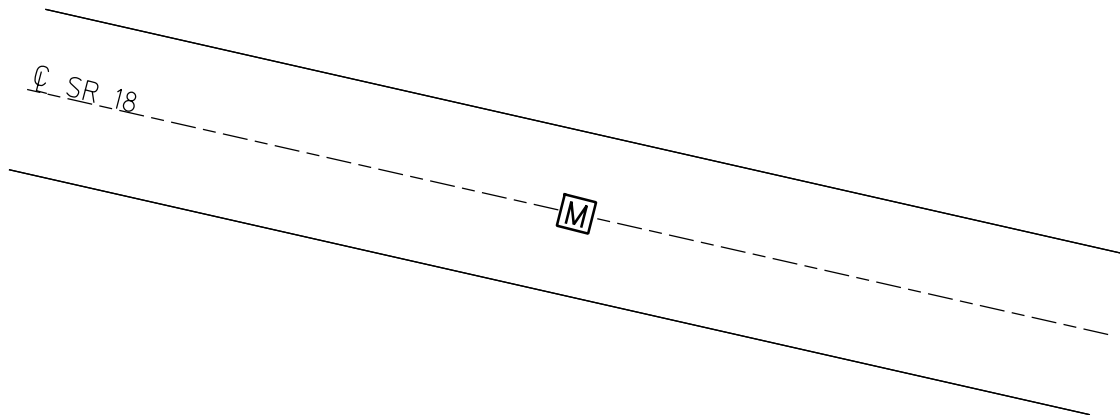

O.D.O.T. DISTRICT 2 SURVEY OFFICE (USE ONLY)

PERSONNEL

REFERENCE NO. 27F

SHEET 44 OF 51

NOTES RHOADES

DATE 6-16-20

ROUTE SR 18

H.C. O'DONNELL

WEATHER SUNNY

COUNTY WOOD

R.C. MAHLER

TEMP. 78°F

TOWNSHIP HENRY

SECTION 35

DWG BY MAHLER PID PAVETRAIN

T 3 N R 10 E

TYPE MONUMENT MONBOX W/ 3/4" IPIN

ON SURFACE - ~~BELOW~~ ON

OFFSET $\varnothing$ PAVEMENT LT : RT

 TO EDGE PAVEMENT


STATION: 196+64.93 (2011 PLAN)

HORZ.DATUM: NAD83 (2011)

GEOID: NAVD88-2012A


GRID: NORTHING: 551115.494

EASTING: 1643890.024

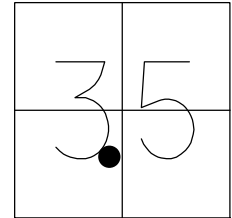

RECORD:
2011 PLAN
STA. 196+64.93
FD MONBOX
W/ 3/4" IPIN
REFF27
6-16-20, JFO

DIST. 27F-27G= 52.93'

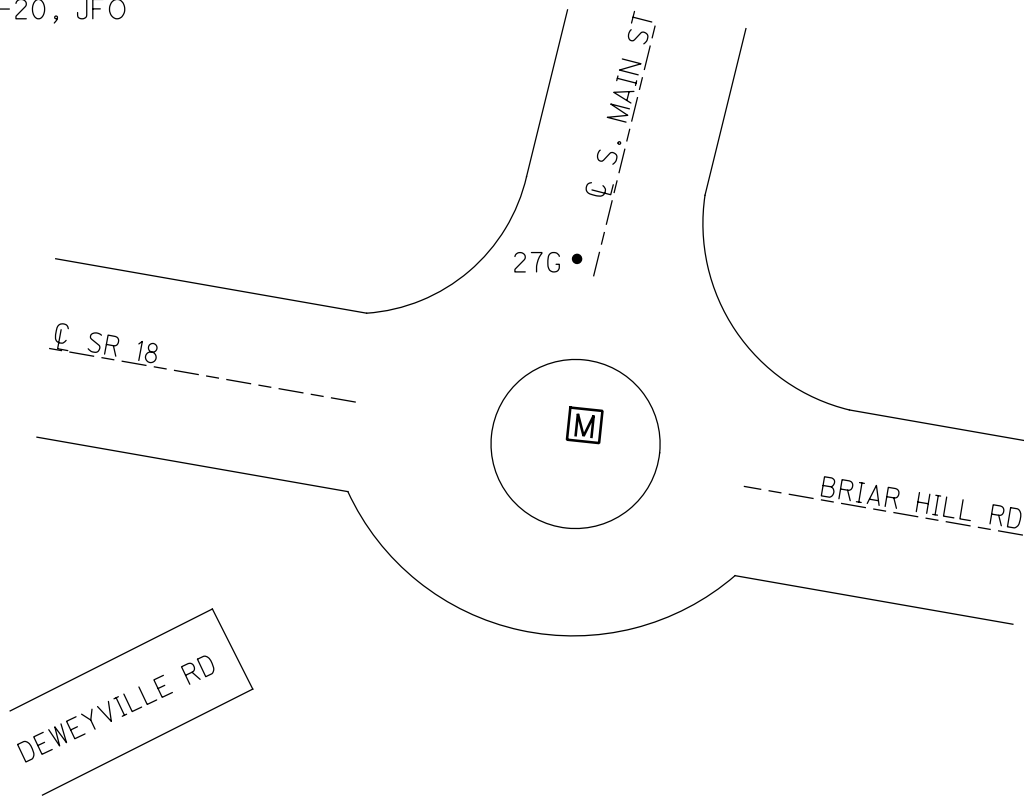

O.D.O.T. DISTRICT 2 SURVEY OFFICE (USE ONLY)

PERSONNEL

REFERENCE NO. 27 G

SHEET 45 OF 51

NOTES RHOADES

DATE 6-16-20

ROUTE SR 18

H.C. O'DONNELL

WEATHER SUNNY

COUNTY WOOD

R.C. MAHLER

TEMP. 78°F

TOWNSHIP HENRY

SECTION 35

DWG BY MAHLER PID PAVETRAIN

T 3 N R 10 E

TYPE MONUMENT MAGNAIL

ON SURFACE - ~~BELOW~~ ON

OFFSET Q PAVEMENT LT : RT

- TO - EDGE PAVEMENT


STATION: 10+52.70 (2011 PLAN)

HORIZ.DATUM: NAD83 (2011)

GEOID: NAVD88-2012A


GRID: NORTHING: 551167.553

EASTING: 1643899.578

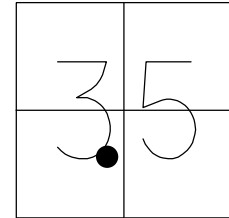

RECORD: P.C.
2011 PLAN
STA. 10+52.70
P.C.-S. MAIN ST
FD MAG NAIL
REFG27
6-16-20, JFO

DIST. 27F-27G= 52.93'

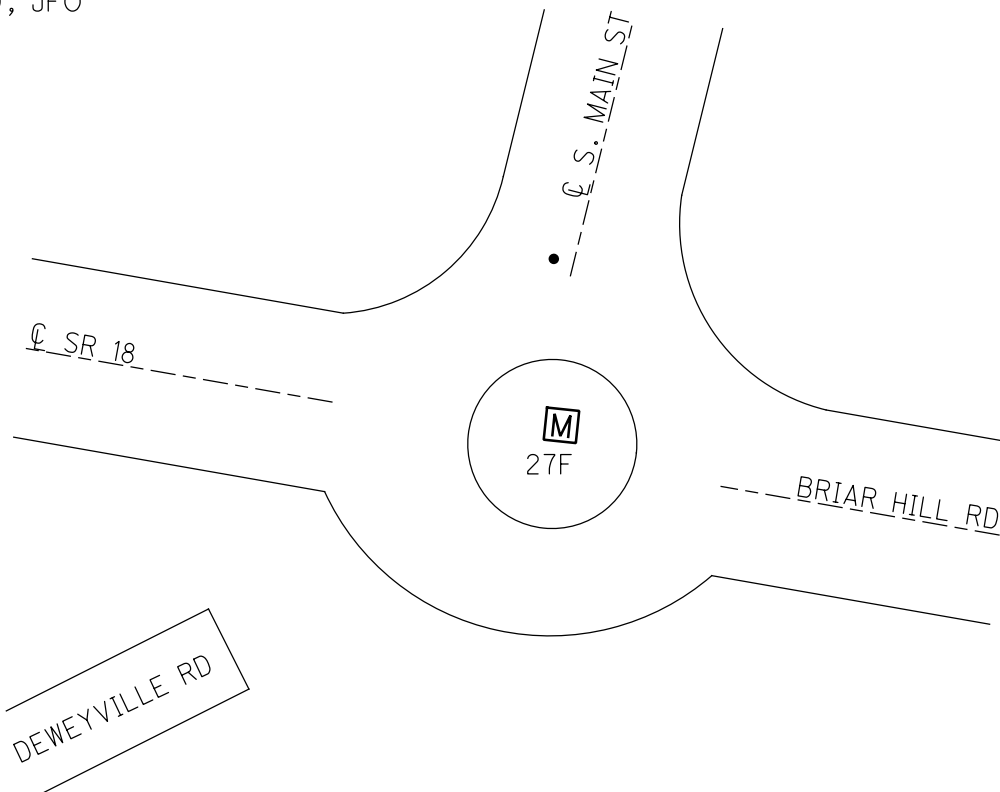

O.D.O.T. DISTRICT 2 SURVEY OFFICE (USE ONLY)

PERSONNEL

REFERENCE NO. 28

SHEET 46 OF 51

NOTES RHOADES

DATE 6-16-20

ROUTE SR 18

H.C. O'DONNELL

WEATHER SUNNY

COUNTY WOOD

R.C. MAHLER

TEMP. 78°F

TOWNSHIP HENRY

SECTION 35

DWG BY MAHLER PID PAVETRAIN

T 3 N R 10 E

TYPE MONUMENT MONBOX W/STRATS

ON SURFACE - ~~BELOW~~ ON

OFFSET CL PAVEMENT LT : RT

- TO - EDGE PAVEMENT


STATION: 199+09.77

HORZ.DATUM: NAD83 (2011)


GEOID: NAVD88-2012A

GRID: NORTHING: 551061.917

EASTING: 1644129.126

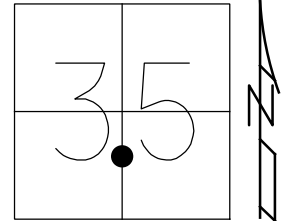

RECORD:
2011 PLAN
STA. 199+04.16
FD MONBOX
STRATS PULLED
SHOT TOP BOX
REF28
6-16-20, JFO

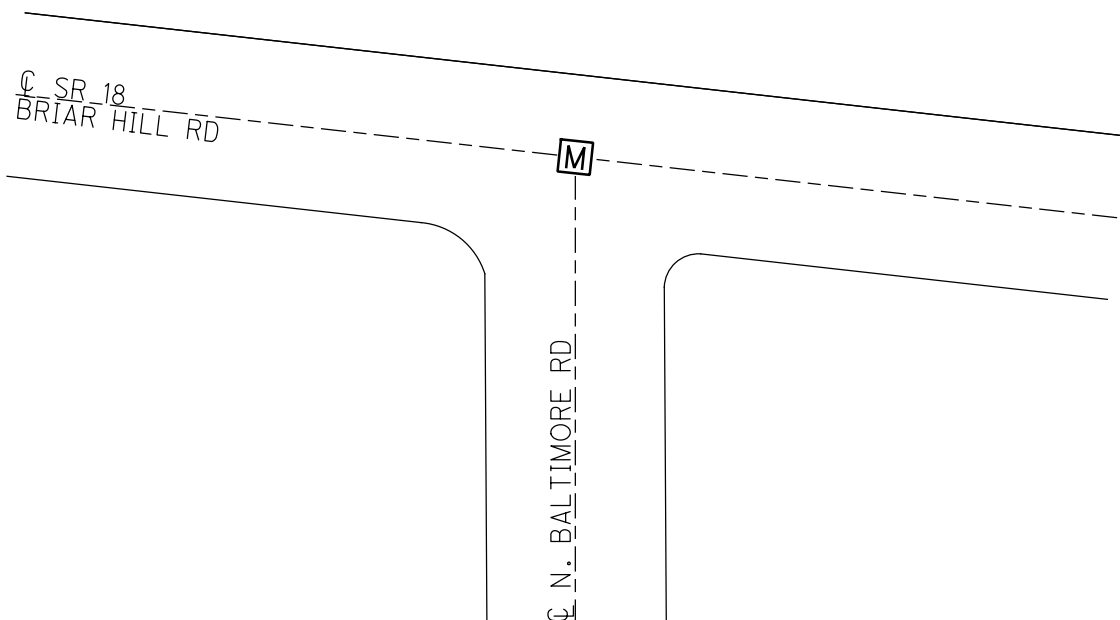

O.D.O.T. DISTRICT 2 SURVEY OFFICE (USE ONLY)

PERSONNEL

REFERENCE NO. 28 A

SHEET 47 OF 51

NOTES RHOADES

DATE 6-16-20

ROUTE SR 18

H.C. O'DONNELL

WEATHER SUNNY

COUNTY WOOD

R.C. MAHLER

TEMP. 78°F

TOWNSHIP HENRY

SECTION 35

DWG BY MAHLER PID PAVETRAIN

T 3 N R 10 E

TYPE MONUMENT MONBOX W/STRATS

ON SURFACE - ~~BELOW~~ ON

OFFSET CL PAVEMENT 5.88' LT : ~~RT~~

- TO - EDGE PAVEMENT


STATION: 200+23.04

HORZ.DATUM: NAD83 (2011)

GEOID: NAVD88-2012A


GRID: NORTHING: 551043.125

EASTING: 1644240.763

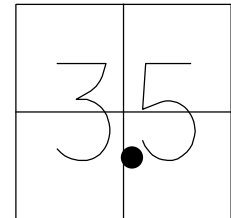

RECORD:
2011 PLAN
STA. 200+23.04
FD MONBOX
STRATS PULLED
SHOT TOP BOX
REFA28
6-16-20, JFO

DIST. 28A-28AB = 5.88'

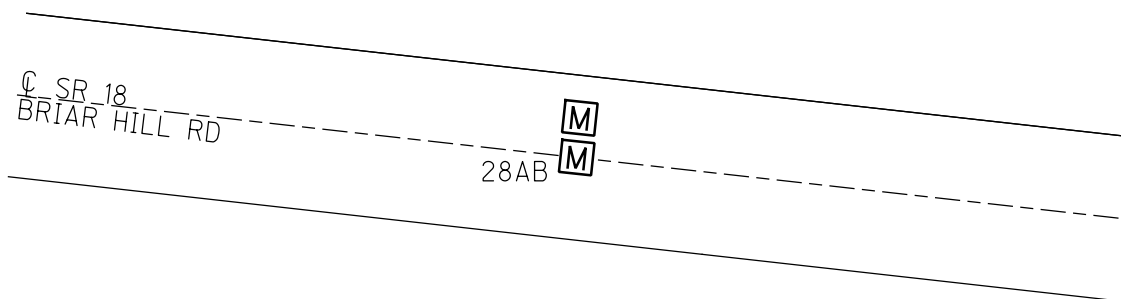

O.D.O.T. DISTRICT 2 SURVEY OFFICE (USE ONLY)

PERSONNEL

REFERENCE NO. 28 AB

SHEET 48 OF 51

NOTES RHOADES

DATE 6-16-20

ROUTE SR 18

H.C. O'DONNELL

WEATHER SUNNY

COUNTY WOOD

R.C. MAHLER

TEMP. 78°F

TOWNSHIP HENRY

SECTION 35

DWG BY MAHLER PID PAVETRAIN

T 3 N R 10 E

TYPE MONUMENT MONBOX W/STRATS

ON SURFACE - ~~BELOW~~ ON

OFFSET Q PAVEMENT ON LT : RT

- TO - EDGE PAVEMENT


STATION: 200+23.04

HORZ.DATUM: NAD83 (2011)

GEOID: NAVD88-2012A

GRID: NORTHING: 551037.241

EASTING: 1644239.427

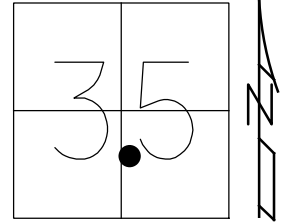

RECORD:
2011 PLAN
STA. 200+23.04
FD MONBOX
STRATS PULLED
SHOT TOP BOX
REFAB28
6-16-20, JFO

DIST. 28A-28AB = 5.88'

Q SR 18
BRIAR HILL RD

M 28A
M

O.D.O.T. DISTRICT 2 SURVEY OFFICE (USE ONLY)

PERSONNEL

REFERENCE NO. 28 AC

SHEET 49 OF 51

NOTES RHOADES

DATE 6-16-20

ROUTE SR 18

H.C. O'DONNELL

WEATHER SUNNY

COUNTY WOOD

R.C. MAHLER

TEMP. 78°F

TOWNSHIP HENRY

SECTION 35

DWG BY MAHLER PID PAVETRAIN

T 3 N R 10 E

TYPE MONUMENT MONBOX W/STRATS

ON SURFACE - ~~BELOW~~ ON

OFFSET CL PAVEMENT 4' LT : ~~RT~~

- TO - EDGE PAVEMENT


STATION: 200+78.74

HORZ.DATUM: NAD83 (2011)

GEOID: NAVD88-2012A


GRID: NORTHING: 551030.960

EASTING: 1644295.048

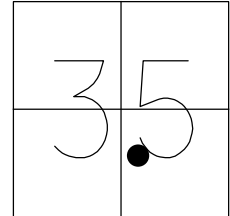

RECORD:
2011 PLAN
STA. 200+78.74
FD MONBOX
STRATS PULLED
SHOT TOP BOX
REFAC28
6-16-20, JFO

DIST. 28A-28AC = 55.70'

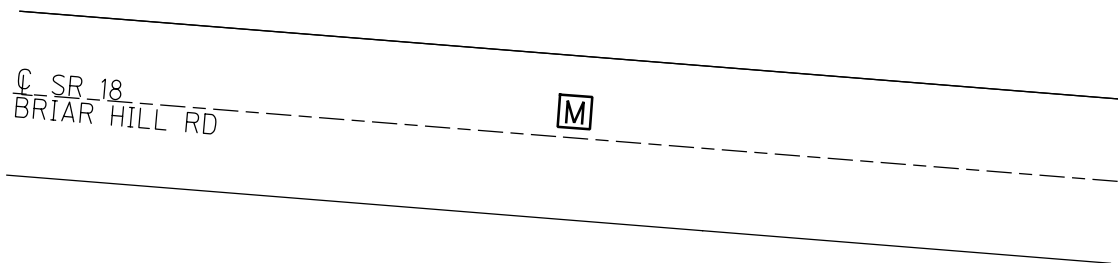

O.D.O.T. DISTRICT 2 SURVEY OFFICE (USE ONLY)

PERSONNEL

REFERENCE NO. 28 AD

SHEET 50 OF 51

NOTES RHOADES

DATE 6-16-20

ROUTE SR 18

H.C. O'DONNELL

WEATHER SUNNY

COUNTY WOOD

R.C. MAHLER

TEMP. 78°F

TOWNSHIP HENRY

SECTION 35

DWG BY MAHLER

PID PAVETRAIN

T 3 N R 10 E

TYPE MONUMENT MONBOX

ON SURFACE - ~~BELOW~~ ON

OFFSET CL PAVEMENT 3' LT : ~~RT~~

- TO - EDGE PAVEMENT


STATION: 202+54.55

HORZ.DATUM: NAD83 (2011)

GEOID: NAVD88-2012A


GRID: NORTHING: 551011.533

EASTING: 1644469.446

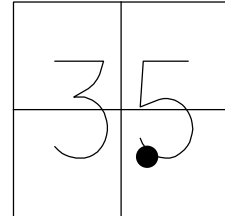

RECORD:
2011 PLAN
STA. 202+54.55
FD MONBOX
SHOT TOP BOX
REFAD28
6-16-20, JFO

DIST. 28AD-28B = 56.30'

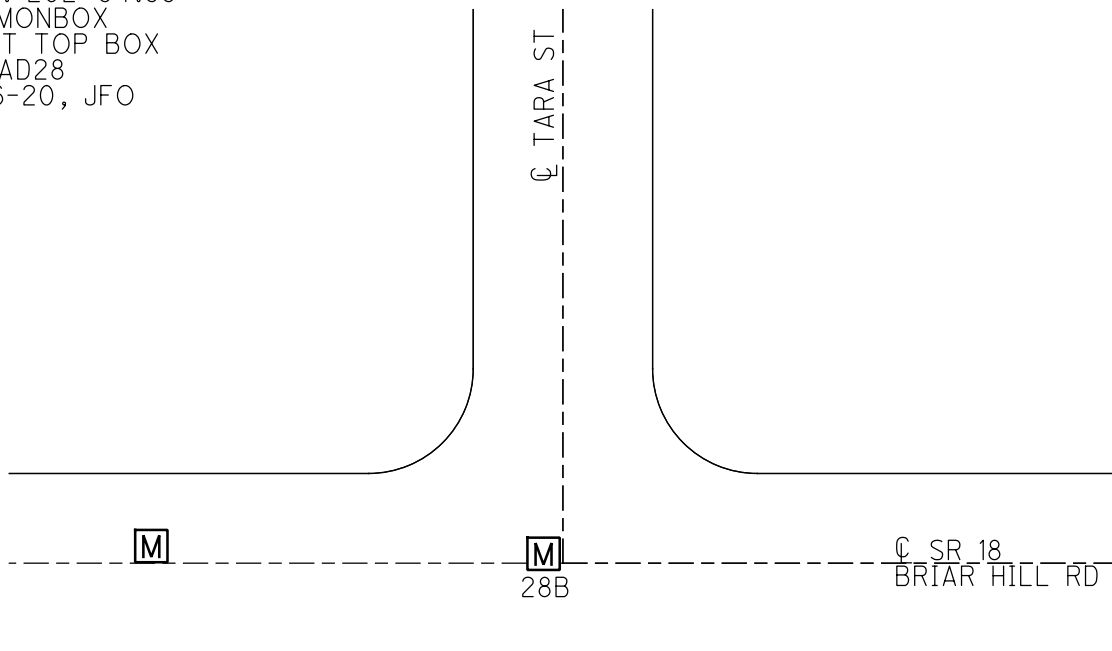

O.D.O.T. DISTRICT 2 SURVEY OFFICE (USE ONLY)

PERSONNEL

REFERENCE NO. 28 B

SHEET 51 OF 51

NOTES RHOADES

DATE 6-16-20

ROUTE SR 18

H.C. O'DONNELL

WEATHER SUNNY

COUNTY WOOD

R.C. MAHLER

TEMP. 78°F

TOWNSHIP HENRY

DWG BY MAHLER PID PAVETRAIN

SECTION 35

T 3 N R 10 E

TYPE MONUMENT MONBOX

ON SURFACE - ~~BELOW~~ ON

OFFSET CL PAVEMENT 2' LT : ~~RT~~

- TO - EDGE PAVEMENT


STATION: 203+10.85

HORZ.DATUM: NAD83 (2011)

GEOID: NAVD88-2012A


GRID: NORTHING: 551011.507

EASTING: 1644525.683

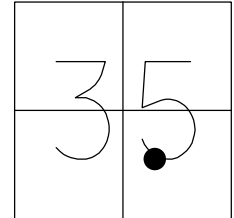

RECORD:
2011 PLAN
STA. 203+10.85
FD MONBOX
SHOT TOP BOX
REFB28
6-16-20, JFO

DIST. 28AD-28B = 56.30'

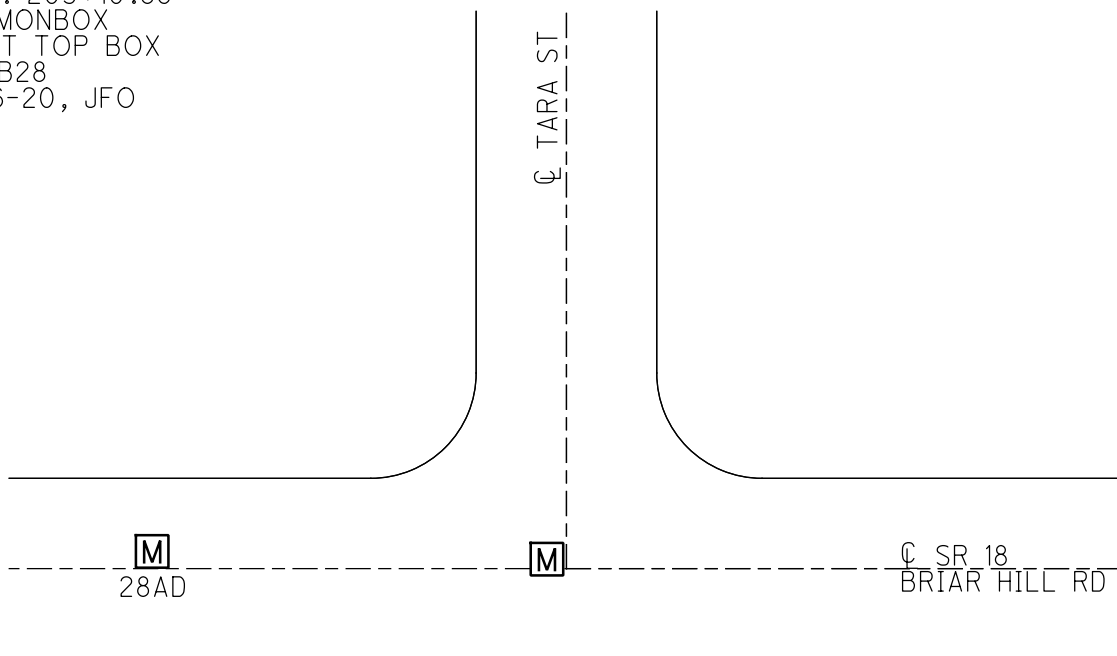

O.D.O.T. DISTRICT 2 SURVEY OFFICE (USE ONLY)

PERSONNEL

REFERENCE NO. 28 C

SHEET 9 OF 19

NOTES HOMAN

DATE 7/8/02

ROUTE SR 18

H.C. ZEBROWSKI

WEATHER SUNNY

COUNTY WOOD

R.C. MICHALAK

TEMP. 85°

TOWNSHIP HENRY

BEAUMONT

SECTION 35

DWG BY MILLER

PID 93417

T 3 N R 10 E

TYPE MONUMENT DRILLH

ON SURFACE - ~~BELOW~~ ON

OFFSET CL PAVEMENT - LT : RT

1.5' LT TO RT EDGE PAVEMENT


STATION: 673+59.32

HORIZ.DATUM: NAD83 (2011)


GEOID: 2012A

GRID: NORTHING: 551003.747

EASTING: 1644751.757

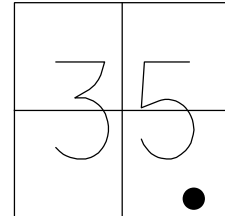

RECORD: P.I.
STA 673+45.36
 $\Delta = 7^{\circ}06'$ LT
CL CONST.
FD DRILLH
REFD28
9/7/16, DCH

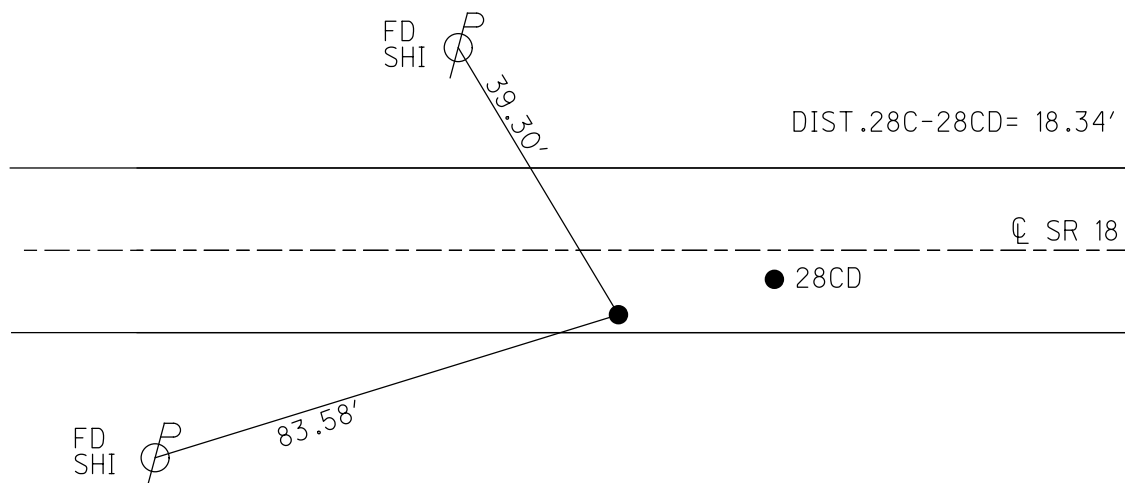

O.D.O.T. DISTRICT 2 SURVEY OFFICE (USE ONLY)

PERSONNEL

REFERENCE NO. 28 CD

SHEET 10 OF 19

NOTES HOMAN

DATE 7/8/02

ROUTE SR 18

H.C. ZEBROWSKI

WEATHER SUNNY

COUNTY WOOD

R.C. MICHALAK

TEMP. 85°

TOWNSHIP HENRY

BEAUMONT

SECTION 35

DWG BY MILLER PID 93417

T 3 N R 10 E

TYPE MONUMENT DRILLH

ON SURFACE - ~~BELOW~~ ON

OFFSET CL PAVEMENT 1.4' ~~LT~~ : RT

9.8' TO RT EDGE PAVEMENT


STATION: 673+60.67

HORZ.DATUM: NAD83 (2011)


GEOID: 2012A

GRID: NORTHING: 551014.082

EASTING: 1644766.924

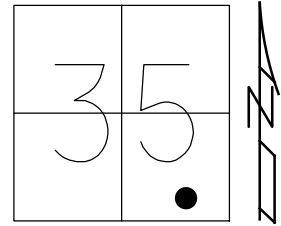

RECORD: P.I.
STA 673+60.65
 $\Delta = 1^{\circ}17'$ LT
CL SURVEY
BY PLAN 1987
673+59.30
BARBER & ASSOC.
FD DRILLH
REFE28
9/7/16, DCH

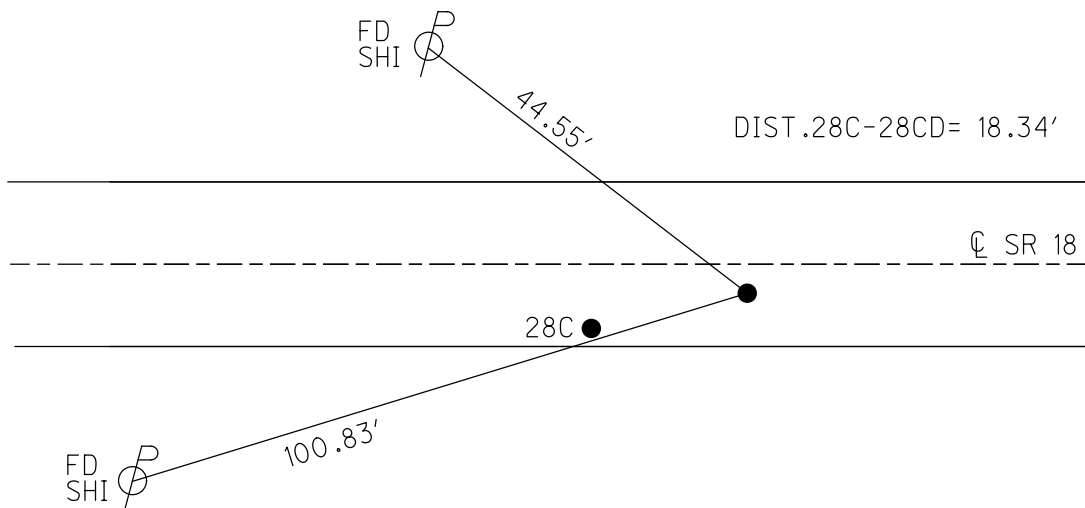

O.D.O.T. DISTRICT 2 SURVEY OFFICE (USE ONLY)

PERSONNEL

REFERENCE NO. 28 D

SHEET 11 OF 19

NOTES HOMAN

DATE 8/4/14

ROUTE SR 18

H.C. LUE

WEATHER SUNNY

COUNTY WOOD

R.C. THOMAS

TEMP. 80°

TOWNSHIP HENRY

SECTION 35

DWG BY MILLER

PID 93417

T 3 N R 10 E

TYPE MONUMENT MONBOX

ON SURFACE - ~~BELOW~~ ON

OFFSET CL PAVEMENT 1.3' ~~LT~~ : RT

10.2' TO RT EDGE PAVEMENT


STATION: 675+64.29

HORZ.DATUM: NAD83 (2011)

GEOID: 2012A


GRID: NORTHING: 551024.695

EASTING: 1644970.264

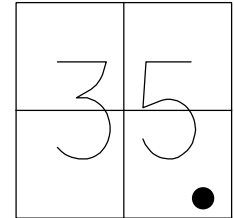

RECORD: P.I.
STA 675+63.93
 $\Delta = 2^\circ 30' \text{ LT}$
SET MAG/WASHER
2/20/03, DCH
FD MAG/WASHER
REFF28
FD MONBOX
REFD28
8-4-14
9-7-16, DCH

SET SHI
S/S POST
OF SIGN FOR
SERVICE CLUBS

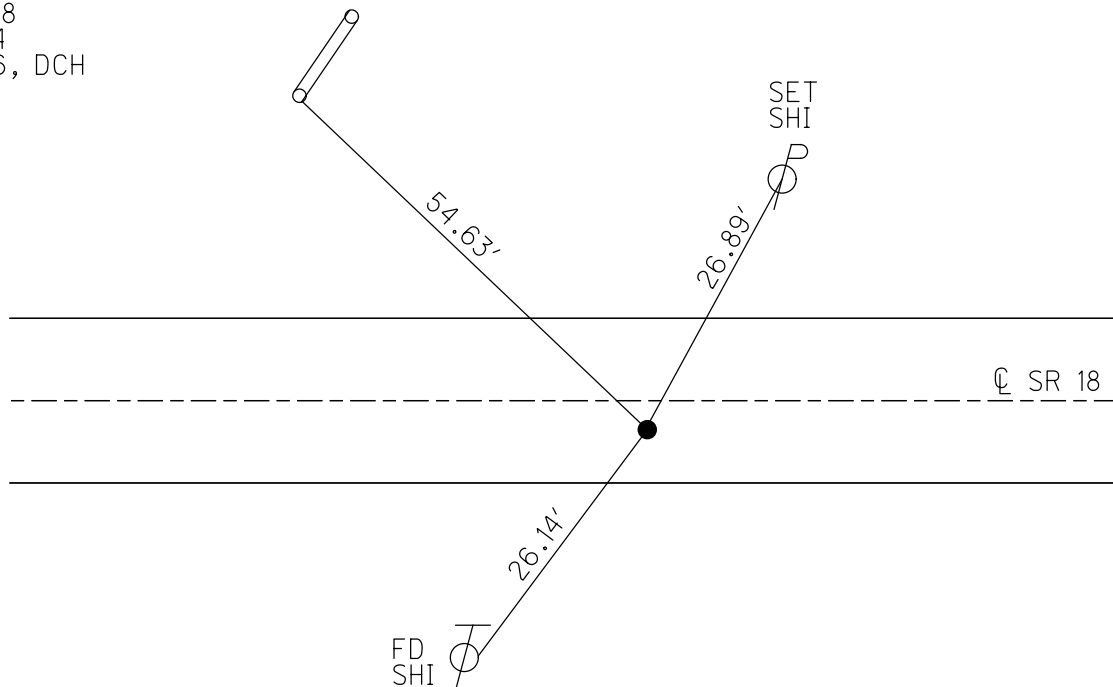

O.D.O.T. DISTRICT 2 SURVEY OFFICE (USE ONLY)

PERSONNEL

REFERENCE NO. 28 E

SHEET 12 OF 9

NOTES HOMAN

DATE 8/4/14

ROUTE SR 18

H.C. LUE

WEATHER SUNNY

COUNTY WOOD

R.C. THOMAS

TEMP. 80°

TOWNSHIP HENRY

SECTION 35

DWG BY MILLER

PID 93417

T 3 N R 10 E

TYPE MONUMENT MAG/WASHER

ON SURFACE - ~~BELOW~~ ON

OFFSET CL PAVEMENT 7.9' LT : ~~RT~~
3.5' TO LT EDGE PAVEMENT



STATION: 688+71.81

HORIZ.DATUM: NAD83 (2011)

GEOID: 2012A

GRID: NORTHING: 551149.154

EASTING: 1646271.891

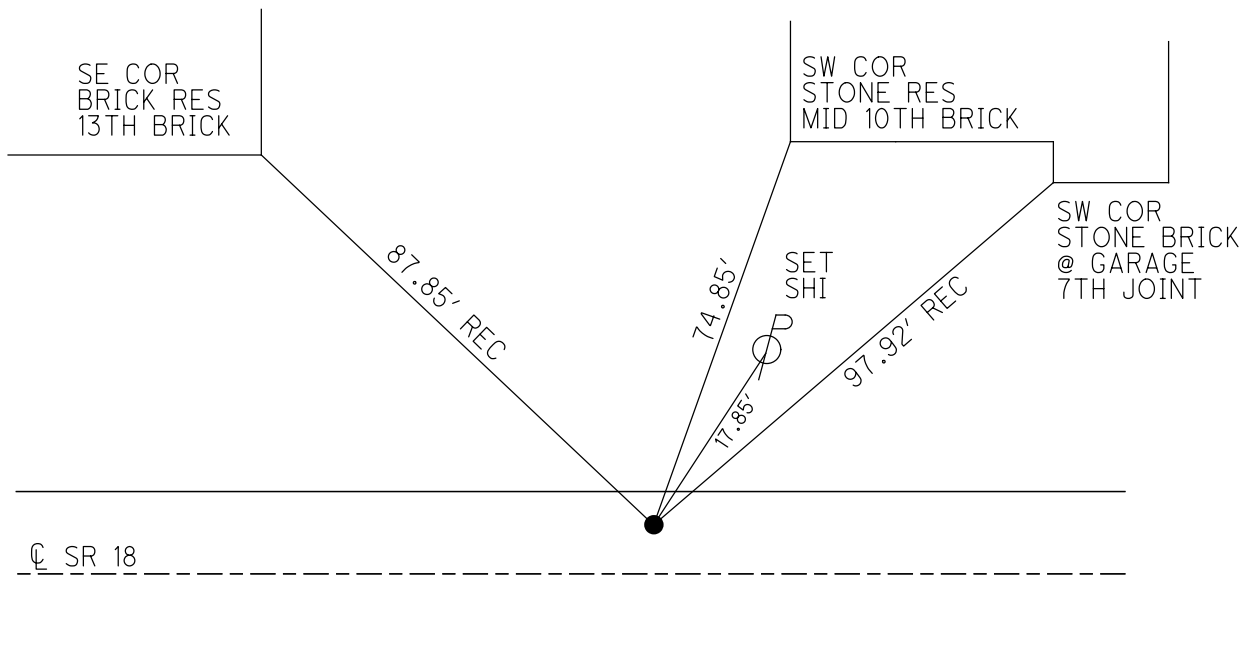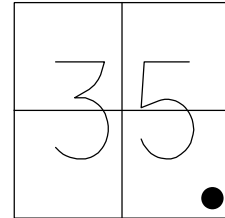

RECORD: P.I.
STA 688+71.65
 $\Delta = 9^\circ 54' \text{ RT}$
SET MAG/WASHER
9/20/02, DCH
FD MAG/WASHER
REFG28
8/04/14, DCH
SET MAG/WASHER
NEWREFE28
9/07/16, DCH

O.D.O.T. DISTRICT 2 SURVEY OFFICE (USE ONLY)

PERSONNEL

REFERENCE NO. 28 F

SHEET 13 OF 19

NOTES HOMAN

DATE 8/4/14

ROUTE SR 18

H.C. LUE

WEATHER SUNNY

COUNTY WOOD

R.C. THOMAS

TEMP. 90°

TOWNSHIP HENRY

DWG BY MILLER

PID 93417

SECTION 35

T 3 N R 10 E

TYPE MONUMENT MAG/WASHER

ON SURFACE - ~~BELOW~~ ON

OFFSET Q PAVEMENT ON ~~LT: RT~~

11.6' TO RT EDGE PAVEMENT


STATION: 694+22.07

HORZ.DATUM: NAD83 (2011)


GEOID: 2012A

GRID: NORTHING: 551106.361

EASTING: 1646821.284

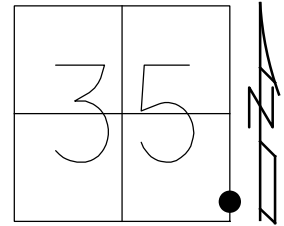

RECORD:
FD SM.R.R.SPIKE
FD P.K./WASHER
7/8/02, DCH
SET MAG/WASHER
3/20/03, DCH
FD MAG/WASHER
REFH28
8/4/14, DCH
SET MAG/WASHER
NEWREFF28
9/7/16, DCH

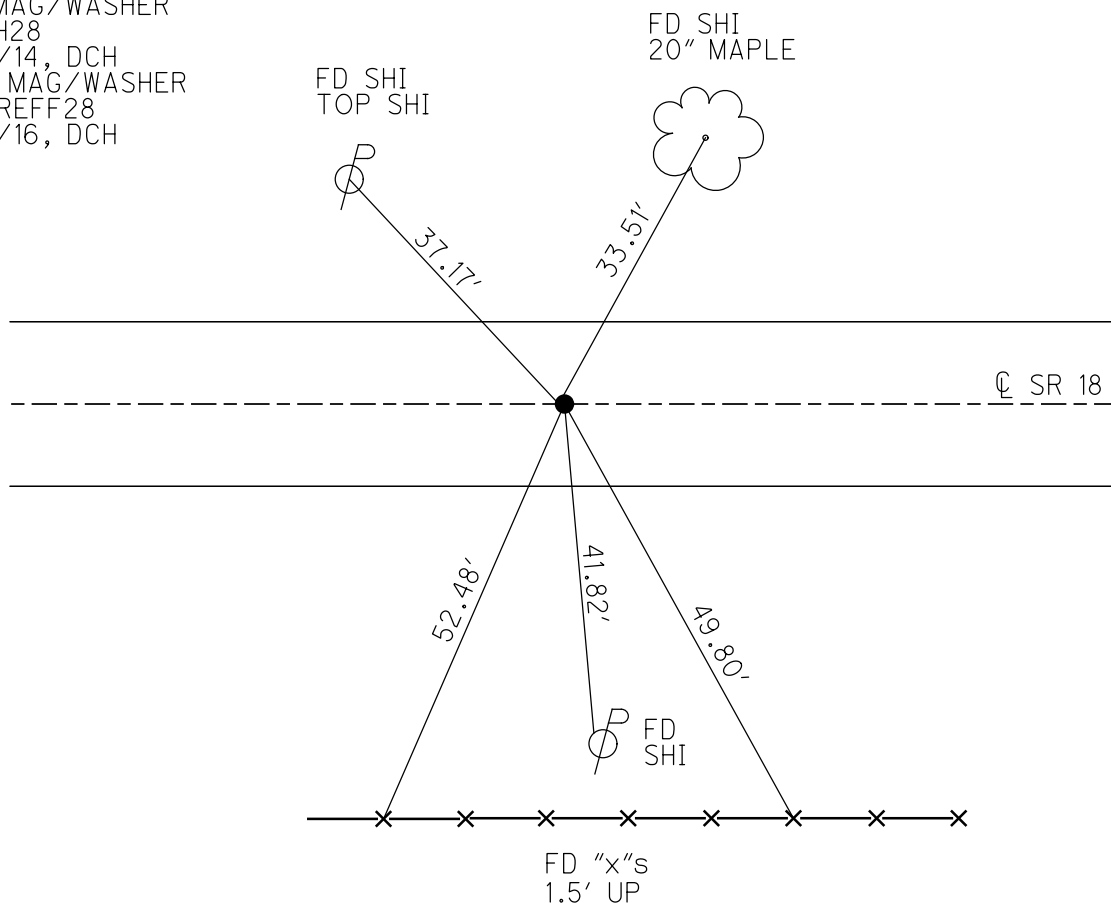

O.D.O.T. DISTRICT 2 SURVEY OFFICE (USE ONLY)

PERSONNEL

REFERENCE NO. 29

SHEET 14 OF 19

NOTES HOMAN

DATE 8/4/14

ROUTE SR 18

H.C. LUE

WEATHER SUNNY

COUNTY WOOD

R.C. THOMAS

TEMP. 80°

TOWNSHIP HENRY

DWG BY MILLER

PID 93417

SECTION 36

T 3 N R 10 E

TYPE MONUMENT MAG/WASHER

ON SURFACE - ~~BELOW~~ ON

OFFSET 12.5' TO RT EDGE PAVEMENT

12.5' TO RT EDGE PAVEMENT


STATION: 707+38.68

HORIZ.DATUM: NAD83 (2011)


GEOID: 2012A

GRID: NORTHING: 551004.173

EASTING: 1648133.909

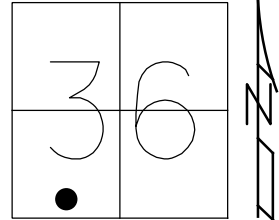

RECORD: P.I.
STA 707+39.12
 $\Delta = 1^\circ 28' \text{ RT}$
FDS P.K./WASHER
7/8/02, DCH
SET P.K./WASHER
2/20/03, DCH
FD MAG/WASHER
REF29
8/4/14, DCH
SET MAG/WASHER
NEWREF29
9/7/16, DCH

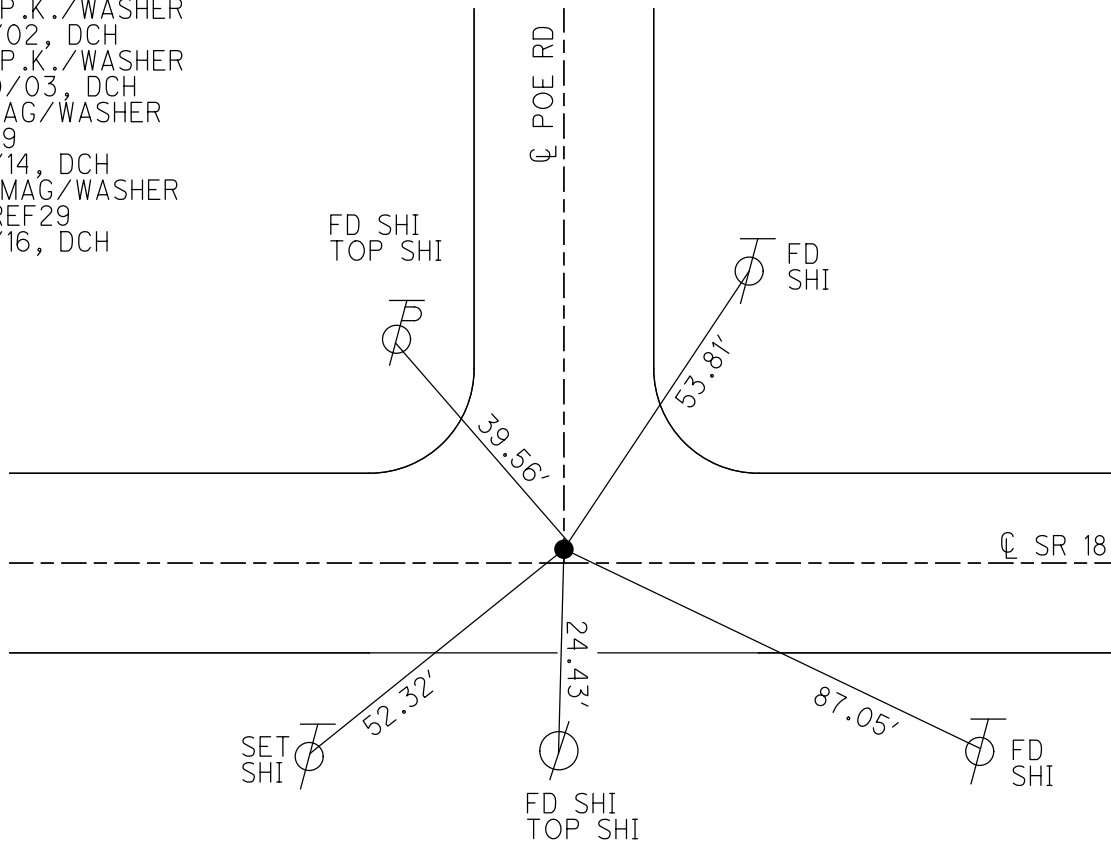

O.D.O.T. DISTRICT 2 SURVEY OFFICE (USE ONLY)

PERSONNEL

REFERENCE NO. 29 A

SHEET 15 OF 19

NOTES HOMAN

DATE 8/4/14

ROUTE SR 18

H.C. LUE

WEATHER SUNNY

COUNTY WOOD

R.C. THOMAS

TEMP. 90°

TOWNSHIP HENRY

SECTION 36

DWG BY MILLER

PID 93417

T 3 N R 10 E

TYPE MONUMENT MAG/WASHER

ON SURFACE - ~~BELOW~~ ON

OFFSET Q PAVEMENT 4.2' LT : ~~RT~~

8.4' TO LT EDGE PAVEMENT


STATION: 708+91.98

HORZ.DATUM: NAD83 (2011)

GEOID: 2012A

GRID: NORTHING: 550992.263

EASTING: 1648286.829

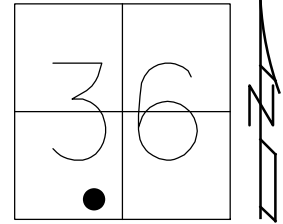

RECORD:

STA 708+92.51

$\Delta = 1^\circ 28' \text{ RT}$

FD P.K./WASHER

7/8/02, DCH

SET MAG/WASHER

2/20/03, DCH

FD MAG NAIL


REFA29

8/4/14, DCH

SET MAG/WASHER

NEWREFA29

9/7/16, DCH

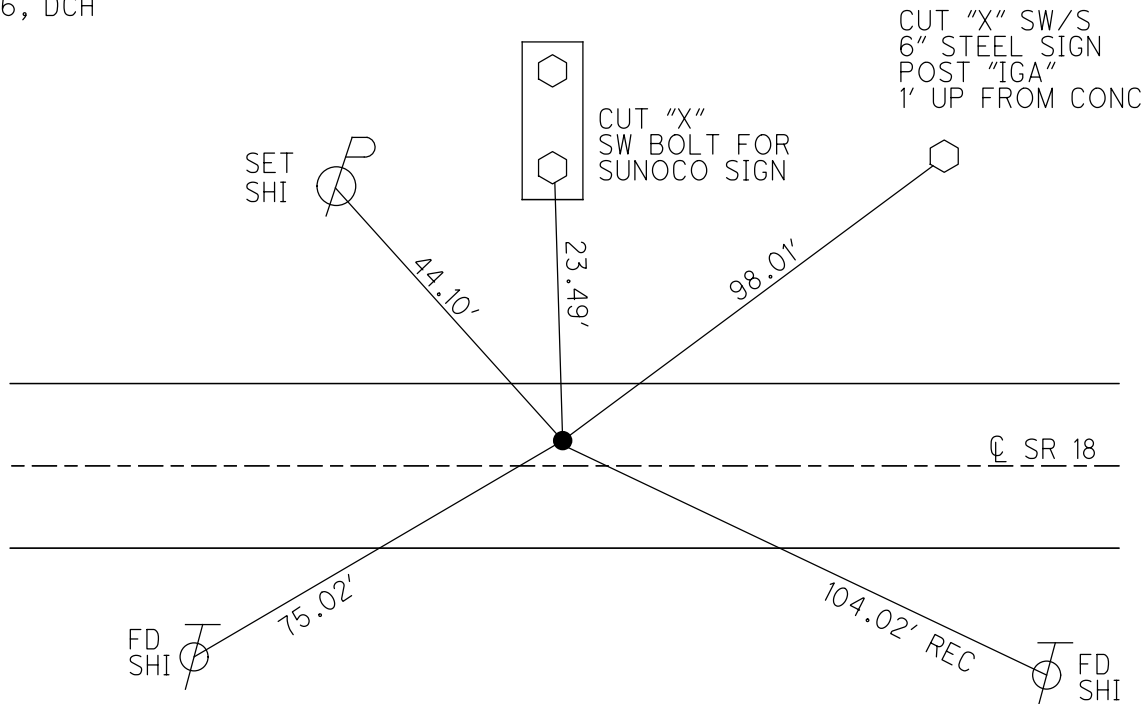

O.D.O.T. DISTRICT 2 SURVEY OFFICE (USE ONLY)

PERSONNEL

REFERENCE NO. 29 AA

SHEET 16 OF 19

NOTES HOMAN

DATE 8/4/14

ROUTE SR 18

H.C. LUE

WEATHER SUNNY

COUNTY WOOD

R.C. THOMAS

TEMP. 90°

TOWNSHIP HENRY

SECTION 36

DWG BY MILLER PID 93417

T 3 N R 10 E

TYPE MONUMENT LG R.R. SPIKE

ON SURFACE - ~~BELOW~~ ON

OFFSET CL PAVEMENT ON LT : RT

11.0' TO RT EDGE PAVEMENT


STATION: 720+60.02

HORZ.DATUM: NAD83 (2011)


GEOID: 2012A

GRID: NORTHING: 550867.282

EASTING: 1649448.069

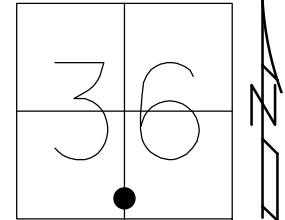

RECORD:
FD P.K./WASHER
7/8/02, DCH
FD LG R.R. SPIKE
REFAAA29
8/4/14, DCH
SET MAG/WASHER
NEWREFAAA29
9/7/16, DCH

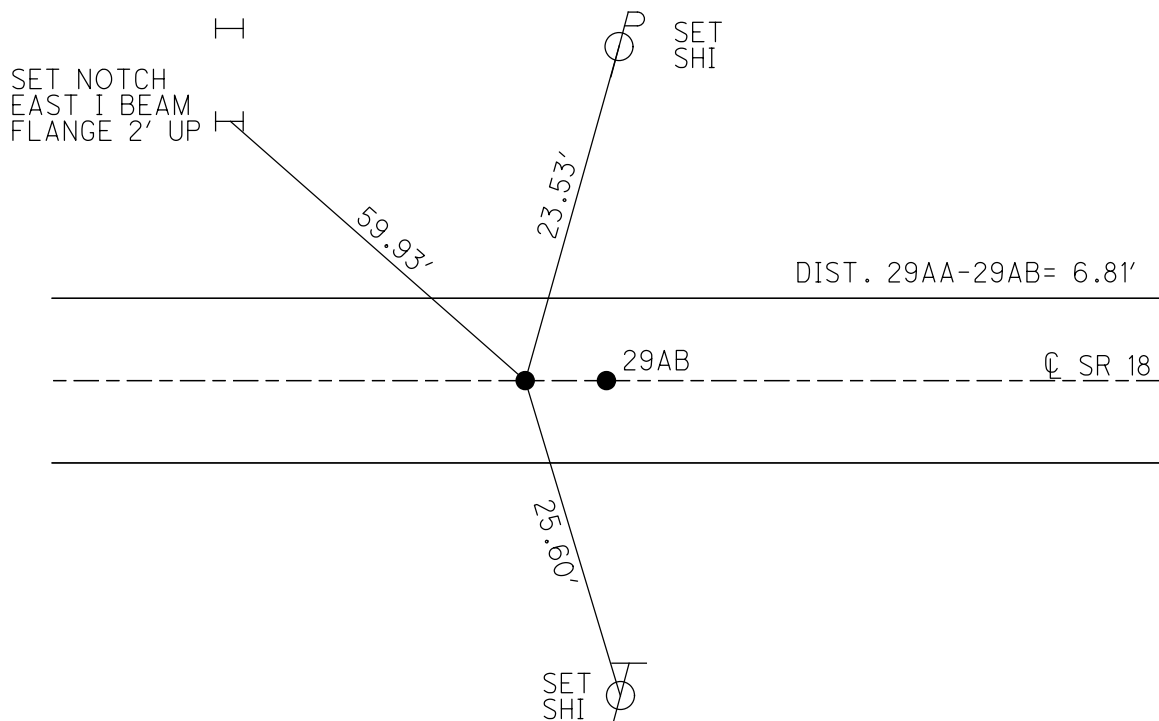

O.D.O.T. DISTRICT 2 SURVEY OFFICE (USE ONLY)

PERSONNEL

REFERENCE NO. 29 AB

SHEET 17 OF 19

NOTES HOMAN

DATE 8/4/14

ROUTE SR 18

H.C. LUE

WEATHER SUNNY

COUNTY WOOD

R.C. THOMAS

TEMP. 90°

TOWNSHIP HENRY

SECTION 36

DWG BY MILLER

PID 93417

T 3 N R 10 E

TYPE MONUMENT MAG/WASHER

ON SURFACE - ~~BELOW~~ ON

OFFSET CL PAVEMENT ON ~~LT:RT~~

11.0' TO RT EDGE PAVEMENT


STATION: 720+66.82

HORIZ.DATUM: NAD83 (2011)


GEOID: 2012A

GRID: NORTHING: 550866.241

EASTING: 1649454.817

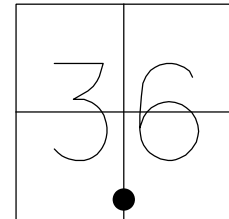

RECORD:
ORIGIN UNKNOWN
FD P.K./WASHER
7/8/02, DCH
SET MAG/WASHER
2/20/03, DCH
FD MAG/WASHER
REFAA29
8/4/14, DCH
SET MAG/WASHER
NEWREFAA29
9/7/16, DCH

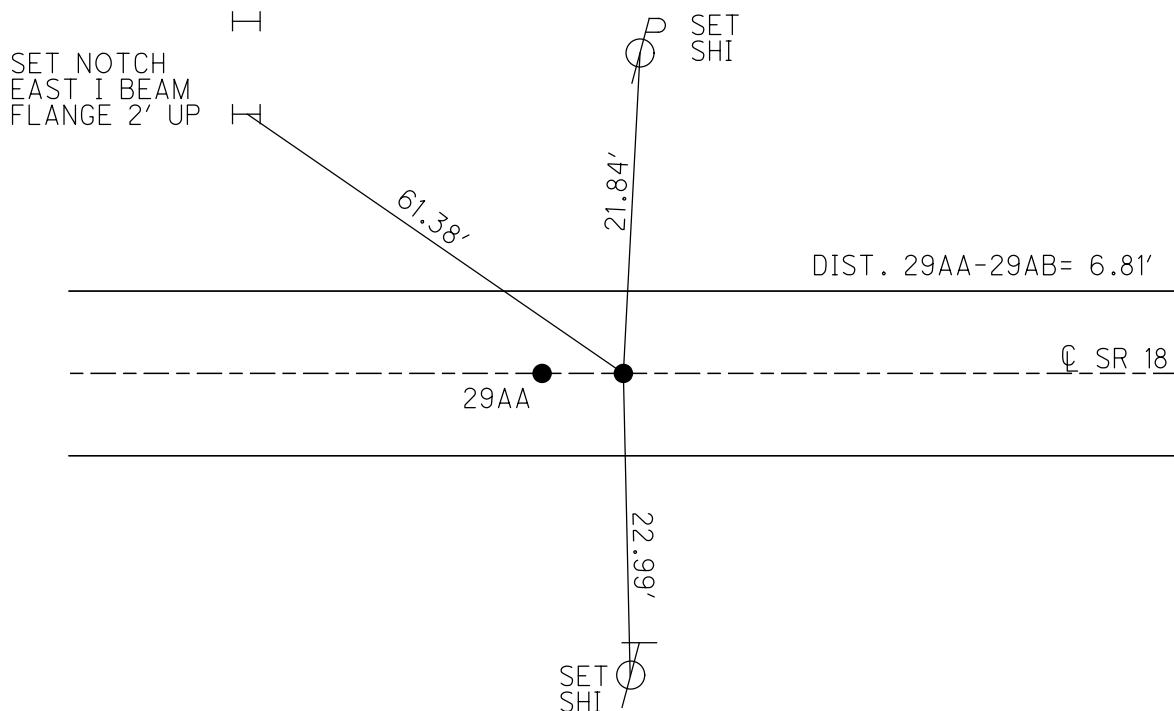

O.D.O.T. DISTRICT 2 SURVEY OFFICE (USE ONLY)

PERSONNEL

REFERENCE NO. 29 B

SHEET 18 OF 19

NOTES HOMAN

DATE 8/4/14

ROUTE SR 18

H.C. LUE

WEATHER SUNNY

COUNTY WOOD

R.C. THOMAS

TEMP. 90°

TOWNSHIP HENRY

SECTION 36

DWG BY MILLER PID 93417

T 3 N R 10 E

TYPE MONUMENT MAG/WASHER

ON SURFACE - ~~BELOW~~ ON

OFFSET CL PAVEMENT 1.3' ~~LT~~ : RT

10.0' TO RT EDGE PAVEMENT


STATION: 722+68.20

HORIZ.DATUM: NAD83 (2011)

GEOID: 2012A

GRID: NORTHING: 550845.374

EASTING: 1649655.162

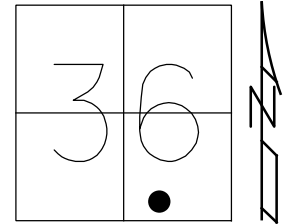

RECORD:

STA 722+68.22

$\Delta = 3^\circ 21' \text{ LT}$

FD P.K./WASHER

7/8/02, DCH

SET MAG/WASHER

2/20/03, DCH

FD MAG/WASHER


REFC29

8/4/14, DCH

SET MAG/WASHER

NEWREFB29

9/7/16, DCH

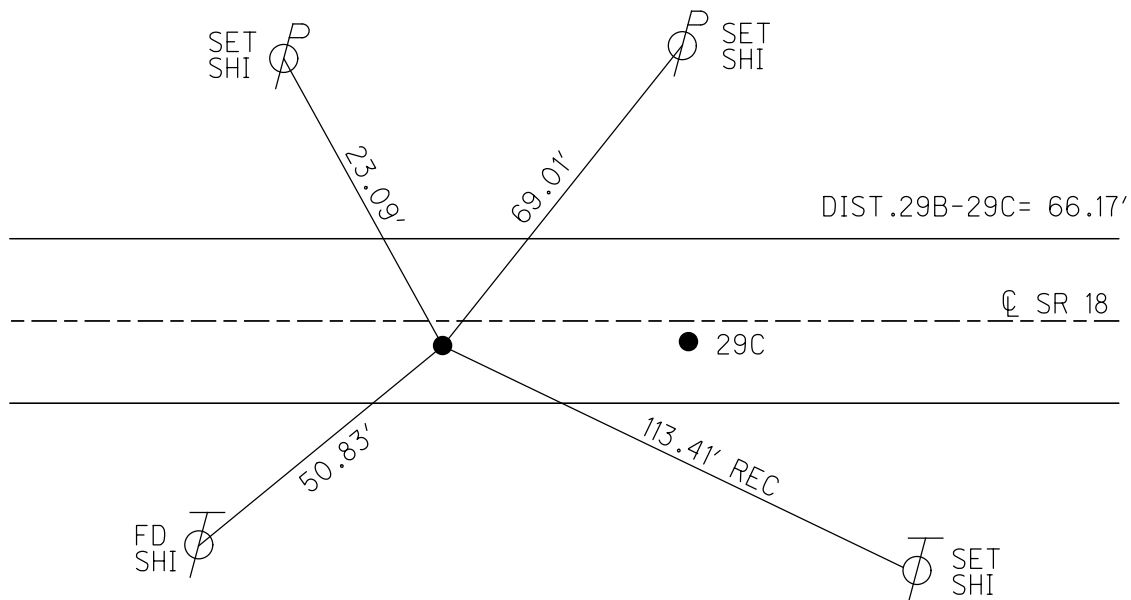

O.D.O.T. DISTRICT 2 SURVEY OFFICE (USE ONLY)

PERSONNEL

REFERENCE NO. 29C

SHEET 19 OF 19

NOTES HOMAN

DATE 8/4/14

ROUTE SR 18

H.C. LUE

WEATHER SUNNY

COUNTY WOOD

R.C. THOMAS

TEMP. 90°

TOWNSHIP HENRY

SECTION 36

DWG BY MILLER

PID 93417

T 3 N R 10 E

TYPE MONUMENT MAG/WASHER

ON SURFACE - ~~BELOW~~ ON

OFFSET CL PAVEMENT 1.3' ~~LT~~ : RT

10.0' TO RT EDGE PAVEMENT


STATION: 723+34.37

HORIZ.DATUM: NAD83 (2011)

GEOID: 2012A


GRID: NORTHING: 550842.422

EASTING: 1649721.258

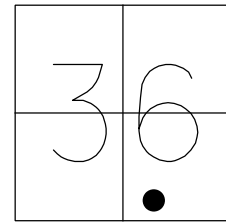

RECORD:
CL SURVEY
STA 723+34.41
 $\Delta = 3^{\circ}20'30''$ LT
SET MAG/WASHER
2/20/03, DCH
FD MAG/WASHER
REFB29
8/4/14, DCH
RESET MAG/WASHER
NEWREFC29
9/7/16, DCH

REF 29 BC
ORIGIN UNKNOWN
FD MAG NAIL
ON CL
N: 550843.596
E: 1649715.120
DIST.29BC-29C= 6.18'

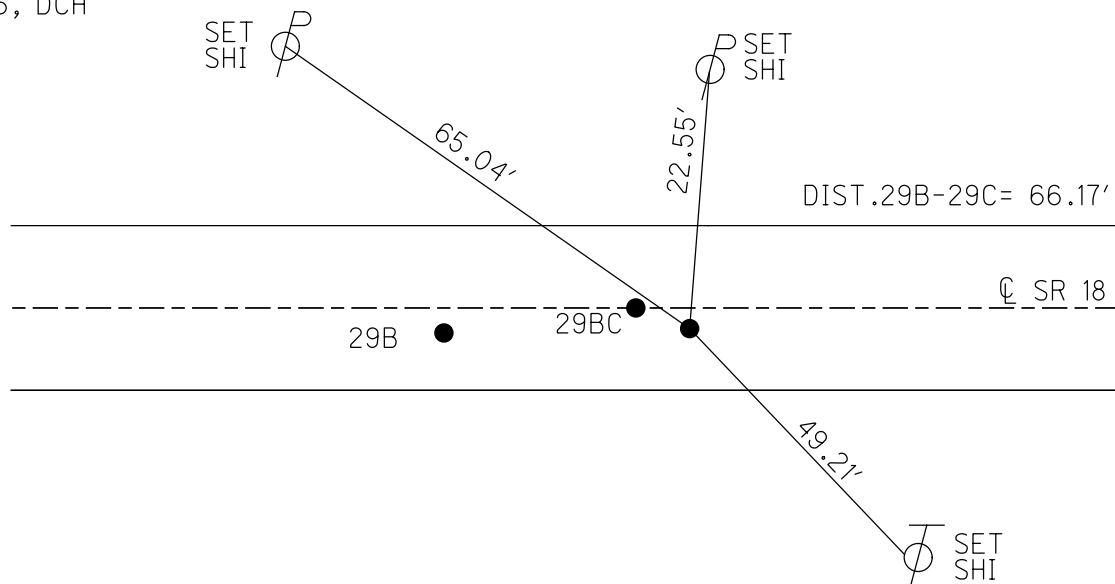

O.D.O.T. DISTRICT 2 SURVEY OFFICE (USE ONLY)

PERSONNEL

REFERENCE NO. 30

SHEET 1 OF 35

NOTES HOFFMAN

DATE 6/17/87

ROUTE SR 18

H.C. LOEHRKE

WEATHER CLEAR

COUNTY WOOD

R.C. BARNHISEL

TEMP. 85°

TOWNSHIP HENRY

SOCKMAN

SECTION 36

DWG BY MILLER

PID 93417

T 3 N R 10 E

TYPE MONUMENT SMALL R.R. SPIKE

ON SURFACE - ~~BELOW~~ ON

OFFSET CL PAVEMENT ON LT : RT

11.4' TO RT EDGE PAVEMENT


STATION: 732+25.50

HORZ.DATUM: NAD83 (2011)

GEOID: 2012A

GRID: NORTHING: 550800.516

EASTING: 1650611.349

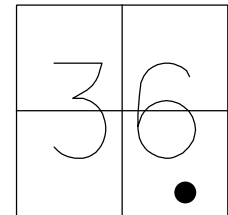

RECORD:

STA 735+84.36

$\Delta = 0^\circ 33' 30''$ LT

FD SMALL R.R. SPIKE

6/17/87, CL


SET P.K./WASHER

7/24/87, CL

FD MONBOX W/ IPIN

REF30

8/4/14, DCH

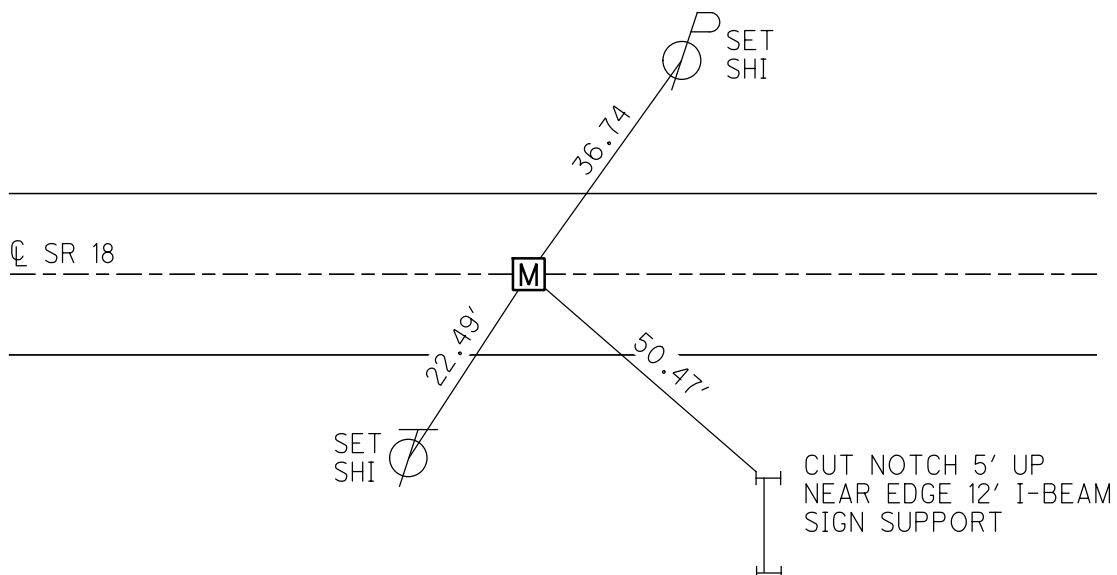

O.D.O.T. DISTRICT 2 SURVEY OFFICE (USE ONLY)

PERSONNEL

REFERENCE NO. 31

SHEET 2 OF 35

NOTES BARNHISEL

DATE 9/11/92

ROUTE SR 18

H.C. VAN DUSEN

WEATHER SUNNY

COUNTY WOOD

R.C. KUSZ

TEMP. 70°

TOWNSHIP BLOOM

SECTION 31

DWG BY MILLER

PID 93417

T 3 N R 11 E

TYPE MONUMENT SMALL R.R. SPIKE

ON SURFACE - ~~BELOW~~ ON

OFFSET CL PAVEMENT 1.0' LT : ~~RT~~

14.5' TO LT EDGE PAVEMENT


STATION: 752+78.75

HORZ.DATUM: NAD83 (2011)

GEOID: 2012A

GRID: NORTHING: 550726.948


EASTING: 1652663.278

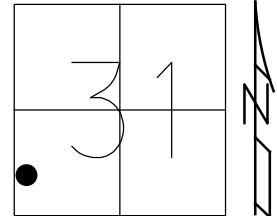

RECORD: P.C.
STA 753+13.15
FD SM R.R. SPIKE
9/11/92, MB
FD MONBOX W/IPIN
REF31
8/4/14, DCH

NOTE:
P.I. CURVE DATA
STA = 755+36.59
 $\Delta = 6^{\circ}41'45''$
D = $1^{\circ}30'00''$
L = 446.39'
T = 223.45'
R = 3819.72'

SET SHI'S
GR POSTS

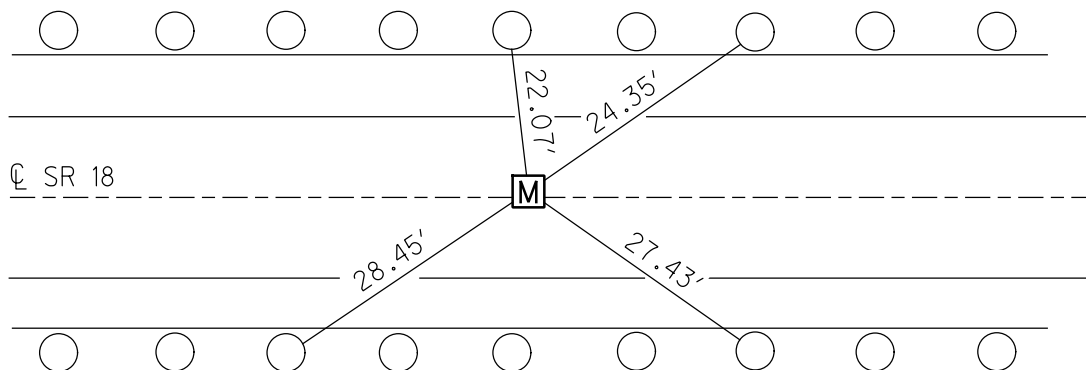

O.D.O.T. DISTRICT 2 SURVEY OFFICE (USE ONLY)

PERSONNEL

REFERENCE NO. 32

SHEET 3 OF 35

NOTES BARNHISEL

DATE 9/11/92

ROUTE SR 18

H.C. VAN DUSEN

WEATHER SUNNY

COUNTY WOOD

R.C. KUSZ

TEMP. 70°

TOWNSHIP BLOOM

SECTION 31

DWG BY MILLER

PID 93417

T 3 N R 11 E

TYPE MONUMENT SMALL R.R. SPIKE

ON SURFACE - ~~BELOW~~ ON

OFFSET CL PAVEMENT 3.0' ~~LT~~ : RT

15.2' TO RT EDGE PAVEMENT


STATION: 756+07.60

HORIZ.DATUM: NAD83 (2011)

GEOID: 2012A

GRID: NORTHING: 550729.260

EASTING: 1652992.027

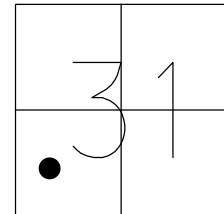

RECORD:

FD SM R.R. SPIKE


9/11/92, MB

FD MONBOX W/IPIN

REF32

8/4/14, DCH

TRUCK
PLAZA

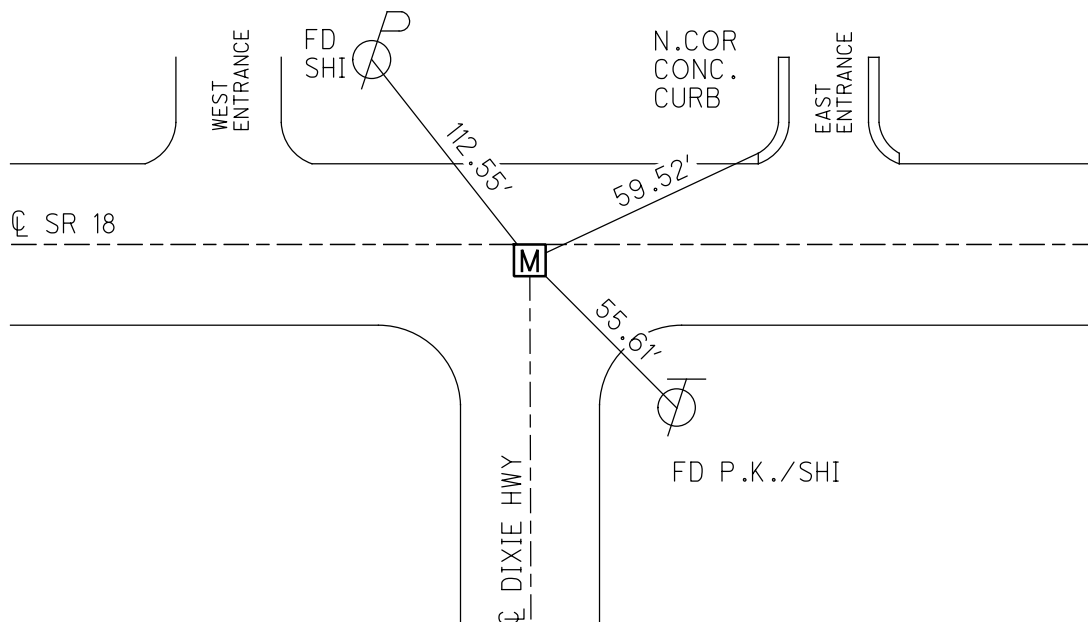

O.D.O.T. DISTRICT 2 SURVEY OFFICE (USE ONLY)

PERSONNEL

REFERENCE NO. 33

SHEET 4 OF 35

NOTES BARNHISEL

DATE 9/11/92

ROUTE SR 18

H.C. VAN DUSEN

WEATHER SUNNY

COUNTY WOOD

R.C. KUSZ

TEMP. 70°

TOWNSHIP BLOOM

DWG BY MILLER PID 93417

SECTION 31

T 3 N R 11 E

TYPE MONUMENT SM.R.R. SPIKE

ON SURFACE - ~~BELOW~~ ON

OFFSET CL PAVEMENT 2.0' LT : ~~RT~~

16.5' TO RT EDGE PAVEMENT


STATION: 757+25.14

HORIZ.DATUM: NAD83 (2011)

GEOID: 2012A


GRID: NORTHING: 550737.026

EASTING: 1653109.306

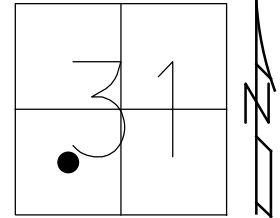

RECORD: P.T.
STA 757+59.53
FD SM R.R. SPIKE
9/11/92
SHOT IPIN IN MONBOX
REF33
8/4/14, DCH

NOTE: P.I.
CURVE DATA
STA = 755+36.59
 $\Delta = 6^{\circ}41'45''$
D = $1^{\circ}30'00''$
L = 446.39'
T = 223.45'
R = 3819.72'

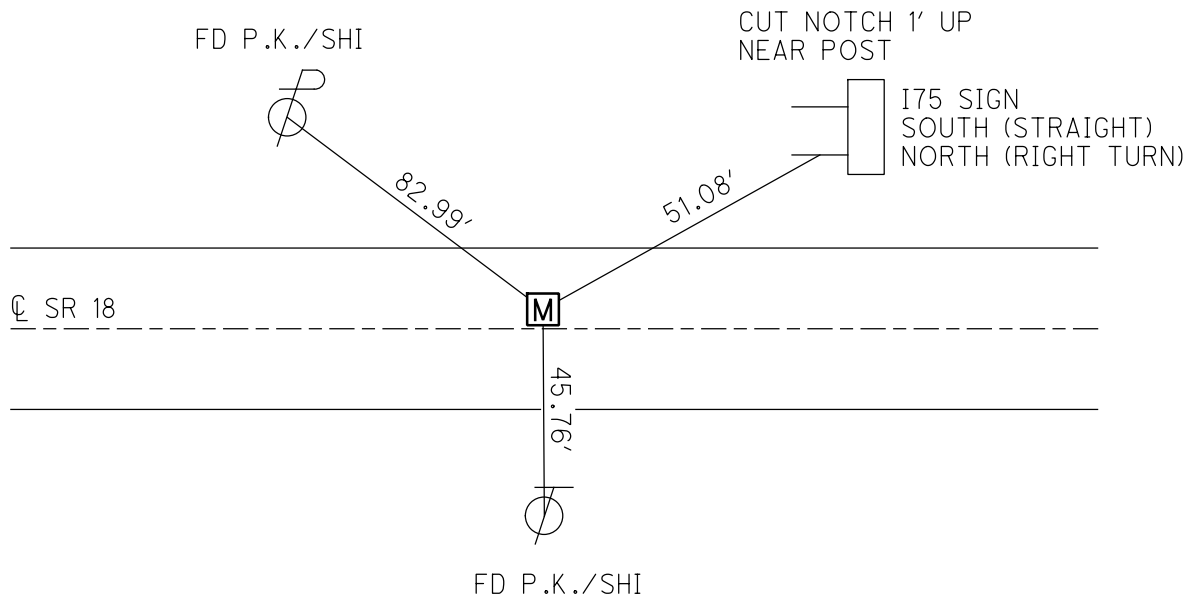

O.D.O.T. DISTRICT 2 SURVEY OFFICE (USE ONLY)

PERSONNEL

REFERENCE NO. 33 A

SHEET 5 OF 35

NOTES HOMAN

DATE 8/25/14

ROUTE SR 18

H.C. LEU

WEATHER SUNNY

COUNTY WOOD

R.C. RHOADES

TEMP. 75°

TOWNSHIP BLOOM

SECTION 31

DWG BY MILLER PID 93417

T 3 N R 11 E

TYPE MONUMENT MONBOX W/IPIN

ON SURFACE - ~~BELOW~~ ON

OFFSET CL PAVEMENT 0.5' LT : ~~RT~~

9.4' TO LT EDGE PAVEMENT


STATION: 763+03.89

HORZ.DATUM: NAD83 (2011)


GEOID: 2012A

GRID: NORTHING: 550787.652

EASTING: 1653685.833

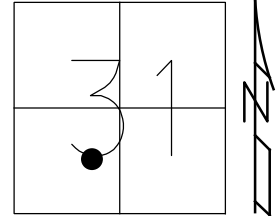

RECORD:
FD MONBOX
W/IPIN
REFA33
8/25/14, DCH

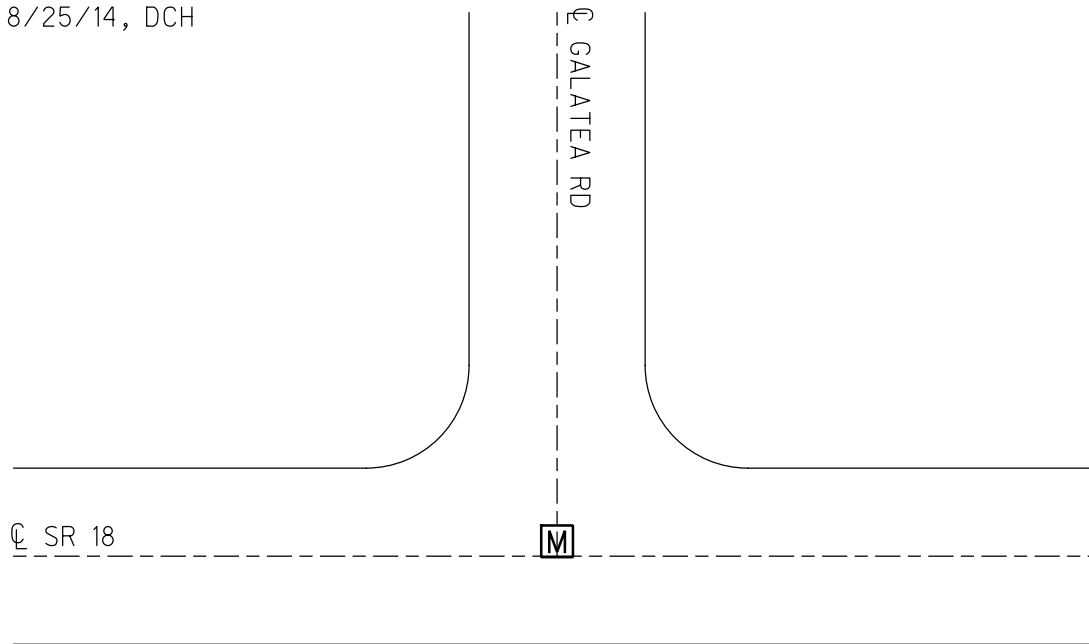

O.D.O.T. DISTRICT 2 SURVEY OFFICE (USE ONLY)

PERSONNEL

REFERENCE NO. 33 B

SHEET 6 OF 35

NOTES HOMAN

DATE 8/25/14

ROUTE SR 18

H.C. LEU

WEATHER SUNNY

COUNTY WOOD

R.C. RHOADES

TEMP. 75°

TOWNSHIP BLOOM

SECTION 31

DWG BY MILLER

PID 93417

T 3 N R 11 E

TYPE MONUMENT P.K.NAIL

ON SURFACE - ~~BELOW~~ ON

OFFSET CL PAVEMENT 0.5' LT : ~~RT~~
9.4' TO LT EDGE PAVEMENT 7.6' W OF CL SOUTH


STATION: 770+81.24

HORZ.DATUM: NAD83 (2011)

GEOID: 2012A

GRID: NORTHING: 550831.650

EASTING: 1654461.941

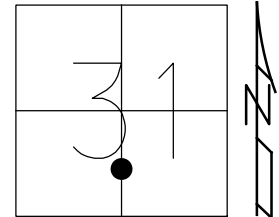

RECORD:

FD LG R.R SPIKE

6/9/99, MB

SET P.K./WASHER

7/20/99, MB


FD P.K./WASHER

REFB33

8/25/14, DCH

SET MAG/WASHER

11/05/14, DCH

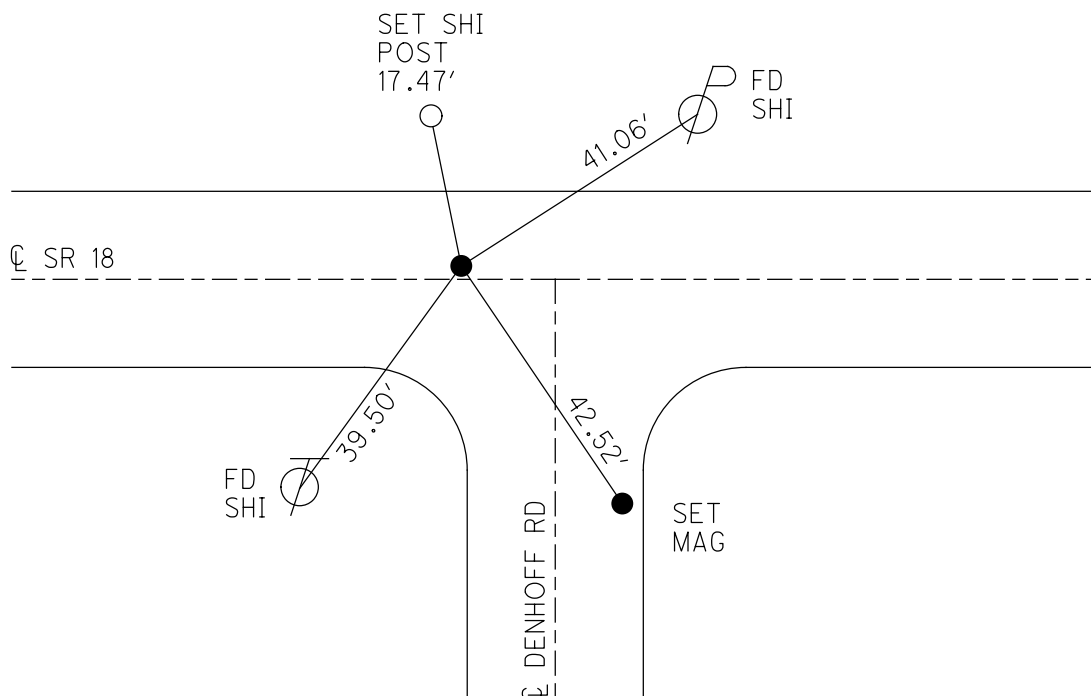

O.D.O.T. DISTRICT 2 SURVEY OFFICE (USE ONLY)

PERSONNEL

REFERENCE NO. 33 C

SHEET 7 OF 35

NOTES HOMAN

DATE 8/25/14

ROUTE SR 18

H.C. LEU

WEATHER SUNNY

COUNTY WOOD

R.C. RHOADES

TEMP. 80°

TOWNSHIP BLOOM

SECTION 31

DWG BY MILLER

PID 93417

T 3 N R 11 E

TYPE MONUMENT P.K.NAIL

ON SURFACE - ~~BELOW~~ ON

OFFSET Q PAVEMENT 0.8' LT : ~~RT~~

8.6' TO LT EDGE PAVEMENT


STATION: 773+31.18

HORZ.DATUM: NAD83 (2011)


GEOID: 2012A

GRID: NORTHING: 550811.870

EASTING: 1654711.098

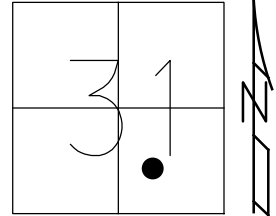

RECORD:
FD FR/OLD SURVEY
OBSERVED
 $\Delta = 05^{\circ}52'38''$
7-30-88
FD SM R.R SPIKE
6/9/99, MB
SET P.K./WASHER
7/20/99, MB
FD P.K.NAIL
REFC33
8/25/14, DCH
SET MAG/WASHER
11/05/14, DCH

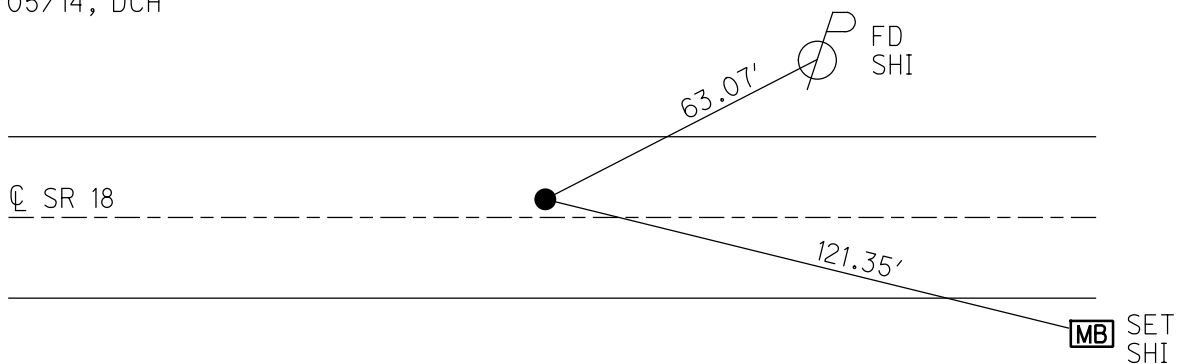

O.D.O.T. DISTRICT 2 SURVEY OFFICE (USE ONLY)

PERSONNEL

REFERENCE NO. 33 D

SHEET 8 OF 35

NOTES NIESE
H.C. NIESE
R.C.

DATE 7/16/24
WEATHER SUNNY
TEMP. 80°

ROUTE SR 18
COUNTY WOOD
TOWNSHIP BLOOM
SECTION 31

DWG BY BARRIERE PID 93417

T 3 N R 11 E

TYPE MONUMENT MAG NAIL/WASHER

ON SURFACE - BELOW ON

OFFSET $\oslash$ PAVEMENT 0.4' LT

TO EDGE PAVEMENT

STATION: 775+30.97

HORIZ.DATUM: NAD83 (2011)


GEOID: 18

GRID: NORTHING: 550775.634


EASTING: 1654907.567

LDP: NORTHING: 372651.192

EASTING: 167029.867

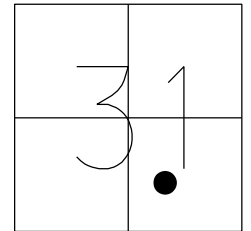

RECORD:
FD FR/OLD SURVEY
OBSERVED
 $\Delta=02^{\circ}47'56''$ RT
8-30-88
FD P.K. NAIL
6/9/99, MB
SET P.K./WASHER
7/20/99, MB
FD P.K. NAIL
REFD33
8/25/14, DCH
SET MAG/WASHER
11/05/14, DCH
FD MAG/WASHER
REF33D
7/16/24, TDN

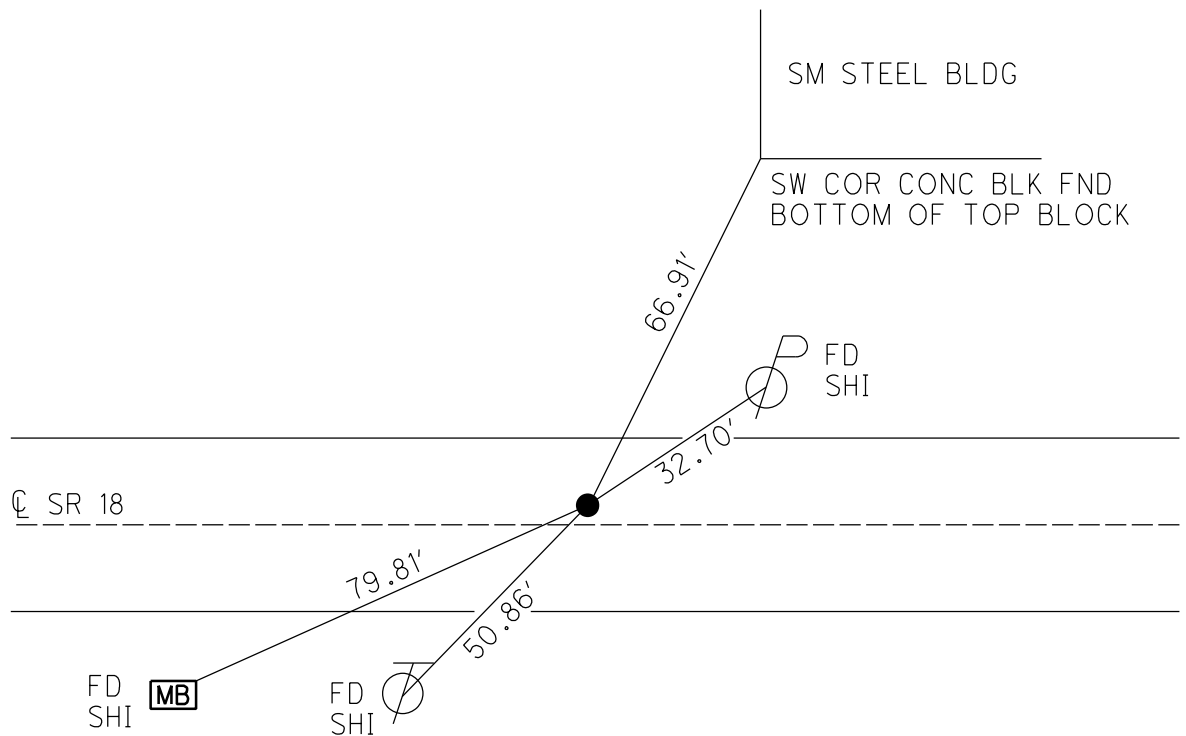

O.D.O.T. DISTRICT 2 SURVEY OFFICE (USE ONLY)

PERSONNEL

REFERENCE NO. 33 E

SHEET 9 OF 35

NOTES NIESE

DATE 7/16/24

ROUTE SR 18

H.C. NIESE

WEATHER SUNNY

COUNTY WOOD

R.C.

TEMP. 80°

TOWNSHIP BLOOM

DWG BY BARRIERE

PID NO PID

SECTION 31

T 3 N R 11 E

TYPE MONUMENT MAG SHANK

ON SURFACE - BELOW ON

OFFSET CL PAVEMENT ON LT : RT

9.3' TO RT EDGE PAVEMENT

STATION: 787+62.68

HORZ.DATUM: NAD83 (2011)


GEOID: 18

GRID: NORTHING: 550493.862

EASTING: 1656106.624

LDP: NORTHING:


EASTING:

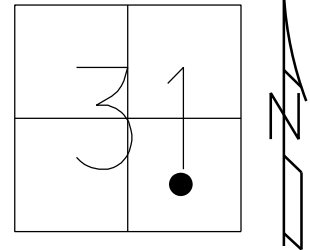

RECORD:
FD FR/OLD SURVEY
OBSERVED
 $\Delta=04^{\circ}02'43''$ RT
9-26-88
FD R.R. SPIKE
6/9/99, MB
SET P.K./WASHER
7/20/99, MB
FD P.K. NAIL
REFE33
8/25/14, DCH
SET MAG/WASHER
11/05/14, DCH
FD MAG SHANK
REF33E
7/16/24, TDN

$4^{\circ}02'26.1''$
MEASURED WHEN
HOLDING RECRE33F

FD P.K. 2' FR/
END OF 12" CMP

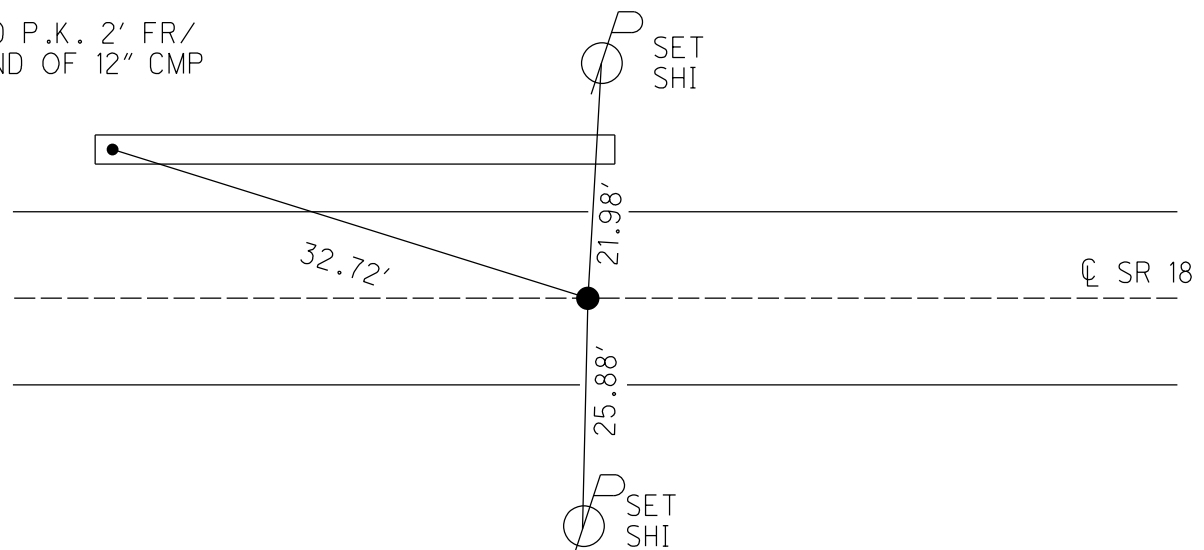

O.D.O.T. DISTRICT 2 SURVEY OFFICE (USE ONLY)

PERSONNEL

REFERENCE NO. 33 F

SHEET 10 OF 35

NOTES NIESE

DATE 7/24/24

ROUTE SR 18

H.C. NIESE

WEATHER SUNNY

COUNTY WOOD

R.C.

TEMP. 80°

TOWNSHIP BLOOM

DWG BY BARRIERE

PID NO PID

SECTION 31

T 3 N R 11 E

TYPE MONUMENT MAG/WASHER

ON SURFACE - BELOW ON

OFFSET CL PAVEMENT 6.6' ~~LT~~ : RT

3.0 TO RT EDGE PAVEMENT

STATION: 796+23.09

HORZ.DATUM: NAD83 (2011)


GEOID: 18

GRID: NORTHING: 550356.482

EASTING: 1656955.996

LDP: NORTHING: 372259.088

EASTING: 169083.726

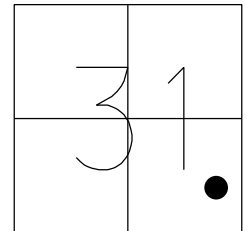

RECORD: P.I.
POINT SET
OBSERVED
 $\Delta=10^{\circ}14'17''$
9-26-88
FD P.K./WASHER
6/9/99, MB
SET P.K./WASHER
7/20/99, MB
FD P.K./WASHER
REF33
8/25/14, DCH
D.N.F.
7/16/24, TDN
SET MAG/WASH
BY GPS COORDS
REF33F
7/24/24, TDN

CL SR 18



O.D.O.T. DISTRICT 2 SURVEY OFFICE (USE ONLY)

PERSONNEL

REFERENCE NO. 33 G

SHEET 11 OF 35

NOTES NIESE

DATE 7/16/24

ROUTE SR 18

H.C. NIESE

WEATHER SUNNY

COUNTY WOOD

R.C.

TEMP. 80°

TOWNSHIP BLOOM

SECTION 31

DWG BY BARRIERE

PID NO PID

T 3 N R 11 E

TYPE MONUMENT MAG SHANK

ON SURFACE - BELOW ON

OFFSET $\varnothing$ PAVEMENT 0.2' ~~LT~~ : RT

9.3' TO RT EDGE PAVEMENT

STATION: 797+65.27

HORIZ.DATUM: NAD83 (2011)


GEOID: 18

GRID: NORTHING: 550359.150

EASTING: 1657098.142

LDP: NORTHING: 372263.682

EASTING: 169225.904

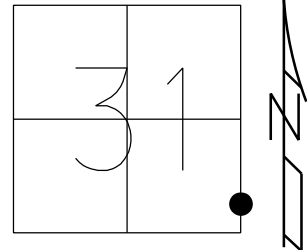

RECORD:

FD P.K. SHANK

6/16/99, MB

SET P.K./WASHER

7/20/99, MB

FD P.K./WASHER

REFG33

8/25/14, DCH


SET MAG/WASHER

11/05/14, DCH

FD MAG SHANK

REF33G

7/16/24, TDN

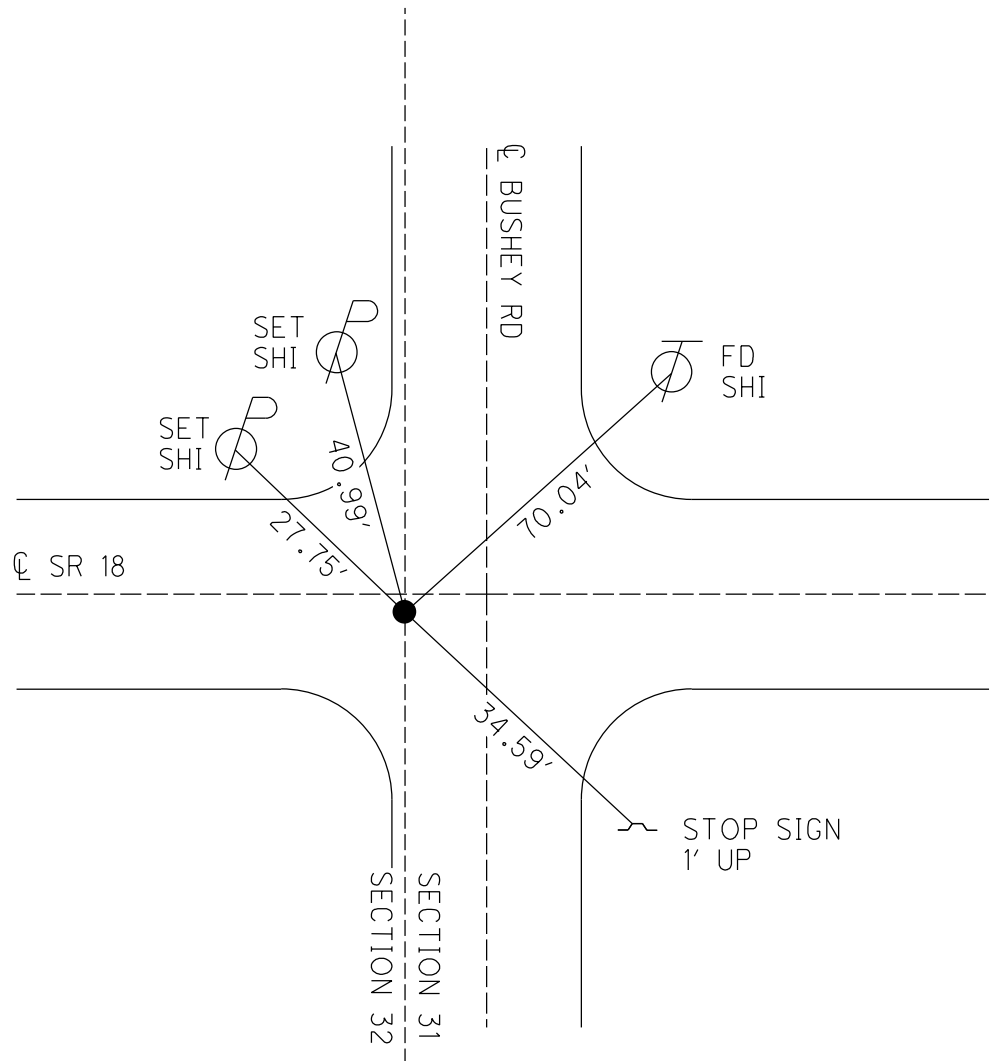

O.D.O.T. DISTRICT 2 SURVEY OFFICE (USE ONLY)

PERSONNEL

REFERENCE NO. 33 H

SHEET 12 OF 29

NOTES NIESE
H.C. NIESE
R.C. _____

DATE 7/16/24
WEATHER SUNNY
TEMP. 80°

ROUTE SR 18
COUNTY WOOD
TOWNSHIP BLOOM
SECTION 32

DWG BY BARRIERE PID NO PID

T 3 N R 11 E

TYPE MONUMENT MAG/WASHER

ON SURFACE - BELOW ON

OFFSET CL PAVEMENT 2' ~~LF~~ : RT

7.4' TO RT EDGE PAVEMENT

STATION: 802+38.34

HORZ.DATUM: NAD83 (2011)


GEOID: 18

GRID: NORTHING: 550367.957


EASTING: 1657571.137

LDP: NORTHING: 372278.640

EASTING: 169698.736

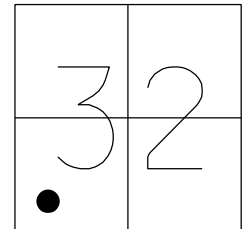

RECORD: P.I.
FD P.K./WASHER
6/16/99, MB
SET P.K./WASHER
7/20/99, MB
FD P.K./WASHER
REFH33
8/25/14, DCH
SET MAG/WASHER
11/05/14, DCH
FD MAG/WASHER
REF33H
7/16/24, TDN

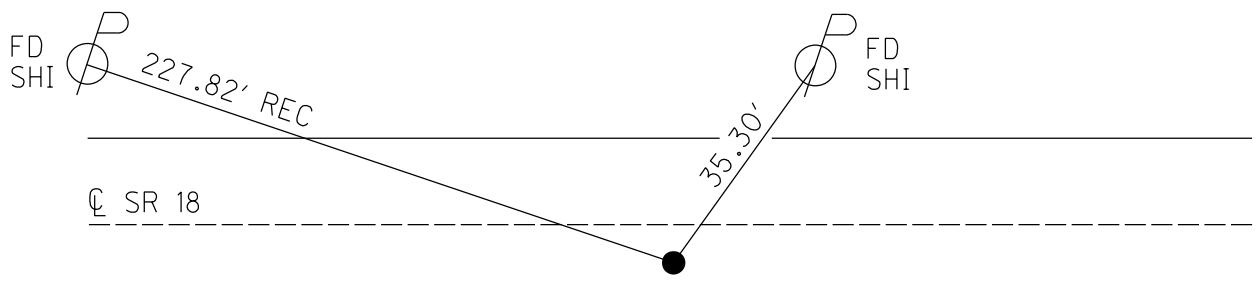

O.D.O.T. DISTRICT 2 SURVEY OFFICE (USE ONLY)

PERSONNEL

REFERENCE NO. 34

SHEET 13 OF 35

NOTES HOMAN

DATE 8/25/14

ROUTE SR 18

H.C. LEU

WEATHER SUNNY

COUNTY WOOD

R.C. RHOADES

TEMP. 80°

TOWNSHIP BLOOM

SECTION 33

DWG BY MILLER

PID 93417

T 3 N R 11 E

TYPE MONUMENT SM.R.R. SPIKE

~~ON SURFACE~~ - BELOW 0.5"

OFFSET $\varnothing$ PAVEMENT 24.0' ~~LT~~ : RT
- TO - EDGE PAVEMENT 2.0' E $\varnothing$ OF PVMT S


STATION: 850+99.70

HORZ.DATUM: NAD83 (2011)


GEOID: 2012A

GRID: NORTHING: 550663.236

EASTING: 1662423.519

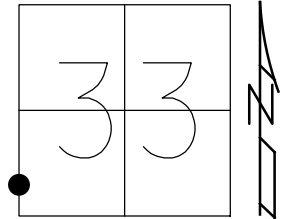

RECORD:
FD SM R.R. SPIKE
6/16/99, MB
SET P.K./WASHER
7/20/99, MB
FD SM R.R. SPIKE
REF34
8/25/14, DCH

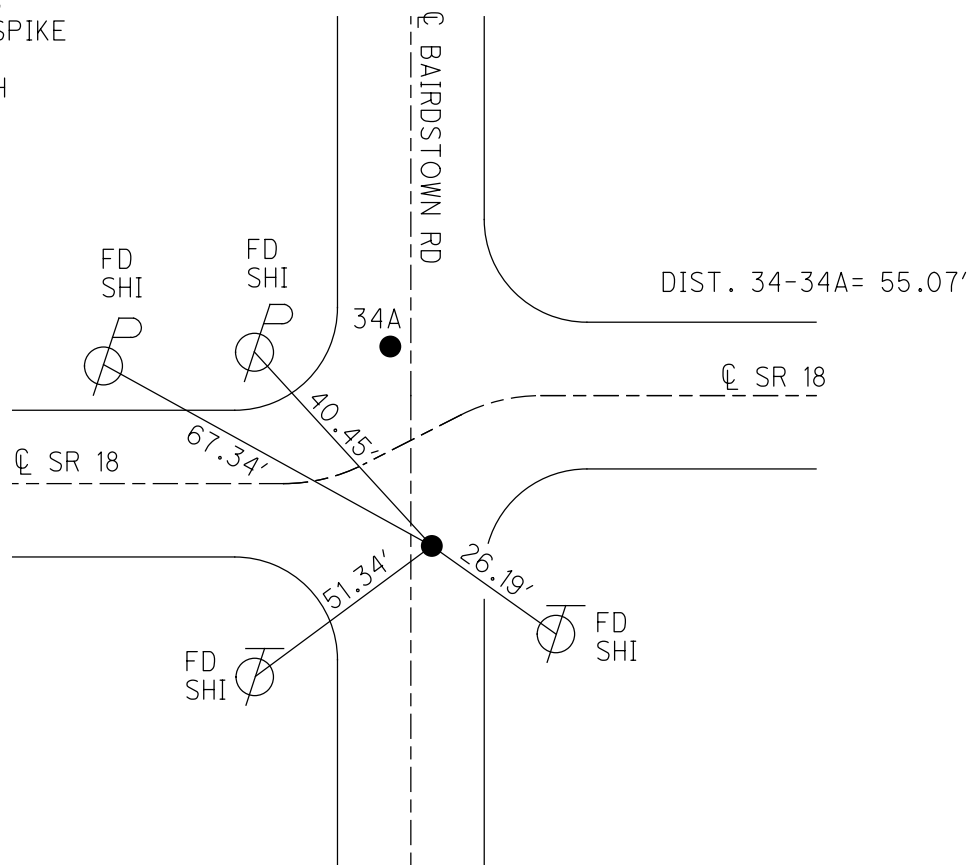

PERSONNEL

REFERENCE NO. 34 A

SHEET 14 OF 35

NOTES _____ HOMAN

DATE 8/25/14ROUTE SR 18

H.C. LEU

WEATHER SUNNY

COUNTY WOOD

R.C. RHOADES

TEMP. 80°

TOWNSHIP BLOOMSECTION 33

DWG BY MILLER PID 93417

T_3_N R_11_E

TYPE MONUMENT SM.R.R. SPIKE

~~ON SURFACE~~ - BELOW 0.5"

OFFSET C PAVEMENT 31.0' LT : RT

____ TO ____ EDGE PAVEMENT 2.0' W C OF PVMT N

STATION: 851+54.77

HORZ.DATUM: NAD83 (2011)

GEOID: 2012A

GRID: NORTHING: 550718.287

EASTING: 1662424.789

RECORD:

FD SM.R.R. SPIKE


6/16/99

7/20/99, MB

FD SM R.R. SPIKE

REF A34

8/25/14, DCH

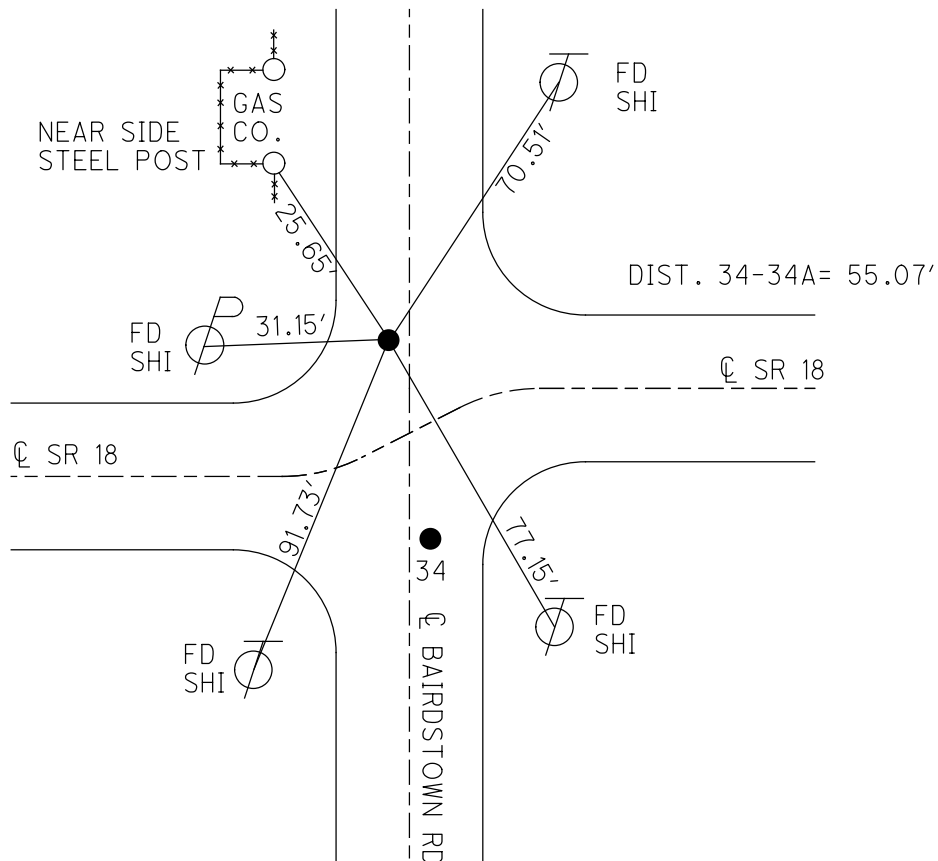

O.D.O.T. DISTRICT 2 SURVEY OFFICE (USE ONLY)

PERSONNEL

REFERENCE NO. 34 B

SHEET 15 OF 35

NOTES HOMAN

DATE 8/25/14

ROUTE SR 18

H.C. LEU

WEATHER SUNNY

COUNTY WOOD

R.C. RHOADES

TEMP. 85°

TOWNSHIP BLOOM

DWG BY MILLER

PID 93417

SECTION 33

T 3 N R 11 E

TYPE MONUMENT P.K.

ON SURFACE - ~~BELOW~~ ON

OFFSET Q PAVEMENT ON LT : RT

10.0' TO RT EDGE PAVEMENT


STATION: 859+06.61

HORZ.DATUM: NAD83 (2011)

GEOID: 2012A

GRID: NORTHING: 550688.446

EASTING: 1663176.039

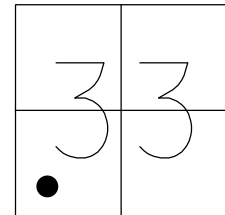

RECORD:

FD P.K./SHI

6/16/99, MB

SET P.K./WASHER

7/20/99, MB

SET P.K./WASHER

9/20/99, MB


FD P.K. SHANK

REFB34

8/25/14, DCH

SET MAG/WASHER

11/05/14, DCH

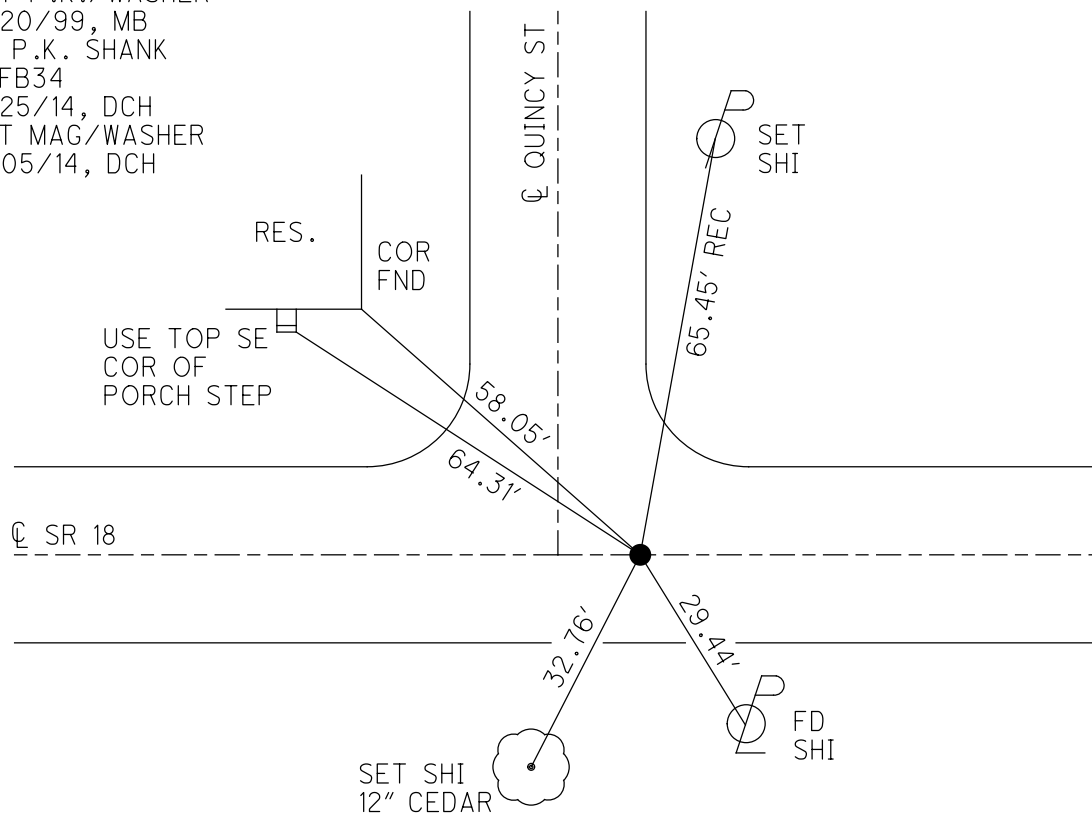

O.D.O.T. DISTRICT 2 SURVEY OFFICE (USE ONLY)

PERSONNEL

REFERENCE NO. 34 C

SHEET 16 OF 35

NOTES HOMAN

DATE 8/25/14

ROUTE SR 18

H.C. LEU

WEATHER SUNNY

COUNTY WOOD

R.C. RHOADES

TEMP. 85°

TOWNSHIP BLOOM

SECTION 33

DWG BY MILLER PID 93417

T 3 N R 11 E

TYPE MONUMENT P.K./WASHER

ON SURFACE - ~~BELOW~~ ON

OFFSET Q PAVEMENT ON ~~LT:RT~~

- TO - EDGE PAVEMENT


STATION: 862+91.31

HORIZ.DATUM: NAD83 (2011)

GEOID: 2012A


GRID: NORTHING: 550672.792

EASTING: 1663560.422

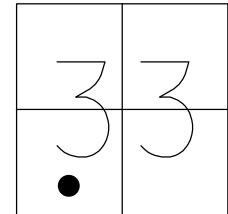

RECORD:

FD P.K./WASHER
6/16/99, MB
SET P.K./WASHER
7/20/99, MB
FD P.K./WASHER
REFC34
8/25/14, DCH
SET MAG/WASHER
11/05/14, DCH

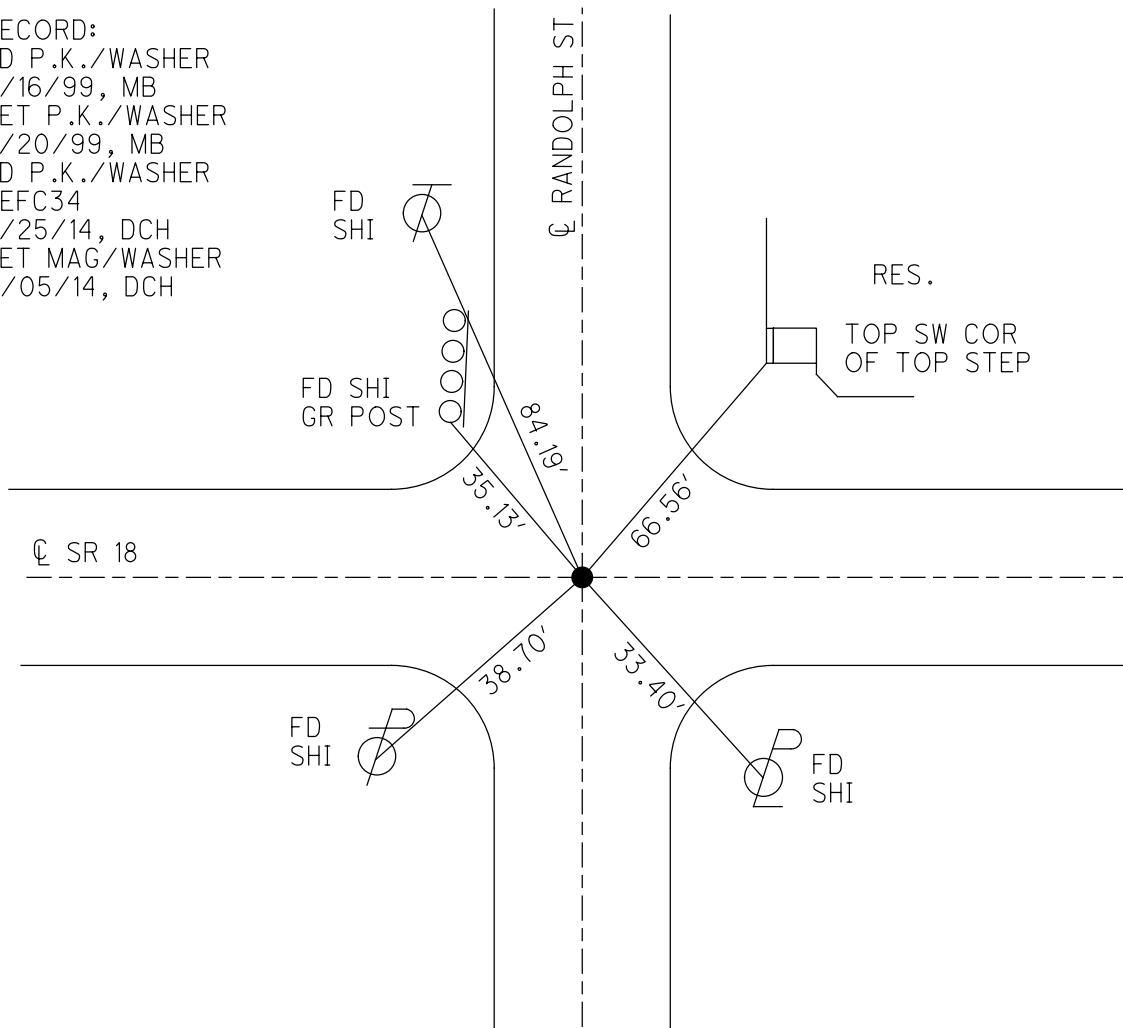

O.D.O.T. DISTRICT 2 SURVEY OFFICE (USE ONLY)

PERSONNEL

REFERENCE NO. 34 D

SHEET 17 OF 35

NOTES HOMAN

DATE 8/25/14

ROUTE SR 18

H.C. LEU

WEATHER SUNNY

COUNTY WOOD

R.C. RHOADES

TEMP. 85°

TOWNSHIP BLOOM

DWG BY MILLER PID 93417

SECTION 33

T 3 N R 11 E

TYPE MONUMENT P.K./WASHER

ON SURFACE - ~~BELOW~~ ON

OFFSET CL PAVEMENT ON LT : RT

- TO - EDGE PAVEMENT


STATION: 866+78.70

HORIZ.DATUM: NAD83 (2011)

GEOID: 2012A

GRID: NORTHING: 550657.965

EASTING: 1663947.529

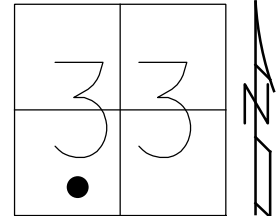

RECORD:

FD P.K./WASHER

6/16/99, MB

SET P.K./WASHER

7/20/99, MB


FD P.K./WASHER

REFD4

8/25/14, DCH

SET MAG/WASHER

11/06/14, DCH

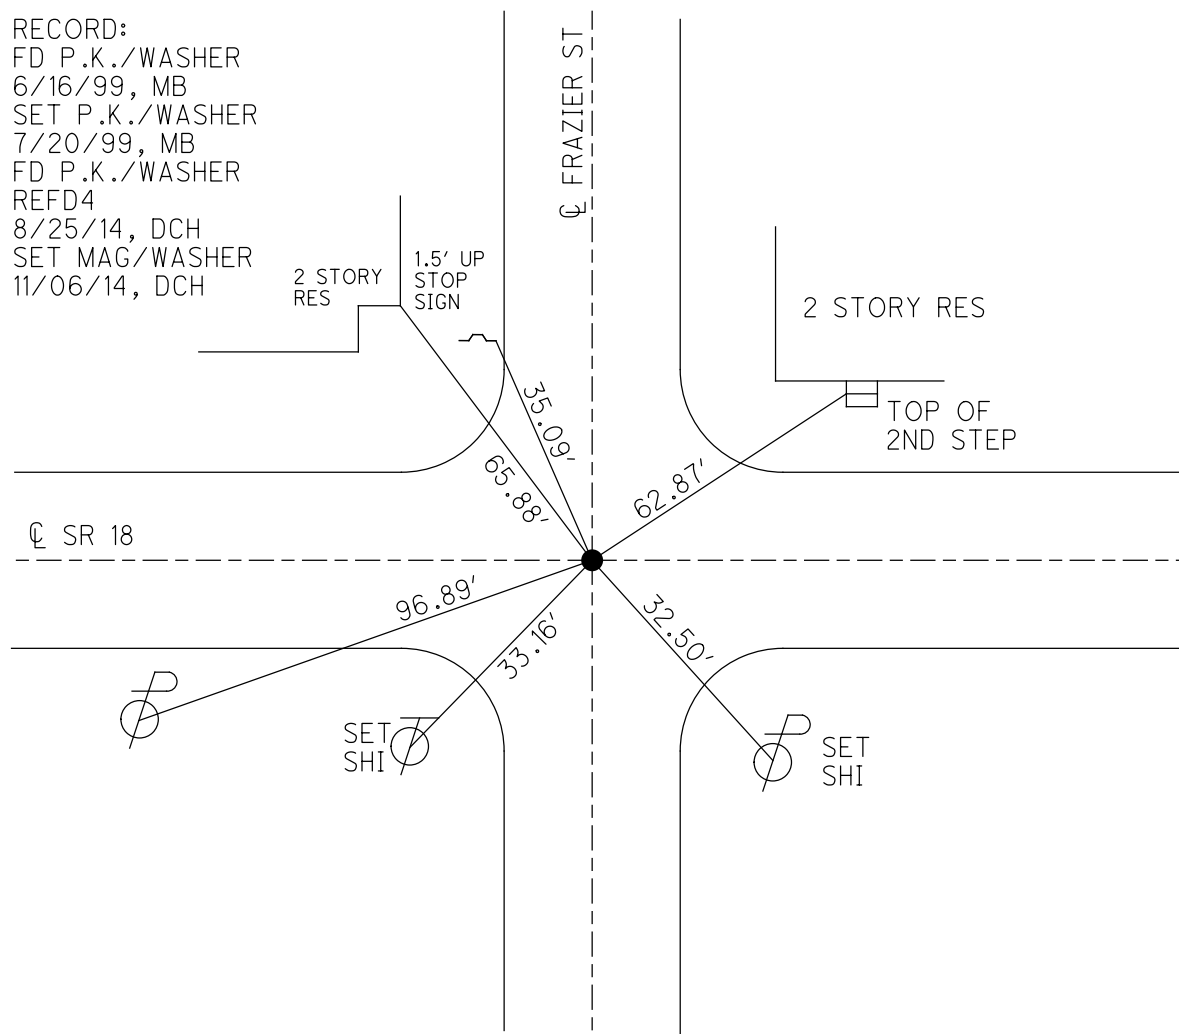

O.D.O.T. DISTRICT 2 SURVEY OFFICE (USE ONLY)

PERSONNEL

REFERENCE NO. 34 E

SHEET 18 OF 35

NOTES HOMAN

DATE 8/25/14

ROUTE SR 18

H.C. LEU

WEATHER SUNNY

COUNTY WOOD

R.C. RHOADES

TEMP. 85°

TOWNSHIP BLOOM

SECTION 33

DWG BY MILLER PID 93417

T 3 N R 11 E

TYPE MONUMENT P.K./WASHER

ON SURFACE - ~~BELOW~~ ON

OFFSET CL PAVEMENT ON LT : RT

9.2' TO RT EDGE PAVEMENT


STATION: 870+49.60

HORZ.DATUM: NAD83 (2011)

GEOID: 2012A

GRID: NORTHING: 550643.268

EASTING: 1664318.137

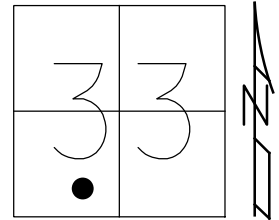

RECORD:

FD P.K./WASHER

6/16/99, MB

SET P.K./WASHER

7/20/99, MB


FD P.K./WASHER

REFE34

8/25/14, DCH

SET MAG/WASHER

11/06/14, DCH

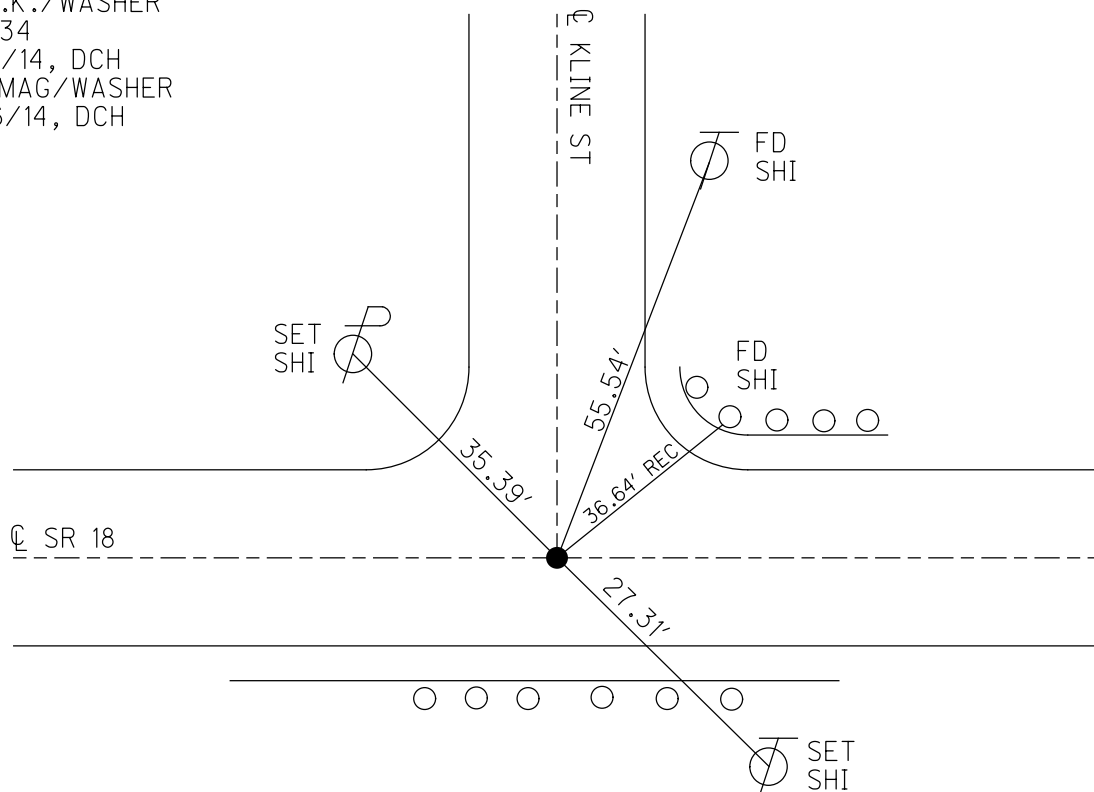

O.D.O.T. DISTRICT 2 SURVEY OFFICE (USE ONLY)

PERSONNEL

REFERENCE NO. 35

SHEET 19 OF 35

NOTES HOMAN

DATE 8/25/14

ROUTE SR 18

H.C. LEU

WEATHER SUNNY

COUNTY WOOD

R.C. RHOADES

TEMP. 85°

TOWNSHIP BLOOM

SECTION 33

DWG BY MILLER

PID 93417

T 3 N R 11 E

TYPE MONUMENT 3/4" IPIN

ON SURFACE - ~~BELOW~~ 2"

OFFSET $\varnothing$ PAVEMENT 47' ~~LT:RT~~

- TO - EDGE PAVEMENT


STATION: 877+93.74

HORZ.DATUM: NAD83 (2011)


GEOID: 2012A

GRID: NORTHING: 550613.900

EASTING: 1665061.694

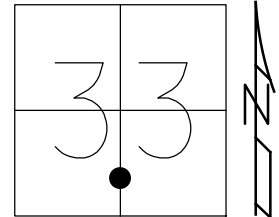

RECORD:
FD 3/4" IPIN
6/16/99, MB
FD IPIN
REF35
8/25/14, DCH

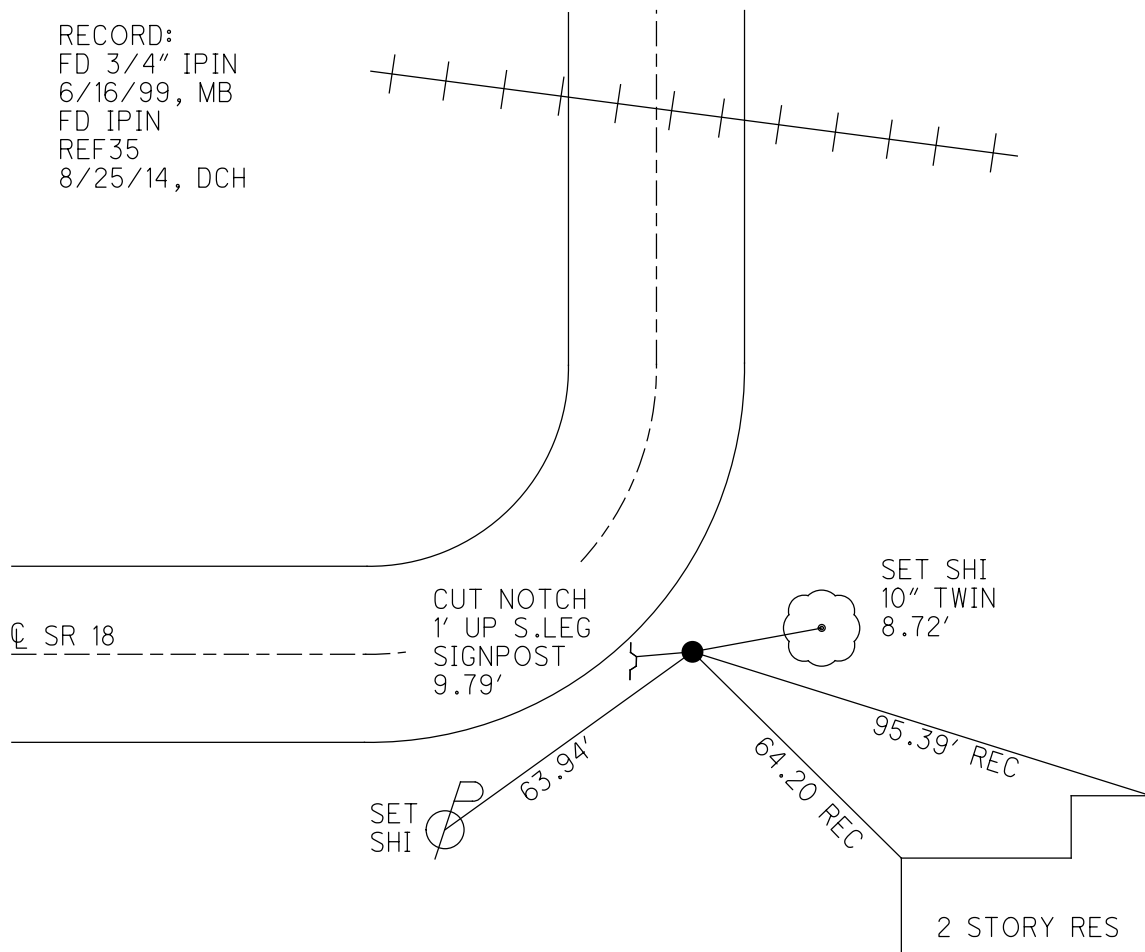

O.D.O.T. DISTRICT 2 SURVEY OFFICE (USE ONLY)

PERSONNEL

REFERENCE NO. 36

SHEET 20 OF 35

NOTES_____HOMAN

DATE 8/26/14ROUTE SR 18

H.C. LEU

WEATHER SUNNY

COUNTY WOOD

R.C. RHOADES

TEMP. 75°

TOWNSHIP BLOOMDWG BY MILLER

PID 93417

T_3_N R_11_E

TYPE MONUMENT P.K.NAIL

ON SURFACE - ~~BELOW~~ ON

OFFSET $\odot$ PAVEMENT 5.0' ~~LT~~ : RT



11.0' TO LT EDGE PAVEMENT 1.0' S CL E.B.

STATION: 885+63.77

HORZ.DATUM: NAD83 (2011)

GEOID: 2012A

GRID: NORTHING: 551383.626

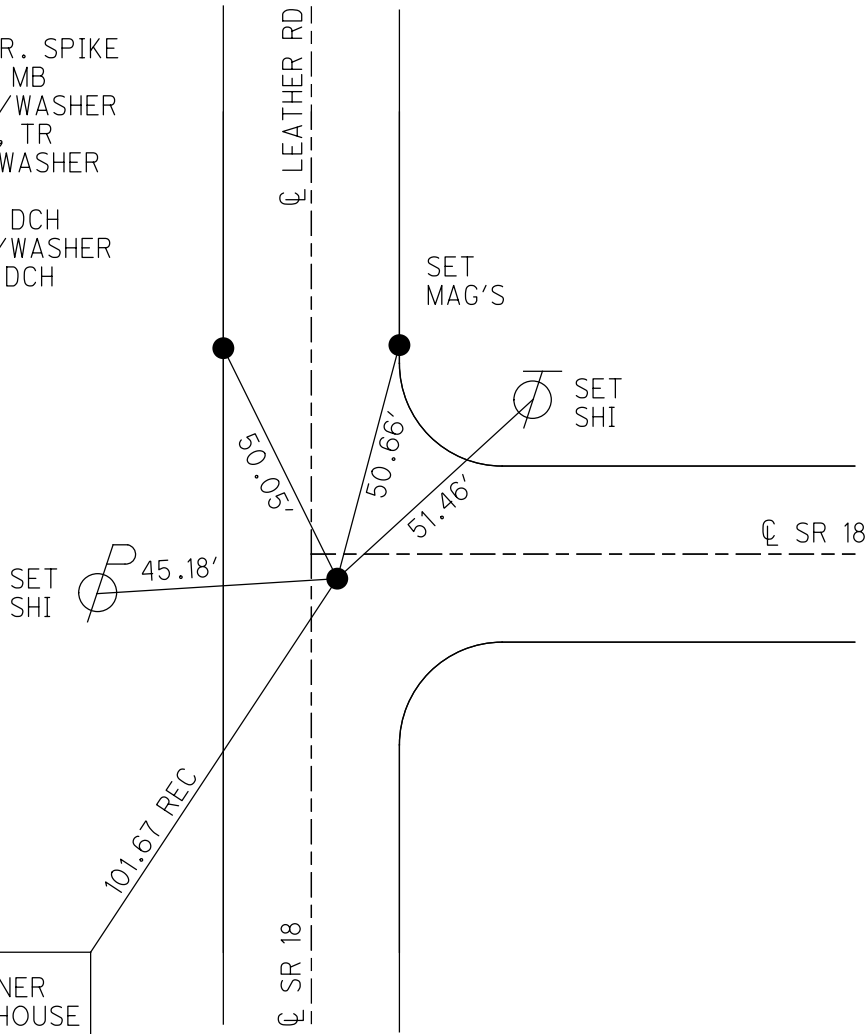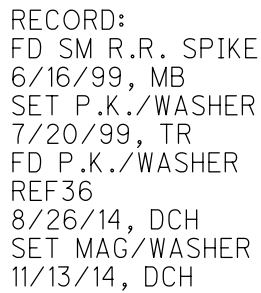EASTING: 1665083.268

O.D.O.T. DISTRICT 2 SURVEY OFFICE (USE ONLY)

PERSONNEL

REFERENCE NO. 37

SHEET 21 OF 35

NOTES HOMAN

DATE 8/26/14

ROUTE SR 18

H.C. LEU

WEATHER SUNNY

COUNTY WOOD

R.C. HOMAN

TEMP. 75°

TOWNSHIP BLOOM

SECTION 33

DWG BY MILLER

PID 93417

T 3 N R 11 E

TYPE MONUMENT P.K. NAIL

ON SURFACE - ~~BELOW~~ ON

OFFSET CL PAVEMENT ON LT : RT

9.7' TO LT EDGE PAVEMENT 7' E. OF CL S.


STATION: 912+22.71

HORZ.DATUM: NAD83 (2011)


GEOID: 2012A

GRID: NORTHING: 551269.407

EASTING: 1667739.760

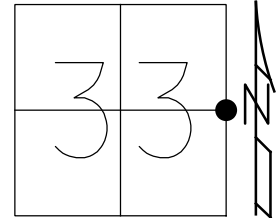

RECORD:
FD P.K. NAIL
6/16/99, MB
SET P.K./WASHER
7/20/99, TR
FD P.K./WASHER
REF37
8/26/14, DCH
SET MAG/WASHER
11/13/14, DCH

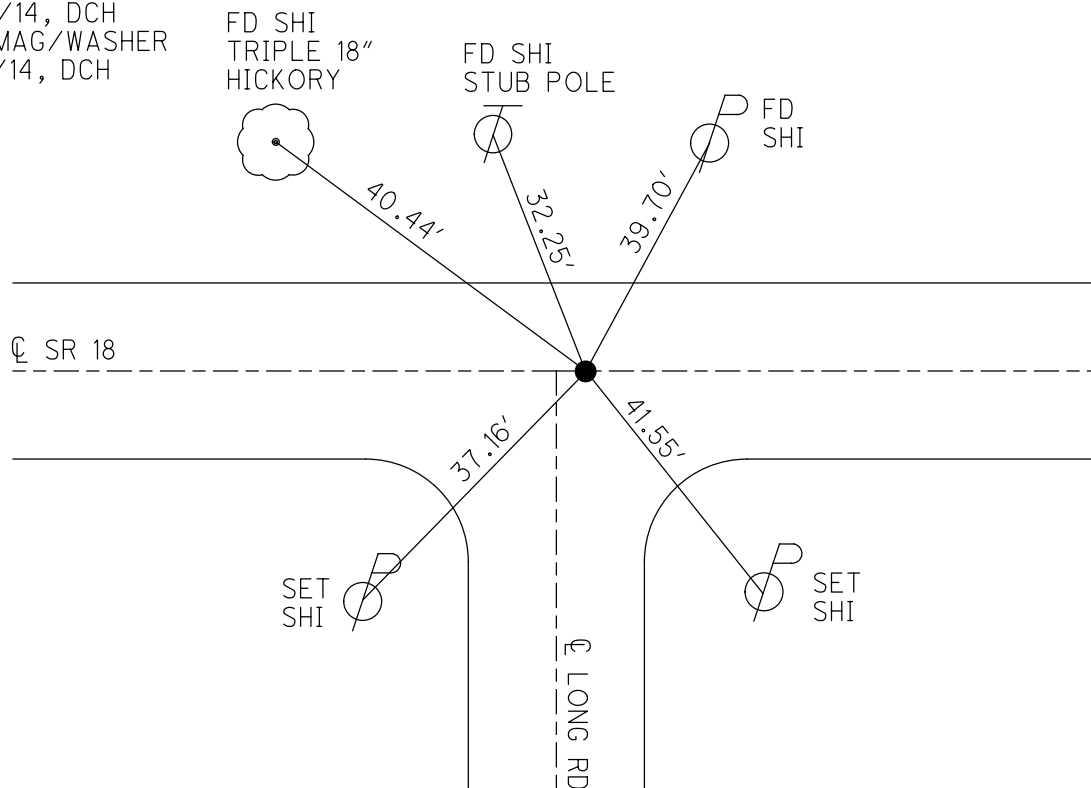

O.D.O.T. DISTRICT 2 SURVEY OFFICE (USE ONLY)

PERSONNEL

REFERENCE NO. 37 A

SHEET 22 OF 35

NOTES HOMAN

DATE 8/26/14

ROUTE SR 18

H.C. LEU

WEATHER SUNNY

COUNTY WOOD

R.C. HOMAN

TEMP. 75°

TOWNSHIP BLOOM

SECTION 34

DWG BY MILLER

PID 93417

T 3 N R 11 E

TYPE MONUMENT P.K./WASHER

ON SURFACE - ~~BELOW~~ ON

OFFSET Q PAVEMENT 1.5' ~~LT~~ : RT

7.9' TO RT EDGE PAVEMENT 2.0' E. Q N.


STATION: 925+39.41

HORZ.DATUM: NAD83 (2011)

GEOID: 2012A


GRID: NORTHING: 551213.261

EASTING: 1669055.262

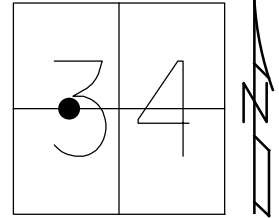

RECORD:

FD P.K./WASHER
6/16/99, MB
SET P.K./WASHER
7/20/99, TR
FD P.K./WASHER
REFA37
8/26/14, DCH
SET MAG/WASHER
11/13/14, DCH

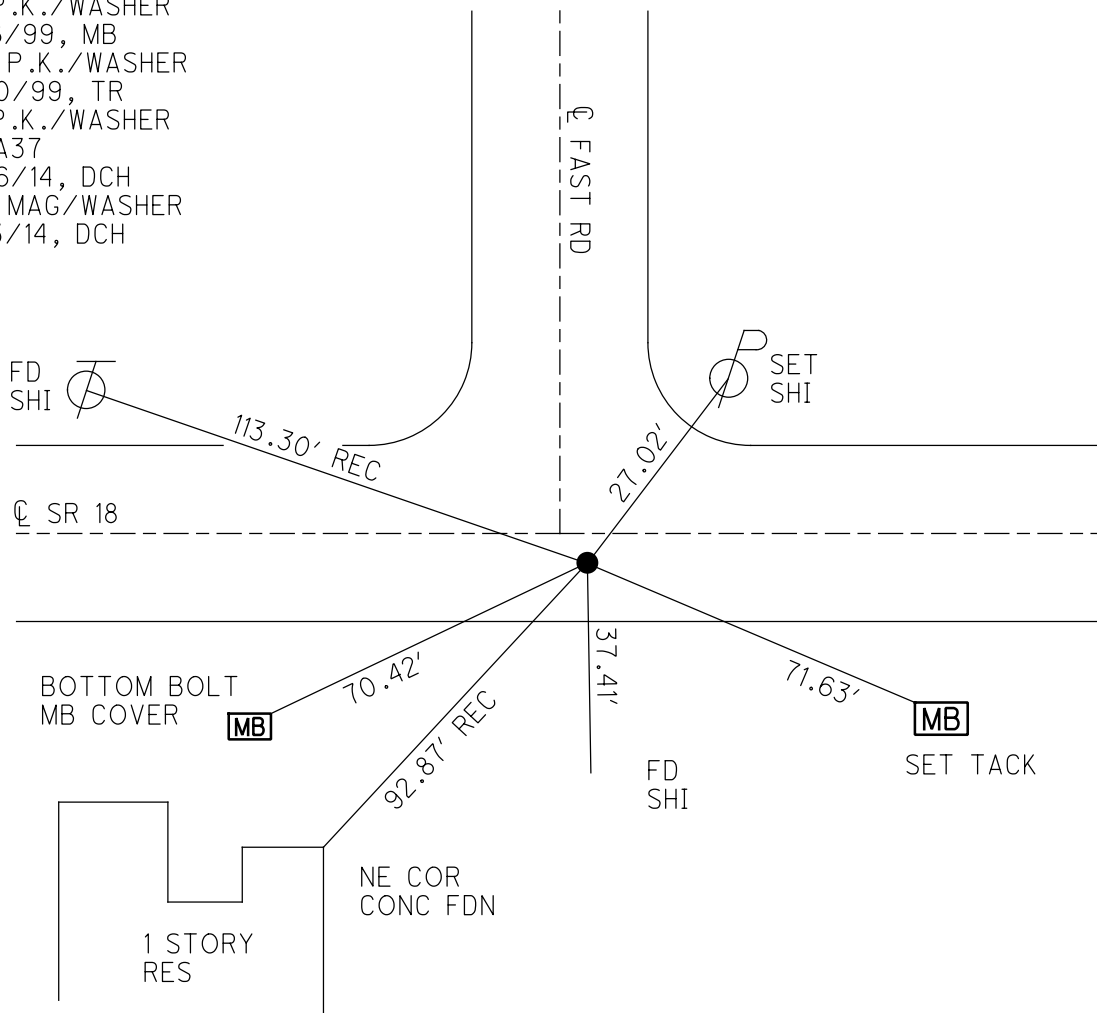

O.D.O.T. DISTRICT 2 SURVEY OFFICE (USE ONLY)

PERSONNEL

REFERENCE NO. 38

SHEET 23 OF 36

NOTES O'DONNELL

DATE 11/5/20

ROUTE SR 18

H.C. AUBLE

WEATHER CLOUDY/WINDY

COUNTY WOOD

R.C. O'DONNELL

TEMP. 50°

TOWNSHIP BLOOM

DWG BY RHOADES PID 95796

SECTION 34

T 3 N R 11 E

TYPE MONUMENT MAG/WASHER

ON SURFACE - ~~BELOW~~ ON

OFFSET CL PAVEMENT 1.8' ~~LT~~ : RT

7.6' TO RT EDGE PAVEMENT


STATION: 938+59.23

HORZ.DATUM: NAD83 (2011)

GEOID: NAVD88 2018


GRID: NORTHING: 551156.854

EASTING: 1670373.913

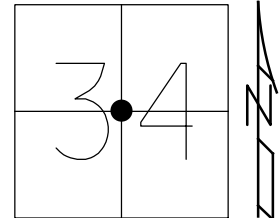

RECORD:
FD SM R.R. SPIKE
6/16/99, MB
SET P.K./WASHER
7/20/99, TR
FD P.K.NAIL
REF38
8/26/14, DCH
SET MAG/WASHER
11/13/14, DCH
FD MAG/WASHER
REF38
11/5/20, JFO

WOOD LDP:
N: 373236.447
E: 182491.064

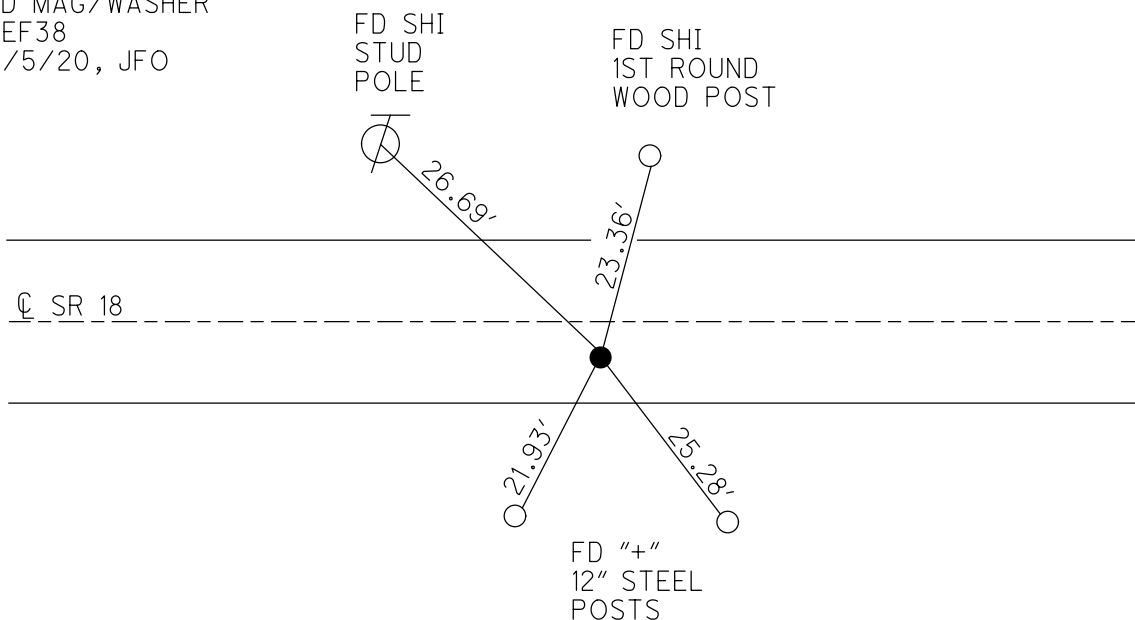

O.D.O.T. DISTRICT 2 SURVEY OFFICE (USE ONLY)

PERSONNEL

REFERENCE NO. 39

SHEET 24 OF 36

NOTES O'DONNELL

DATE 11/5/20

ROUTE SR 18

H.C. AUBLE

WEATHER CLOUDY/WINDY

COUNTY WOOD

R.C. O'DONNELL

TEMP. 50°

TOWNSHIP BLOOM

SECTION 34

DWG BY RHOADES PID 95796

T 3 N R 11 E

TYPE MONUMENT MAG/WASHER

ON SURFACE - ~~BELOW~~ ON

OFFSET 2.8' TO RT EDGE PAVEMENT 7.0' E. OF C S.


STATION: 964+96.70

HORIZ.DATUM: NAD83 (2011)

GEOID: _____


GRID: NORTHING: 551042.296

EASTING: 1673008.857

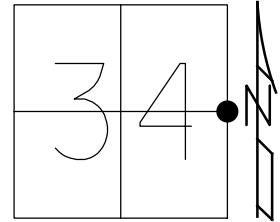

RECORD:
FD P.K.SHANK
6/8/99, MB
SET P.K./WASHER
7/20/99, TR
FD P.K./WASHER
REF39
8/26/14, DCH
SET MAG/WASHER
11/13/14, DCH
FD MAG/WASHER
REF39
11/5/20, JFO

WOOD LDP:
N: 373156.640
E: 185127.513

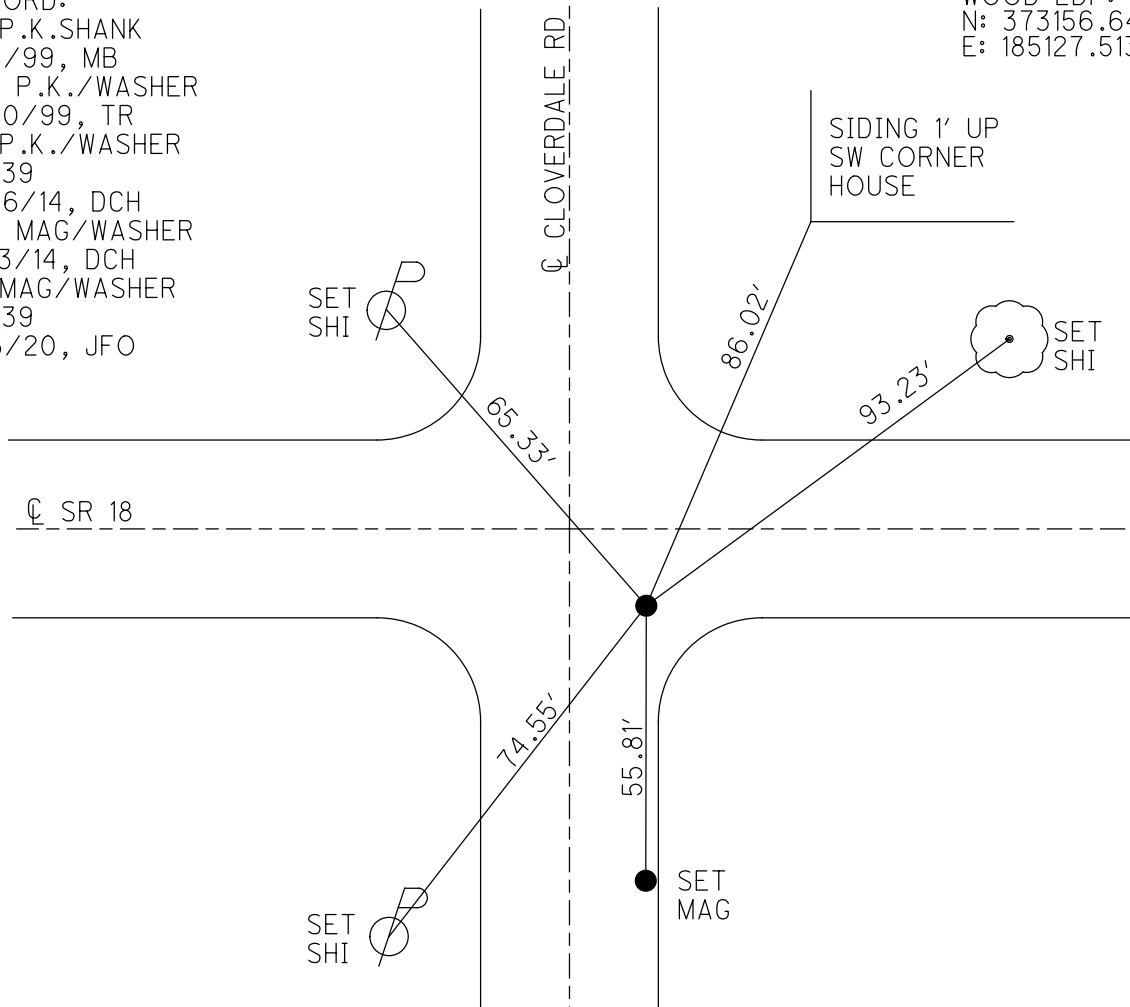

O.D.O.T. DISTRICT 2 SURVEY OFFICE (USE ONLY)

PERSONNEL

REFERENCE NO. 39 A

SHEET 25 OF 36

NOTES ASTON

DATE 8/10/23

ROUTE SR 18

H.C. NIESE

WEATHER CLOUDY

COUNTY WOOD

R.C. AUBLE

TEMP. 74°

TOWNSHIP BLOOM

SECTION 35

DWG BY RHOADES

PID 95796

T 3 N R 11 E

TYPE MONUMENT MAG WASHER

ON SURFACE - ~~BELOW~~ ON

OFFSET Q PAVEMENT 0.9' LT : ~~RT~~
9.8' TO LT EDGE PAVEMENT


STATION: 992+06.60

HORZ.DATUM: NAD83 (2011)

GEOID: NAVD88 2018

GRID: NORTHING: 550678.900

EASTING: 1675643.817

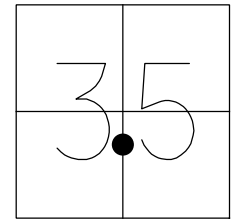


RECORD:

FD P.K./WASHER
6/8/99, MB
SET P.K./WASHER
7/20/99, TR
FD MAG SPIKE
REFA39
8/26/14, DCH
SET MAG/WASHER
3" DOWN
11/5/20, JFO
SET MAG/WASHER
REFA39
8-10-23, TDN

WOOD LDP:

N: 372827.996
E: 187767.260

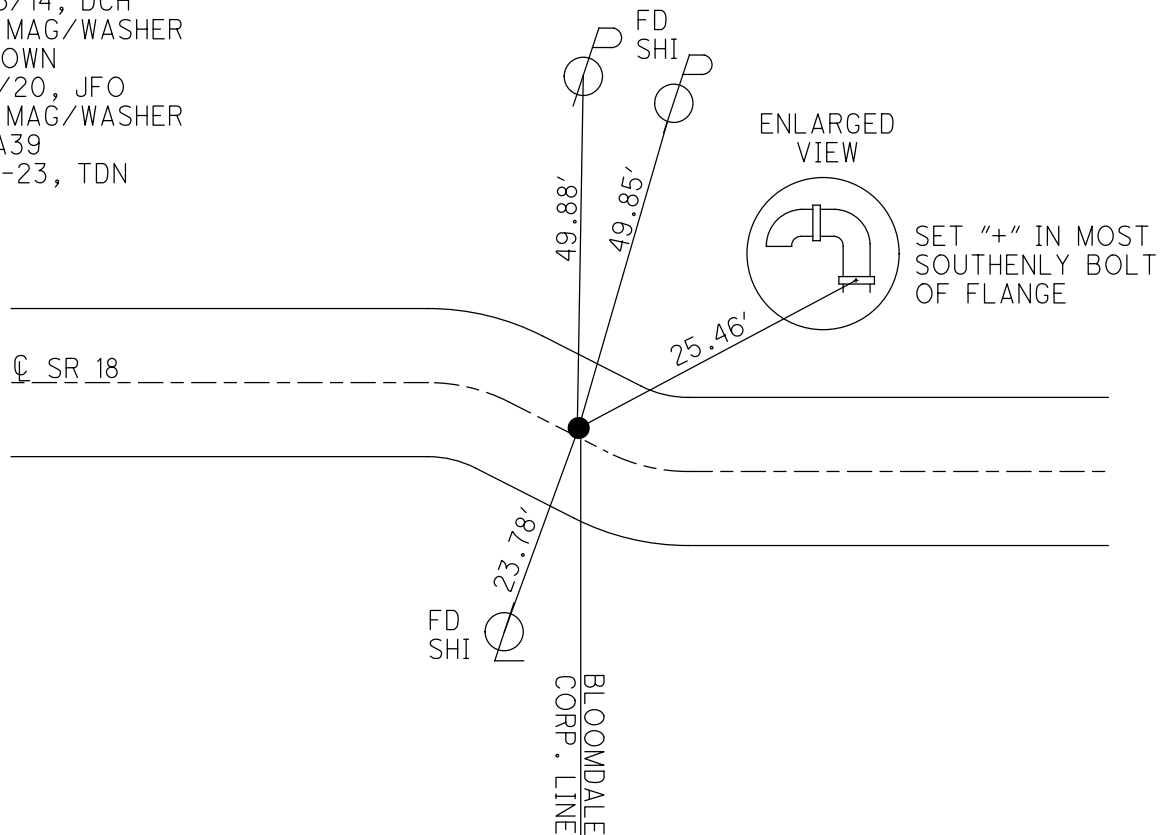

O.D.O.T. DISTRICT 2 SURVEY OFFICE (USE ONLY)

PERSONNEL

REFERENCE NO. 40

SHEET 26 OF 36

NOTES ASTON

DATE 8/10/23

ROUTE SR 18

H.C. NIESE

WEATHER CLOUDY

COUNTY WOOD

R.C. AUBLE

TEMP. 74°

TOWNSHIP BLOOM

SECTION 35

DWG BY RHOADES

PID 95796

T 3 N R 11 E

TYPE MONUMENT MAG/WASHER

ON SURFACE - ~~BELOW~~ ON

OFFSET Q PAVEMENT 0.5' LT : ~~RT~~

- TO - EDGE PAVEMENT


STATION: 1000+17.32

HORIZ.DATUM: NAD83 (2011)

GEOID: NAVD88 2018

GRID: NORTHING: 550456.154


EASTING: 1676404.786

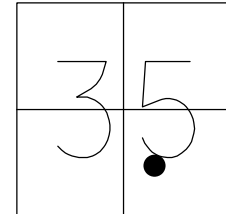

RECORD:

FD P.K./WASHER
6/8/99, MB
SET P.K./WASHER
7/20/99, TR
FD P.K./WASHER
REF40
8/26/14, DCH
FD P.K.SHANK
3" DOWN
4/12/22, TDN
SET MAG/WASHER
8-10-23, TDN

WOOD LDP:
N: 372615.287
E: 188531.165

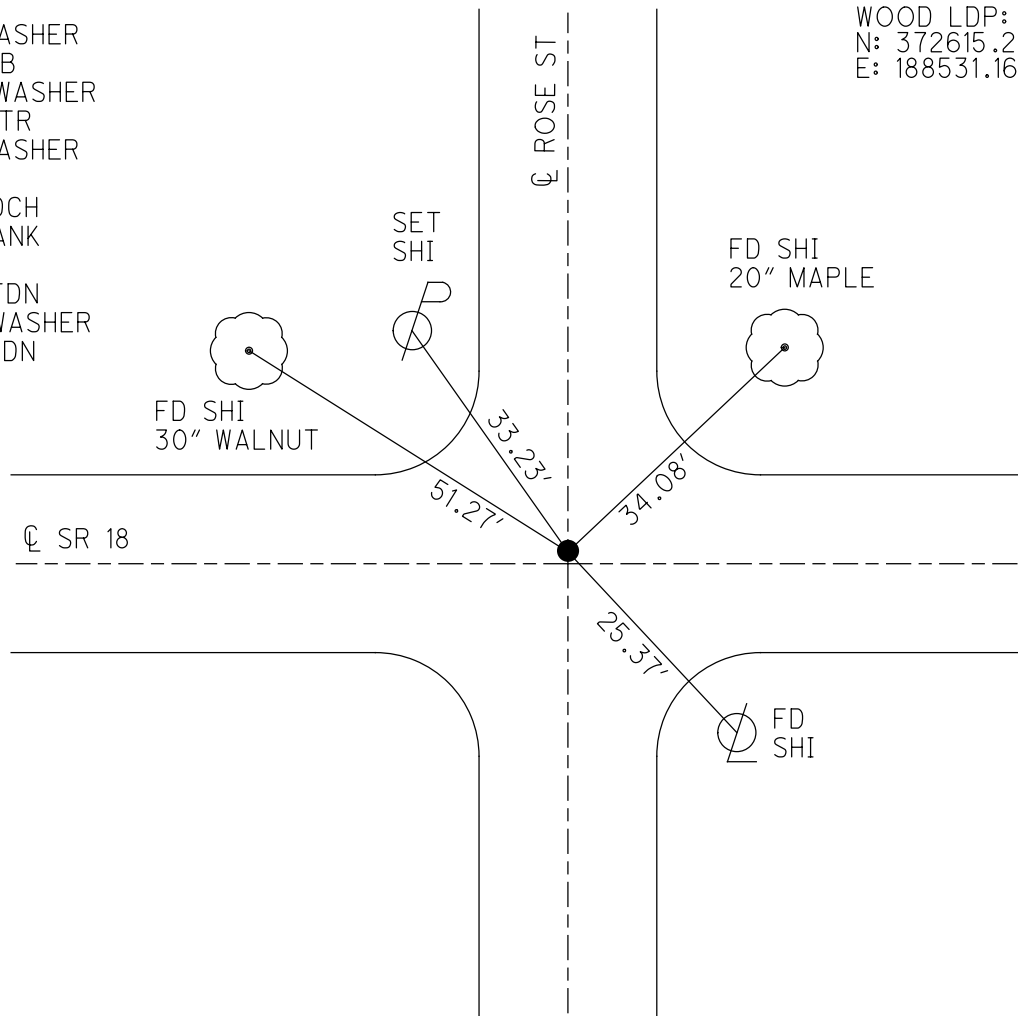

O.D.O.T. DISTRICT 2 SURVEY OFFICE (USE ONLY)

PERSONNEL

REFERENCE NO. 40 A

SHEET 27 OF 36

NOTES ASTON

DATE 8/10/23

ROUTE SR 18

H.C. NIESE

WEATHER CLOUDY

COUNTY WOOD

R.C. AUBLE

TEMP. 74°

TOWNSHIP BLOOM

SECTION 35

DWG BY RHOADES

PID 95796

T 3 N R 11 E

TYPE MONUMENT MAG/WASHER

ON SURFACE - ~~BELOW~~ ON

OFFSET CL PAVEMENT 2' LT : ~~RT~~

- TO - EDGE PAVEMENT 2' W. OF CL N.


STATION: 1003+83.34

HORIZ.DATUM: NAD83 (2011)

GEOID: NAVD88 2018

GRID: NORTHING: 550445.844


EASTING: 1676770.530

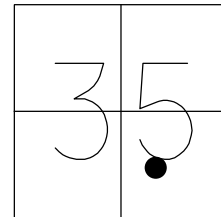

RECORD:

FD P.K./WASHER
6/8/99, MB
SET P.K./WASHER
7/20/99, TR
FD P.K./ WASHER
REFA40
8/26/14, DCH
FD PK/WASHER
REFA40
11/05/20, JFO
4/12/22, TDN
SET MAG/WASHER
8/10/23, TDN

WOOD LDP:
N: 372609.800
E: 188897.044

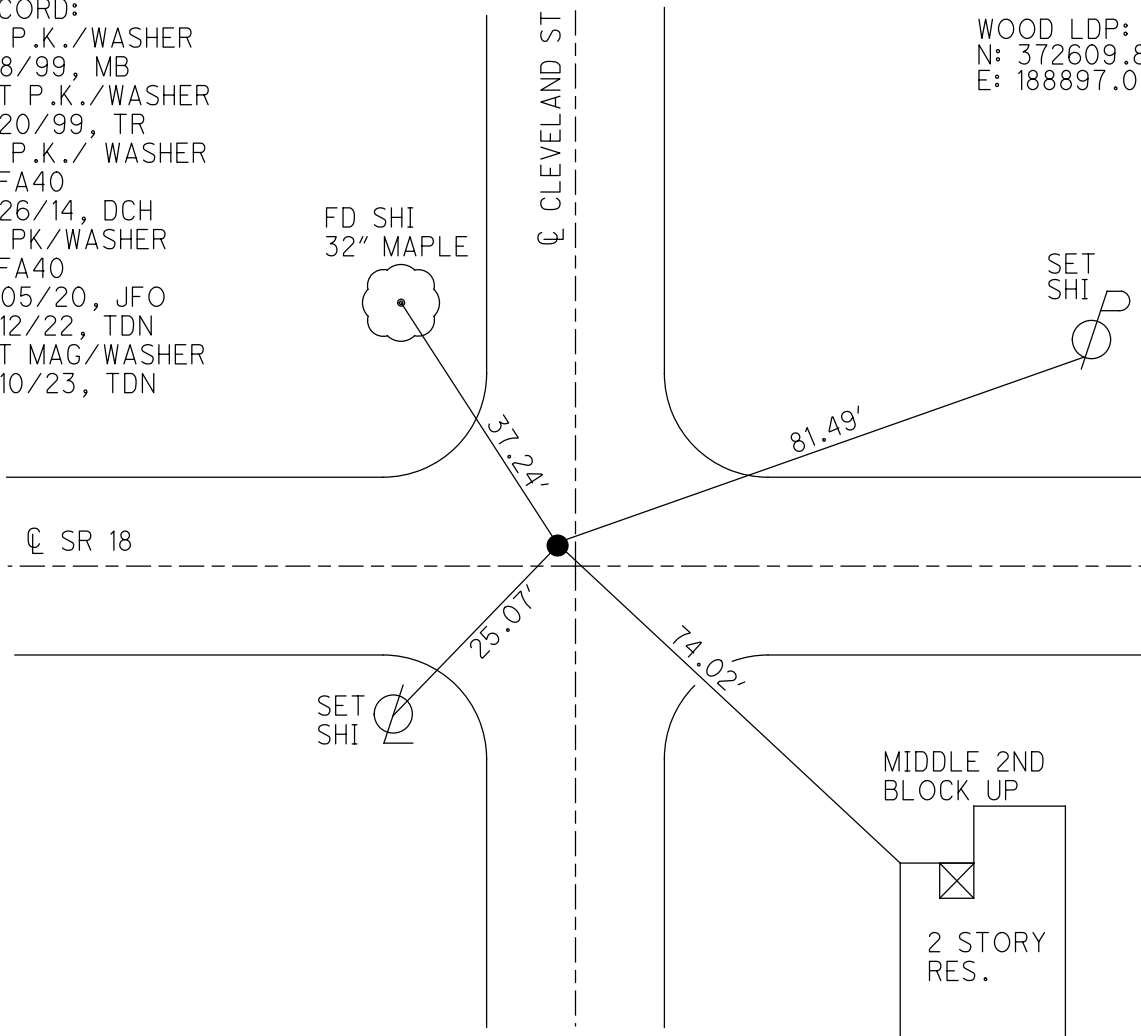

O.D.O.T. DISTRICT 2 SURVEY OFFICE (USE ONLY)

PERSONNEL

REFERENCE NO. 40 B

SHEET 28 OF 36

NOTES ASTON

DATE 8/10/23

ROUTE SR 18

H.C. NIESE

WEATHER CLOUDY

COUNTY WOOD

R.C. AUBLE

TEMP. 74°

TOWNSHIP BLOOM

DWG BY RHOADES

PID 95796

SECTION 35

T 3 N R 11 E

TYPE MONUMENT MAG/WASHER

ON SURFACE - ~~BELOW~~ ON

OFFSET CL PAVEMENT 0.2' LT : ~~RT~~

- TO - EDGE PAVEMENT 2' W. OF CL N.



STATION: 1007+54.45

HORZ.DATUM: NAD83 (2011)

GEOID: NAVD88 2018

GRID: NORTHING: 550435.312

EASTING: 1677141.518

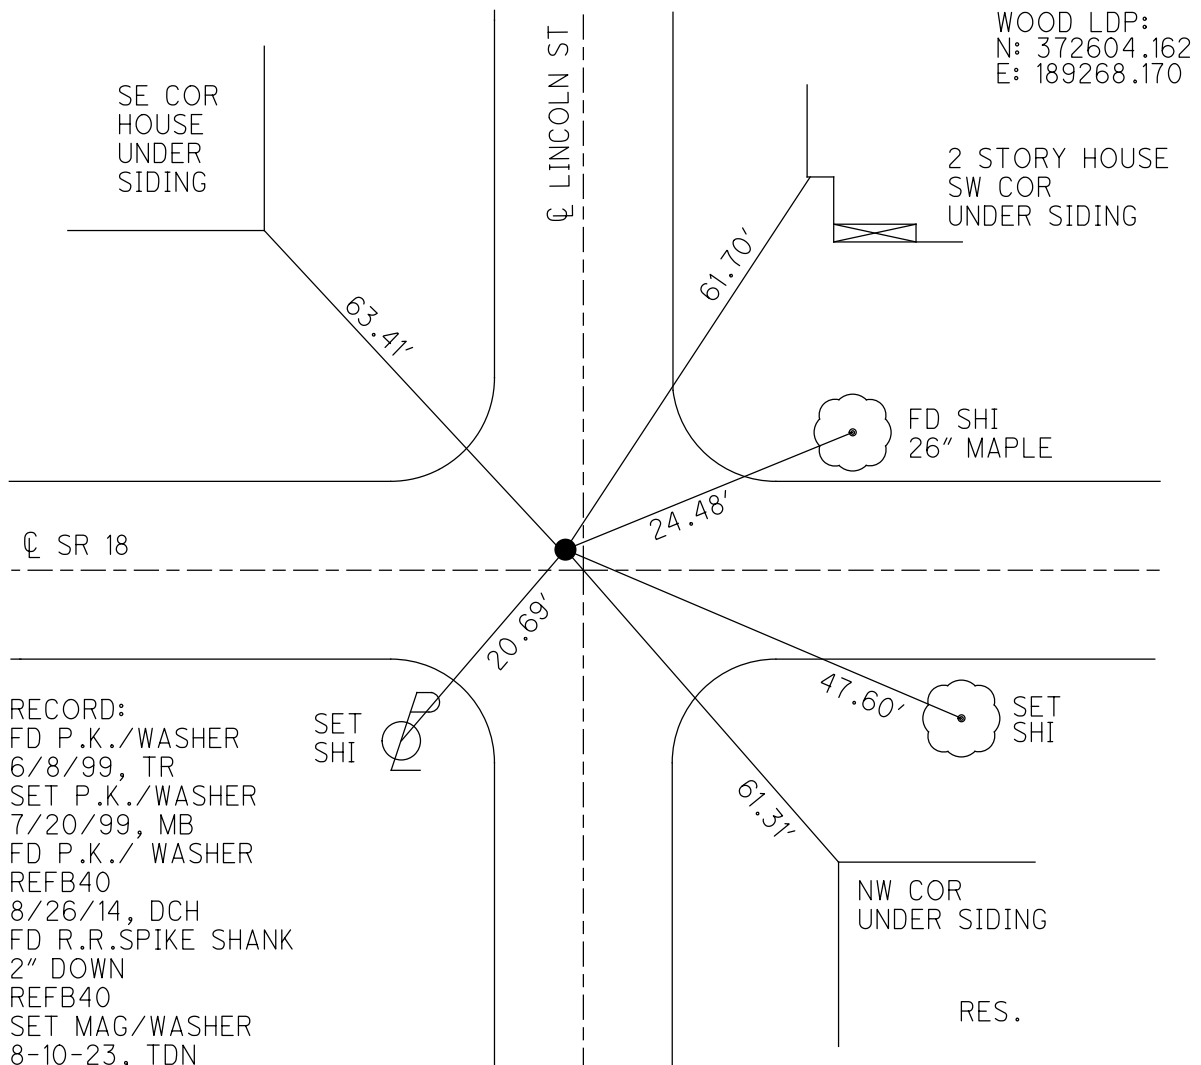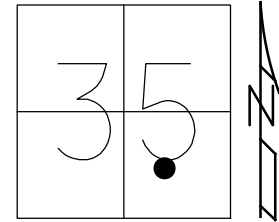

O.D.O.T. DISTRICT 2 SURVEY OFFICE (USE ONLY)

PERSONNEL

REFERENCE NO. 40 C

SHEET 29 OF 36

NOTES ASTON

DATE 8/10/23

ROUTE SR 18

H.C. NIESE

WEATHER CLOUDY

COUNTY WOOD

R.C. AUBLE

TEMP. 74°

TOWNSHIP BLOOM

SECTION 35

DWG BY RHOADES

PID 95796

T 3 N R 11 E

TYPE MONUMENT MAG/WASHER

ON SURFACE - ~~BELOW~~ ON

OFFSET Q PAVEMENT ON LT : ~~RT~~

10.8 TO LT EDGE PAVEMENT


STATION: 1011+24.92

HORIZ.DATUM: NAD83 (2011)

GEOID: NAVD88 2018

GRID: NORTHING: 550424.771

EASTING: 1677511.845

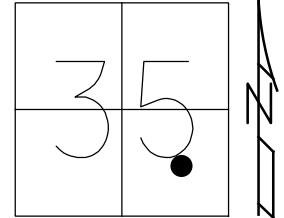

RECORD:

FD P.K./WASHER

6/8/99, TR

SET P.K./WASHER

7/20/99, MB

FD P.K./ WASHER

REFC40

8/26/14, DCH

FD P.K.SHANK

REFC40

11/05/20, JFO

4/12/22, TDN


SET MAG/WASHER

8-10-23, TDN

WOOD LDP:

N: 372598.505

E: 189638.636

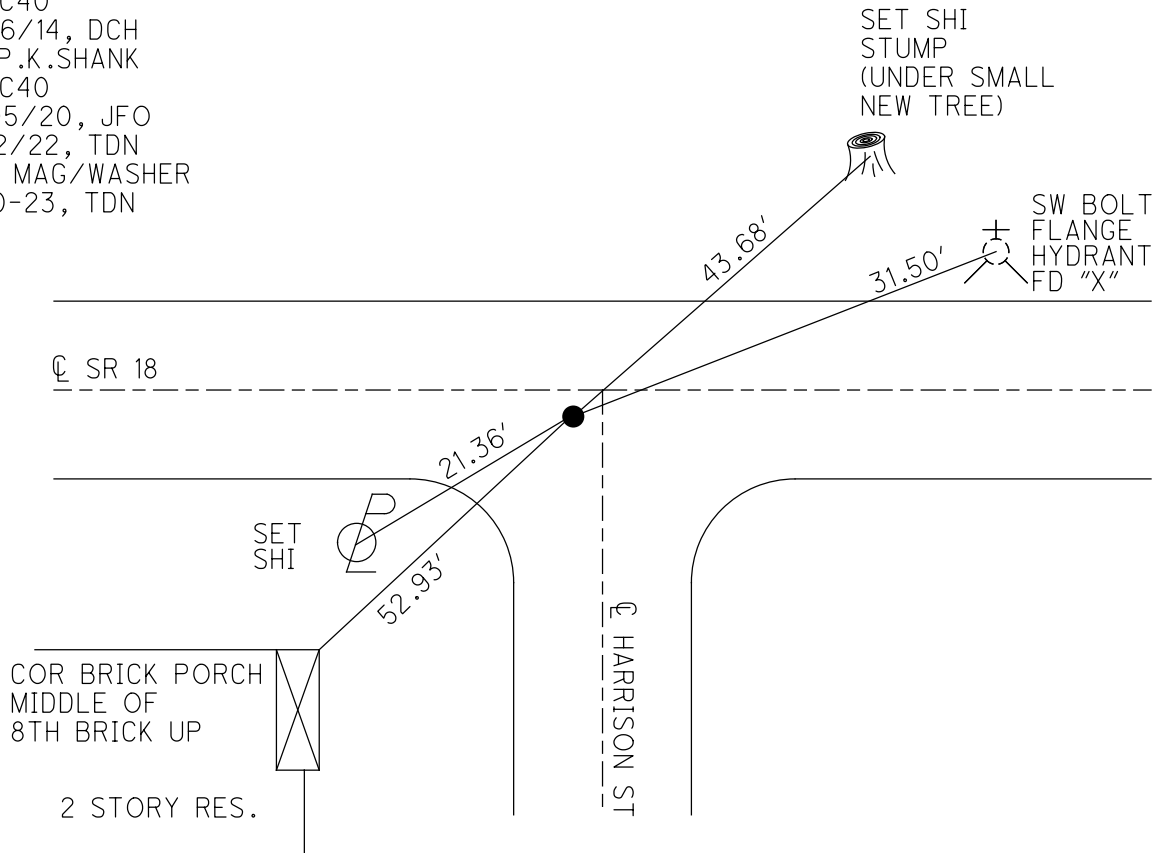

O.D.O.T. DISTRICT 2 SURVEY OFFICE (USE ONLY)

PERSONNEL

REFERENCE NO. 40 D

SHEET 30 OF 36

NOTES ASTON

DATE 8/10/23

ROUTE SR 18

H.C. NIESE

WEATHER CLOUDY

COUNTY WOOD

R.C. AUBLE

TEMP. 74°

TOWNSHIP BLOOM

DWG BY RHOADES

PID 95796

SECTION 35

T 3 N R 11 E

TYPE MONUMENT P.K./WASHER

ON SURFACE - ~~BELOW~~ ON

OFFSET CL PAVEMENT 0.25' ~~LT~~ : RT

- TO - EDGE PAVEMENT



STATION: 1014+96.77

HORZ.DATUM: NAD83 (2011)

GEOID: NAVD88 2018

GRID: NORTHING: 550414.236

EASTING: 1677883.516

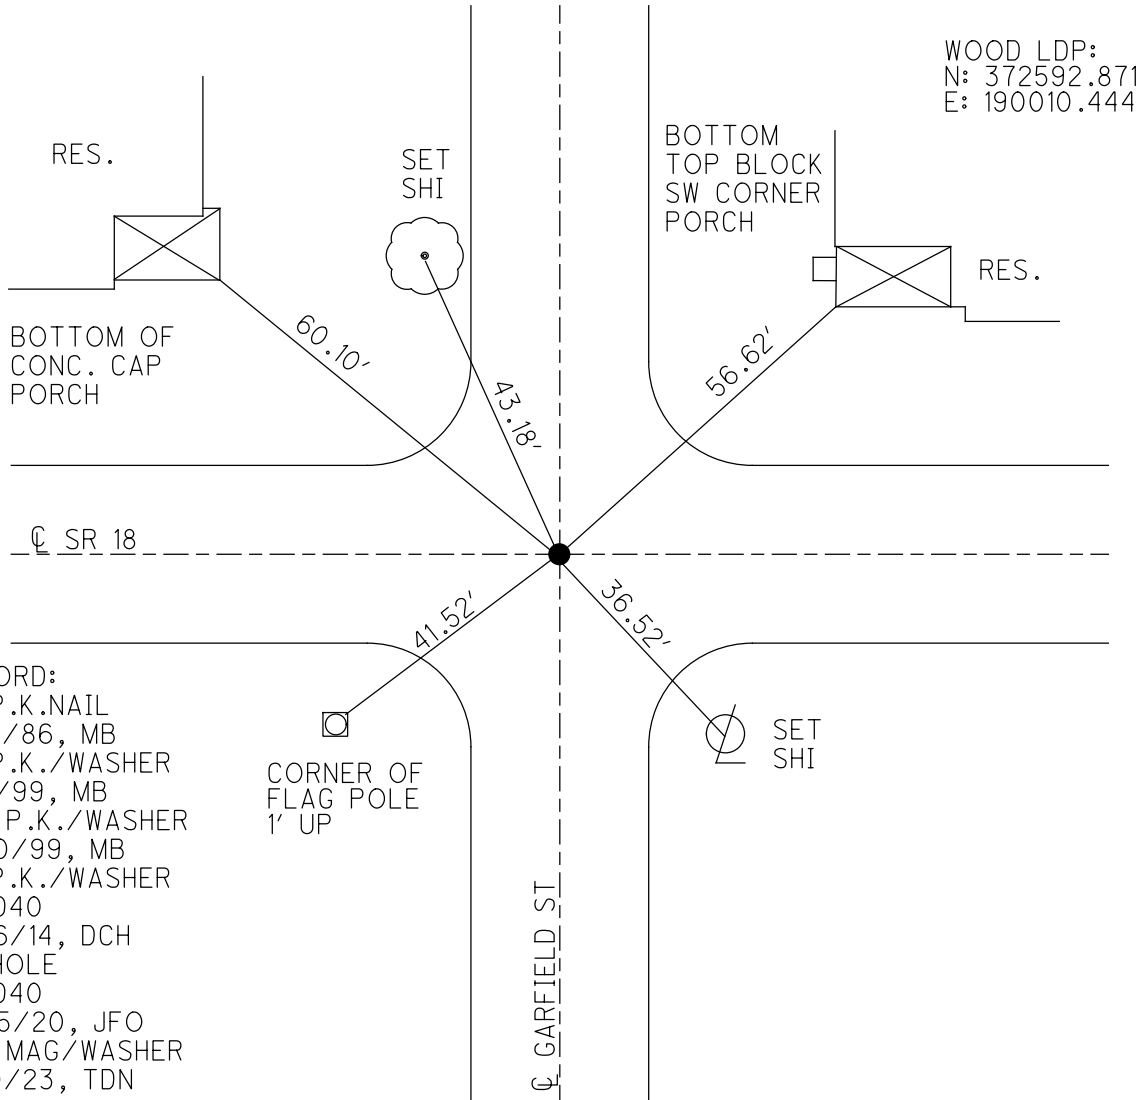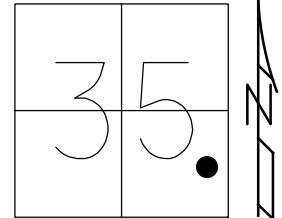

RECORD:
FD P.K.NAIL
5/14/86, MB
FD P.K./WASHER
6/8/99, MB
SET P.K./WASHER
7/20/99, MB
FD P.K./WASHER
REFD40
8/26/14, DCH
FD HOLE
REFD40
11/05/20, JFO
SET MAG/WASHER
8/10/23, TDN

O.D.O.T. DISTRICT 2 SURVEY OFFICE (USE ONLY)

PERSONNEL

REFERENCE NO. 41

SHEET 31 OF 36

NOTES ASTON

DATE 8/10/23

ROUTE SR 18

H.C. NIESE

WEATHER CLOUDY

COUNTY WOOD

R.C. AUBLE

TEMP. 74°

TOWNSHIP BLOOM

DWG BY RHOADES

PID 95796

SECTION 35

T 3 N R 11 E

TYPE MONUMENT MAG/WASHER

ON SURFACE - ~~BELOW~~ ON

OFFSET CL PAVEMENT ON LT : RT

5' TO LT EDGE PAVEMENT


STATION: 1018+73.65

HORZ.DATUM: NAD83 (2011)

GEOID: NAVD88 2018


GRID: NORTHING: 550402.709

EASTING: 1678261.396

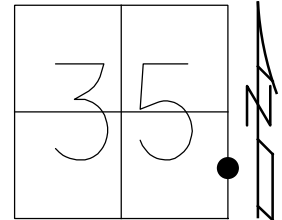

RECORD:
FD SM.R.R.SPIKE
6/8/99, MB
SET P.K./WASHER
7/20/99, MB
FD P.K./WASHER
REF41
8/26/14, DCH
FD MAG NAIL
REF41
11/5/20, JFO
4/12/22, TDN
SET MAG/WASHER
8-10-23, TDN

WOOD LDP:
N: 372586.328
E: 190388.476

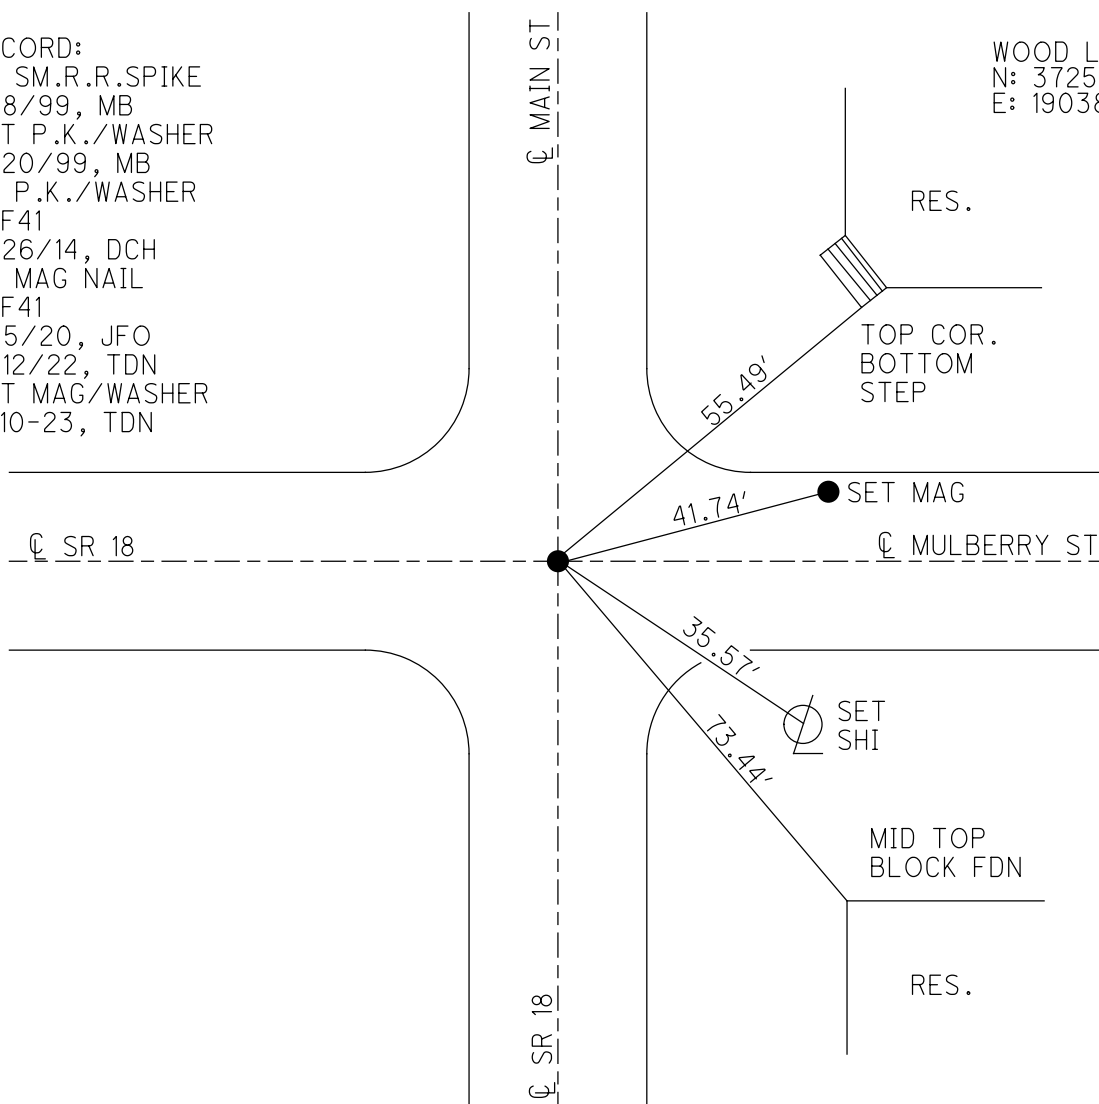

O.D.O.T. DISTRICT 2 SURVEY OFFICE (USE ONLY)

PERSONNEL

REFERENCE NO. 41 A

SHEET 32 OF 36

NOTES ASTON

DATE 8/10/23

ROUTE SR 18

H.C. NIESE

WEATHER CLOUDY

COUNTY WOOD

R.C. AUBLE

TEMP. 74°

TOWNSHIP BLOOM

SECTION 35

DWG BY RHOADES

PID 95796

T 3 N R 11 E

TYPE MONUMENT MAG/WASHER

ON SURFACE - ~~BELOW~~ ON

OFFSET CL PAVEMENT ON LT : RT

- TO - EDGE PAVEMENT



STATION: 1022+41.61

HORIZ.DATUM: NAD83 (2011)

GEOID: NAVD88 2018

GRID: NORTHING: 550036.103

EASTING: 1678251.838

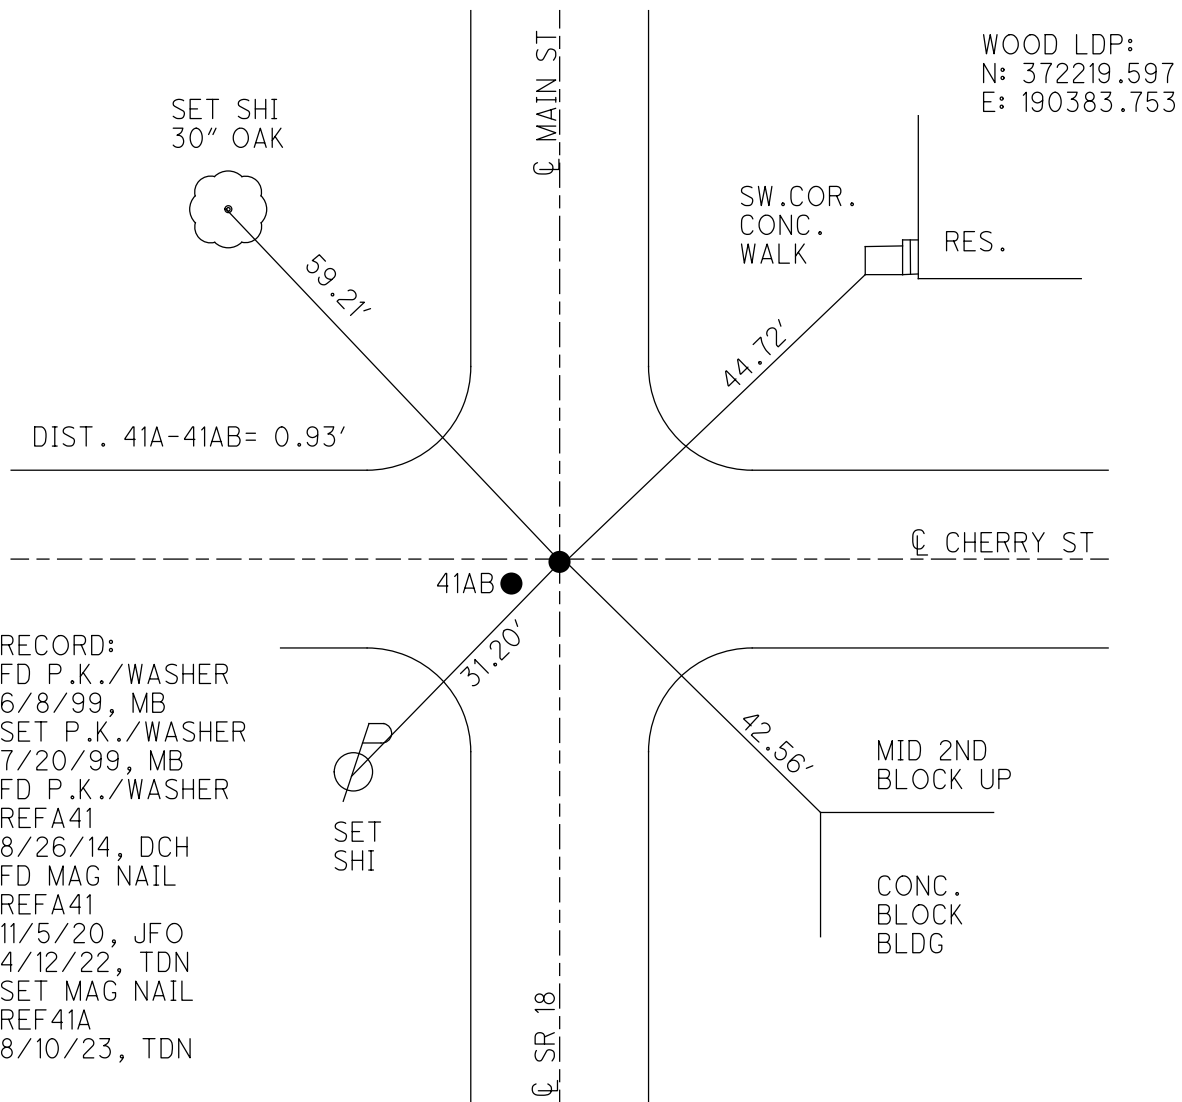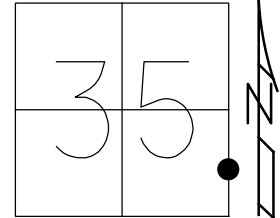

O.D.O.T. DISTRICT 2 SURVEY OFFICE (USE ONLY)

PERSONNEL

REFERENCE NO. 41 AB

SHEET 33 OF 36

NOTES ASTON

DATE 8/10/23

ROUTE SR 18

H.C. NIESE

WEATHER CLOUDY

COUNTY WOOD

R.C. AUBLE

TEMP. 74°

TOWNSHIP BLOOM

SECTION 35

DWG BY RHOADES

PID 95796

T 3 N R 11 E

TYPE MONUMENT MAG/WASHER

ON SURFACE - ~~BELOW~~ ON

OFFSET Q PAVEMENT ON LT : RT

- TO - EDGE PAVEMENT



STATION: 1022+40.68

HORZ.DATUM: NAD83 (2011)

GEOID: NAVD88 2018

GRID: NORTHING: 550035.800

EASTING: 1678251.010

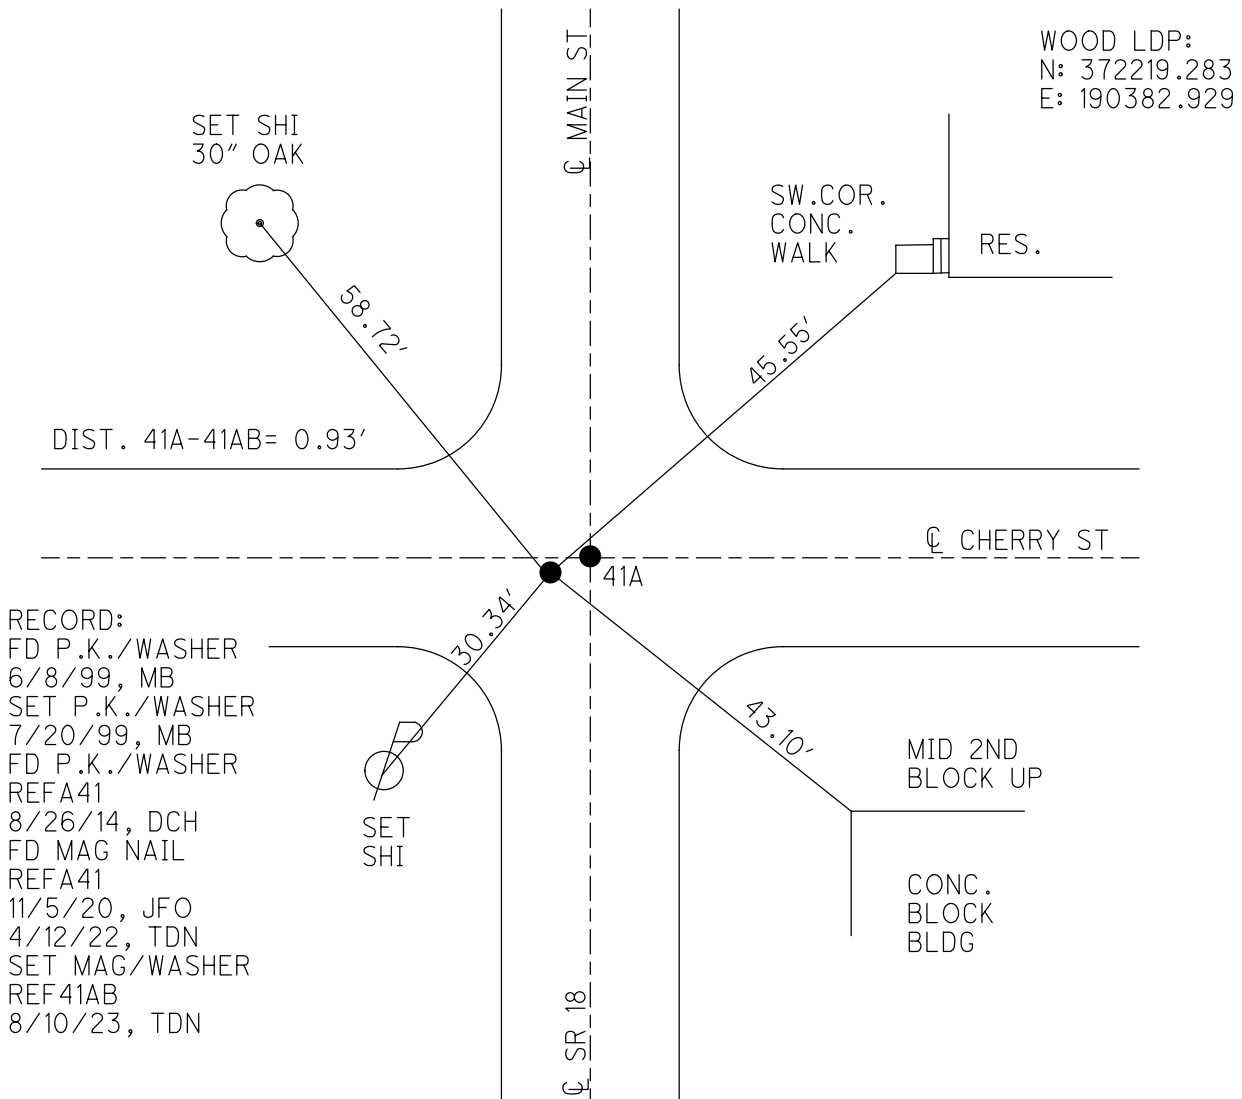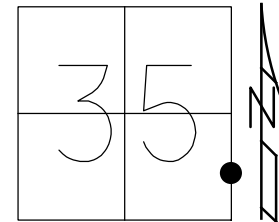

RECORD:
FD P.K./WASHER
6/8/99, MB
SET P.K./WASHER
7/20/99, MB
FD P.K./WASHER
REFA41
8/26/14, DCH
FD MAG NAIL
REFA41
11/5/20, JFO
4/12/22, TDN
SET MAG/WASHER
REF41AB
8/10/23, TDN

O.D.O.T. DISTRICT 2 SURVEY OFFICE (USE ONLY)

PERSONNEL

REFERENCE NO. 41 B

SHEET 34 OF 36

NOTES ASTON

DATE 8/10/23

ROUTE SR 18

H.C. NIESE

WEATHER CLOUDY

COUNTY WOOD

R.C. AUBLE

TEMP. 74°

TOWNSHIP BLOOM

SECTION 35

DWG BY RHOADES PID 95796

T 3 N R 11 E

TYPE MONUMENT MAG/WASHER

ON SURFACE - ~~BELOW~~ ON

OFFSET CL PAVEMENT ON LT : RT

- TO - EDGE PAVEMENT 2' S. OF CL W.


STATION: 1026+09.87

HORZ.DATUM: NAD83 (2011)

GEOID: NAVD88 2018

GRID: NORTHING: 549667.610

EASTING: 1678241.940

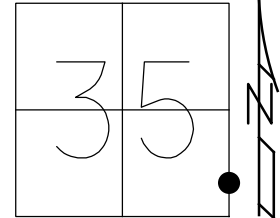

RECORD:

FD SM.R.R.SPIKE

2" DOWN

6/8/99, MB

SET P.K./WASHER

7/20/99, MB

FD P.K./WASHER

REFB41

8/26/14, DCH

D.N.F. P.K./WASHER

11/5/20, JFO

SET MAG/WASHER

REF41B

5-19-23, DSA


SET MAG/WASHER

8-10-23, TDN

WOOD LDP:

N: 371850.975

E: 190378.715

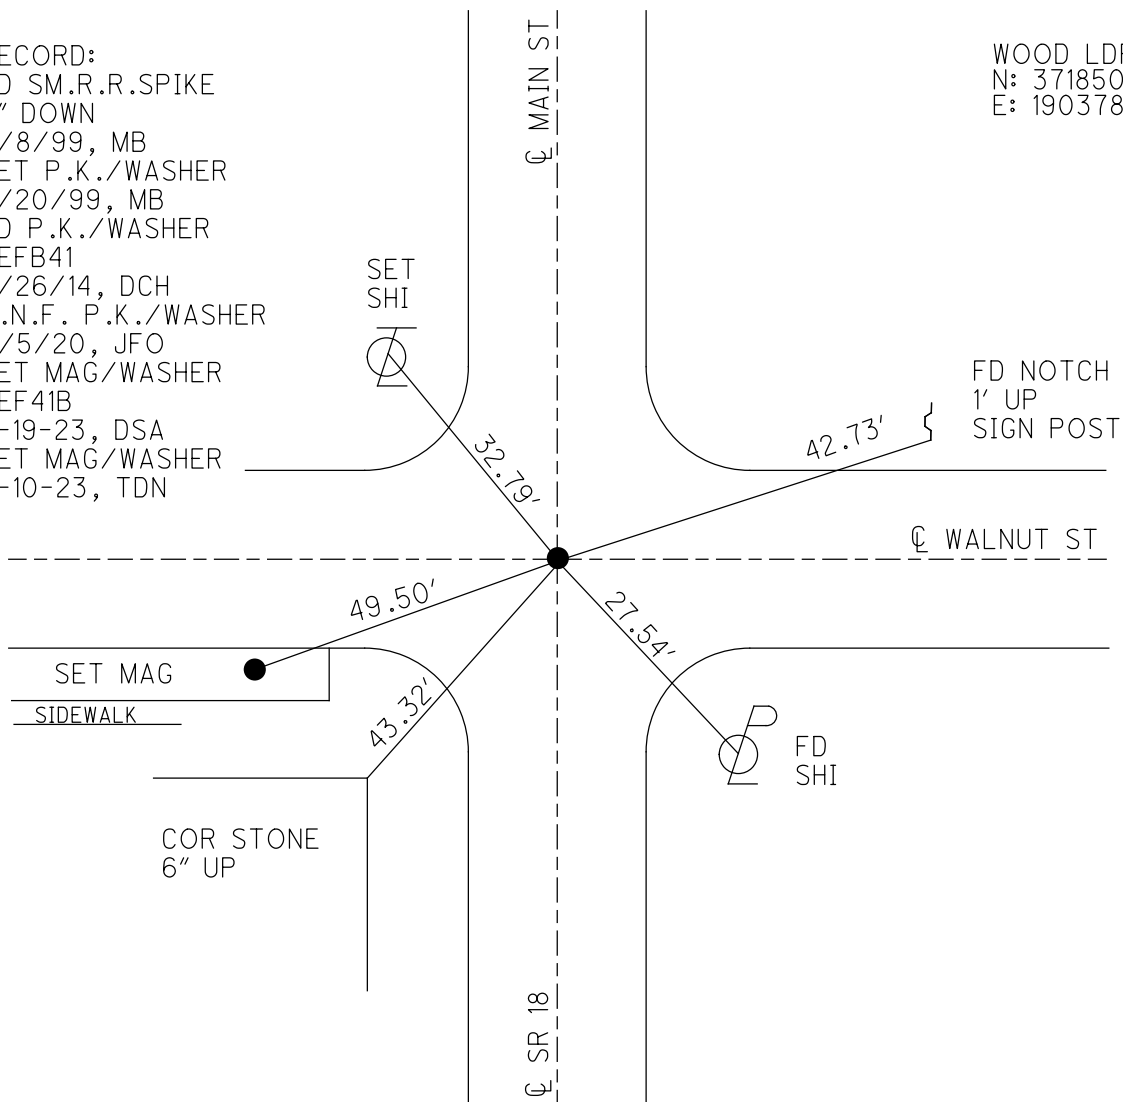

O.D.O.T. DISTRICT 2 SURVEY OFFICE (USE ONLY)

PERSONNEL

REFERENCE NO. 41 C

SHEET 35 OF 36

NOTES ASTON

DATE 8/10/23

ROUTE SR 18

H.C. NIESE

WEATHER CLOUDY

COUNTY WOOD

R.C. AUBLE

TEMP. 74°

TOWNSHIP BLOOM

DWG BY RHOADES

PID 95796

SECTION 35

T 3 N R 11 E

TYPE MONUMENT MAG/WASHER

ON SURFACE - ~~BELOW~~ ON

OFFSET CL PAVEMENT ON LT : RT

- TO - EDGE PAVEMENT


STATION: 1029+77.04

HORZ.DATUM: NAD83 (2011)

GEOID: NAVD88 2018


GRID: NORTHING: 549300.608

EASTING: 1678232.446

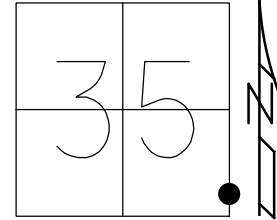

RECORD:
FD P.K./WASHER
6/8/99, MB
SET P.K./WASHER
7/20/99, MB
FD R.R.SPIKE
3" DOWN
REFC41
8/26/14, DCH
FD LG.R.R.SPIKE
2" DOWN
REFC41
11/5/20, JFO
4/12/22, TDN
SET MAG/WASHER
8/10/23, TDN

WOOD LDP:
N: 371483.848
E: 190374.061

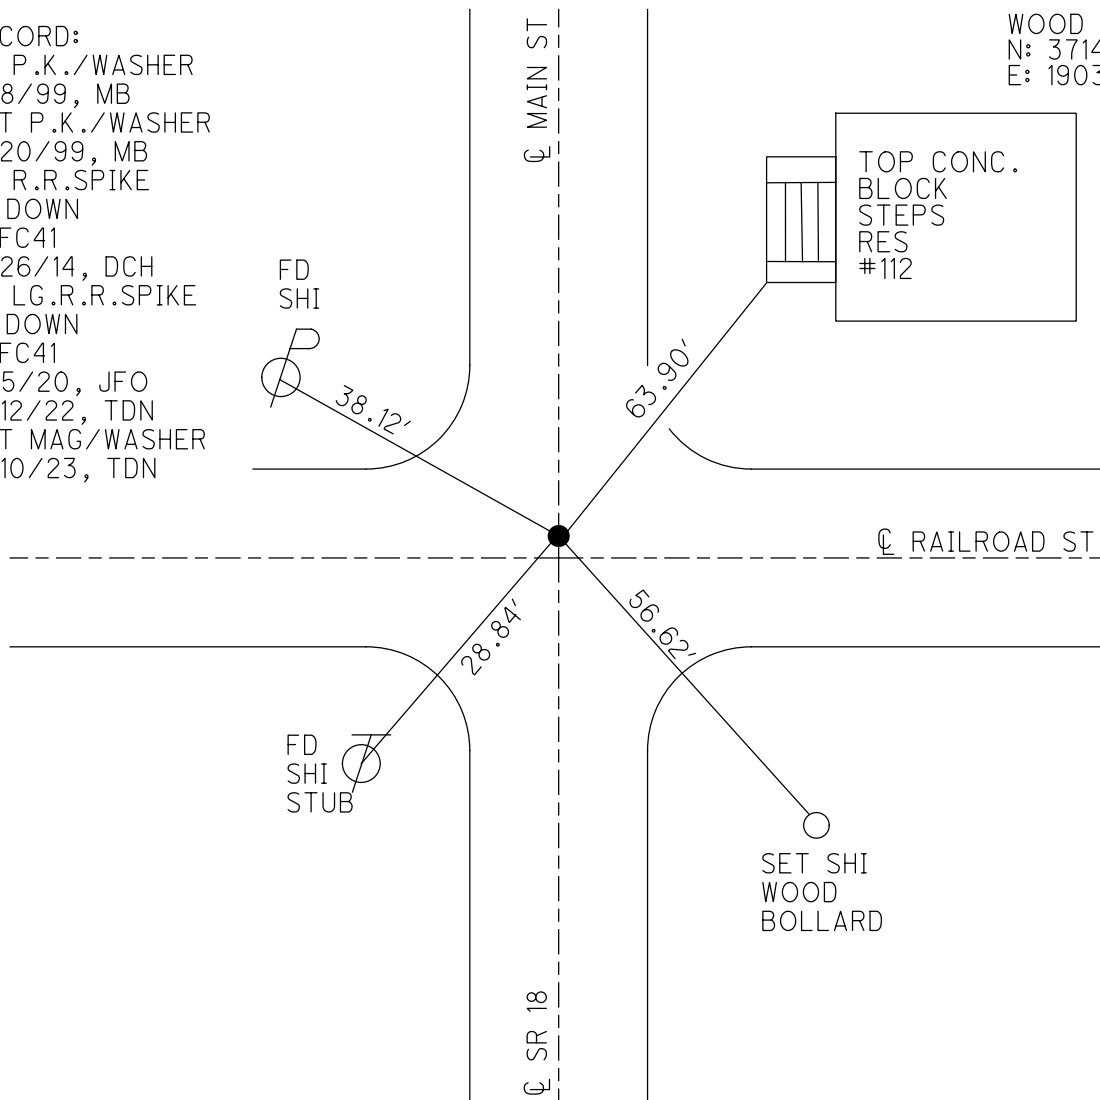

O.D.O.T. DISTRICT 2 SURVEY OFFICE (USE ONLY)

PERSONNEL

REFERENCE NO. 42

SHEET 36 OF 36

NOTES ASTON

DATE 8/10/23

ROUTE SR 18

H.C. NIESE

WEATHER CLOUDY

COUNTY WOOD

R.C. AUBLE

TEMP. 74°

TOWNSHIP BLOOM

SECTION 35

DWG BY RHOADES

PID 95796

T 3 N R 11 E

TYPE MONUMENT MAG/WASHER

ON SURFACE - ~~BELOW~~ ON

OFFSET CL PAVEMENT 5.6' LT : ~~RT~~

5' TO LT EDGE PAVEMENT 2' N. OF CL W.


STATION: 1040+67.27

HORZ.DATUM: NAD83 (2011)

GEOID: NAVD88 2018

GRID: NORTHING: 548210.708

EASTING: 1678205.075

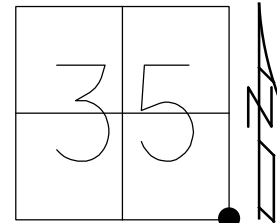

RECORD:
FD SM.R.R.SPIKE
6/8/99, MB
SET P.K./WASHER
7/20/99, MB
FD R.R.SPIKE
2" DOWN
REF42
8/26/14, DCH
FD LG.R.R.SPIKE
1 1/2" DOWN
REF42
11/5/20, JFO
4/12/22, TDN
SET MAG/WASHER
8/10/23, TDN

FD SHI
18" PINE

56.60'

19.47'

SET
SHI

CL CASS RD

51.92'

SET MAG
BERM

37.59'

SET
MAG

CO. LINE
HANCOCK/WOOD

WOOD LDP:
N: 370393.589
E: 190361.065

CL MAIN ST

CL SR 18