

O.D.O.T. DISTRICT 2 SURVEY OFFICE (USE ONLY)

PERSONNEL

REFERENCE NO. 2

SHEET 2 OF 15

NOTES RHOADES

DATE 6-12-20

ROUTE SR 18

H.C. AUBLE

WEATHER SUNNY

COUNTY WOOD

R.C. MAHLER

TEMP. 66°F

TOWNSHIP JACKSON

O'DONNELL

SECTION 19

DWG BY MAHLER

PID PAVE TRAIN

T 3 N R 9 E

TYPE MONUMENT MAG/WASHER

ON SURFACE - ~~BELOW~~ ON

OFFSET CL PAVEMENT 4.3' LT : RT

5.4' TO RT EDGE PAVEMENT


STATION: 28+00

HORIZ.DATUM: NAD83 (2011)


GEOID: NAVD88-2012A

GRID: NORTHING: 563182.308

EASTING: 1591109.130

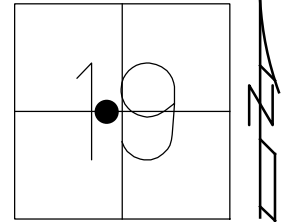

RECORD:
SET MAG/WASHER
7-25-05, DCH
FD MAG NAIL
REF2
9-2-15, DCH
FD MAG/WASHER
REF2
6-12-20
9-16-21, JFO

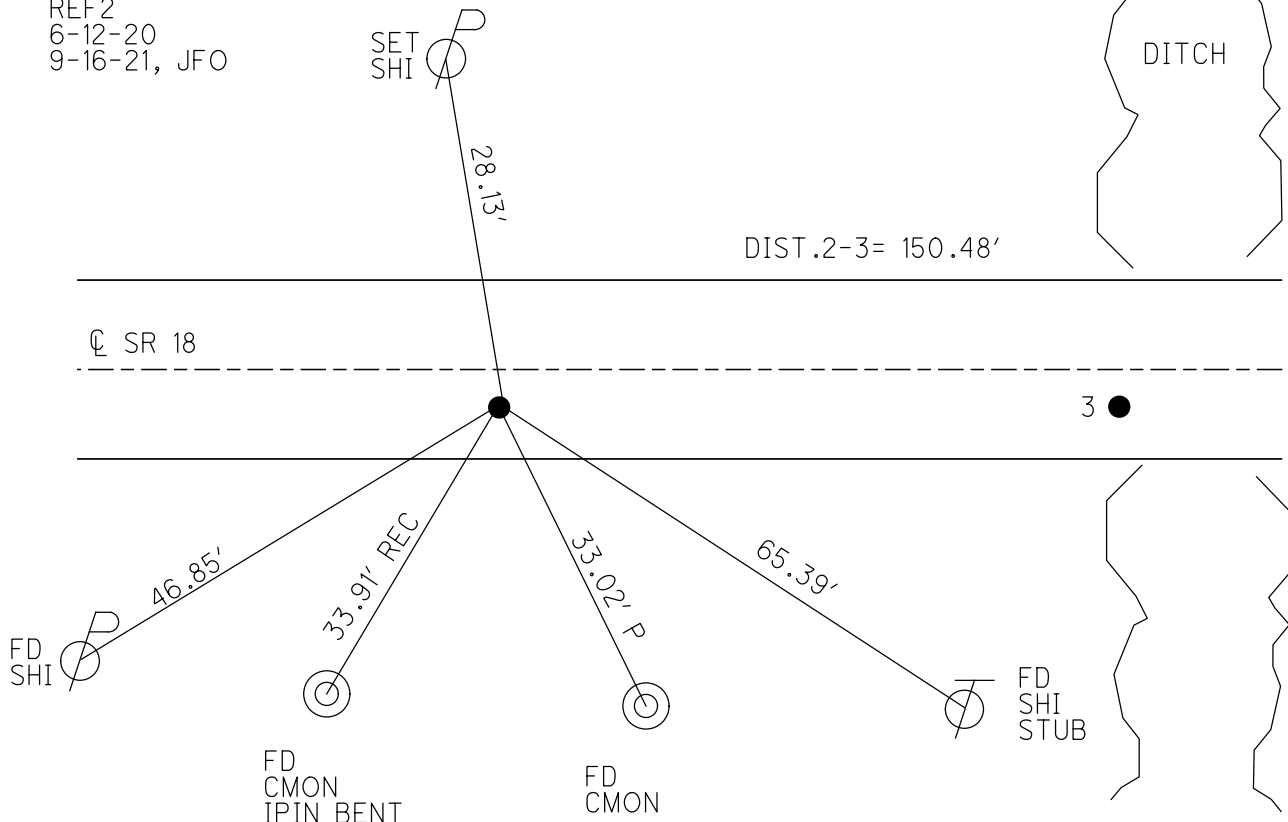

O.D.O.T. DISTRICT 2 SURVEY OFFICE (USE ONLY)

PERSONNEL

REFERENCE NO. 2

SHEET 2 OF 13

NOTES RHOADES

DATE 6-12-20

ROUTE SR 18

H.C. AUBLE

WEATHER SUNNY

COUNTY WOOD

R.C. MAHLER

TEMP. 66°F

TOWNSHIP JACKSON

O'DONNELL

SECTION 19

DWG BY MAHLER PID PAVE TRAIN

T 3 N R 9 E

TYPE MONUMENT MAG/WASHER

ON SURFACE - ~~BELOW~~ ON

OFFSET CL PAVEMENT 4.3' ~~LT~~ : RT

5.4' TO RT EDGE PAVEMENT


STATION: 28+00

HORIZ.DATUM: NAD83 (2011)

GEOID: NAVD88-2012A


GRID: NORTHING: 563182.308

EASTING: 1591109.130

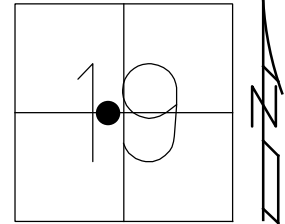

RECORD:
SET MAG/WASHER
7-25-05, DCH
FD MAGNAIL
REF2
9-2-15, DCH
FD MAG/WASHER
REF2
6-12-20, JFO


DIST.2-3= 150.48'

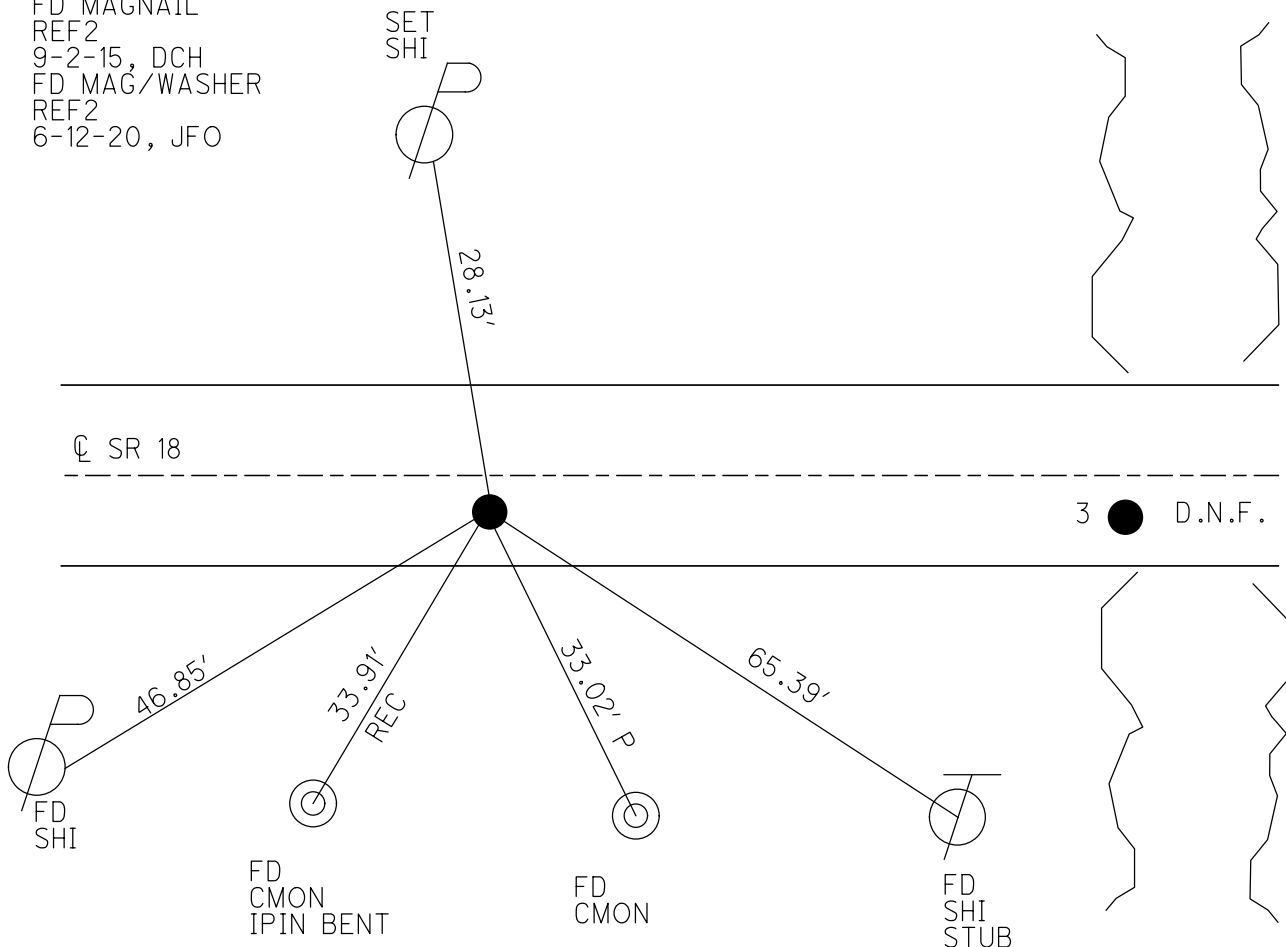

O.D.O.T. DISTRICT 2 SURVEY OFFICE (USE ONLY)

PERSONNEL _____ REFERENCE NO. 2 SHEET 2 OF 13
 NOTES _____ DATE 4-6-05 ROUTE SR 18
 H.C. HUSS WEATHER SUNNY COUNTY WOOD
 R.C. HOMAN TEMP. 67°F TOWNSHIP JACKSON
 _____ SECTION 19
 _____ T 3 N R 9 E

TYPE MONUMENT _____ PK/WASHER _____
 ON SURFACE - ~~BELOW~~ ON _____
~~LEFT~~ = CL PAV'T - RIGHT 4.3'
5.4' TO RT EDGE PAVEMENT
 S.L.M. 28+00

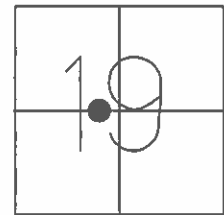


GRID: NORTHING: 563182.33 EASTING: 1591109.13

RECORD:
 SET MAG/WASHER
 7-25-05, DCH

NOTE: DIS. REF2 TO REF3 = 150.48'

FD MAG
 GPS, REF2
 9-2-15, DCH, JLL

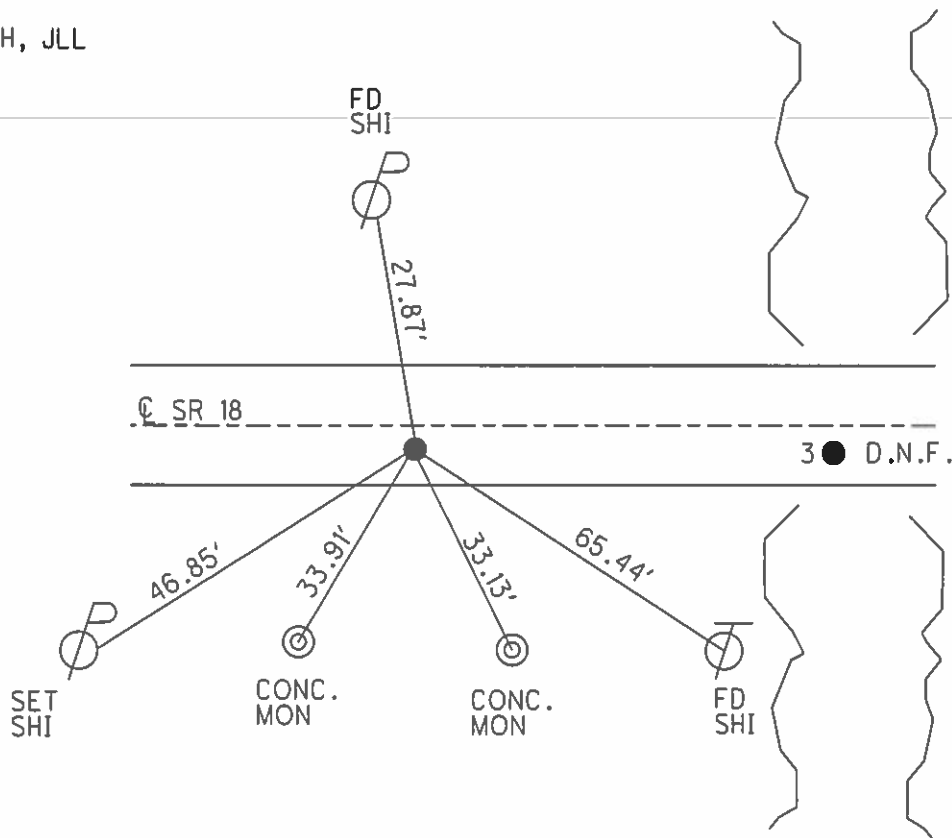

O.D.O.T. DISTRICT 2 SURVEY OFFICE

PERSONNEL

REFERENCE NO. 2A #3

SHEET 2 OF 14

NOTES STEVE

DATE 4-6-05

ROUTE S.R. 18

H.C. DUANE

WEATHER SUNNY

COUNTY WOOD

R.C. JOE

TEMP. 67°

TOWNSHIP JACKSON

SECTION 19

T 3 N R 9 E


TYPE MONUMENT PK NAIL AND WASHER

ON SURFACE - ~~BELOW~~ ON

~~LEFT - C PAVT~~ - RIGHT 4.3' RT


5.4' TO RT EDGE PAVEMENT

S.L.M. A=28+00 ; B=29+50

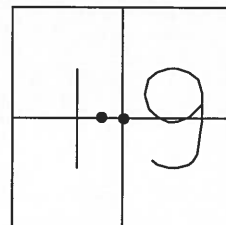

PT A
SET MAG AND WASHER
7-25-05 DCH

PT B
DID NOT FIND CONTROL POINT
NEW CULVERT AT THIS LOCATION

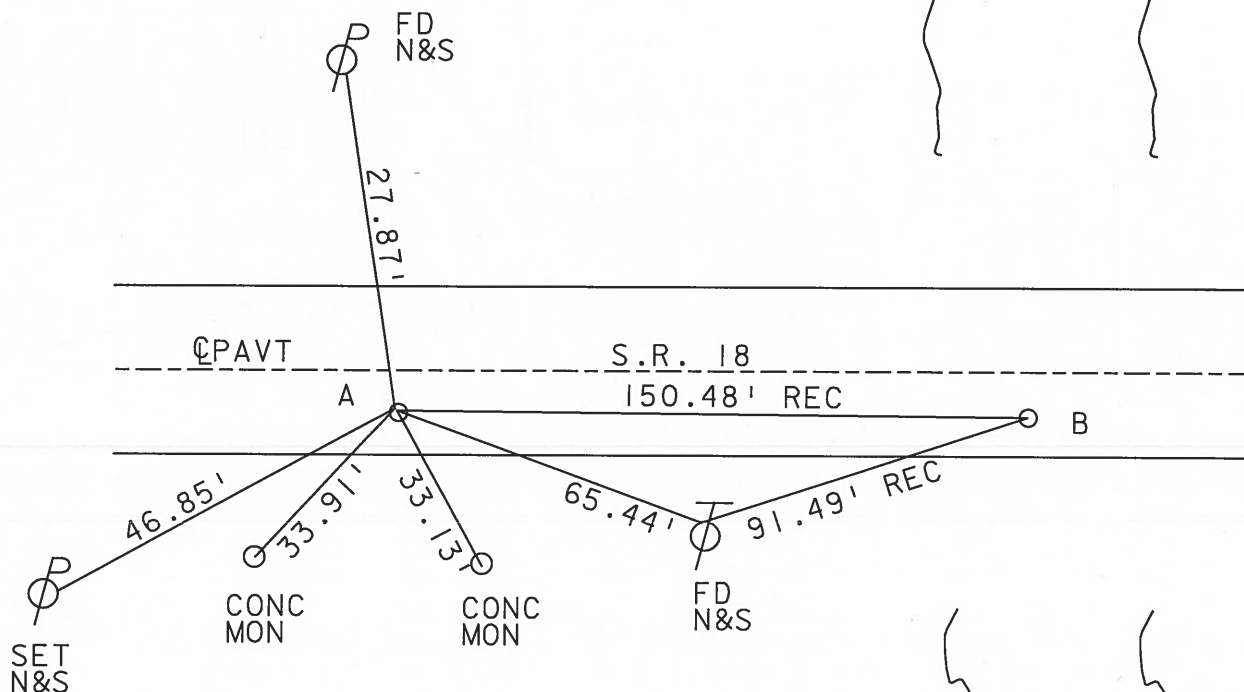

O.D.O.T. DISTRICT 2 SURVEY OFFICE

PERSONNEL

REFERENCE NO. 2-A & 3

SHEET OF

NOTES BARNHISEL

H.C. Loehrke

R.C. HOFFMAN

DATE 3-19-91

WEATHER cloudy - windy

TEMP. +40°

ROUTE 18

COUNTY WOOD

TOWNSHIP JACKSON

SECTION 19

T 3 N R 9 E


TYPE MONUMENT 2-A & 3 P.K. & Washers

ON SURFACE - BELOW YES YES


LEFT - CL PAV'T. - RIGHT 5.4 - 6.0

TO RT EDGE PAVEMENT

S.L.M. 28+00 & 29+50

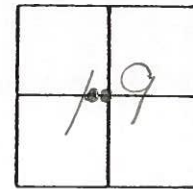

Set P.K. & Washer
4-11-91
MB

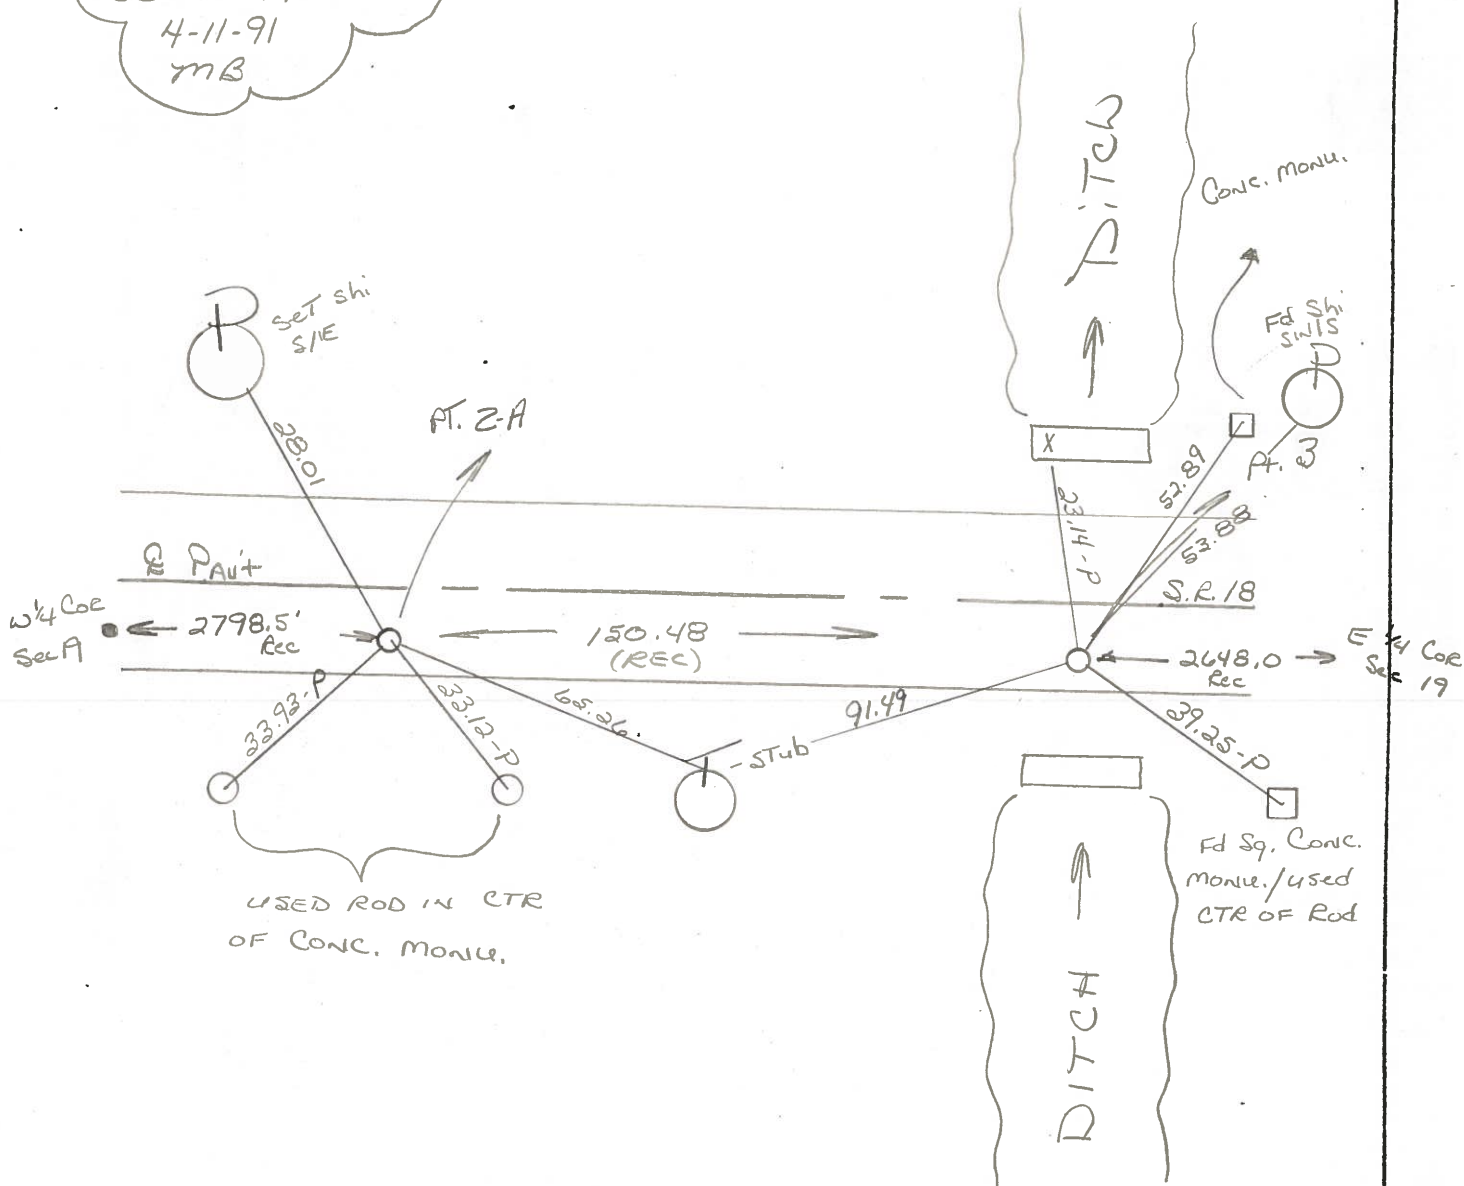

O.D.O.T. DISTRICT 2 SURVEY OFFICE

SHEET 2A-3 OF

County WOOD S.R. 18

Date 11-25-83

Township JACKSON

Weather CLEAR, WINDY

Section 19


Temp. +32°

T3N, R9E

Personnel BARNHISEL HC

HOUSEHOLDER RC

LOEHRE

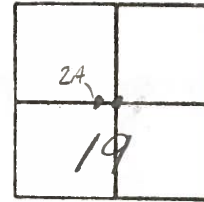

2A - Fd SMALL RR SPIKE @ SURFACE
5.2 Rt of Q
3.5 Lf of SEP


SLM 27+90

#3 Fd SMALL RR SPIKE
5.9 Rt of Q
3.4 Lf of SEP

SLM 29+41

SET PK+WASHER
7-24-85
C.L.



SET PK+WASHER
7-24-85
C.L.

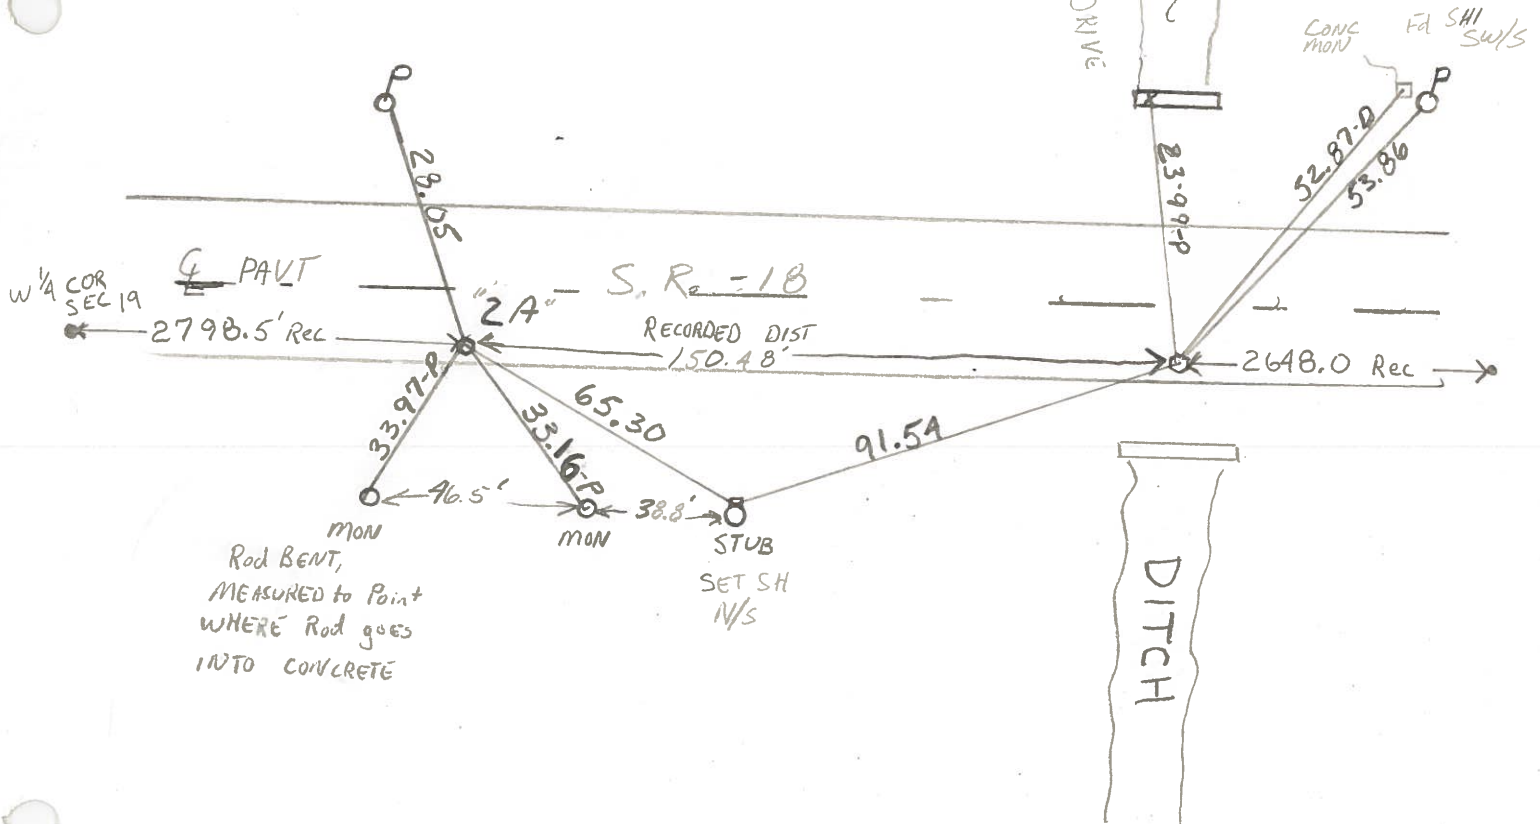

County WOOD S.R. US 18Township JACKSONSection 19

T3N, R9E

Personnel	PARRINCEL	HC
	HOUSEHOLDER	RC
	LOEHKE	□

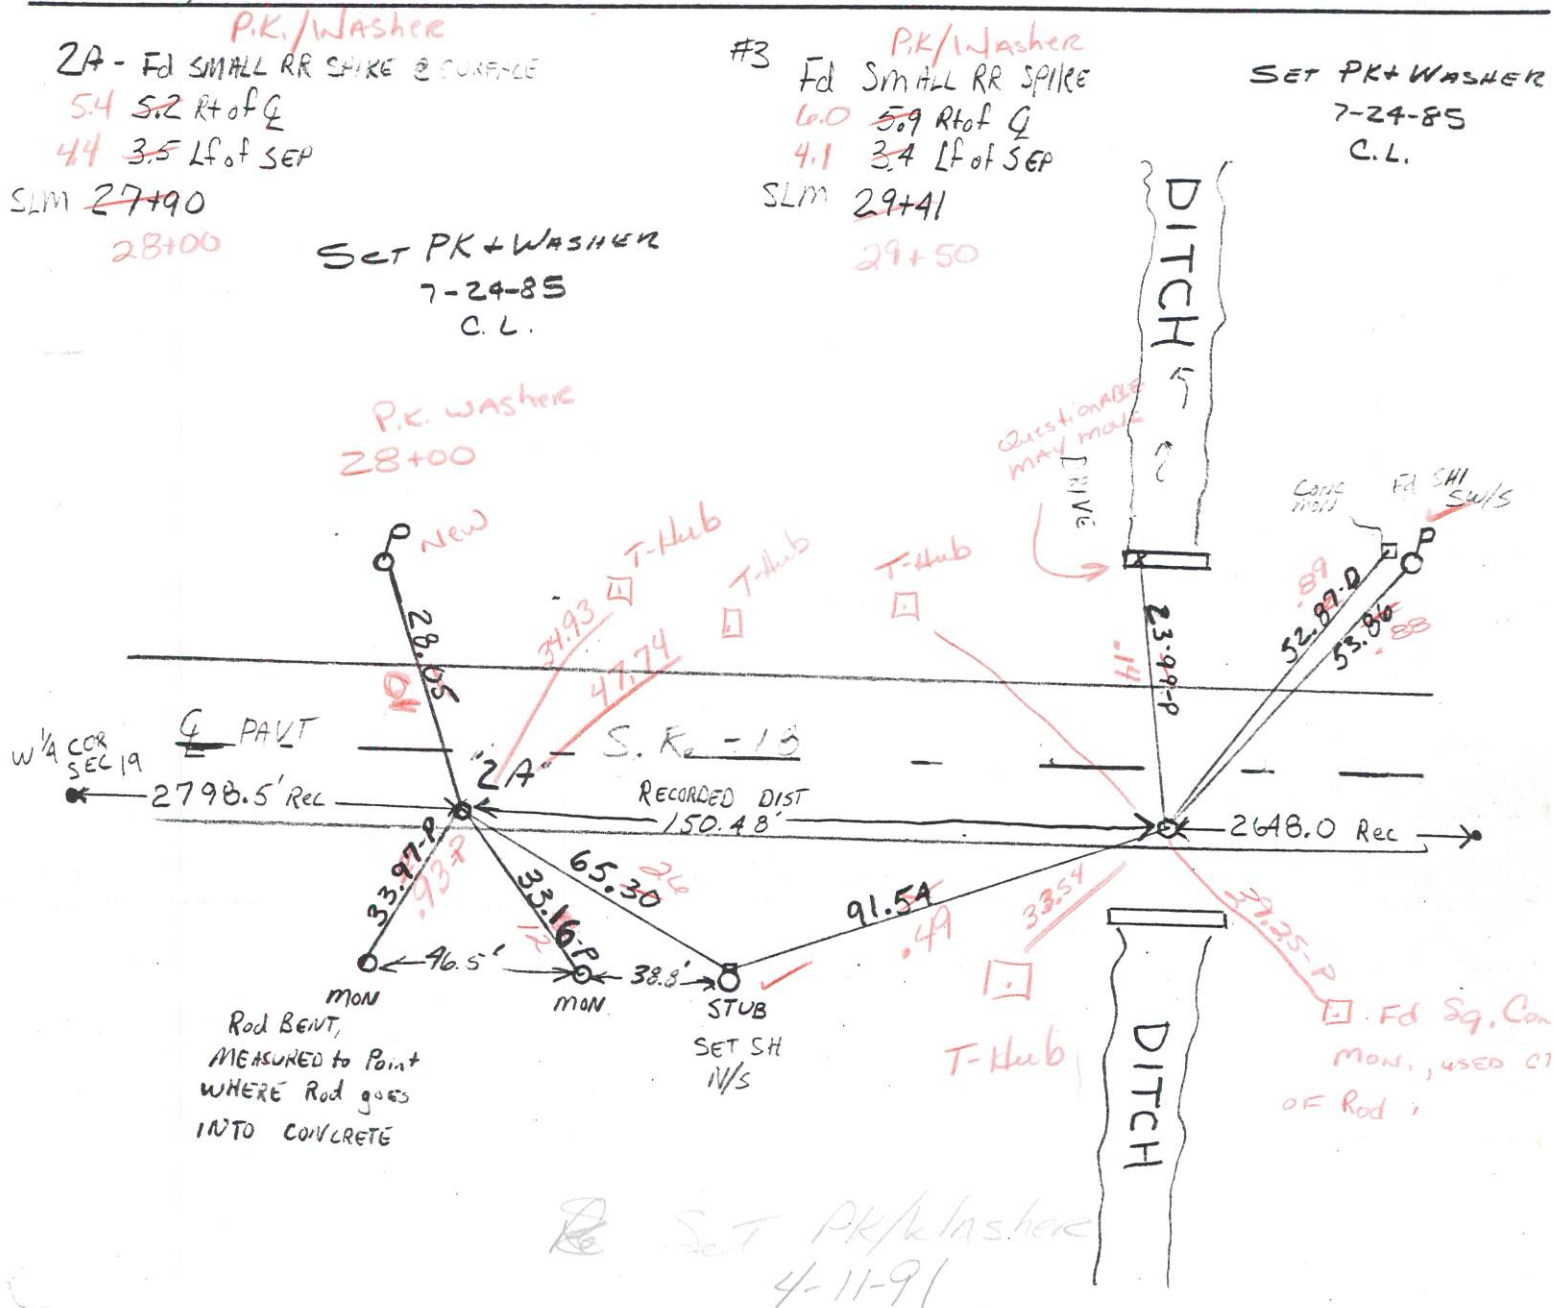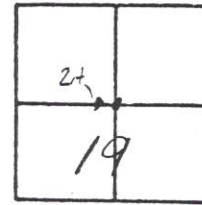Date 11-25-93Weather CLEAR, WINDYTemp. +32°

Q.D.O.T. DISTRICT 2 SURVEY OFFICE

Sht. 2A-3 of

County WOOD - U.S. 18

Date 5-30-74

Township JACKSON

Weather CLEAR

Section 19

Temp. 80°


T3N, R9E

Personnel BURNSIDE

SMITH

BOWERS


MEAD

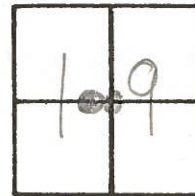

#2-A -
FD. STONE 1.25 DEEP
AND 5' S. OF CENTER
PAUT. (S.R. 18) FROM SURVEY
BY W. H. WOOD 1903
SET P.K. NAIL AND
BROKEN TILE OVER STONE

INTERIOR 1/4 COR. SEC. 19
SET P.K. NAIL ON LINE
E-W.


{ STONE BELIEVED TO
HAVE BEEN DESTROYED
DUE TO X-OVER LOCATION }

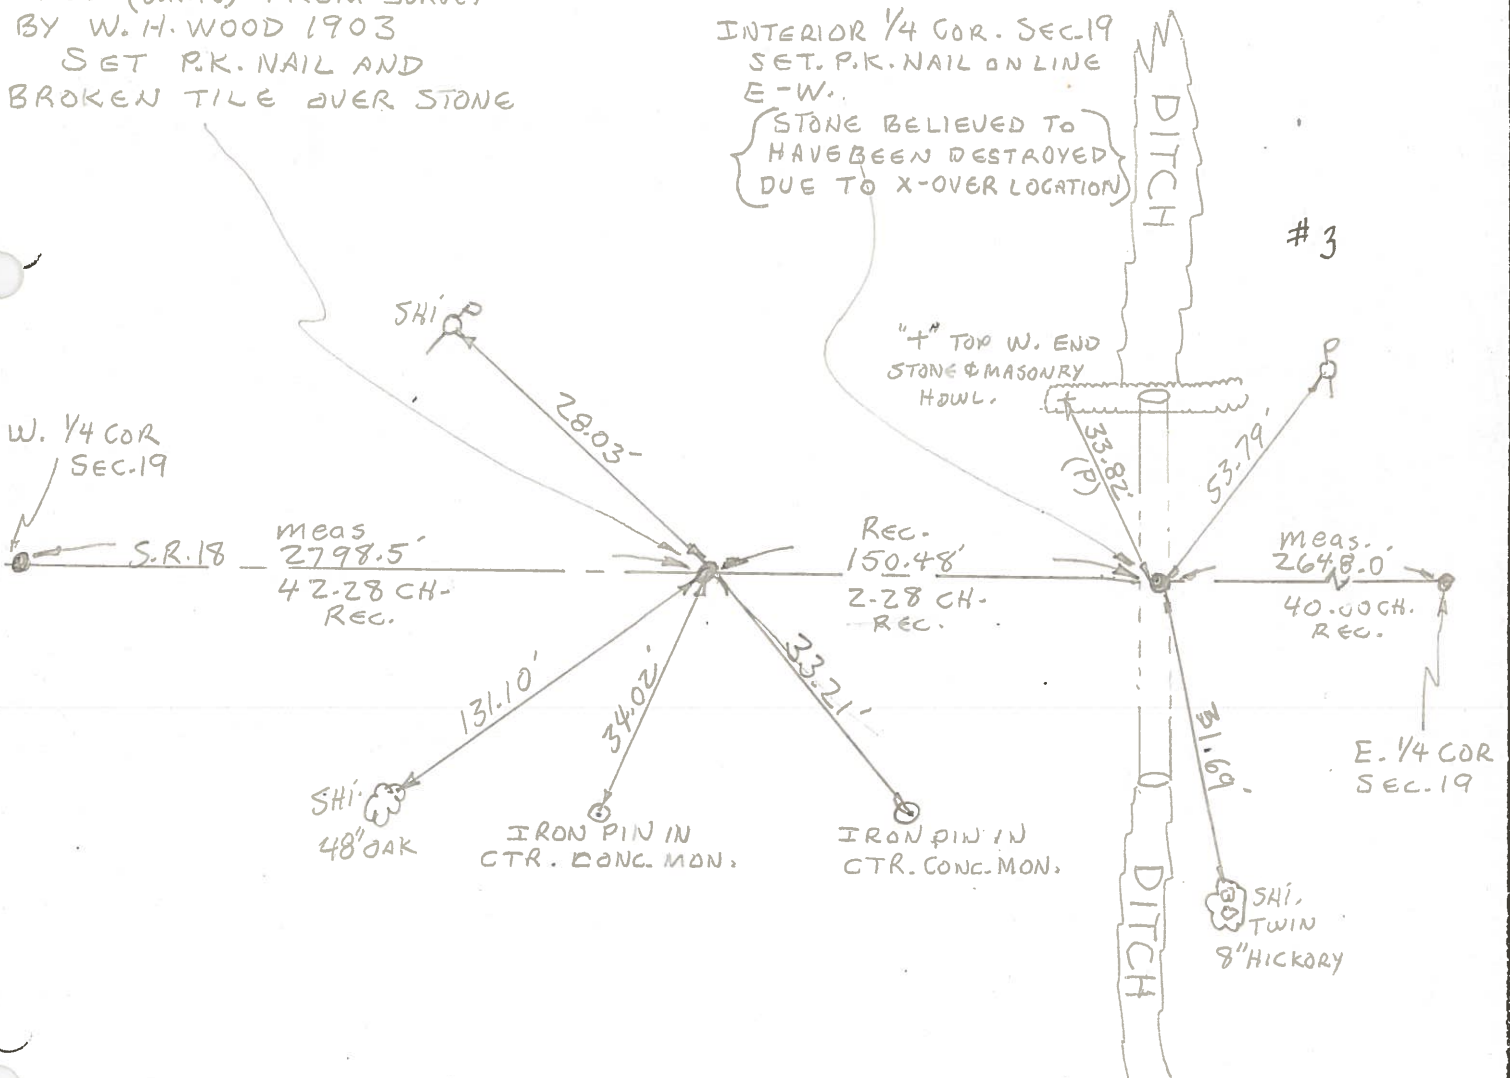

PERSONNEL	TITLE	PERSONNEL	TITLE
BURNSIDE			
SMITH			
BOWERS			
MEAD			

COUNTY WOODDATE 5-20-74S. R. 18WEATHER CLEARSEC. 19TEMP. +66°DESCRIPTION EST. W 1/4 COR. SEC. 19 JACKSON TWP R-9-E T-3-N

JOB NO. _____

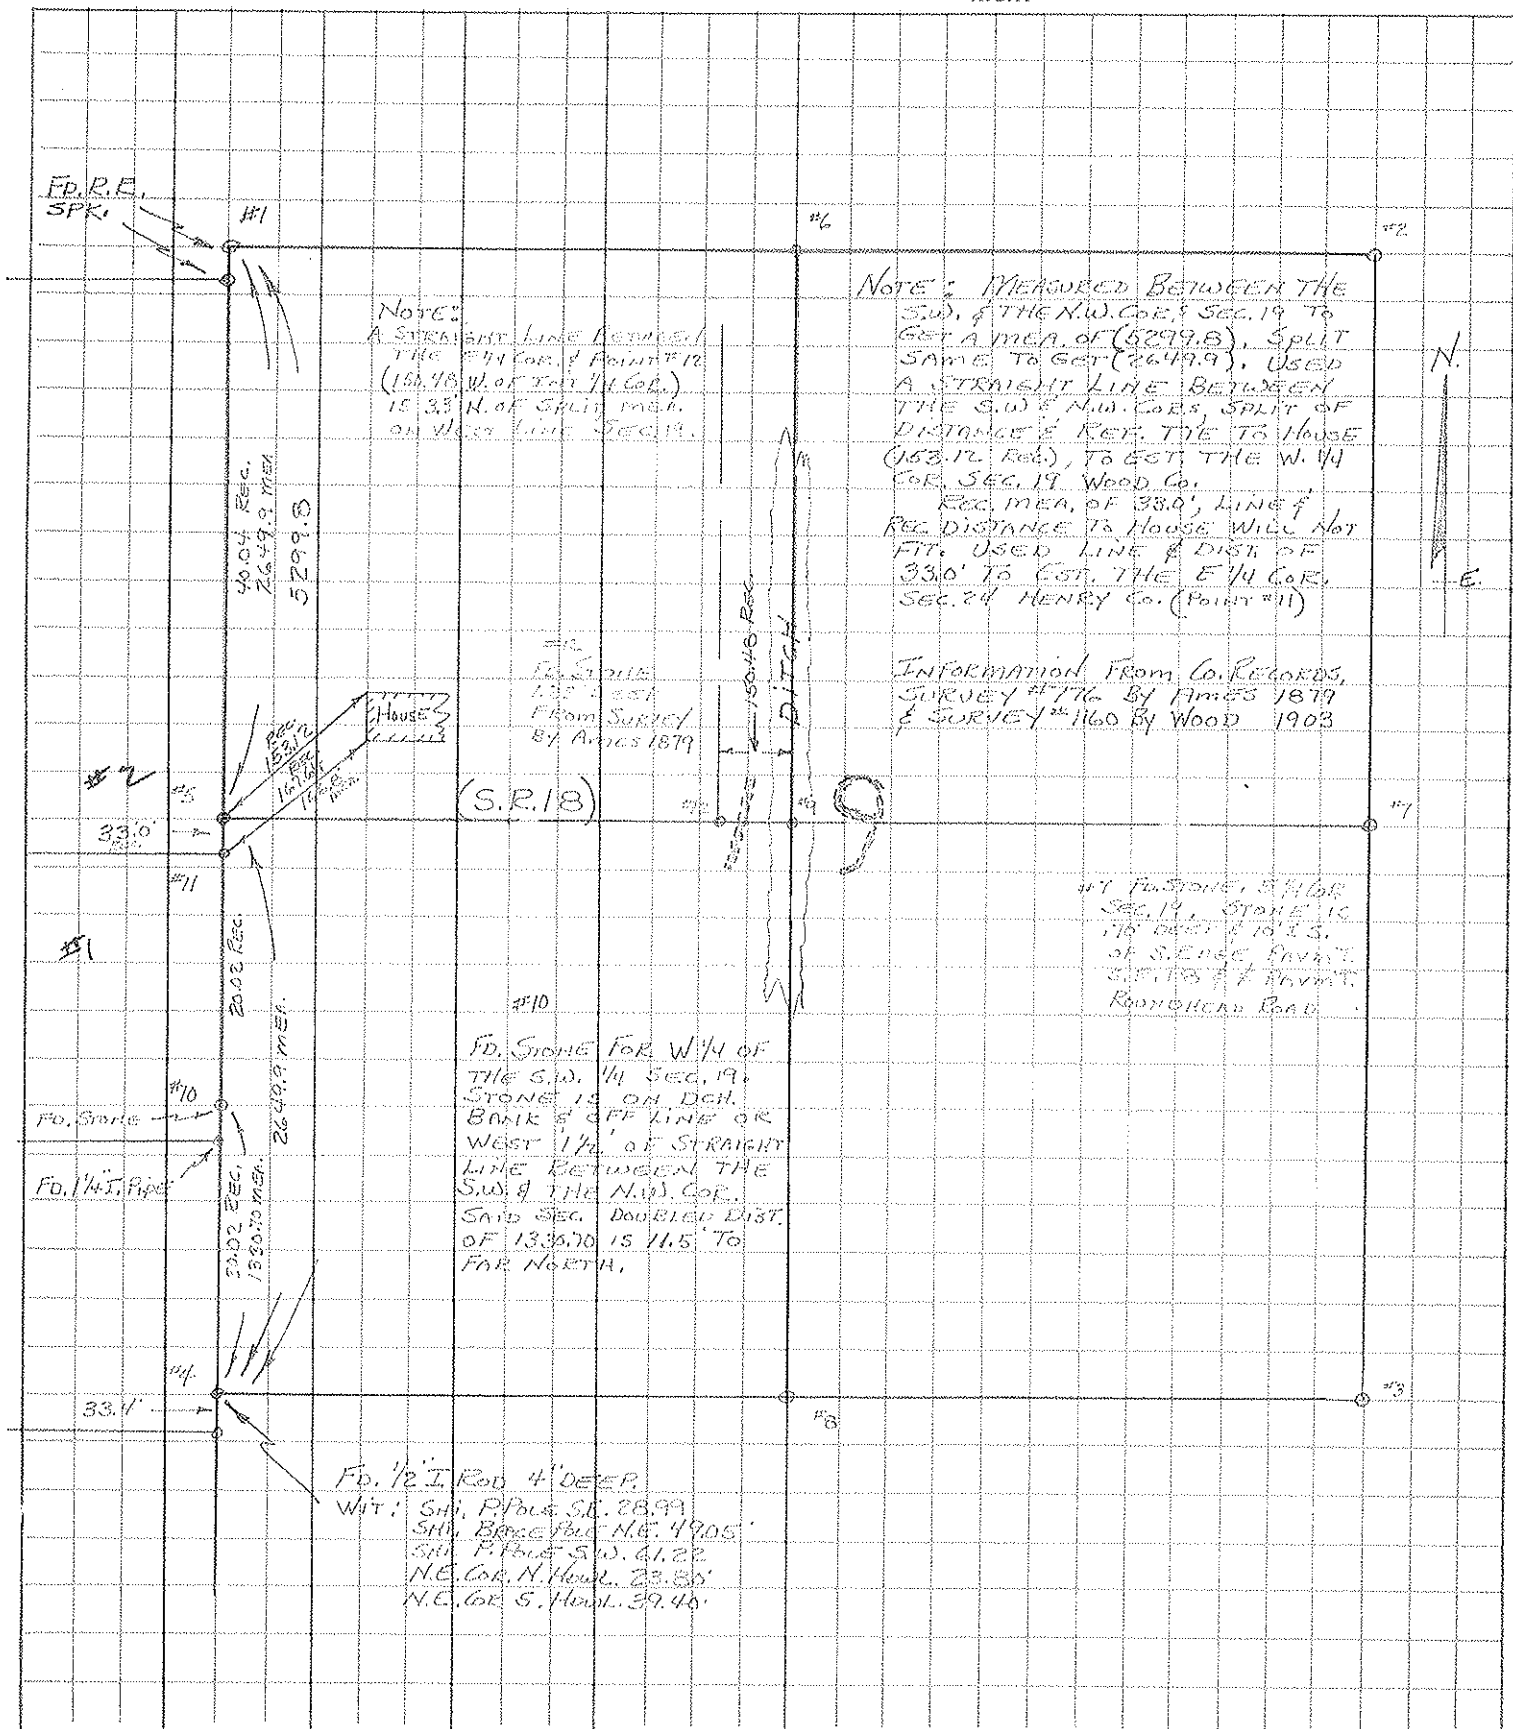

PERSONNEL	TITLE	PERSONNEL	TITLE	COUNTY	DATE	WEATHER	TEMP.
BURNSIDE				WOOD			
SMITH				Sec. 19 & 20			
BOWERS				JACKSON Twp			
KILOWSKI							

DESCRIPTION STONE REFERENCES

LEFT

CENTER LINE

RIGHT

JOB NO. _____

A	S.W. COR SEC. 19 JACKSON TWP. R-9-E T-3-N FD 1/2 I. Rod 4" DEEP.	WIT:	SHI. IN R. POLE	SW.	61.82
			SHI. IN F. POLE	SE.	28.99
			SHI. IN BRACE POLE	NE.	49.05
			NE. COR N. HOWL.		23.80
			NE. COR S. HOWL.		39.40
C	N 1/4 POST SEC. 20 JACKSON TWP. R-9-E T-3-N FD. STONE @ SURFACE 1 ON SPRINT OF MILE E. & W.	WIT:	4" TOP EAST END NORTH CONC. HOWL.		13.13
			4" " WEST " " " "		18.90
			4" " EAST " SOUTH " "		6.82
			4" " WEST " " " "		18.35
D	SE. COR SEC. 20 JACKSON TWP. R-9-E T-3-N FD. STONE ON WEST EDGE PAVE. 14" DEEP. SET 1/2 I. Rod ON TOP	WIT:	N.W. COR. W. PROJECTION HOUSE	NE.	86.80
			S.W. " " " "	NE.	74.24
			S.W. " S. " " "	NE.	76.88
			COR POST EAST		25.47
			" " WEST		17.08
B	NE. COR SEC. 19 JACKSON TWP. R-9-E T-3-N FD. R.R. Spt. @ SURFACE	WIT:	SHI. IN R. POLE	S.W.	51.83
			N.W. COR. E. CONC. BR. RAIL	SE.	16.30
			NE. COR W. CONC. BR. RAIL	SW.	15.38