

O.D.O.T. DISTRICT 2 SURVEY OFFICE (USE ONLY)

PERSONNEL

REFERENCE NO. 4

SHEET 4 OF 15

NOTES RHOADES

DATE 6-12-20

ROUTE SR 18

H.C. AUBLE

WEATHER SUNNY

COUNTY WOOD

R.C. MAHLER

TEMP. 66°F

TOWNSHIP JACKSON

O'DONNELL

SECTION 19

DWG BY MAHLER

PID PAVE TRAIN

T 3 N R 9 E

TYPE MONUMENT MAG/WASHER

ON SURFACE - ~~BELOW~~ ON

OFFSET CL PAVEMENT 18.2' ~~LT~~ : RT

- TO - EDGE PAVEMENT


STATION: 56+09

HORZ.DATUM: NAD83 (2011)

GEOID: NAVD88-2012A

GRID: NORTHING: 563168.439

EASTING: 1593906.314

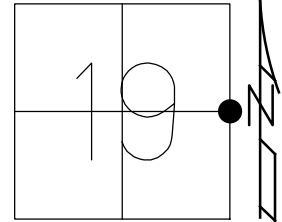

RECORD:

FD P.K.NAIL

ATOP P.K./WASHER

1.5" DOWN

ATOP LG.RR.SPIKE

3" DOWN

ATOP STONE

10.5" DOWN

SET MAG/WASHER

7-25-05, DCH

FD MAG/WASHER

REF3


9-02-15, DCH

FD MAG/WASHER

REF4

6-12-20

9-16-21, JFO

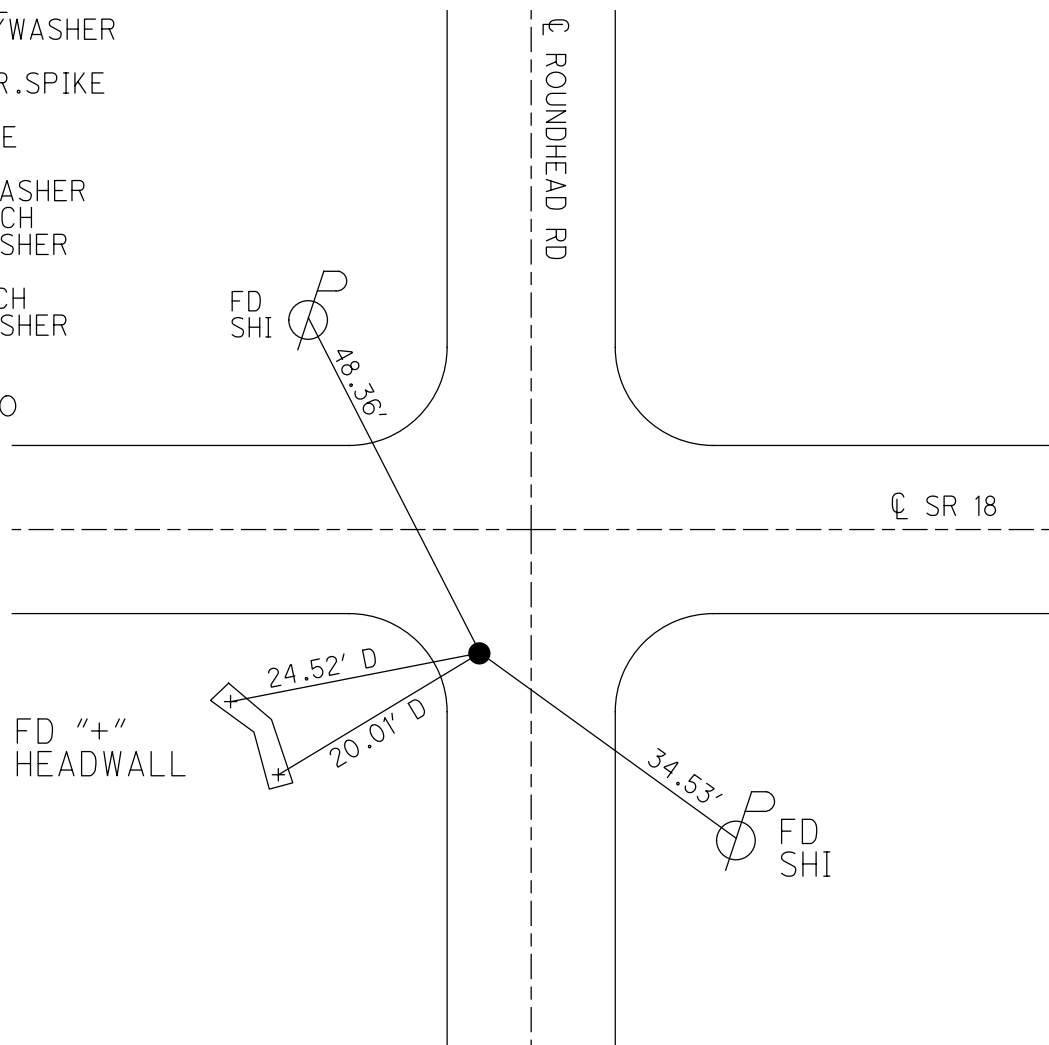

O.D.O.T. DISTRICT 2 SURVEY OFFICE (USE ONLY)

PERSONNEL

REFERENCE NO. 4

SHEET 4 OF 13

NOTES RHOADES

DATE 6-12-20

ROUTE SR 18

H.C. AUBLE

WEATHER SUNNY

COUNTY WOOD

R.C. MAHLER

TEMP. 66°F

TOWNSHIP JACKSON

O'DONNELL

SECTION 19

DWG BY MAHLER

PID PAVE TRAIN

T 3 N R 9 E

TYPE MONUMENT MAG/WASHER

ON SURFACE - ~~BELOW~~ ON

OFFSET Q PAVEMENT 18.2' ~~LT~~ : RT

- TO - EDGE PAVEMENT


STATION: 56+09

HORIZ.DATUM: NAD83 (2011)


GEOID: NAVD88-2012A

GRID: NORTHING: 563168.439

EASTING: 1593906.314

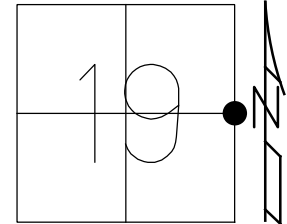

RECORD:
FD P.K.NAIL
ATOP P.K./WASHER
1.5" DOWN
ATOP LG.RR.SPIKE
3" DOWN
ATOP STONE
10.5" DOWN
SET MAG/WASHER
7-25-05, DCH
FD MAG/WASHER
REF3
9-02-15, DCH
FD MAG/WASHER
REF4
6-12-20, JFO

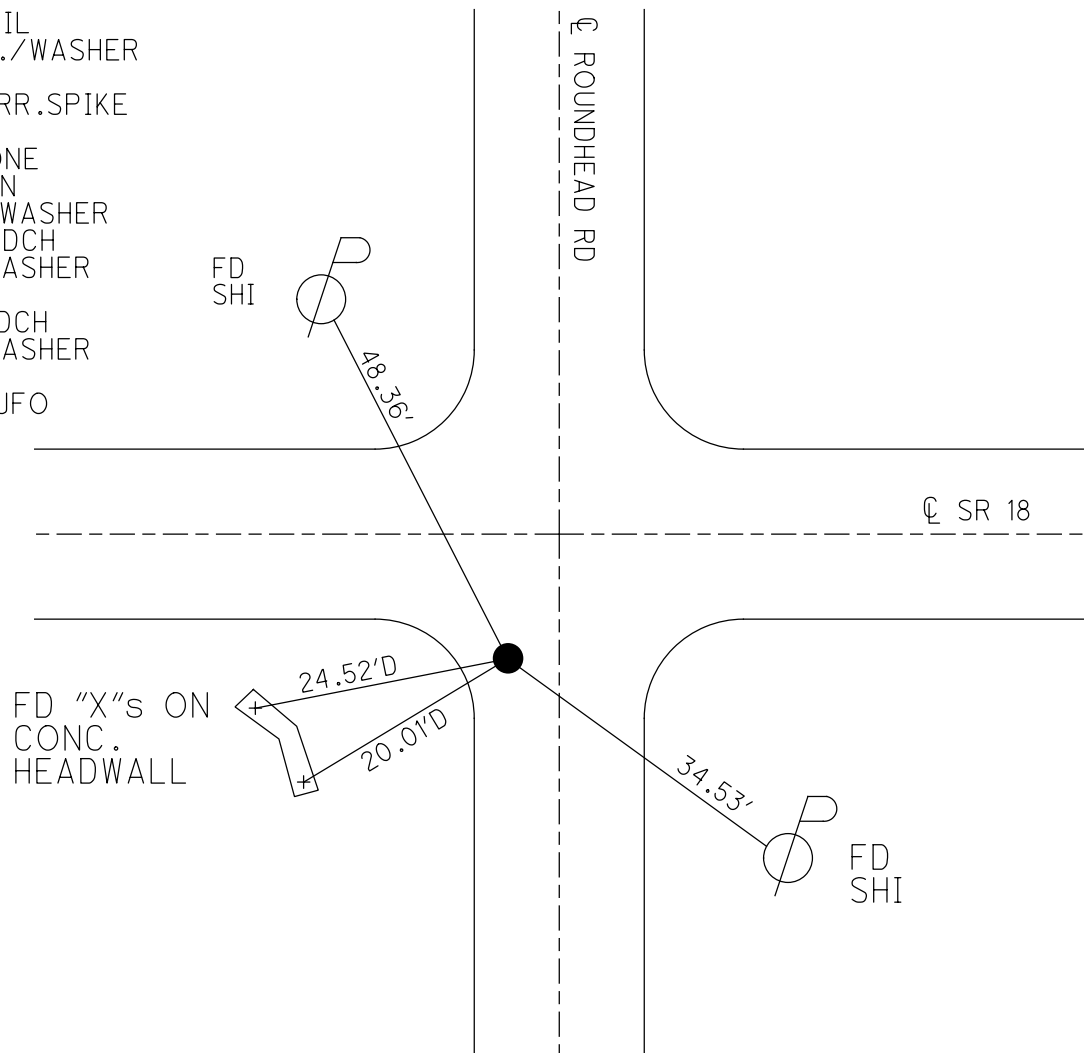


O.D.O.T. DISTRICT 2 SURVEY OFFICE (USE ONLY)

PERSONNEL _____ REFERENCE NO. 4 SHEET 4 OF 13
 NOTES _____ DATE 4-08-05 ROUTE SR 18
 H.C. HOMAN WEATHER SUNNY COUNTY WOOD
 R.C. HUSS TEMP. 55°F TOWNSHIP JACKSON
 _____ SECTION 19
 _____ T 3 N R 9 E

TYPE MONUMENT _____ PK/WASHER _____
 ON SURFACE - ~~BELOW~~ _____ ON _____
~~LEFT~~ = Q PAV'T - RIGHT 18.2'
 _____ TO _____ EDGE PAVEMENT
 S.L.M. 56+09


GRID: NORTHING: 563168.51 EASTING: 1593906.28

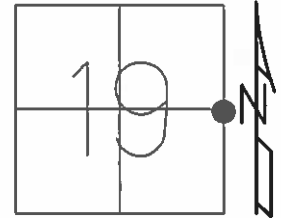

RECORD:
 PK ON SUFACE
 ATOP PK/WASHER 1.5"
 ATOP LG. RR. SPK. 3"
 ATOP STONE 10.5"

SET MAG/WASHER
 7-25-05, DCH

FD MAG/WASHER
 GPS, REF3
 09-02-15, DCH, JLL

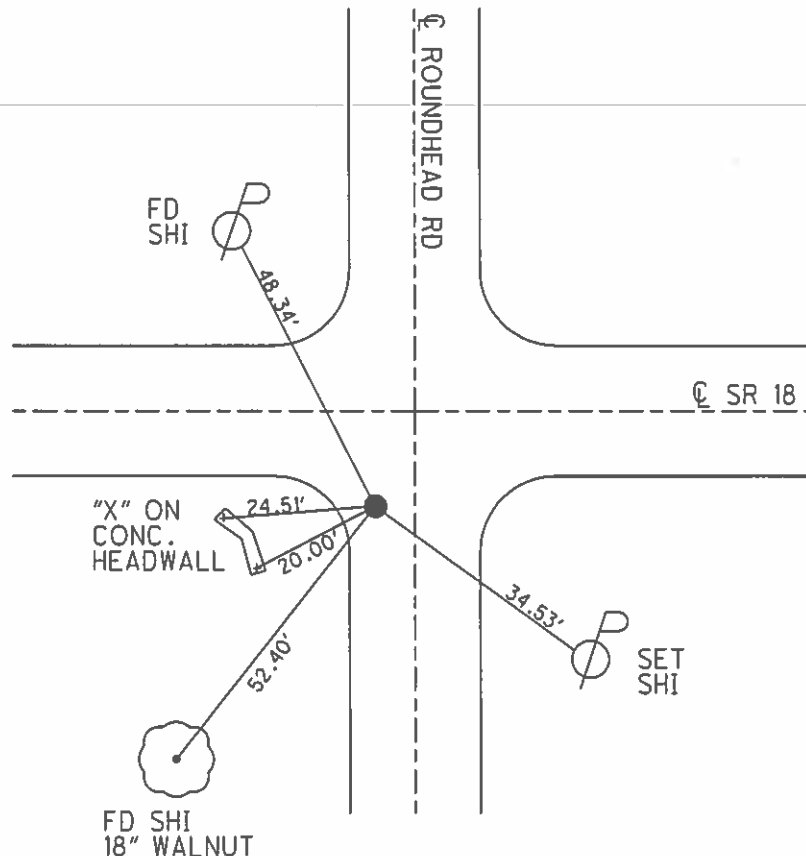

O.D.O.T. DISTRICT 2 SURVEY OFFICE

PERSONNEL

NOTES _____ DUANE

H.C. _____ STEVE

R.C. _____ JOE

REFERENCE NO. 4

DATE 4-08-05

WEATHER SUNNY

TEMP. 55°

SHEET 3 OF 14

ROUTE S.R. 18

COUNTY WOOD

TOWNSHIP JACKSON

SECTION 19

T 3 N R 9 E


TYPE MONUMENT _____ PK & WASHER

ON SURFACE - ~~BELOW~~ _____ ON

~~LEFT - C PAVT~~ - RIGHT 18.2'

_____ TO _____ EDGE PAVEMENT

S.L.M. _____ 56+09

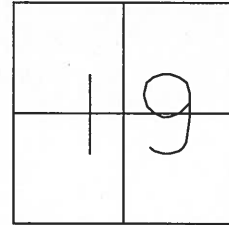


RESET MAG NAIL & WASHER
7-25-05
DCH

FOUND PK ON SURFACE

1 1/2" DOWN FOUND PK & WASHER

3" DOWN FOUND LG RR SPIKE

10 1/2" DOWN FOUND STONE

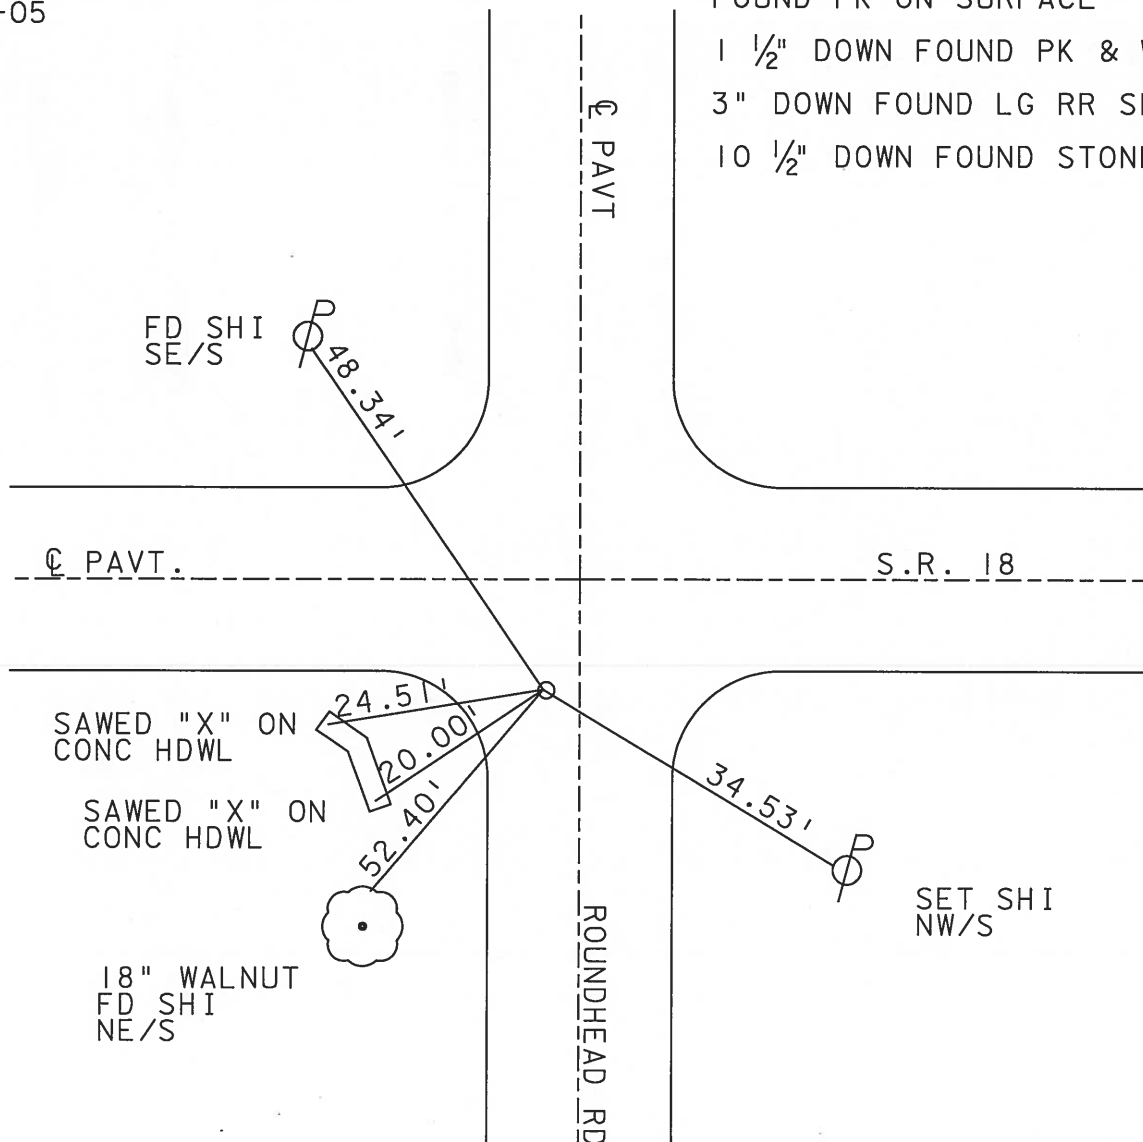

O.D.O.T. DISTRICT 2 SURVEY OFFICE

PERSONNEL

REFERENCE NO. 4

SHEET OF

NOTES BAERNHISEL

H.C. LDEhrke

R.C. HOFFMAN

DATE 3-19-91

WEATHER cloudy - Windy

TEMP. +40°

ROUTE 18

COUNTY Wood

TOWNSHIP JACKSON

SECTION 19

T 3 N R 9 E


TYPE MONUMENT P.K. & Washer

ON SURFACE - BELOW yes


LEFT - & PAV'T. - RIGHT 18.4

110 FT TO LT EDGE PAVEMENT


S.L.M. 55+98

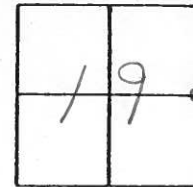

Set P.K. & Washer
4-17-91
mB

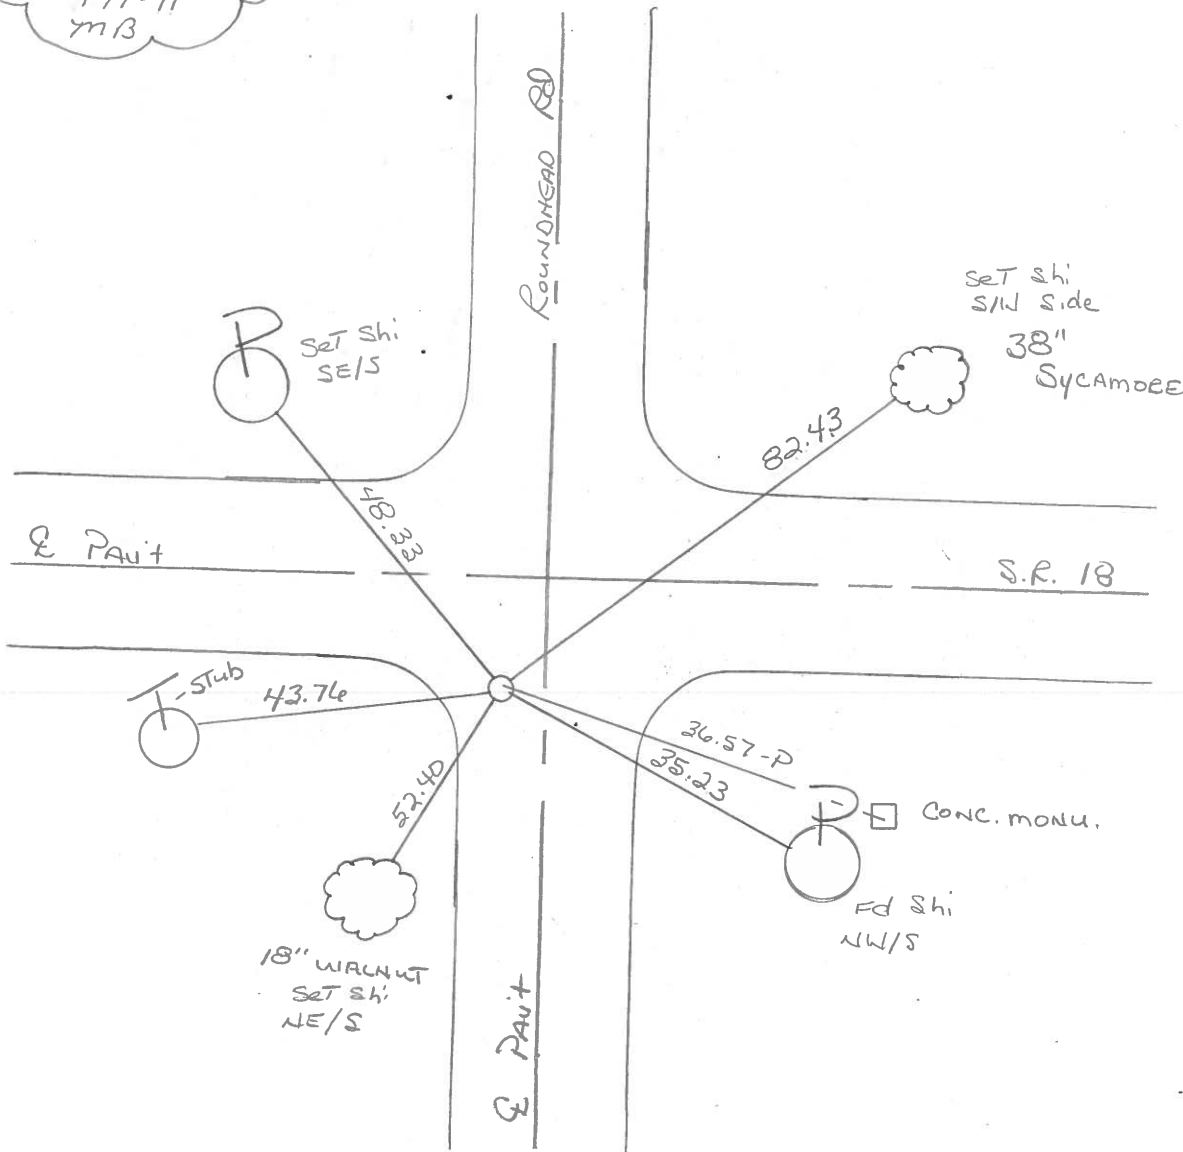


Q.D.O.T. DISTRICT 2 SURVEY OFFICE

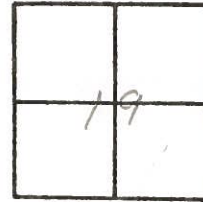SHEET 4 OF County WOOD S.R. 18Township JACKSONSection 19T3N, R9EPersonnel BARNHISEL H.C.HOUSEHOLDER R.C.LOEHKE Date 11-25-83Weather CLEAR, WINDYTemp. +34°

Fd SMALL RR SPIKE
SLM 55+89 @ SURFACE
10± Rt of SEP
2' W of Q ROUNDHEAD Rd

SET PK + WASHER
7-25-85
C.L.

#4

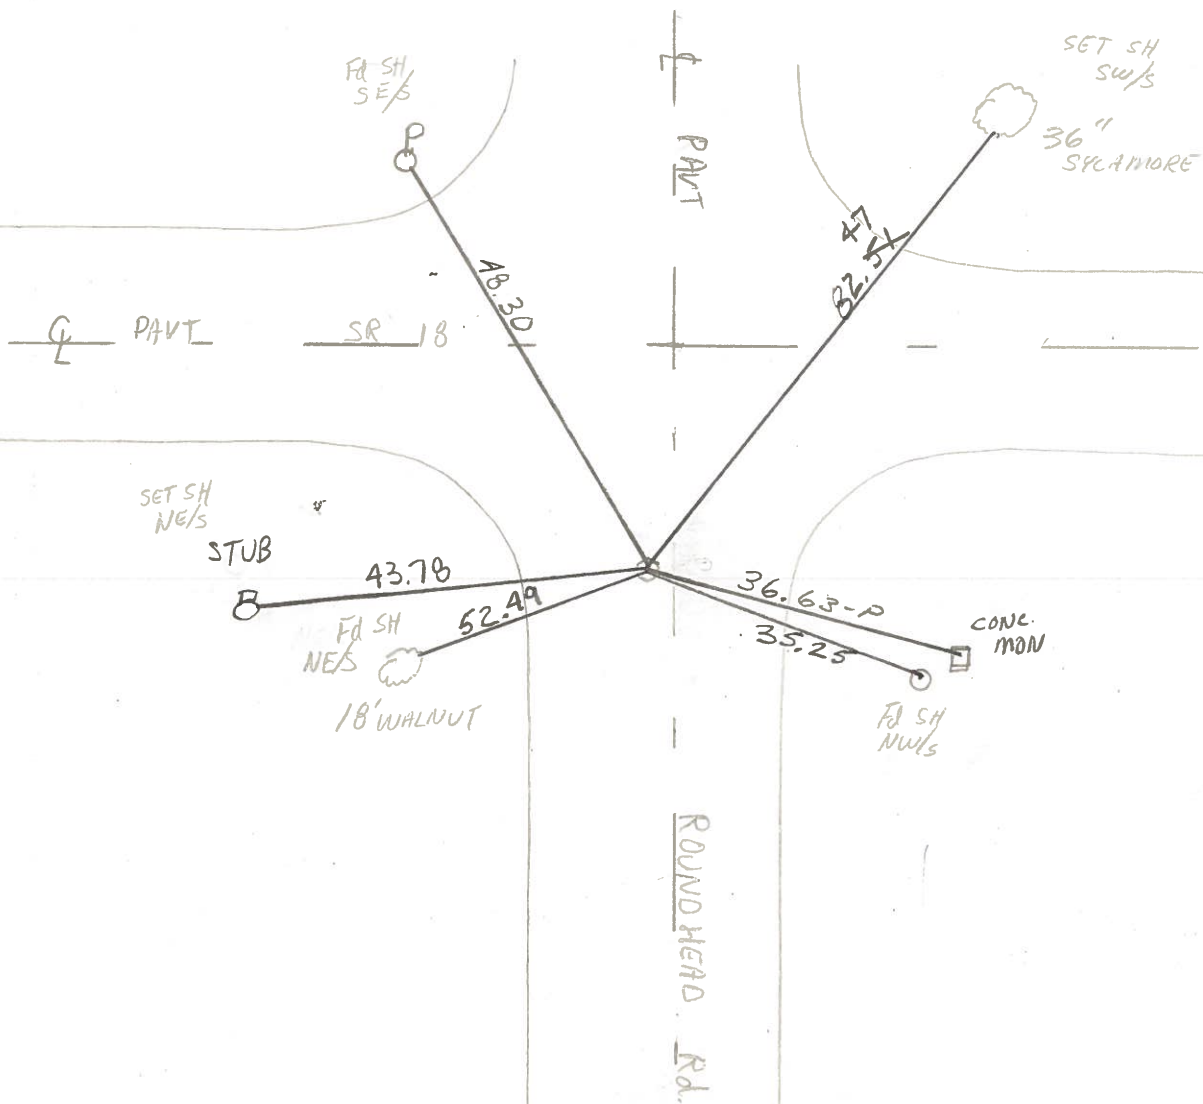

County WISCONSIN S.R. 2

Date 11-25-83

Township TACSON

Weather Cloudy, Windy

Section 19


Temp. + 24°

T3N, R9E

Personnel H.C.

 R.C.

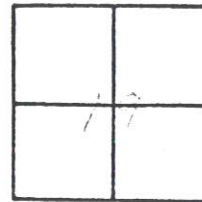


Ed SMALL RS SPIKE
SLIN 55+89
10± R+ of SEP
2' W of Q Roundhead R.

SET PK + WASHER
7-25-83
C.L.

#4

18.4 RT Q
PK & WASHER
55+98

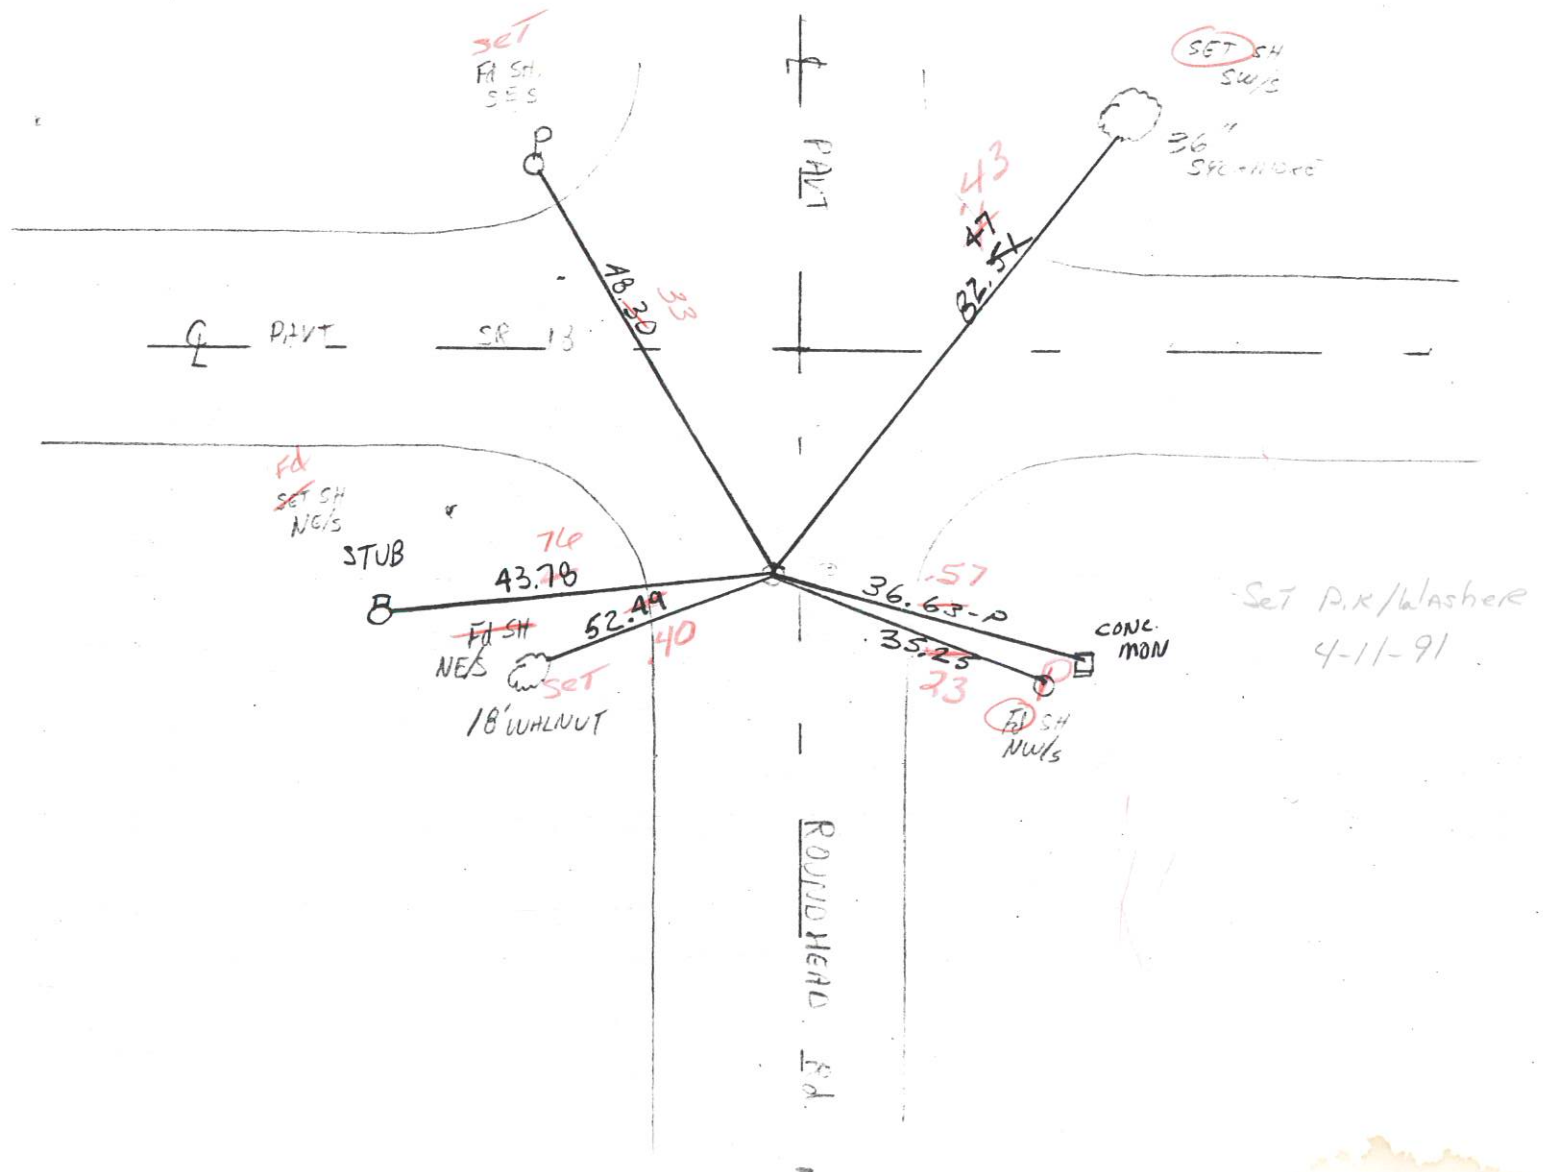

O.D.O.T. DISTRICT 2 SURVEY OFFICE

SHEET 4 OF

County WOOD S.R. 18

Township JACKSON

Section 19

T3N, R9E

Personnel BURNSIDE

SMITH


BOWERS

MEAD

Date 5-30-74

Weather CLEAR


Temp. 80°

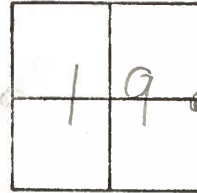

#4

FD. STONE .70' DEEP
AND 10'± SOUTH OF SOUTH
EDGE PAVT.


SET SMALL R.R. SPK.
AND BROKEN TILE OVER STONE

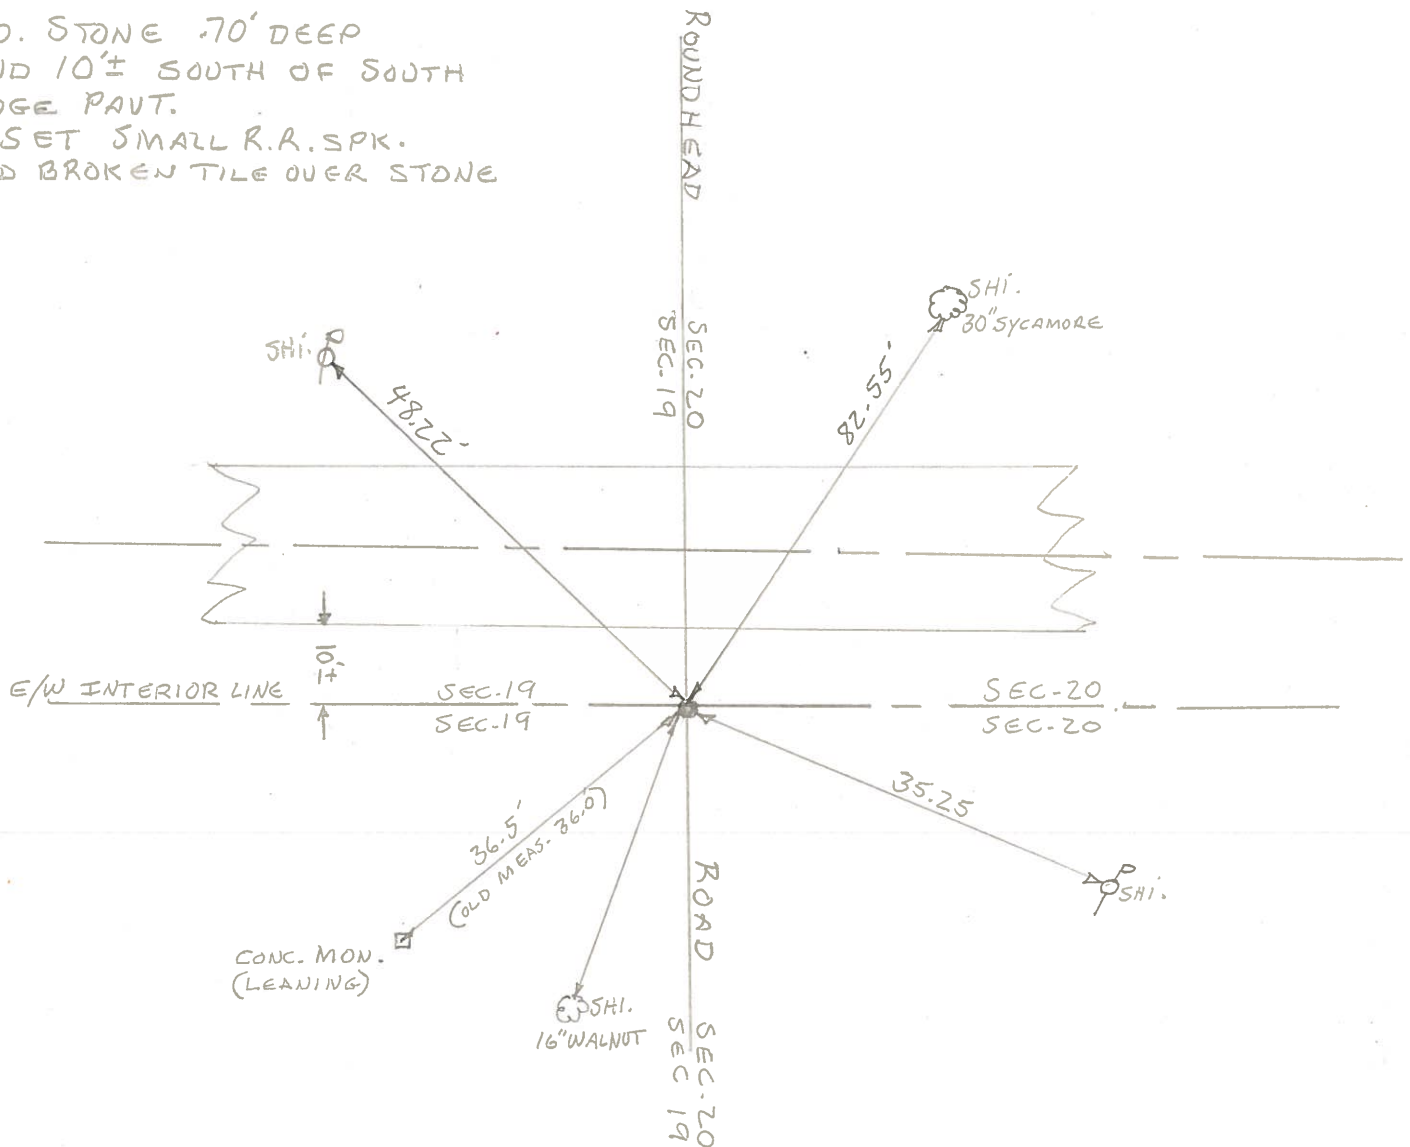

PERSONNEL	TITLE	PERSONNEL	TITLE
BURNSIDE			
SMITH			
BOWERS			
MEAD			

COUNTY WOODDATE 5-20-74S. R. 18WEATHER CLEARSEC. 19TEMP. +66°DESCRIPTION EST. W 1/4 COR. SEC. 19 JACKSON TWP R-9-E T-3-N

JOB NO. _____

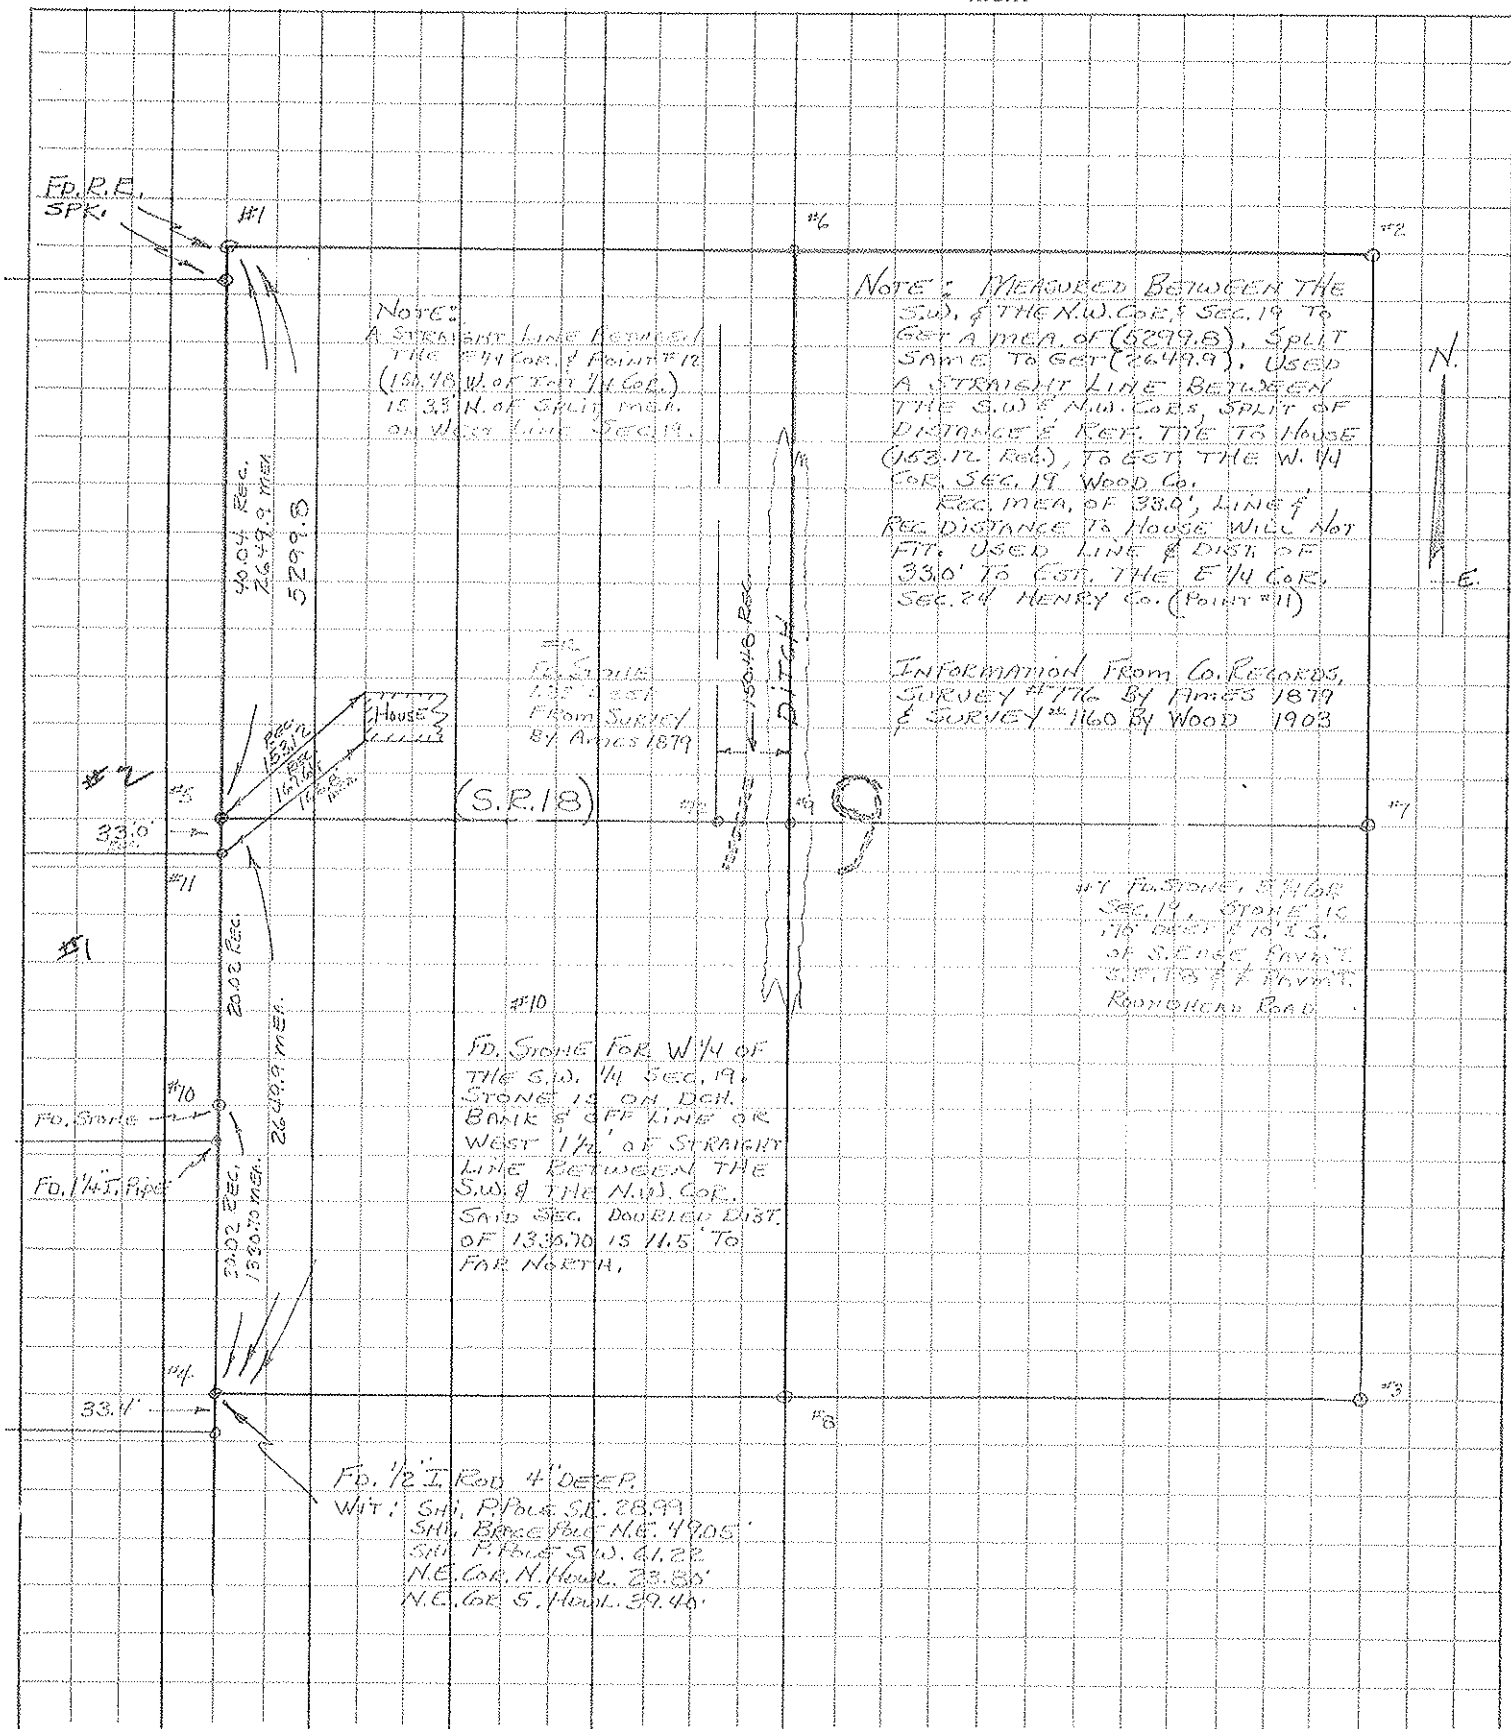

PERSONNEL	TITLE	PERSONNEL	TITLE	COUNTY	DATE	WEATHER	TEMP.
BURNSIDE				WOOD			
SMITH				Sec. 19 & 20			
BOWERS				JACKSON Twp			
KILOWSKI							

DESCRIPTION STONE REFERENCES

LEFT

CENTER LINE

RIGHT

JOB NO. _____

A	S.W. COR SEC. 19 JACKSON Twp. R-9-E T-3-N FD 1/2 I. Rod 4" DEEP.	WIT:	SHI. IN R. POLE	SW.	61.82
			SHI. IN F. POLE	SE.	28.99
			SHI. IN BRACE POLE	NE.	49.05
			NE. COR N. HOWL.		23.80
			NE. COR S. HOWL.		39.40
C	N 1/4 Post SEC. 20 JACKSON Twp. R-9-E T-3-N FD. STONE @ SURFACE 1 ON SPRIT OF MILE E. & W.	WIT:	4" Top East End North Conc. Howl.		13.13
			4" " West " " " "		18.90
			4" " East " South " "		6.82
			4" " West " " " "		18.35
D	SE. COR SEC. 20 JACKSON Twp. R-9-E T-3-N FD. STONE ON WEST EDGE PAVE. 14" DEEP. SET 1/2 I. Rod ON TOP	WIT:	N.W. COR. W. PROJECTION HOUSE	NE.	86.80
			S.W. " " " "	NE.	74.24
			S.W. " S. " " "	NE.	76.88
			COR Post East		25.47
			" " West		17.08
B	NE. COR SEC. 19 JACKSON Twp. R-9-E T-3-N FD. R.R. Spk. @ SURFACE	WIT:	SHI. IN R. POLE	SW.	51.83
			N.W. COR. E. CONC. BR. RAIL	SE.	16.30
			NE. COR W. CONC. BR. RAIL	SW.	15.38

PERSONNEL TITLE PERSONNEL TITLE

BURNSIDE

COUNTY WOOD

DATE 12-1-70

SMITH

S. R. 18

WEATHER CLOUDY

BOWERS

SEC. 6, LINE EAST

TEMP. +58°

HOLCOMBE

DESCRIPTION

LEFT

CENTER LINE

RIGHT

JOB NO.

W 1/4 POST SEC. 20
JACKSON TWP.

FD. R.R. SPK. 20' BELOW
SURFACE, FROM OLD MON.
WIT. 10' ± S. OF S. EDGE PAVE.

4

INTERIOR COR. SEC. 19
"DID NOT FIND"

W 1/4 POST SEC. 19
JACKSON TWP.
(COUNTY LINE)
"DID NOT FIND"
12-1-70

SHi. 30"
SYCAMORE

82.66'

34.92'

SHi.

ROUNDHEAD ROAD

48.55'

SHi.

36.7'
(OLD MON. SEC.)

52.22'

SHi. 16"
WALNUT

CONC. MON
"LEANING"



SEE NEW TIES

PERSONNEL

TITLE

PERSONNEL

TITLE

COUNTY

DATE

DATE

WEATHER

TEMP

DESCRIPTION

LEFT

CENTER LINE

RIGHT

JOB NO.

NOTES

Wood

S. R. #18

SEC. A E F F

(1960)

Set I-pin 12.8' S. of iron
pipe which is W/4
post of sec. 19 Jackson
Twp. County line

#101

(S.E. to T.P. gone 27
with to S.W. to cor. fence post 25
Iron Pin)

#102

Did Not Find

Stone - W/4 post sec. 20
Jackson Twp.

S.R. #18 & Roundhead Rd.

#103

Conc. man. gone S.E. 29.

Conc. man. gone S.W. 36

#104

Did not find

X 12" Step Church stairs E.S.E. 79.84

Shiner 14" Locust W.S.W. 80.51

Shiner 26" Oak W.N.W. 95.06

NE cor. church S.E. 86.0'

S.W. cor. church S.E. 110.7'

Conc. Mt. (old leaning) S.W. 29.85

N.W. 25.85

MAY 16, 1958 - Wood Co.

Found

E/4 Post 20 #105

I. Pin

N.E. Pt. Hdd. S.W. 19.90'

W/4 Post 21 S.R. #18 & Custar Rd.

S.E. Pt. Hdd. N.W. 22.65'

Placed I. Pin @ side of higher R.P.P. Spk

Int. 1/4 post sec. 21

Found

Conc. man. S.E. 31.99321

Jackson Twp.

Found

Conc. man. S.W. 31.33216

Iron pin over stone

I. Pin 20'

Shiner 22' Elm S.E. 33.86'

S.R. #18 & Hockenberry Rd.

S. of S.

Shiner P. Pole S.W. 29.85'

#106

edge Post

Shiner 20' Crabapple N.W. 45.31

Shiner 22' Apple N.E. 62.76'