

O.D.O.T. DISTRICT 2 SURVEY OFFICE (USE ONLY)

PERSONNEL

REFERENCE NO. 5

SHEET 5 OF 15

NOTES RHOADES

DATE 6-12-20

ROUTE SR 18

H.C. AUBLE

WEATHER SUNNY

COUNTY WOOD

R.C. MAHLER

TEMP. 66°F

TOWNSHIP JACKSON

O'DONNELL

SECTION 20

DWG BY MAHLER

PID PAVE TRAIN

T 3 N R 9 E

TYPE MONUMENT MAG/WASHER

ON SURFACE - ~~BELOW~~ ON

OFFSET CL PAVEMENT 6.6' ~~LT~~ : RT

3.1' TO RT EDGE PAVEMENT



STATION: 82+62

HORIZ.DATUM: NAD83 (2011)

GEOID: NAVD88-2012A

GRID: NORTHING: 563154.306

EASTING: 1596559.680

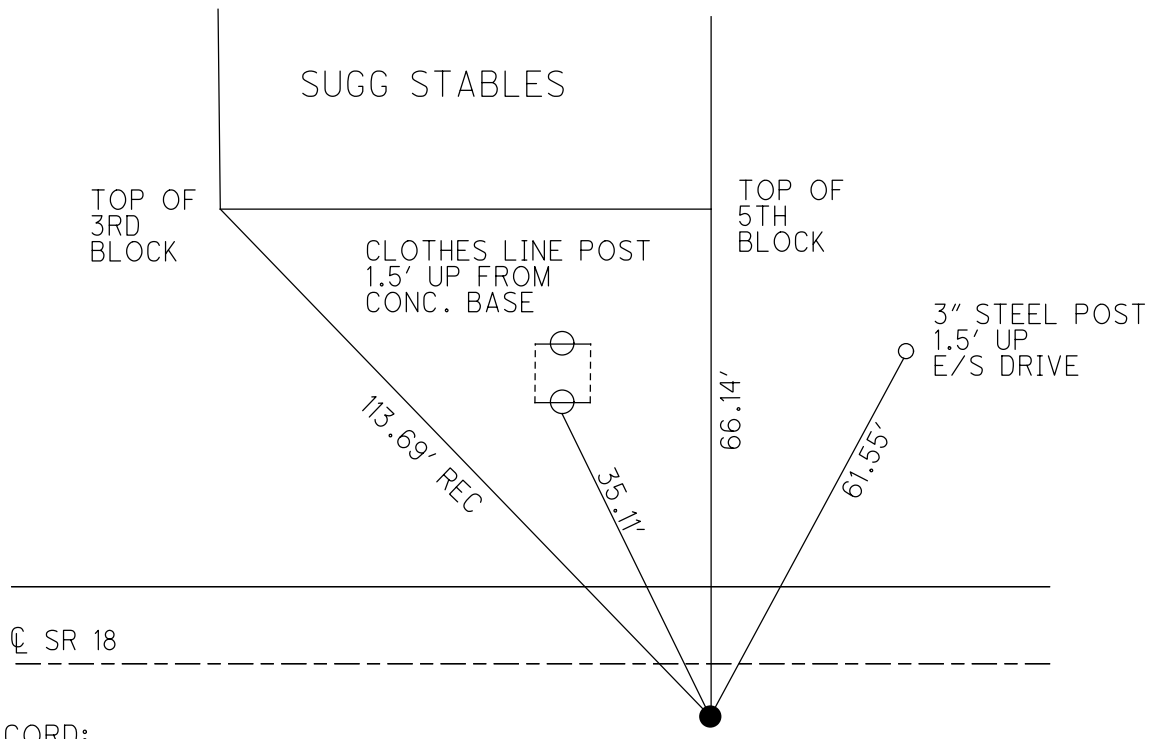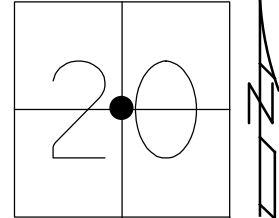

RECORD:
FD SM.R.R.SPIKE
4" DOWN
SET MAG/WASHER
6-29-05, DCH
REF4
9-04-15, DCH
FD MAG/WASHER
REF5
6-12-20, JFO
SET MAG/WASHER
NEWREF5
9-16-21, JFO

O.D.O.T. DISTRICT 2 SURVEY OFFICE (USE ONLY)

PERSONNEL

REFERENCE NO. 5

SHEET 5 OF 13

NOTES RHOADES

DATE 6-12-20

ROUTE SR 18

H.C. AUBLE

WEATHER SUNNY

COUNTY WOOD

R.C. MAHLER

TEMP. 66°F

TOWNSHIP JACKSON

O'DONNELL

SECTION 20

DWG BY MAHLER PID PAVE TRAIN

T 3 N R 9 E

TYPE MONUMENT MAG/WASHER

ON SURFACE - ~~BELOW~~ ON

OFFSET CL PAVEMENT 6.6' ~~LT~~ : RT

3.1' TO RT EDGE PAVEMENT


STATION: 82+62

HORZ.DATUM: NAD83 (2011)


GEOID: NAVD88-2012A

GRID: NORTHING: 563154.309

EASTING: 1596559.655

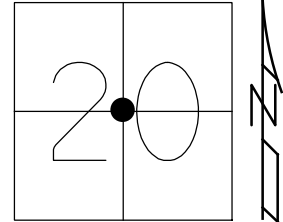

RECORD:
FD SM. RR. SPIKE
4" DOWN
SET MAG/WASHER
6-29-05, DCH
REF 4
9-04-15
FD MAG/WASHER
REF5
6-12-20, JFO

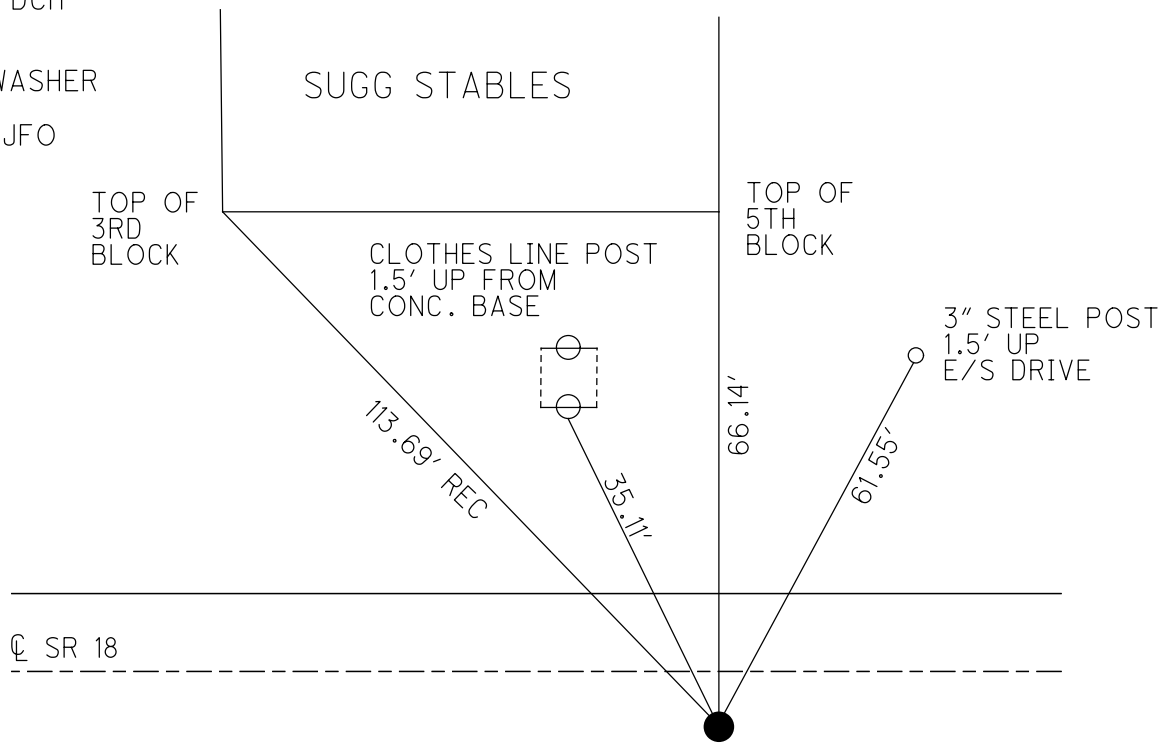


O.D.O.T. DISTRICT 2 SURVEY OFFICE (USE ONLY)

PERSONNEL _____ REFERENCE NO. 5 SHEET 5 OF 13
 NOTES _____ DATE 09-04-15 ROUTE SR 18
 H.C. LEU WEATHER PTLY CLOUDY COUNTY WOOD
 R.C. HOMAN TEMP. 78°F TOWNSHIP JACKSON
 _____ SECTION 20
 _____ T 3 N R 9 E

TYPE MONUMENT _____ MAG/WASHER _____
 ON SURFACE - ~~BELOW~~ _____ ON _____
~~LEFT~~ = $\odot$ PAV'T - RIGHT _____ 6.6'
 3.1' TO RT EDGE PAVEMENT
 S.L.M. _____ 82+62


GRID: NORTHING: 563154.32 EASTING: 1596559.68

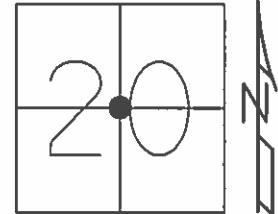

RECORD:
 FD SM. RR. SPK.
 4" DOWN

SET MAG/WASHER
 6-29-05, DCH

GPS, REF 4
 09-04-15

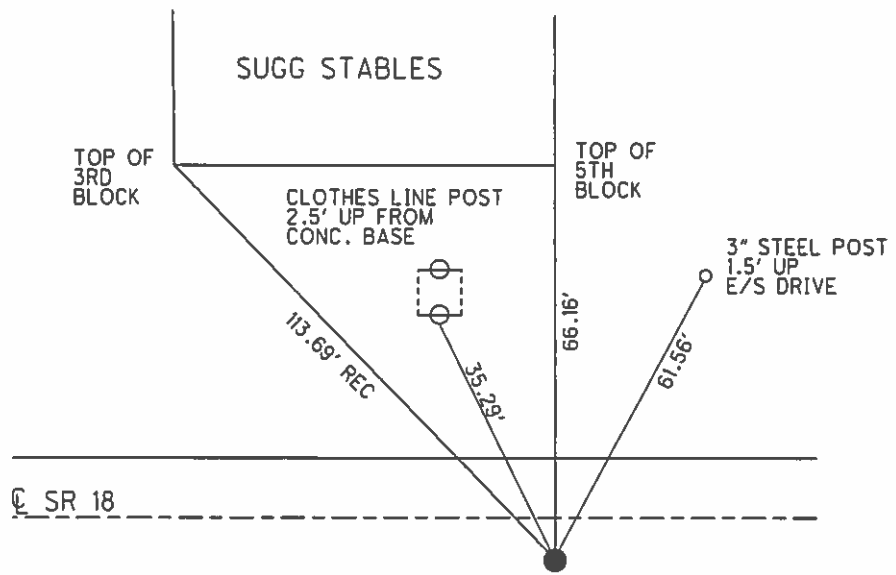

O.D.O.T. DISTRICT 2 SURVEY OFFICE

PERSONNEL

REFERENCE NO. 5

SHEET 4 OF 14

NOTES STEVE

DATE 04-11-05

ROUTE S.R. 18

H.C. DUANE

WEATHER CLOUDY

COUNTY WOOD

R.C. JOE

TEMP. 55°

TOWNSHIP JACKSON

SECTION 20

T 3 N R 9 E


TYPE MONUMENT PK & WASHER

ON SURFACE - ~~BELOW~~ ON

~~LEFT - C PAVT~~ - RIGHT 6.6'

3.1' TO RT EDGE PAVEMENT

S.L.M. 82+62

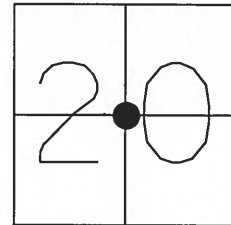

RESET MAG & WASHER
6-29-05
DCH

FD SMALL RR SPIKE
4" DOWN

SUGG
STABLES

TOP OF
3RD
BLOCK

TOP OF
5TH
BLOCK

1.5' UP
3" STEEL
POST
E/S DRIVE

CLOTHES
LINE
POST
2.5' UP
FROM
CONC.
BASE

113.69' REC

66.10'

61.50'

35.03'

C PAVT

S.R. 18

N 1/4 COR
SEC 20

2653.8' REC

Record = 5275.5

E 1/4
COR
SEC 20

70.50' P

O.D.O.T. DISTRICT 2 SURVEY OFFICE

PERSONNEL

REFERENCE NO. 5

SHEET OF

NOTES BARNHISEL

H.C. Loehke

DATE 3-19-91

ROUTE 18

R.C. HOFFMAN

WEATHER cloudy - windy

COUNTY HENRY

TEMP. +40°

TOWNSHIP JACKSON

SECTION 20

T 3 N R 9 E


TYPE MONUMENT P.K. & Washer

ON SURFACE - BELOW yes

LEFT - CL PAV'T. - RIGHT 6.7

3.7 TO RT EDGE PAVEMENT


S.L.M. 82+52

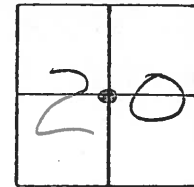

Set P.K. & Washer

4-17-91

m/b

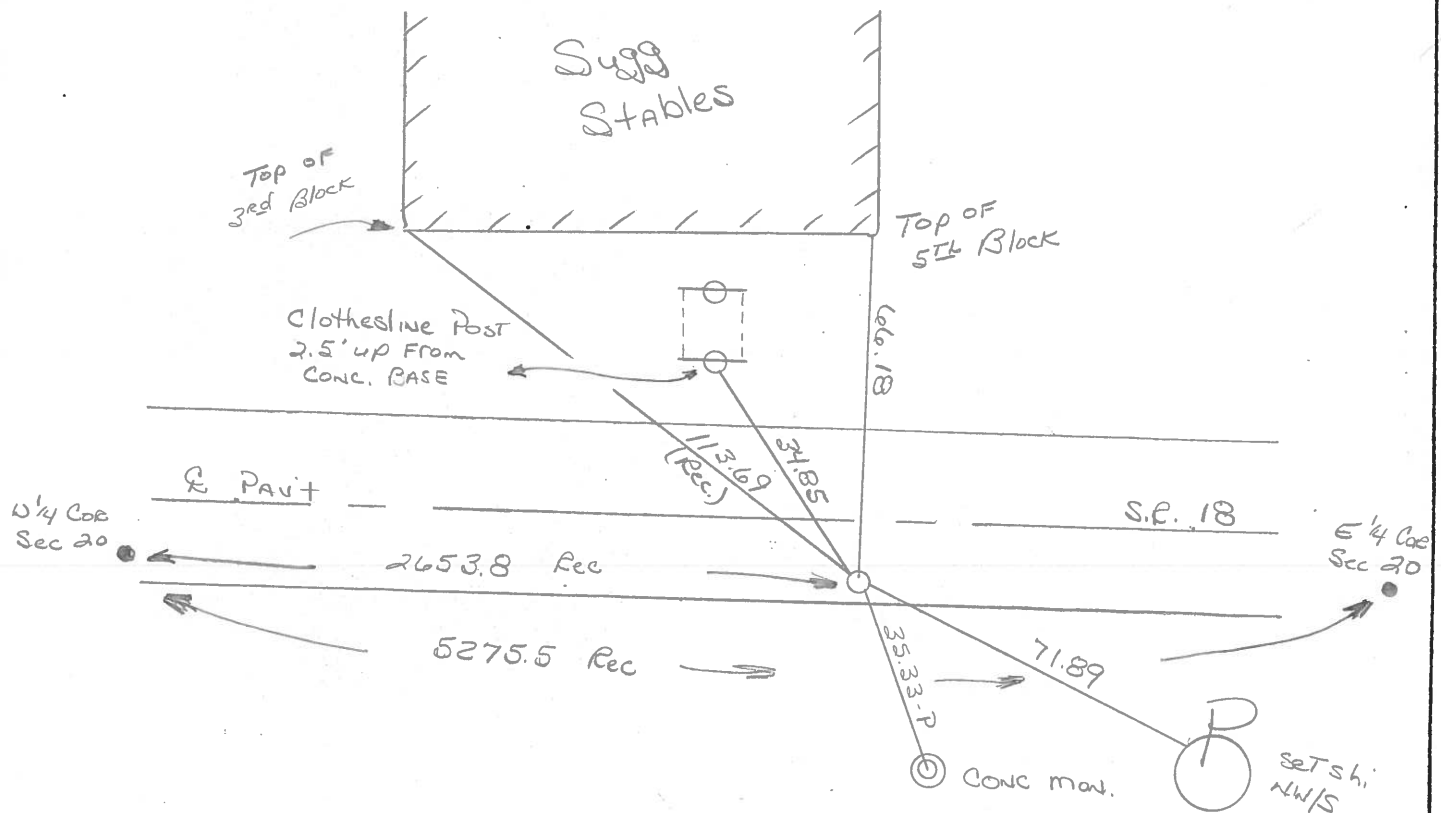

Q.D.O.T. DISTRICT 2 SURVEY OFFICE

SHEET 5 OF

County WOOD S.R. 18

Township JACKSON

Section 20

T3N, R9E

Personnel BARNHISEL H.C.


HOUSEHOLDER R.C.

LOEHRKE

Date 11-25-83

Weather CLEAR, WINDY

Temp. +34

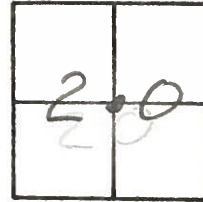

FD. Small R.R. SPIKE @ SURFACE

6.5' Rt of & S.R. 18,

+ 2.5' Lt of SEP.


S.L.M. 82+41

SET PK + WASHER

7-25-85

C.L.

#5

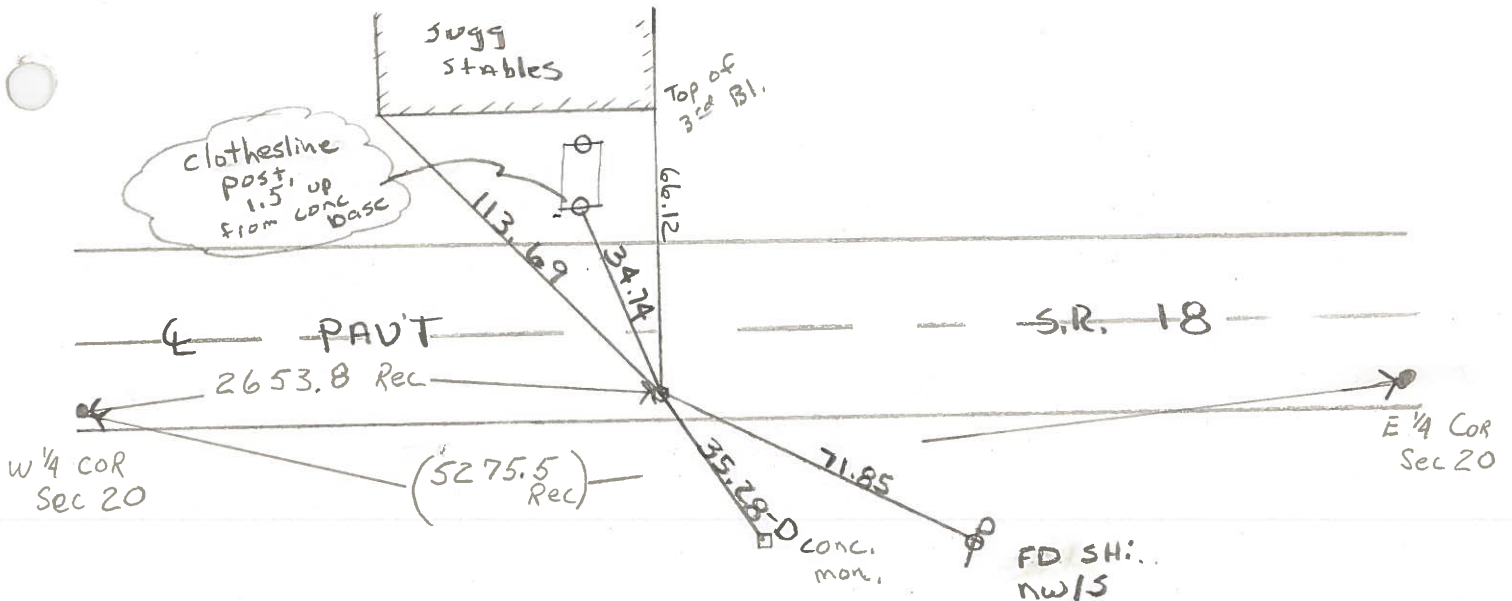

County WOOD S.R. 18

Township JACKSON

Section 20


T3N, R9E

Personnel	<u>BARDHISEL</u>	<u>H.C.</u>
	<u>HOUSEHOLDER</u>	<u>R.C.</u>
	<u>LEHRKE</u>	<u>✓</u>

Date 11-25-83

Weather CLEAR, WINDY

Temp. +34

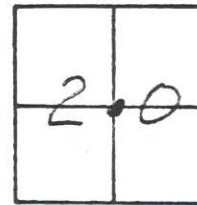

FD. Small R.R. SPIKE @ CORNER

SET PK + WASHER

7-25-85

#5

C.L.

6.7 ~~6.5~~' Rt of & S.R. 18,


3.7 ~~+2.5~~' Lt of SEP.

S.L.M. 82+~~41~~

52


Set PK/Washer

4-11-91

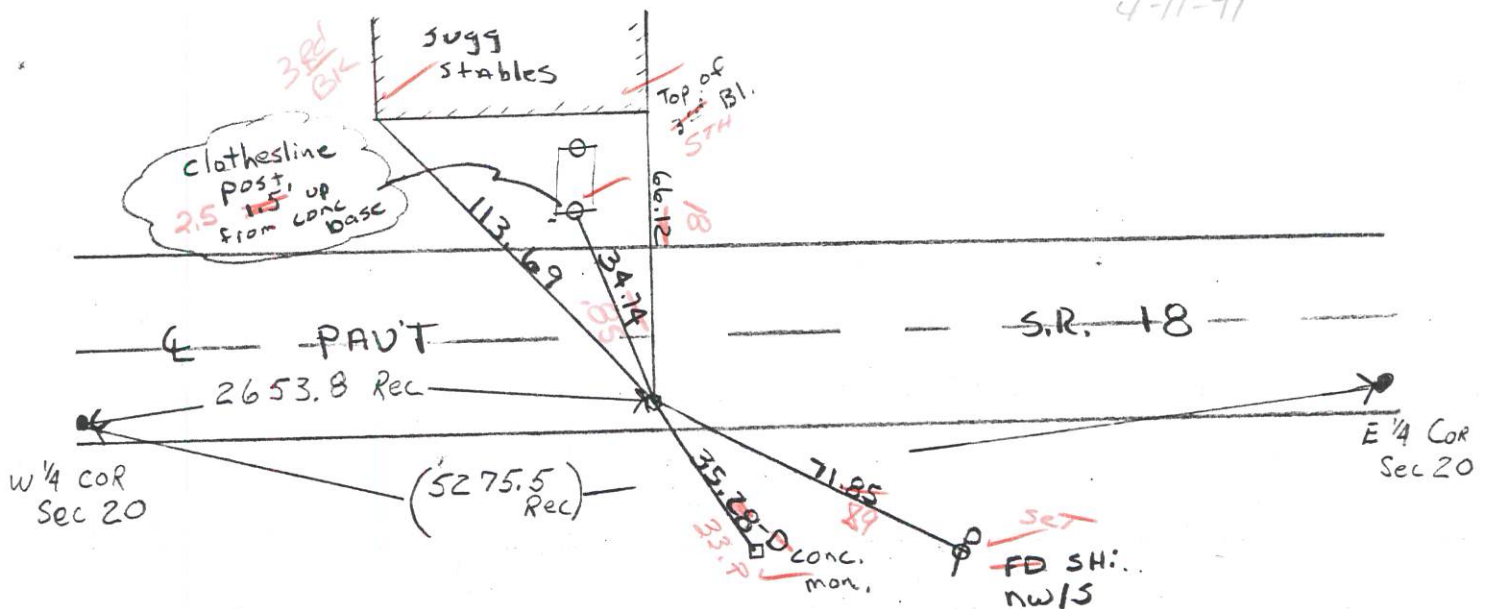

County WOOD S.R. 18Township JACKSONSection 20

T3N, R9E

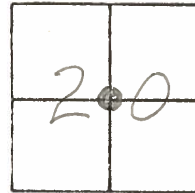Personnel BURNSIDESMITHBOWERSMEADDate 5-30-74Weather CLEARTemp. 80°

#5

MEAS.
5297.25'