

O.D.O.T. DISTRICT 2 SURVEY OFFICE (USE ONLY)

PERSONNEL

REFERENCE NO. 6

SHEET 6 OF 15

NOTES RHOADES

DATE 6-12-20

ROUTE SR 18

H.C. AUBLE

WEATHER SUNNY

COUNTY WOOD

R.C. MAHLER

TEMP. 66°F

TOWNSHIP JACKSON

O'DONNELL

SECTION 20

DWG BY MAHLER PID PAVE TRAIN

T 3 N R 9 E

TYPE MONUMENT MAG/WASHER

ON SURFACE - ~~BELOW~~ ON

OFFSET CL PAVEMENT 0.3' LT : RT

- TO - EDGE PAVEMENT


STATION: 108+86

HORIZ.DATUM: NAD83 (2011)


GEOID: NAVD88-2012A

GRID: NORTHING: 563140.467

EASTING: 1599181.257

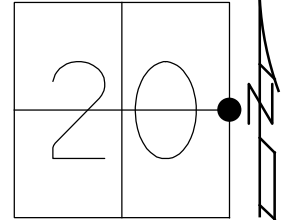

RECORD:
FD LG.R.R.SPIKE
3.5" DOWN
SET MAG/WASHER
7-25-05, DCH
REF5
9-04-15
FD MAG/WASHER
REF6
6-12-20
9-16-21, JFO

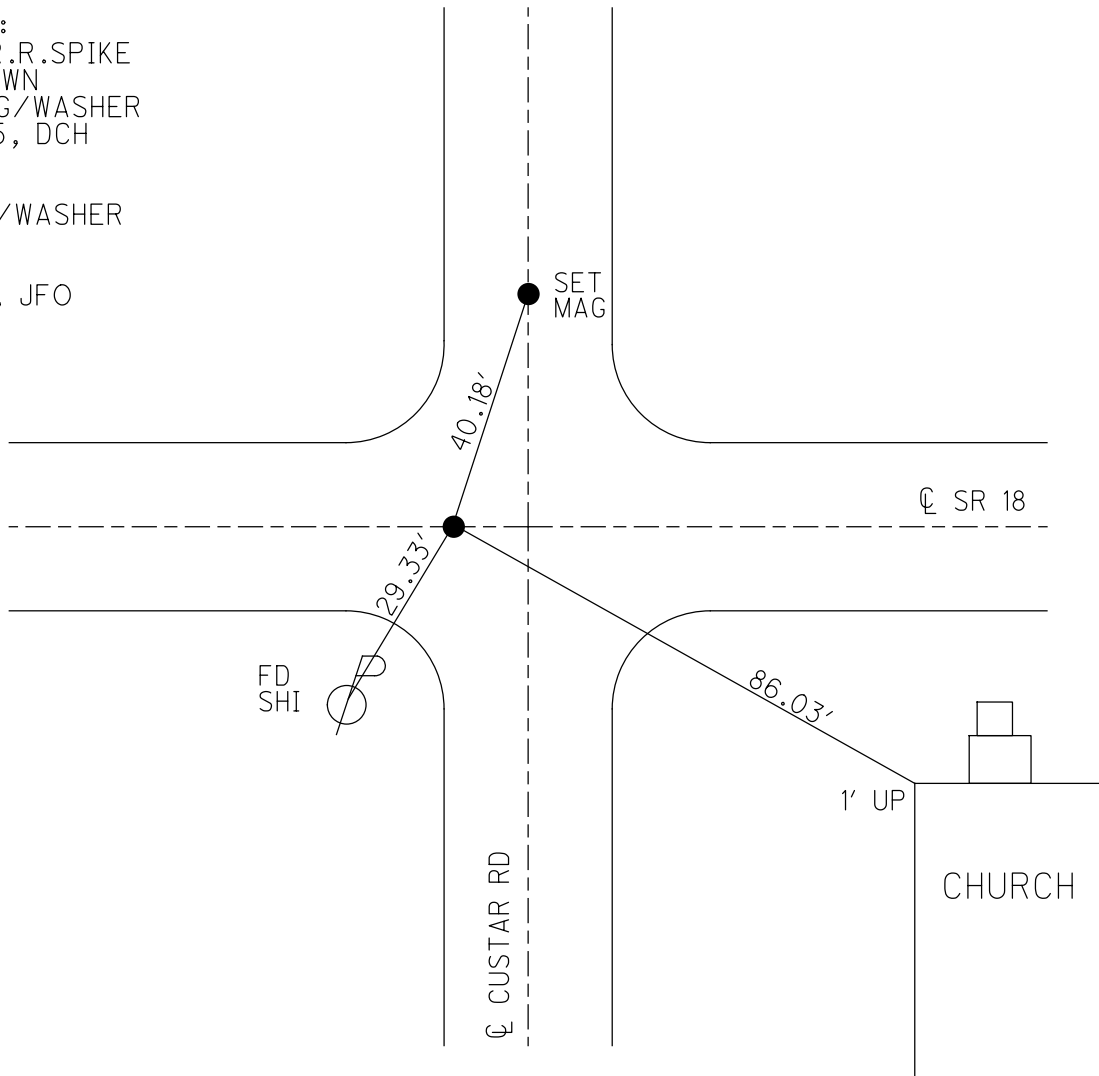

O.D.O.T. DISTRICT 2 SURVEY OFFICE (USE ONLY)

PERSONNEL

REFERENCE NO. 6

SHEET 6 OF 13

NOTES RHOADES

DATE 6-12-20

ROUTE SR 18

H.C. AUBLE

WEATHER SUNNY

COUNTY WOOD

R.C. MAHLER

TEMP. 66°F

TOWNSHIP JACKSON

O'DONNELL

SECTION 20

DWG BY MAHLER PID PAVE TRAIN

T 3 N R 9 E

TYPE MONUMENT MAG/WASHER

ON SURFACE - ~~BELOW~~ ON

OFFSET 0.3' ~~LT~~ : RT

- TO - EDGE PAVEMENT


STATION: 108+86

HORZ.DATUM: NAD83 (2011)


GEOID: NAVD88-2012A

GRID: NORTHING: 563140.467

EASTING: 1599181.257

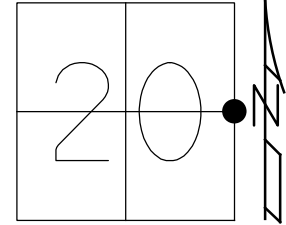

RECORD:
FD LG. RR. SPIKE
3.5" DOWN
SET MAG/WASHER
7-25-05, DCH
REF5
9-04-15
FD MAG/WASHER
REF6
6-12-20, JFO

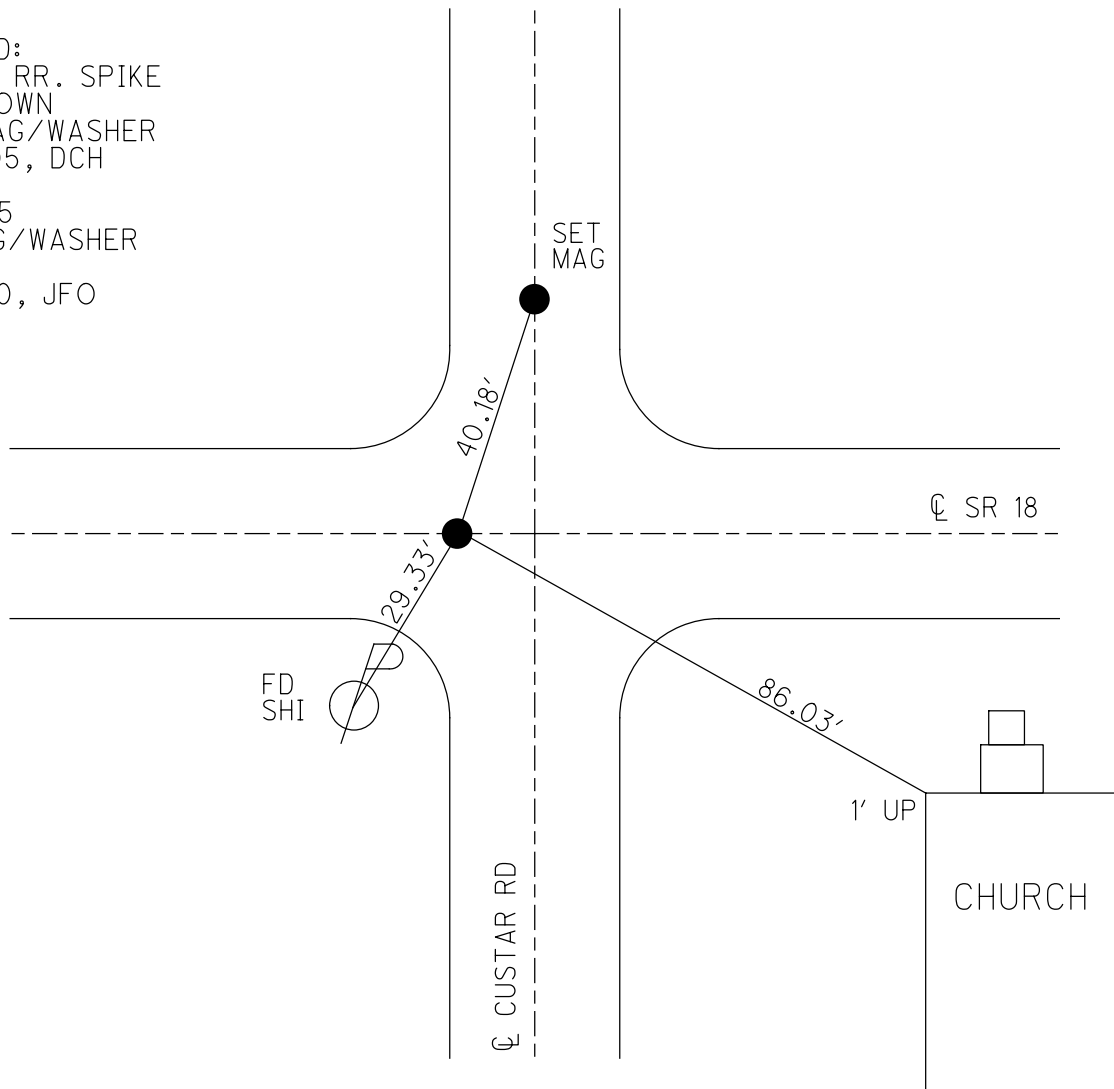


O.D.O.T. DISTRICT 2 SURVEY OFFICE (USE ONLY)

PERSONNEL _____ REFERENCE NO. 6 SHEET 6 OF 13
 NOTES _____ DATE 09-04-15 ROUTE SR 18
 H.C. LEU WEATHER PTLY CLOUDY COUNTY WOOD
 R.C. HOMAN TEMP. 78°F TOWNSHIP JACKSON
 _____ SECTION 20
 _____ T 3 N R 9 E

TYPE MONUMENT MAG/WASHER
 ON SURFACE - ~~BELOW~~ ON
~~LEFT~~ = Q PAV'T - RIGHT 0.3'
- TO - EDGE PAVEMENT
 S.L.M. 108+86


GRID: NORTHING: 563140.46 EASTING: 1599181.28

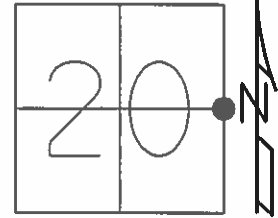

RECORD:
 FD LG. RR. SPK.
 3.5" DOWN

SET MAG/WASHER
 7-25-05, DCH

GPS, REF5
 09-04-15

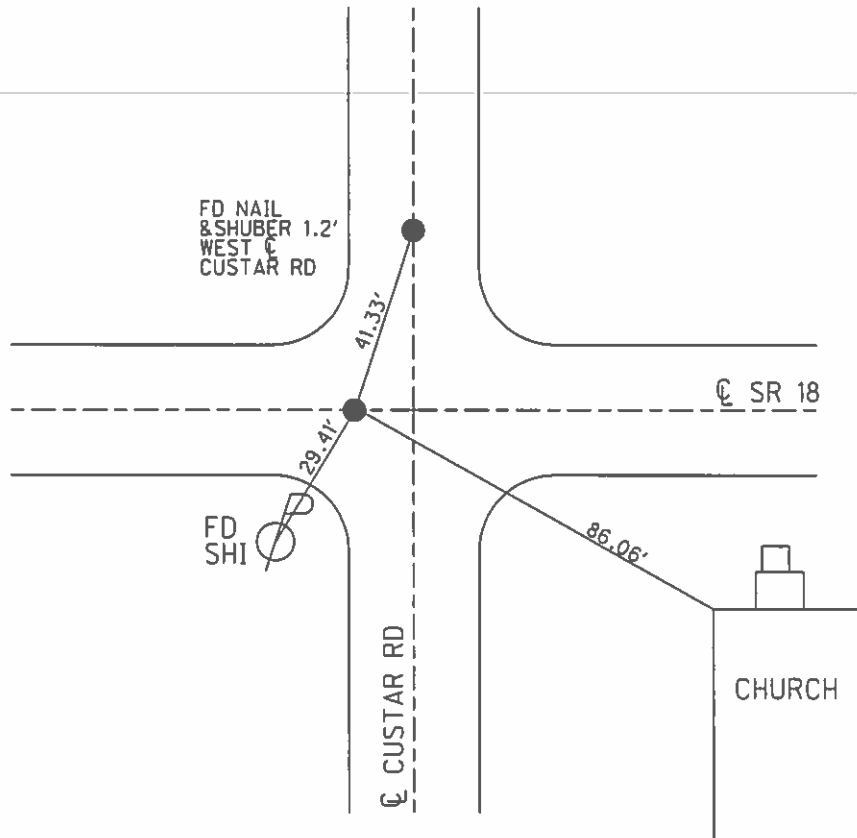

O.D.O.T. DISTRICT 2 SURVEY OFFICE

PERSONNEL

NOTES _____ STEVE
H.C. _____ DUANE
R.C. _____ JOE


REFERENCE NO. 6

DATE 4-11-05
WEATHER CLOUDY
TEMP. 58°

SHEET 5 OF 14


ROUTE S.R. 18
COUNTY WOOD
TOWNSHIP JACKSON
SECTION 20
T 3 N R 9 E

TYPE MONUMENT _____ PK & WASHER
ON SURFACE - ~~BELOW~~ _____ ON
LEFT - ~~C PAVT~~ - RIGHT _____ 0.3'
_____ TO _____ EDGE PAVEMENT
S.L.M. _____ 108+86

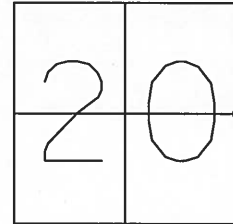

RESET MAG & WASHER
7-25-05
DCH

FD LARGE RR SPIKE
3 1/2" DOWN

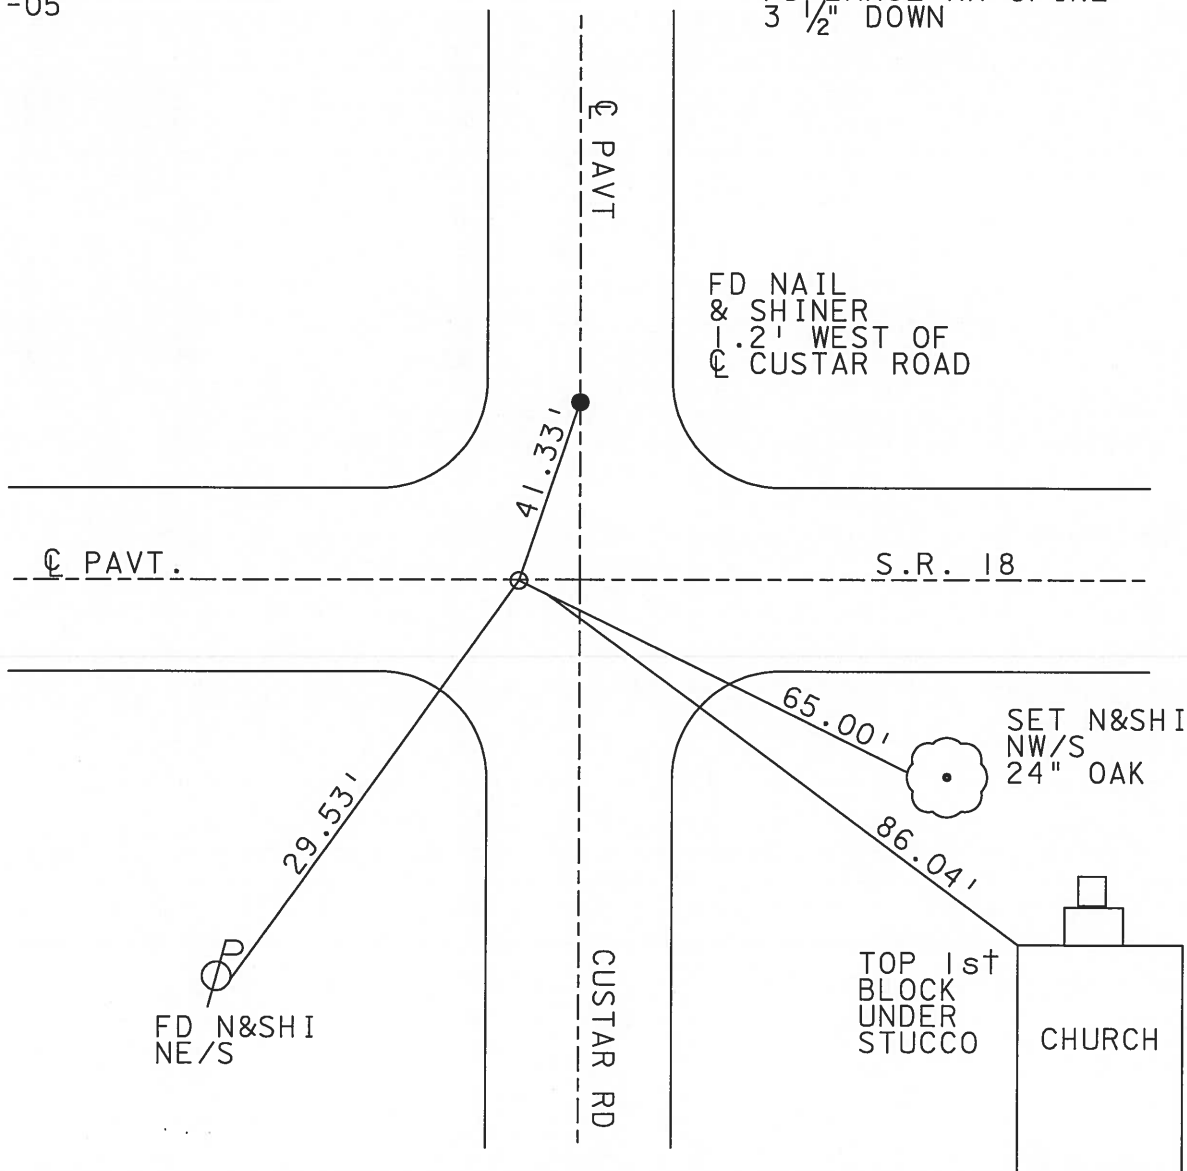

O.D.O.T. DISTRICT 2 SURVEY OFFICE

PERSONNEL

REFERENCE NO. 6

SHEET OF

NOTES BARNHISEL

H.C. Locheke

R.C. HOFFMAN

DATE 3-19-91

WEATHER cloudy - windy

TEMP. +45°

ROUTE 18

COUNTY WOOD

TOWNSHIP JACKSON

SECTION 20

T 3 N R 9 E


TYPE MONUMENT P.K. & Washer

ON SURFACE - BELOW yes


LEFT- & PAV'T. - RIGHT 0.6


TO EDGE PAVEMENT

S.L.M. 108+63

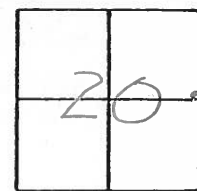

Set P.K. & Washer
4-17-91
mB

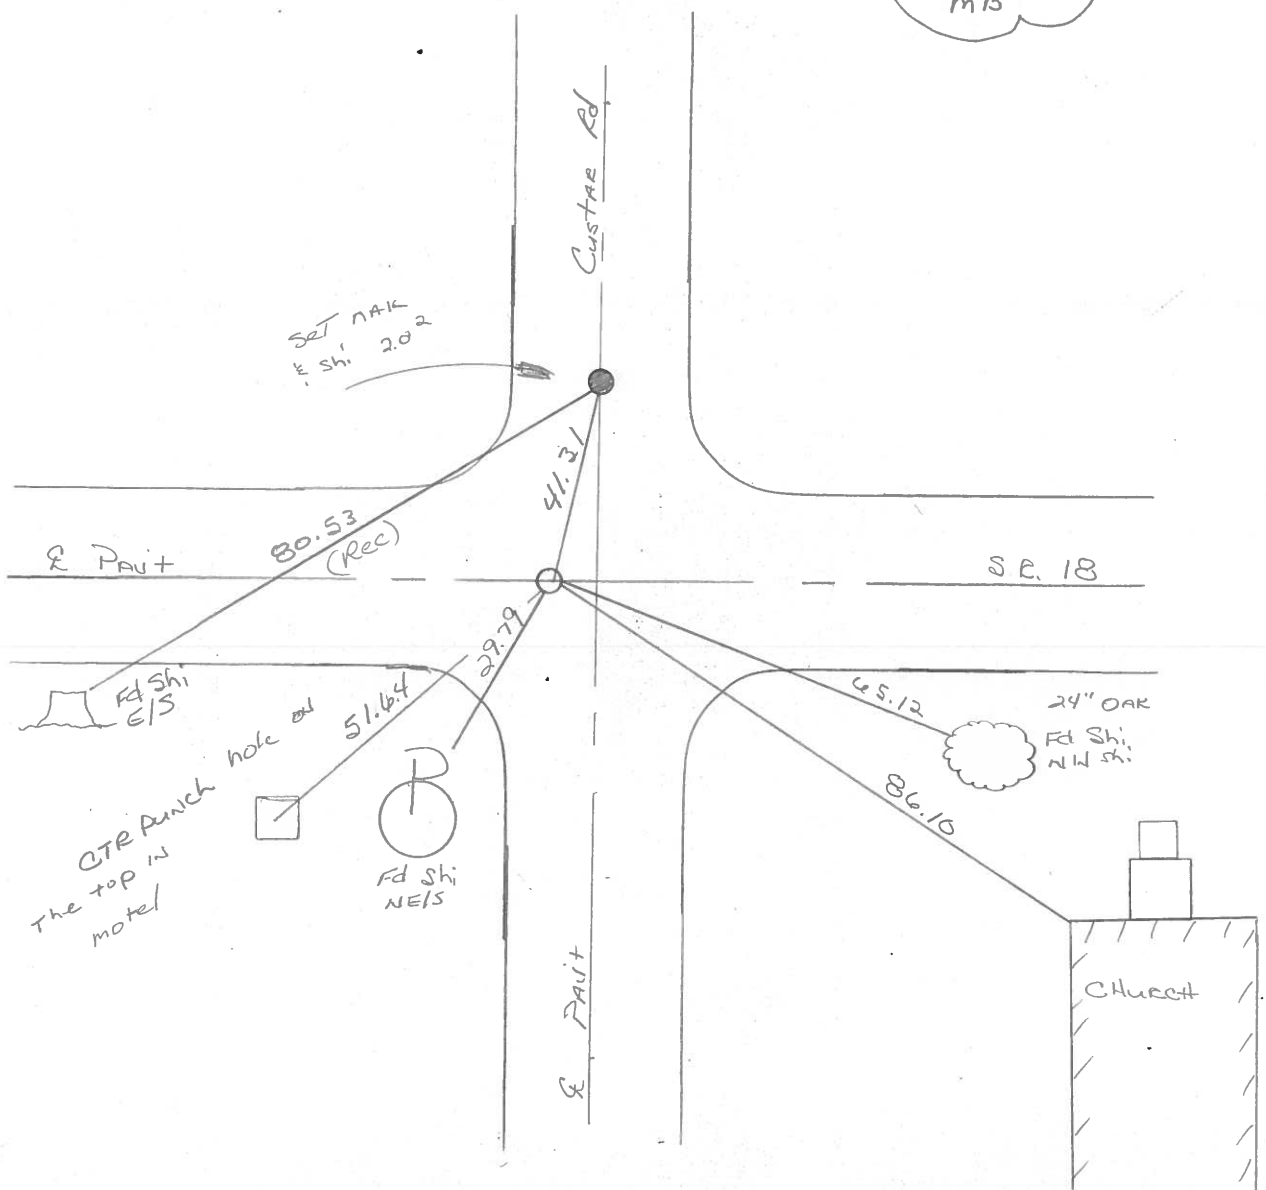

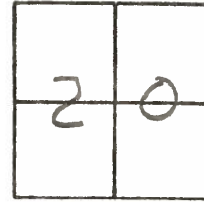County WOOD S.R. 18Township JACKSONSection 20T3N, R9EPersonnel Householder R.CLoehcke ☒Barnhiser HCDate 11-25-83Weather clear, windyTemp. +32°

FD Lg R.R. SPIKE @ SURFACE

0.6' Lt & S.R. 18,

10' W. of S. Custer RD


S.L.M. 108+63

#6

SET PK + WASHER


7-25-85

C.L

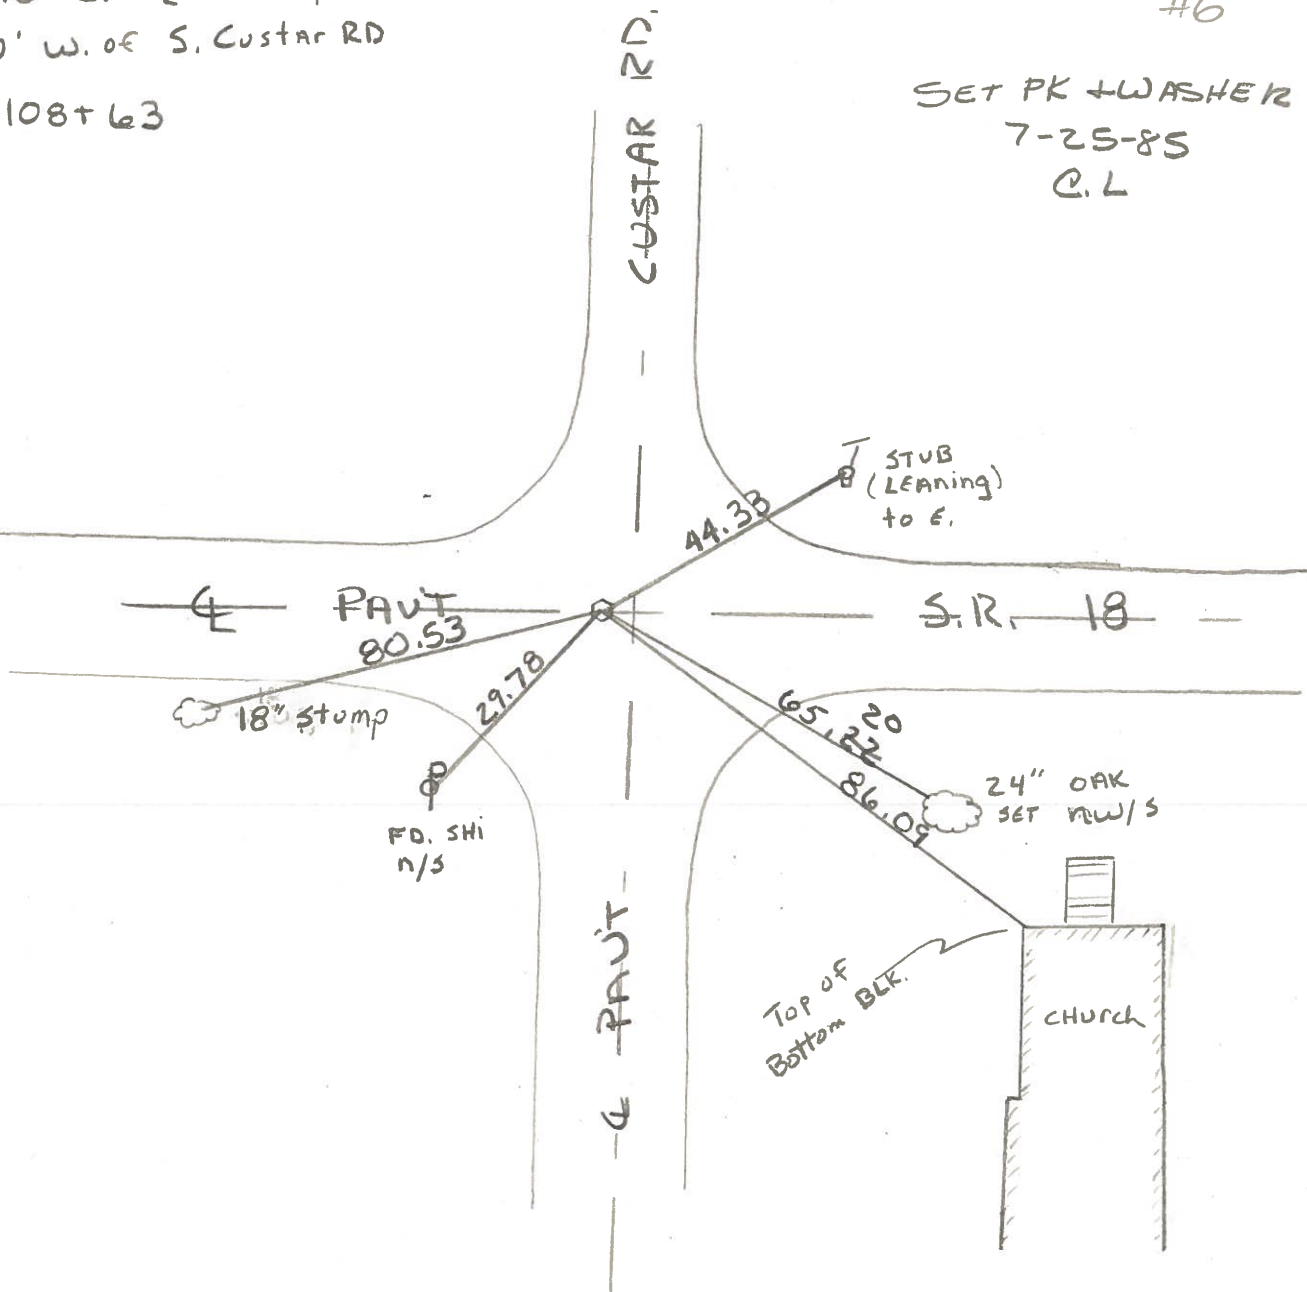

County WOOD S.R. 18Township JACKSONSection 20

T3N, R9E

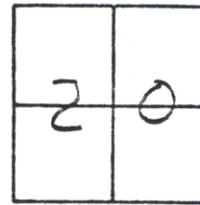Personnel Hauschalter R.CLoehckeBarnhiser HCDate 11-25-83Weather clear, windyTemp. +32°

FD Lg R.R. SPIKE @ SURFACE

0.6' Lt & S.R. 18,10' W. of S. Custer RD

S.L.M. 108+63

#6


SET PK + WASHER

7-25-85

C.L

Set PK/Washer

4-11-91

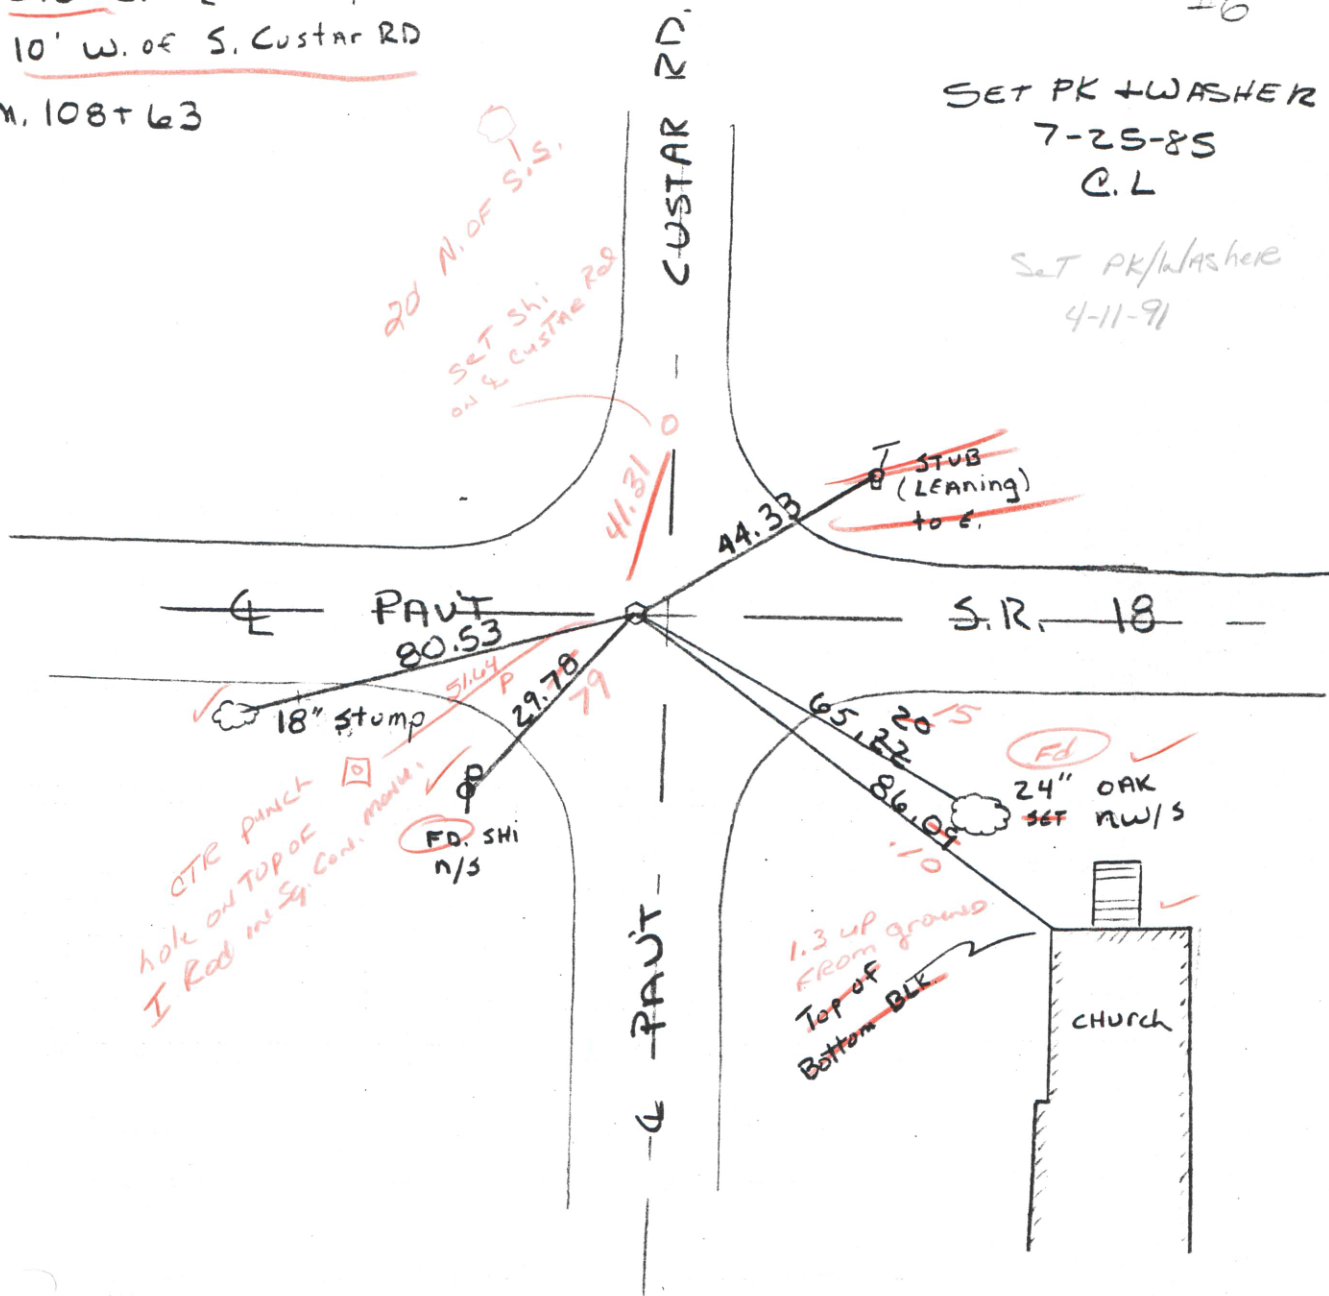

Q.D.O.T. DISTRICT 2 SURVEY OFFICE

SHEET 6 OF

County WOOD S.R. 18

Date 6-17-74

Township JACKSON

Weather Pt. Cloudy

Section 20

Temp. 62°

T3N, R9E


Personnel BURNSIDE

SMITH


BOWERS

KIOWSKI

MEAD

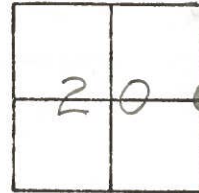

#6

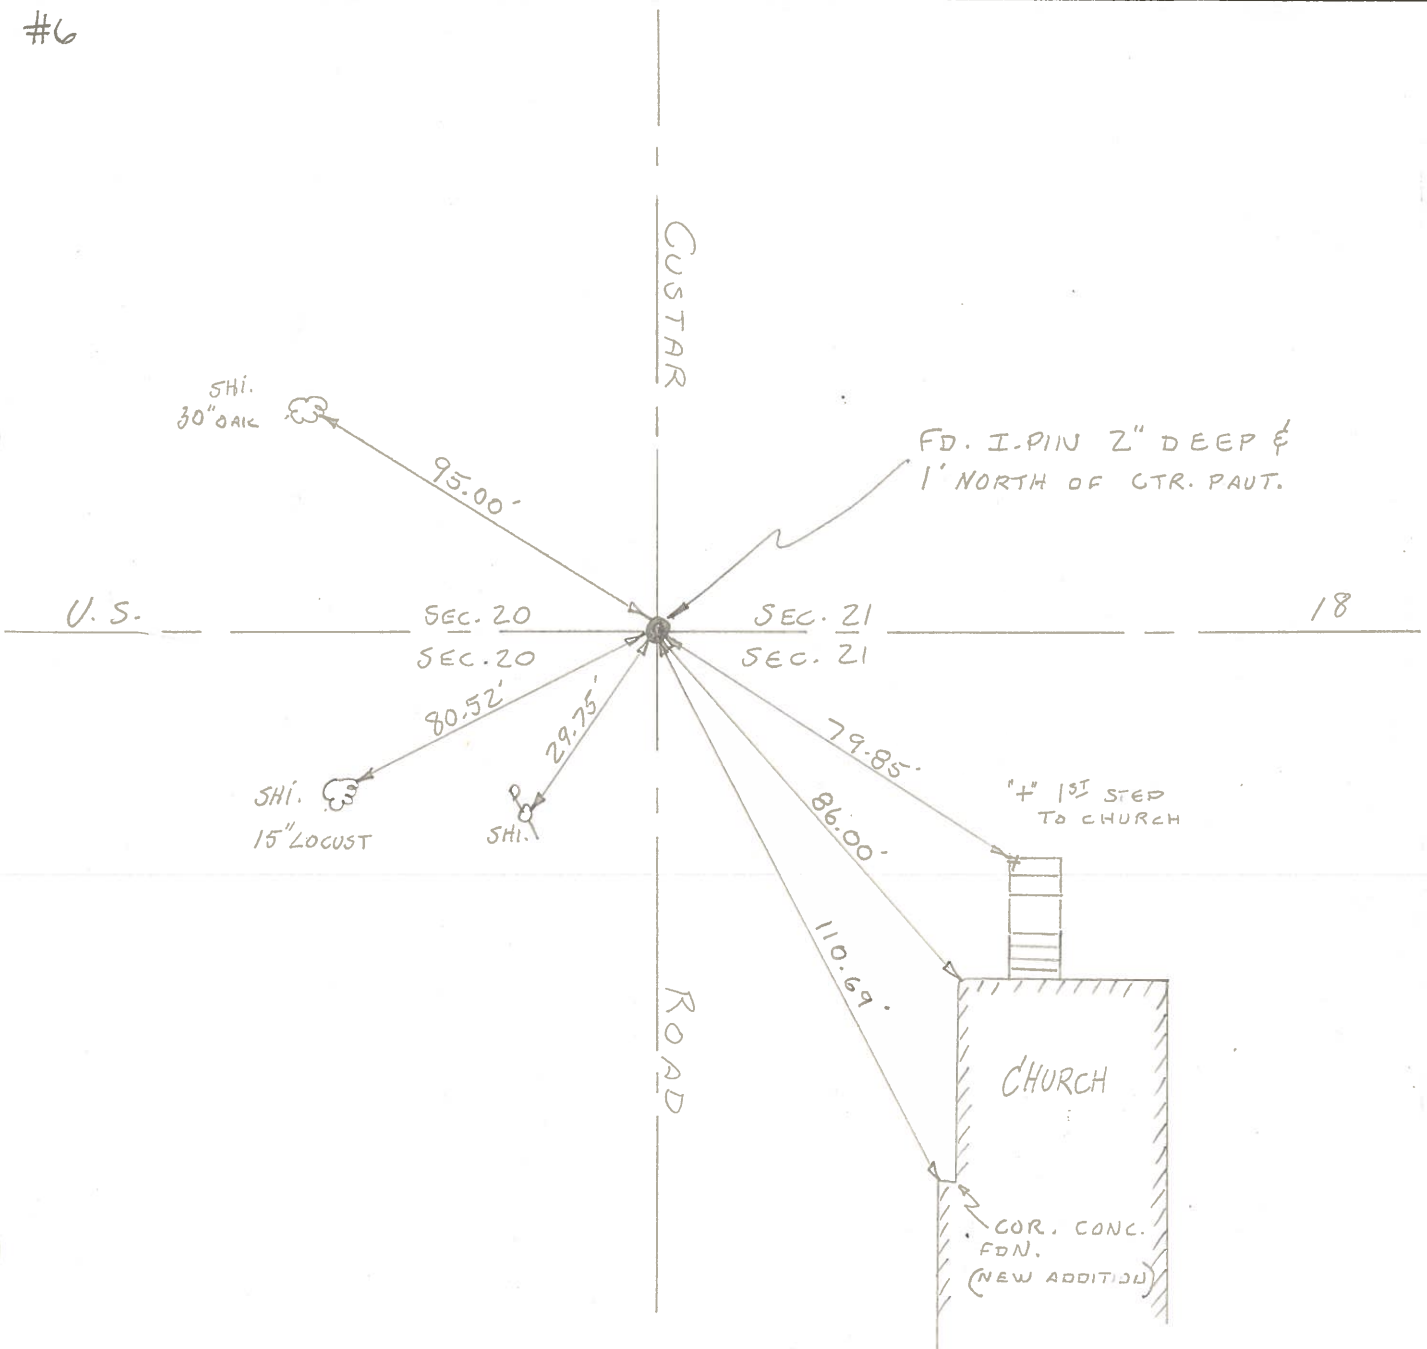

PERSONNEL	TITLE	PERSONNEL	TITLE
BURNSIDE.			
SMITH			
BOWERS			
HOLCOMBE			

COUNTY WOOD DATE 12-28-70

S. R. #18 WEATHER CLEAR

SEC. HENRY CO. LINE EAST TEMP. +26°

DESCRIPTION _____ LEFT _____ CENTER LINE _____ RIGHT _____ JOB NO. _____

