

O.D.O.T. DISTRICT 2 SURVEY OFFICE (USE ONLY)

PERSONNEL

REFERENCE NO. 7

SHEET 7 OF 15

NOTES RHOADES

DATE 6-12-20

ROUTE SR 18

H.C. AUBLE

WEATHER SUNNY

COUNTY WOOD

R.C. MAHLER

TEMP. 66°F

TOWNSHIP JACKSON

O'DONNELL

SECTION 21

DWG BY MAHLER

PID PAVE TRAIN

T 3 N R 9 E

TYPE MONUMENT MAG/WASHER

ON SURFACE - ~~BELOW~~ ON

OFFSET CL PAVEMENT 11.4" ~~LT~~ : RT

0.7' TO RT EDGE PAVEMENT



STATION: 135+39

HORZ.DATUM: NAD83 (2011)

GEOID: NAVD88-2012A

GRID: NORTHING: 563094.399

EASTING: 1601844.840

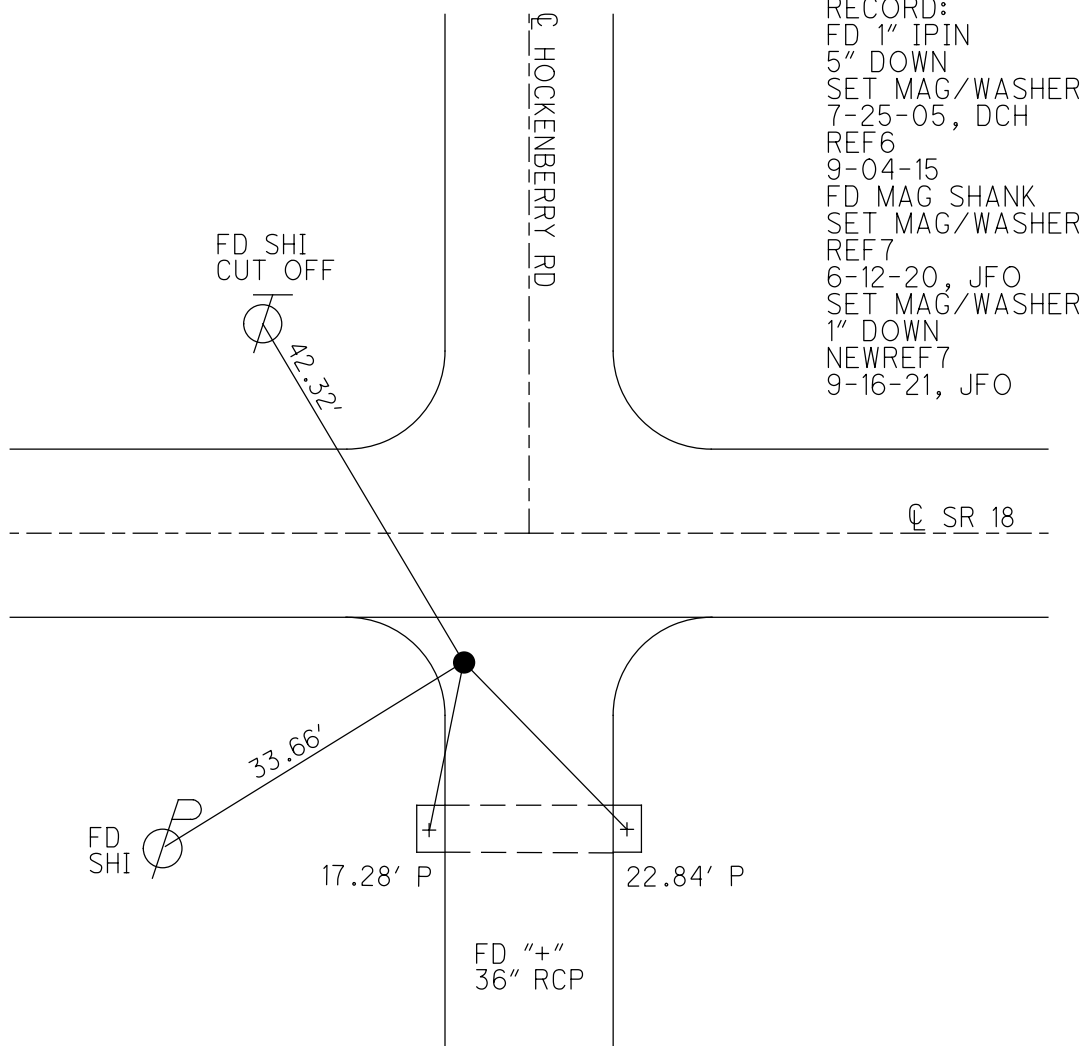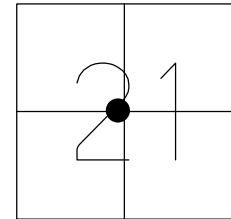

O.D.O.T. DISTRICT 2 SURVEY OFFICE (USE ONLY)

PERSONNEL

REFERENCE NO. 7

SHEET 7 OF 13

NOTES RHOADES  
H.C. AUBLE  
R.C. MAHLER  
O'DONNELL

DATE 6-12-20  
WEATHER SUNNY  
TEMP. 66°F

ROUTE SR 18  
COUNTY WOOD  
TOWNSHIP JACKSON  
SECTION 21  
T 3 N R 9 E

DWG BY MAHLER PID PAVE TRAIN

TYPE MONUMENT MAG/WASHER

ON SURFACE - ~~BELOW~~ ON

OFFSET 11.4" LT : RT

- TO - EDGE PAVEMENT


STATION: 135+39

HORZ.DATUM: NAD83 (2011)


GEOID: NAVD88-2012A

GRID: NORTHING: 563094.426

EASTING: 1601844.814

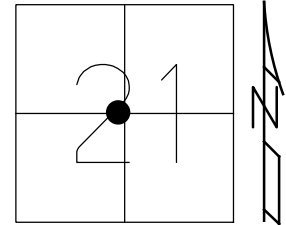

RECORD:  
FD 1" IRON PIN  
5" DOWN  
SET MAG/WASHER  
7-25-05, DCH  
REF6  
9-04-15  
FD MAG SHANK  
SET MAG/WASHER  
REF7  
6-12-20, JFO

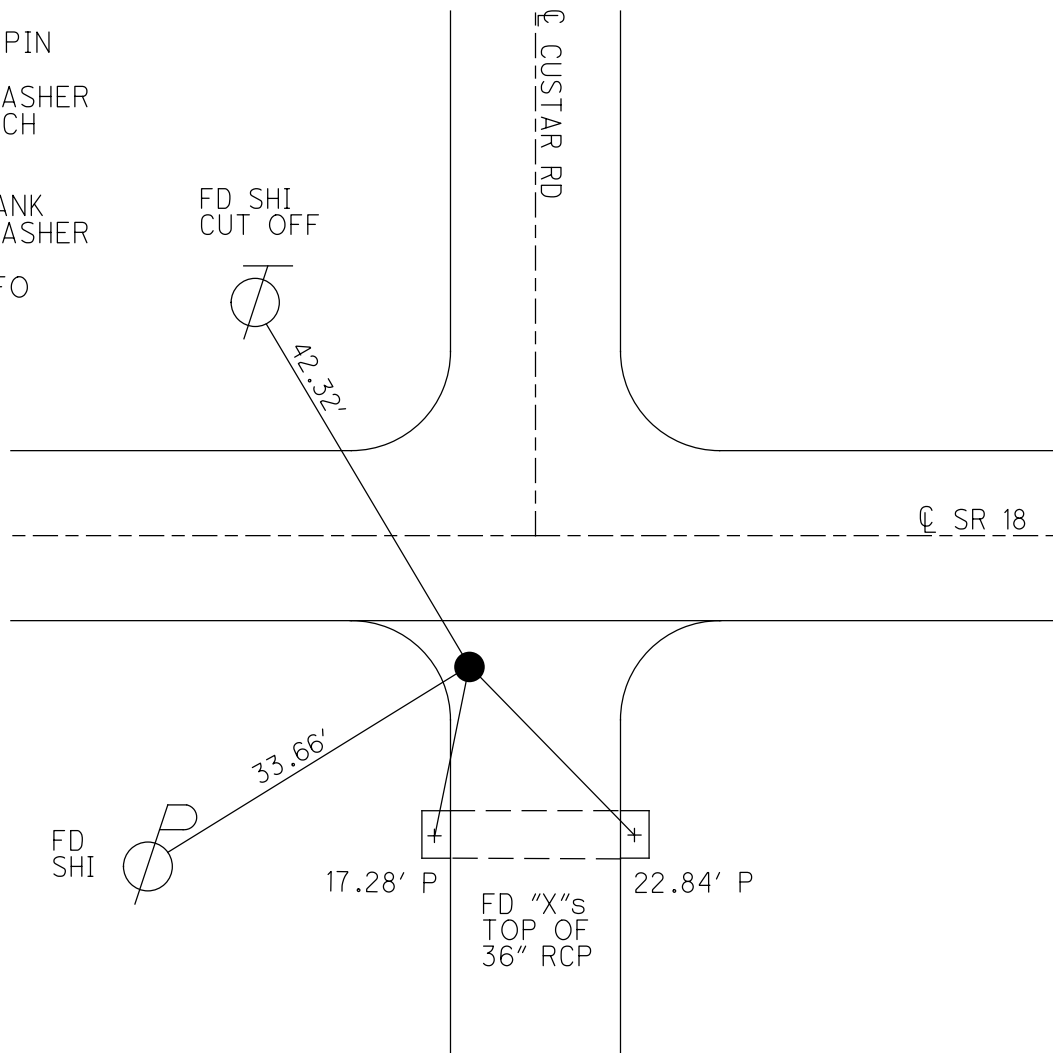


# O.D.O.T. DISTRICT 2 SURVEY OFFICE (USE ONLY)

PERSONNEL \_\_\_\_\_ REFERENCE NO. 7 SHEET 7 OF 13  
 NOTES LEU DATE 09-04-15 ROUTE SR 18  
 H.C. HOMAN WEATHER PTLY CLOUDY COUNTY WOOD  
 R.C. LEU TEMP. 78°F TOWNSHIP JACKSON  
 SECTION 21  
 T 3 N R 9 E

TYPE MONUMENT MAG/WASHER  
 ON SURFACE - ~~BELOW~~ ON  
~~LEFT~~ Q PAV'T - RIGHT 11.4'  
- TO - EDGE PAVEMENT  
 S.L.M. 135+39


GRID: NORTHING: 563094.37 EASTING: 1601844.81

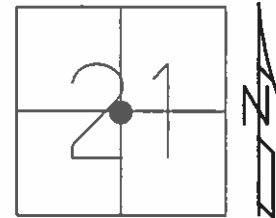

RECORD:  
 FD 1" IRON PIN  
 5" DOWN

SET MAG/WASHER  
 7-25-05, DCH

GPS, REF6  
 09-04-15

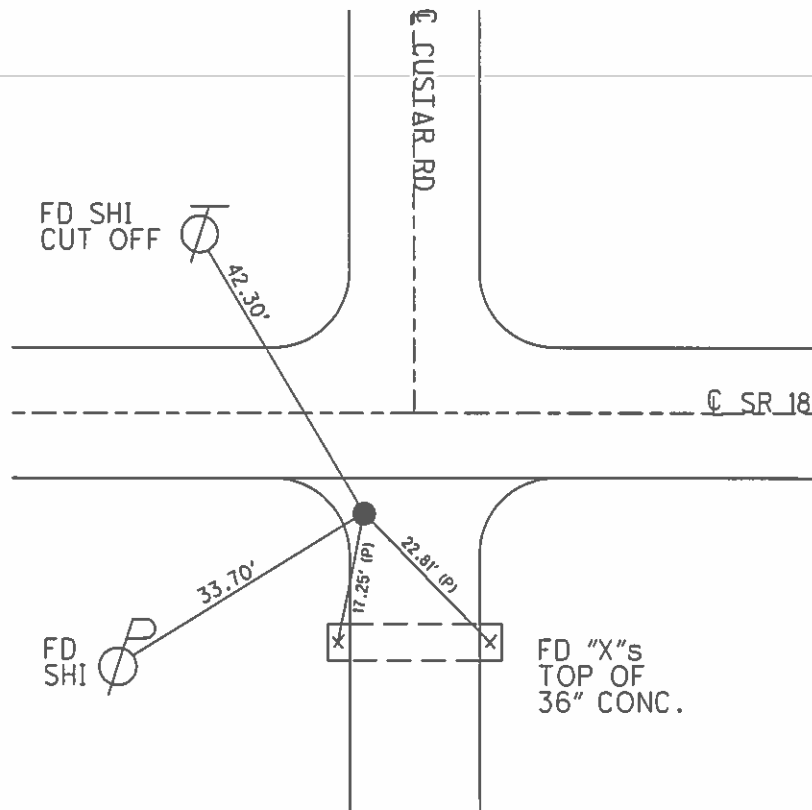

O.D.O.T. DISTRICT 2 SURVEY OFFICE

PERSONNEL

REFERENCE NO. 7

SHEET 6 OF 14

NOTES DUANE

DATE 4-08-05

ROUTE S.R. 18

H.C. STEVE

WEATHER SUNNY

COUNTY WOOD

R.C. JOE

TEMP. 60°

TOWNSHIP JACKSON

SECTION 21

T3 N R9 E


TYPE MONUMENT PK & WASHER

ON SURFACE - BELOW ON

LEFT - Q PAV'T - RIGHT 11.4'

TO EDGE PAVEMENT

S.L.M. 135+39

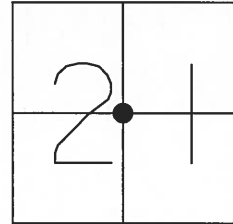

RESET MAG & WASHER  
7-25-05  
DCH

SET SHI  
S/S OF  
MAIL BOX POST

[MB]

74.86'

FD SHI  
E/S

42.30'

HOCKENBERRY RD  
Q PAVT

51.74'

SET NAIL & SHI  
2.5' WEST OF EAST  
EDGE OF PAVEMENT  
OPPOSITE OF STOP SIGN

FD 1" iron pin  
5" DOWN

Q PAVT.

S.R. 18

FD SHI  
NE/S



33.81'

FD "X"  
TOP OF  
36" CONC

17.46'

22.74'

FD "X"  
TOP OF  
36" CONC

# O.D.O.T. DISTRICT 2 SURVEY OFFICE

PERSONNEL

REFERENCE NO. 7

SHEET      OF     

NOTES BARNHISEL

H.C. Loehrke

R.C. HOFFMAN

DATE 3-19-91

WEATHER cloudy - WINDY

TEMP. +45°

ROUTE 18

COUNTY WOODS

TOWNSHIP JACKSON

SECTION 21

T 3 N R 9 E


TYPE MONUMENT Sm RR Spk

ON SURFACE - BELOW YES


LEFT - PAV'T. - RIGHT 11.4

1.8 RT OF ET TO EDGE PAVEMENT

S.L.M. 135+39

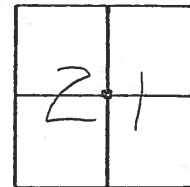

Set P.K. / Washer  
4-17-91  
mB

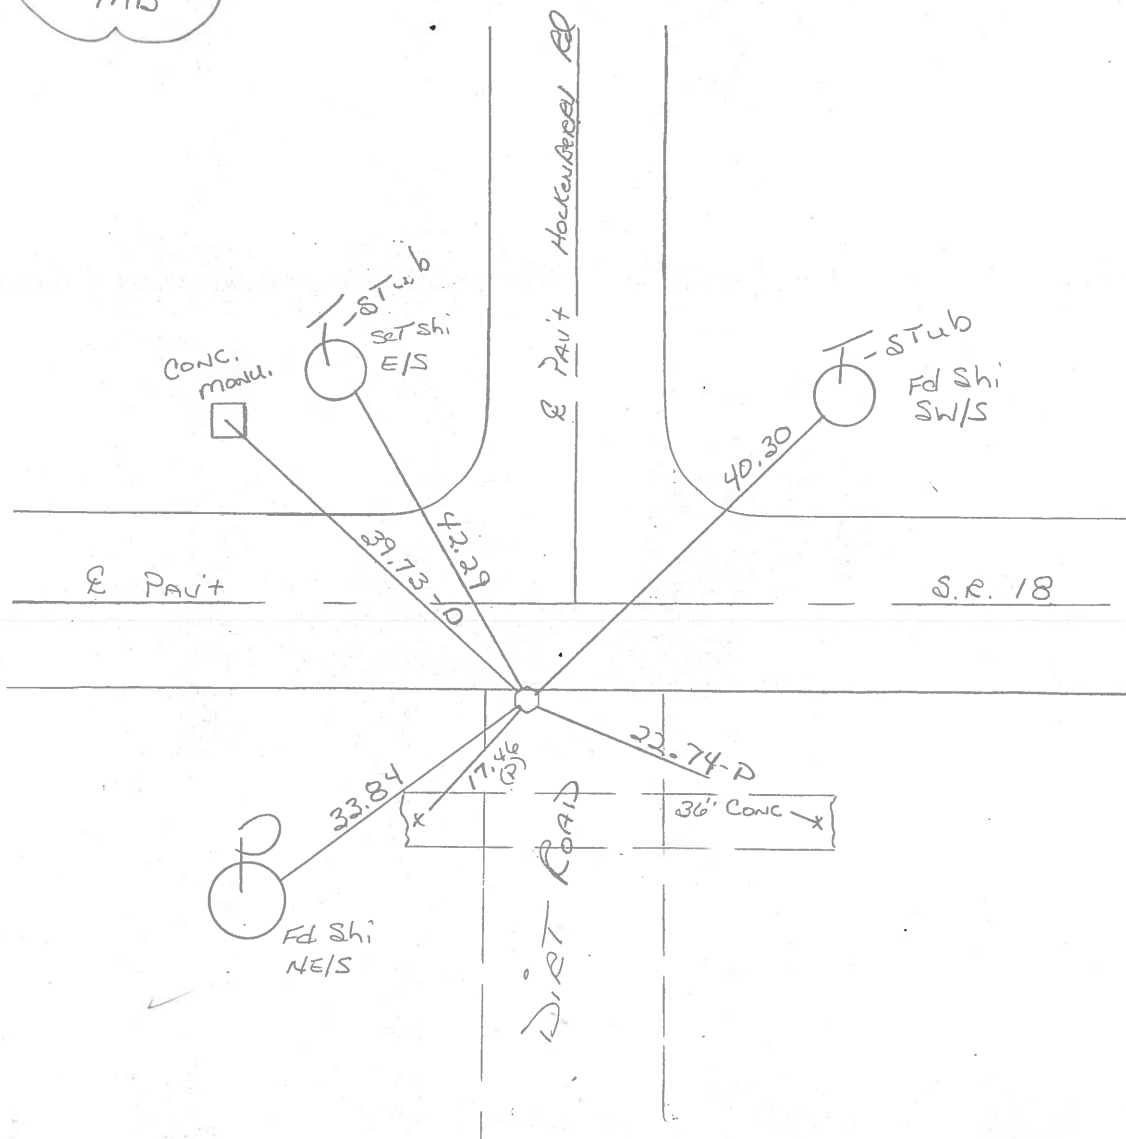

Date 11-25-83

Weather clear, windy

Temp. + 32°

N  
A

SET Sm R.R SPIKE


7-25-85 #7

C.L.

SLM 135+26


6.0 W of Q HOCKENBERRY Rd

3.0 Rt of SEP SR18

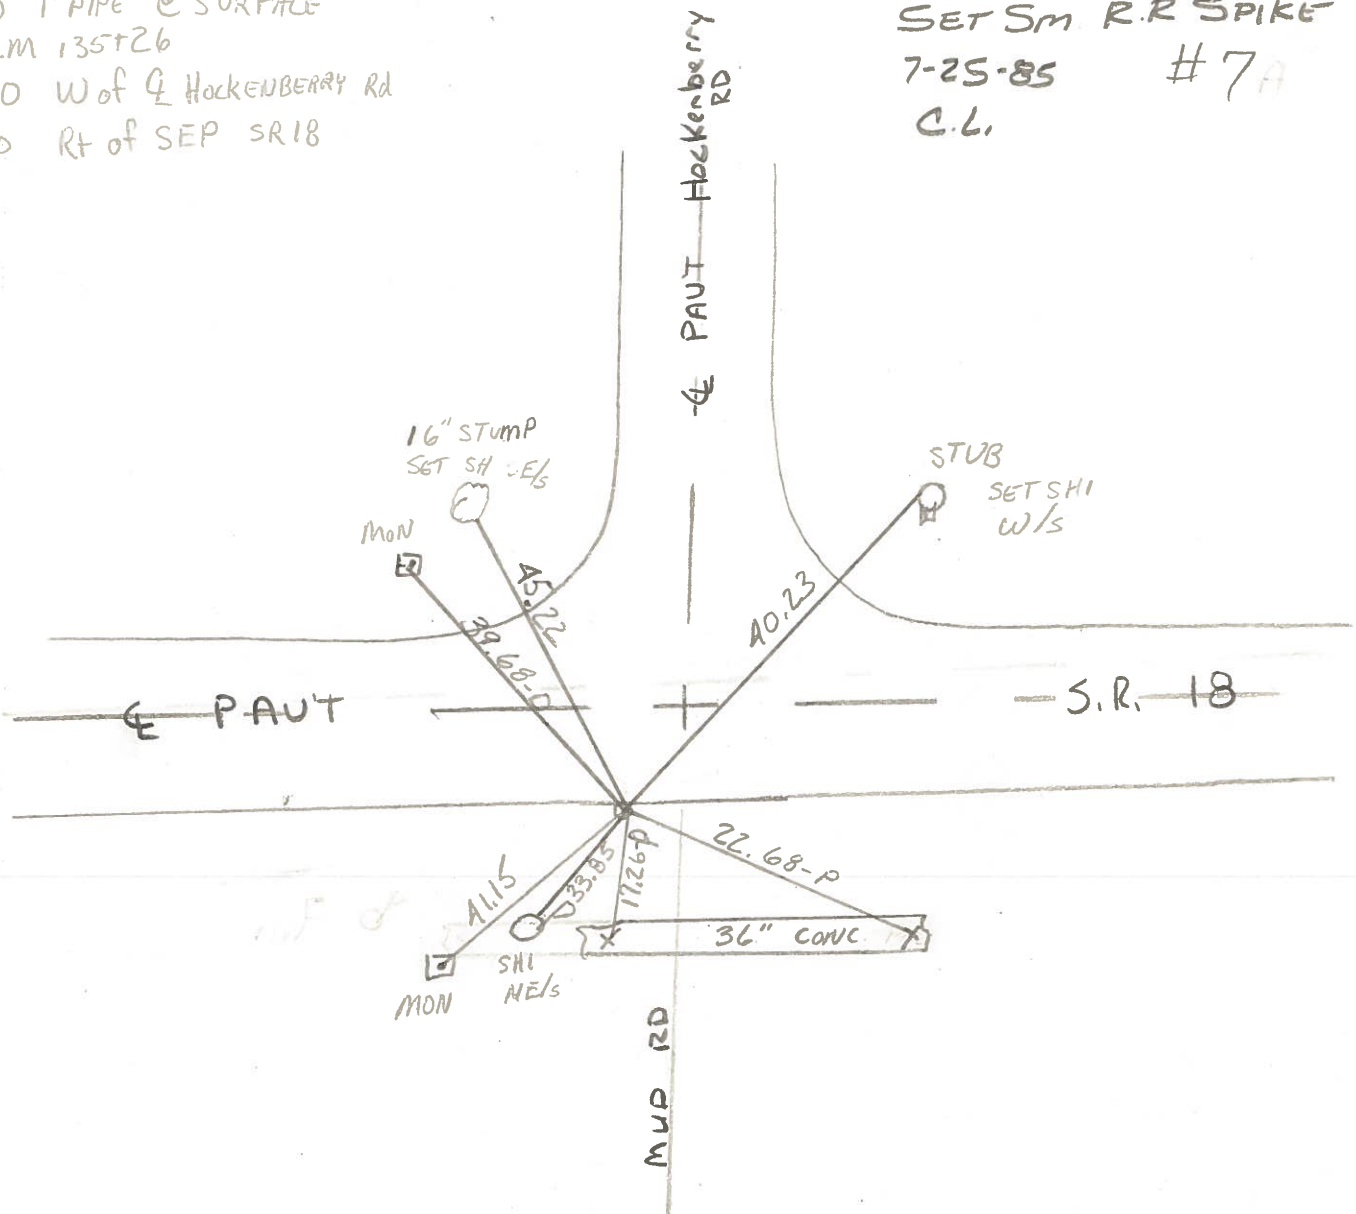

County WOOD S.R. 18Date 11-25-83Township JACKSONWeather clear, windySection 21Temp. + 32°

T3N, R9E

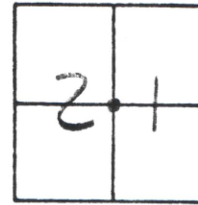Personnel Loehake Householder HCBarnhiser RC

FD 1" PIPE @ SURFACE

SLIM 135+26

6.0 W of C Hockenberry RD

3.0 RT of C&amp;P SR 18

SET SM R.R SPIKE

7-25-85

#7

C.L.


Set P/W/flash here  
4-11-91

135+39

118.4 RT E

1.8 RT OF RT EOP

6.0 west E N

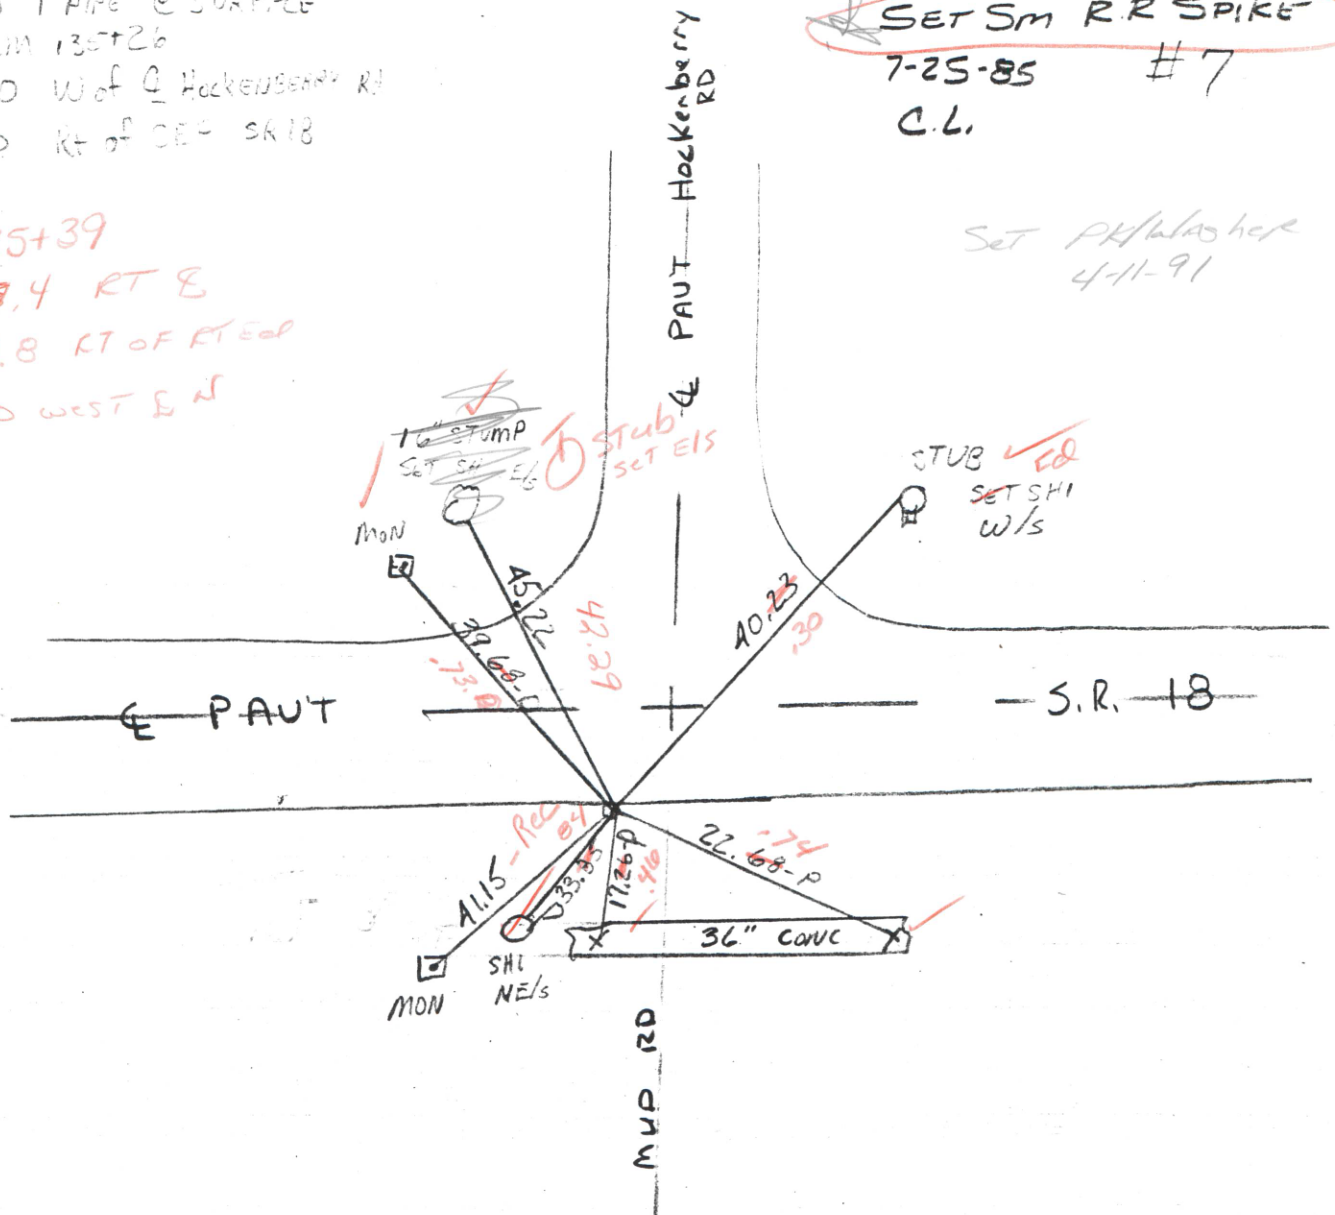

# O.D.O.T. DISTRICT 2 SURVEY OFFICE

SHEET 7 OF

County WOOD S.R. 18

Date 6-17-74

Township JACKSON

Weather CLOUDY

Section 21

Temp. 60°

T3N, R9E


Personnel BURNSIDE

SMITH


BOINERS

MEAD

KIJOWSKI

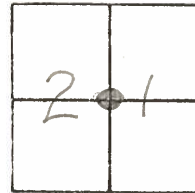

#7

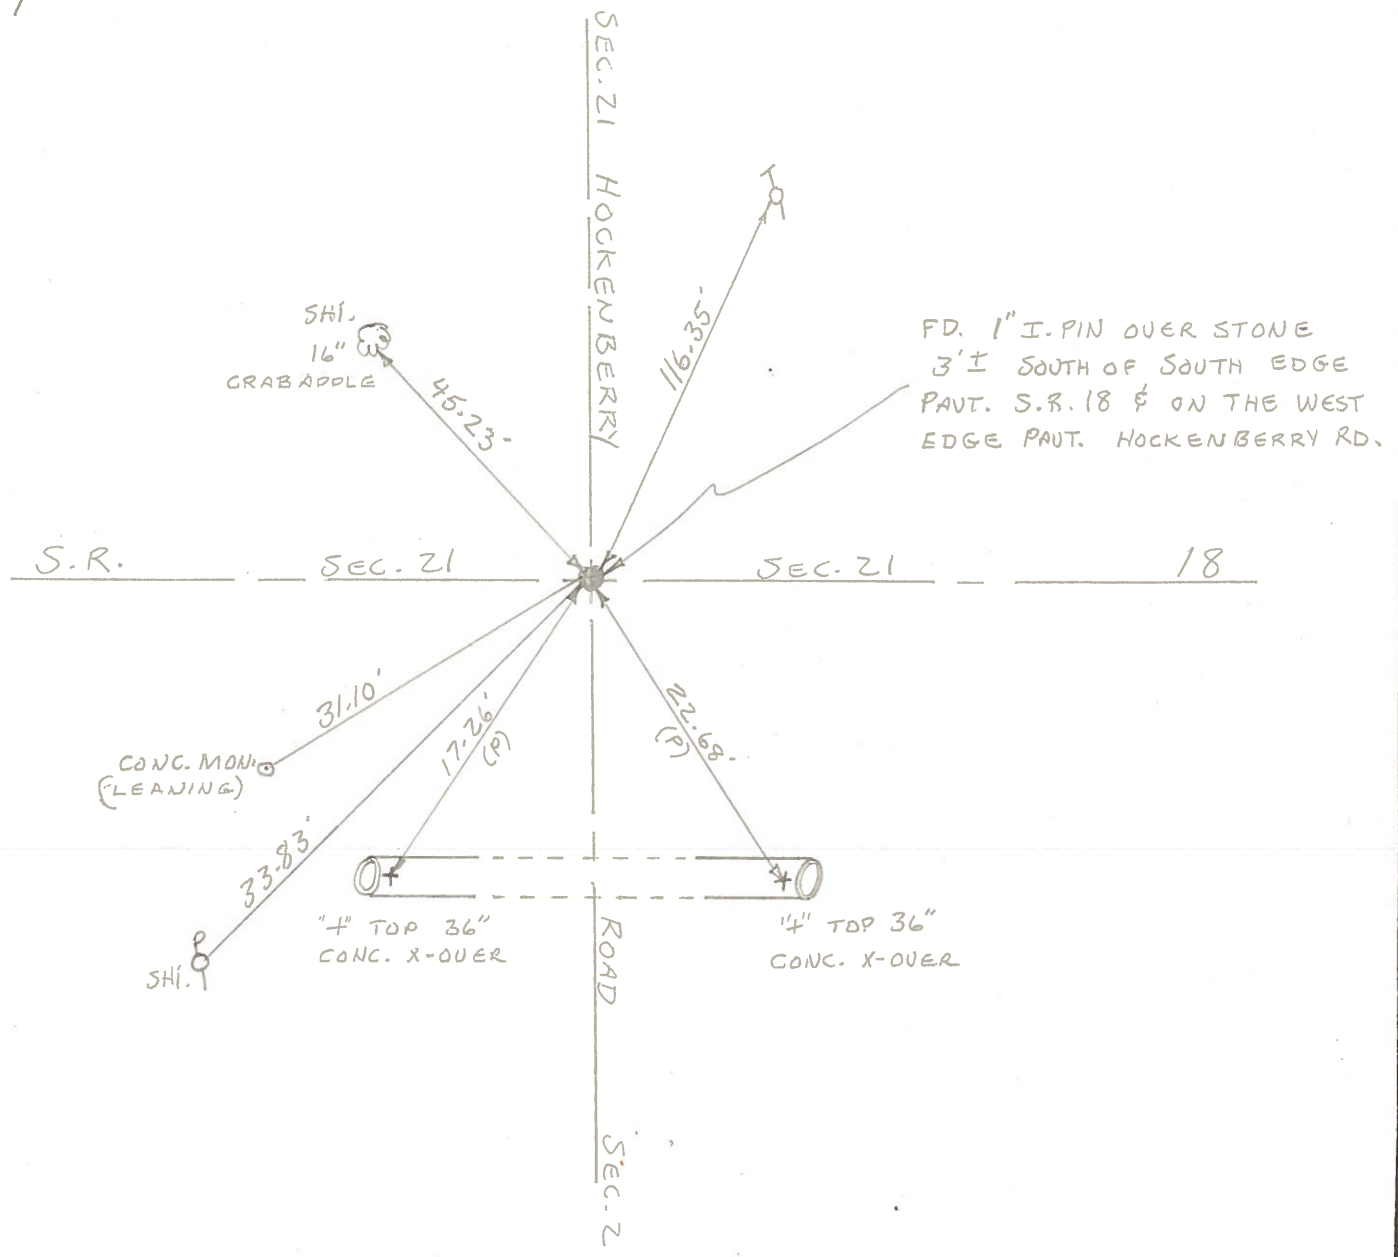

PERSONNEL TITLE PERSONNEL TITLE

COUNTY WOODDATE 12-28-70S. R. #18WEATHER CLEARSEC. HEN. CO. LINE EASTTEMP. +26°

DESCRIPTION

LEFT

CENTER LINE

RIGHT

JOB NO.

80 Rods W. of E.  
 1/4 Post SEC. 21  
 JACKSON TWP.  
 PRAIRIE VIEW RD.  
 "DID NOT FIND"

CONC. MON. S.E. 31.20'

INTERIOR 1/4 Post SEC. 21  
 JACKSON TWP.

7  
 F.D. I. PIN - 2.8' S. OF  
 S. EDGE PAVE.

HOCKENBERRY

ROAD

SHI.  
 20' CRABAPPLE

45.27'

31.92' CONC. MON.

31.17'  
 29.84'

CONC. MON.



PERSONNEL TITLE PERSONNEL TITLE PERSONNEL TITLE  
 DATE DATE DATE  
 COUNTY Wood  
 S. R. 18  
 WEATHER  
 TEMP.

DESCRIPTION ON JOB NO. LEFT CENTER LINE RIGHT JOB NO. (1960)

Stone - 80 rods W. of E.  
 1/4 post sec. 21 Jackson  
 Twp. Prairie View Rd. Did Not Find  
 #107

E. 1/4 post sec. 21 Jackson  
 Twp. Found R.R. Spk.  
 Milton Rd.  
 #108

80- rods W. of Int. 1/4  
 post sec. 22 Jackson  
 Twp. - Stone  
 #109 Did Not Find

Stone - Int 1/4 post sec.  
 22 Jackson Twp. Sands Rd.  
 Did Not Find  
 (See #)  
 #110  
 \* Found P.K. Nail

E. 1/4 post sec. 22  
 Jackson Twp. Milton Rd.  
 R.R. Spk. over stone  
 Found Bolt.  
 #111