

O.D.O.T. DISTRICT 2 SURVEY OFFICE (USE ONLY)

PERSONNEL

REFERENCE NO. 7 A

SHEET 8 OF 15

NOTES RHOADES

DATE 6-12-20

ROUTE SR 18

H.C. AUBLE

WEATHER SUNNY

COUNTY WOOD

R.C. MAHLER

TEMP. 66°F

TOWNSHIP JACKSON

O'DONNELL

SECTION 21

DWG BY MAHLER

PID PAVE TRAIN

T 3 N R 9 E

TYPE MONUMENT MAG/WASHER

ON SURFACE - ~~BELOW~~ ON

OFFSET CL PAVEMENT 8.4' LT : RT

1.1' TO RT EDGE PAVEMENT



STATION: 148+80

HORIZ.DATUM: NAD83 (2011)

GEOID: NAVD88-2012A

GRID: NORTHING: 563070.560

EASTING: 1603182.738

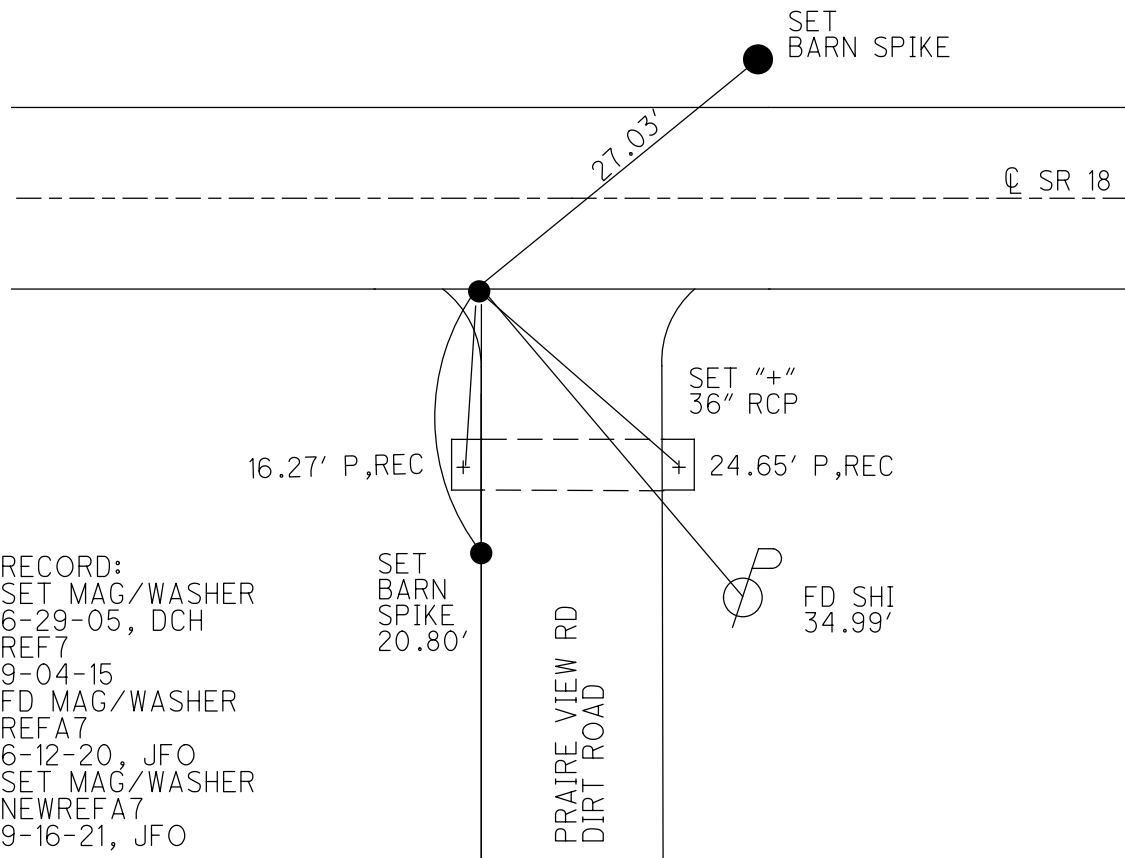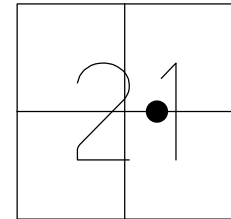

RECORD:
SET MAG/WASHER
6-29-05, DCH
REF 7
9-04-15
FD MAG/WASHER
REFA 7
6-12-20, JFO
SET MAG/WASHER
NEWREFA 7
9-16-21, JFO

AG/WASHER
7
20, JFO

SET BARN SPIKE

27.03'

CL SR 18

16.27' P, REC

24.65' P, REC

SET "X"s
TOP OF
36" RCP

SET BARN SPIKE
20.80'


PRAIRE VIEW RD
DIRT ROAD

FD SHI
34.99'


O.D.O.T. DISTRICT 2 SURVEY OFFICE (USE ONLY)

PERSONNEL _____ REFERENCE NO. 7 A SHEET 8 OF 13
 NOTES _____ DATE 09-04-15 ROUTE SR 18
 H.C. LEU WEATHER PTLY CLOUDY COUNTY WOOD
 R.C. LEU TEMP. 78°F TOWNSHIP JACKSON
 SECTION 21
 T 3 N R 9 E

TYPE MONUMENT _____ MAG/WASHER _____
 ON SURFACE - ~~BELOW~~ ON _____
~~LEFT~~ C PAV'T - RIGHT 8.4', 9.0' W OF C DIRT RD
1.1' TO RT EDGE PAVEMENT
 S.L.M. 148+80
 GRID: NORTHING: 563070.47 EASTING: 1603182.73

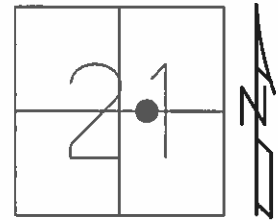

RECORD:
 SET MAG/WASHER
 6-29-05, DCH
 GPS, REF7
 09-04-15

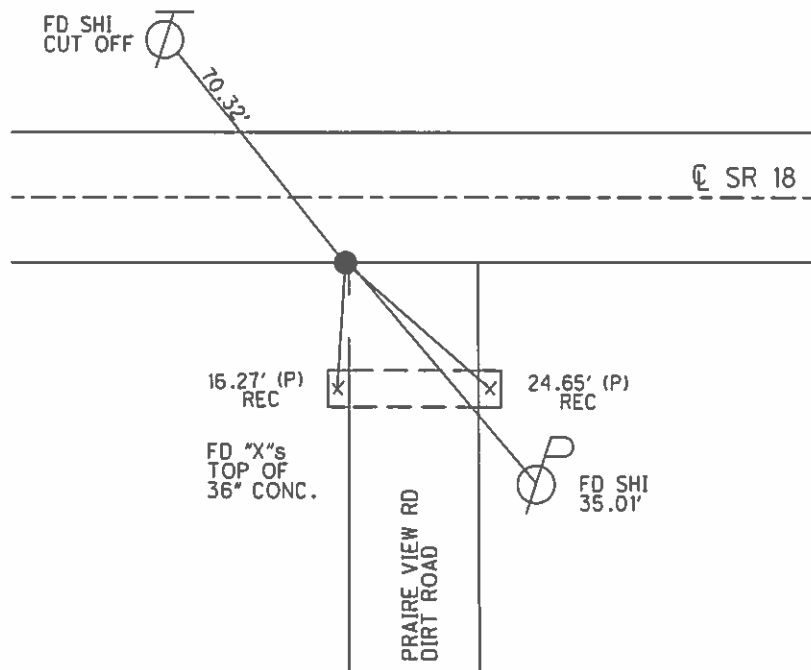

O.D.O.T. DISTRICT 2 SURVEY OFFICE

PERSONNEL

REFERENCE NO. 7-A

SHEET 7 OF 14

NOTES STEVE

DATE 4-14-05

ROUTE S.R. 18

H.C. JOE

WEATHER CLOUDY

COUNTY WOOD

R.C. DUANE

TEMP. 58°

TOWNSHIP JACKSON

SECTION 21

T 3 N R 9 E


TYPE MONUMENT PK & WASHER

ON SURFACE - ~~BELOW~~ ON


~~LEFT - C PAVT~~ - RIGHT 8.4'

1.1' TO RT EDGE PAVEMENT

S.L.M. 148+80; 9.0' W OF C DIRT RD

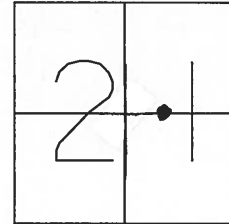

RESET MAG & WASHER
6-29-05
DCH

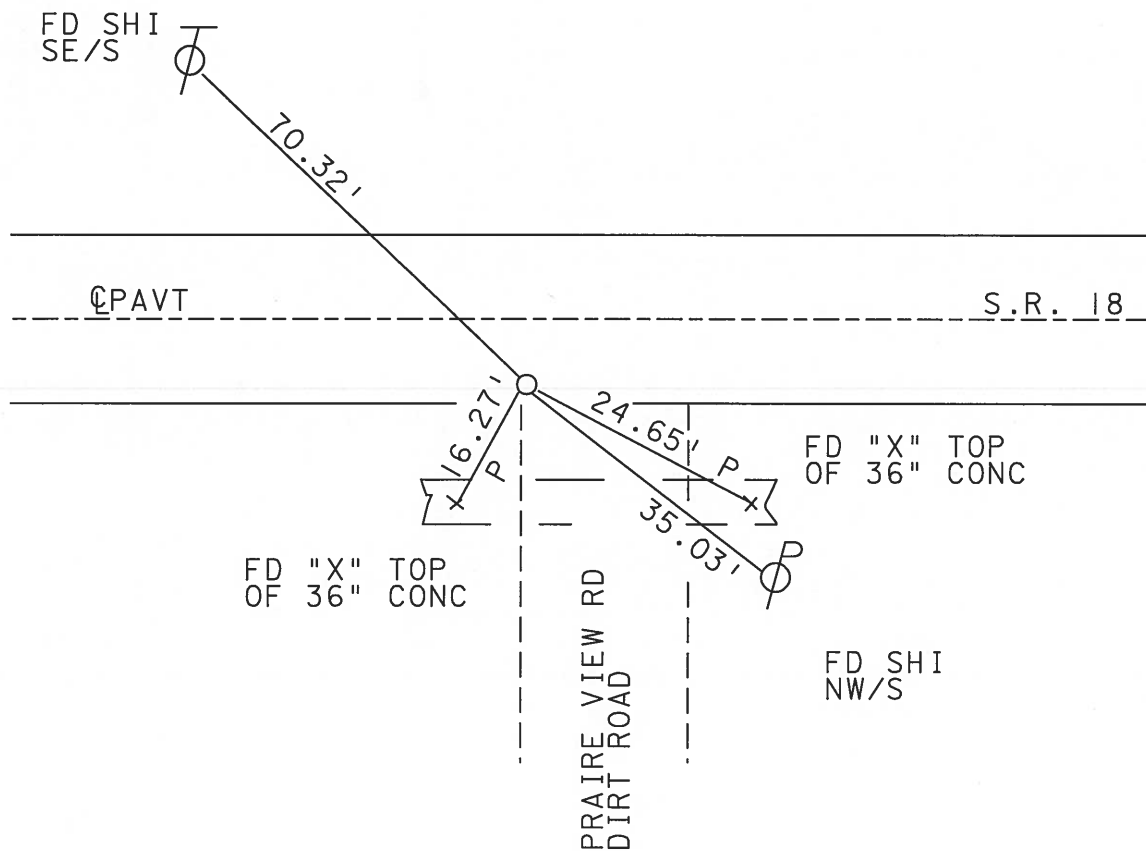

O.D.O.T. DISTRICT 2 SURVEY OFFICE

PERSONNEL

REFERENCE NO. 7-A

SHEET OF

NOTES BAANHISEL

H.C. Loehke

R.C. HOFFMAN

DATE 3-19-91

WEATHER Cloudy - Windy

TEMP. +45°

ROUTE 18

COUNTY Wood

TOWNSHIP JACKSON

SECTION 21

T 3 N R 9 E

TYPE MONUMENT P.K. & Washer


ON SURFACE - BELOW yes

LEFT - & PAV'T. - RIGHT 9.0


1.5 TO RT EDGE PAVEMENT

S.L.M. 148 + 78

9.0 W. OF & DIRT RD

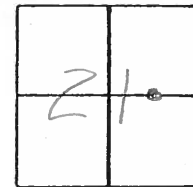

Set P.K. / Washer
4-17-91
MB

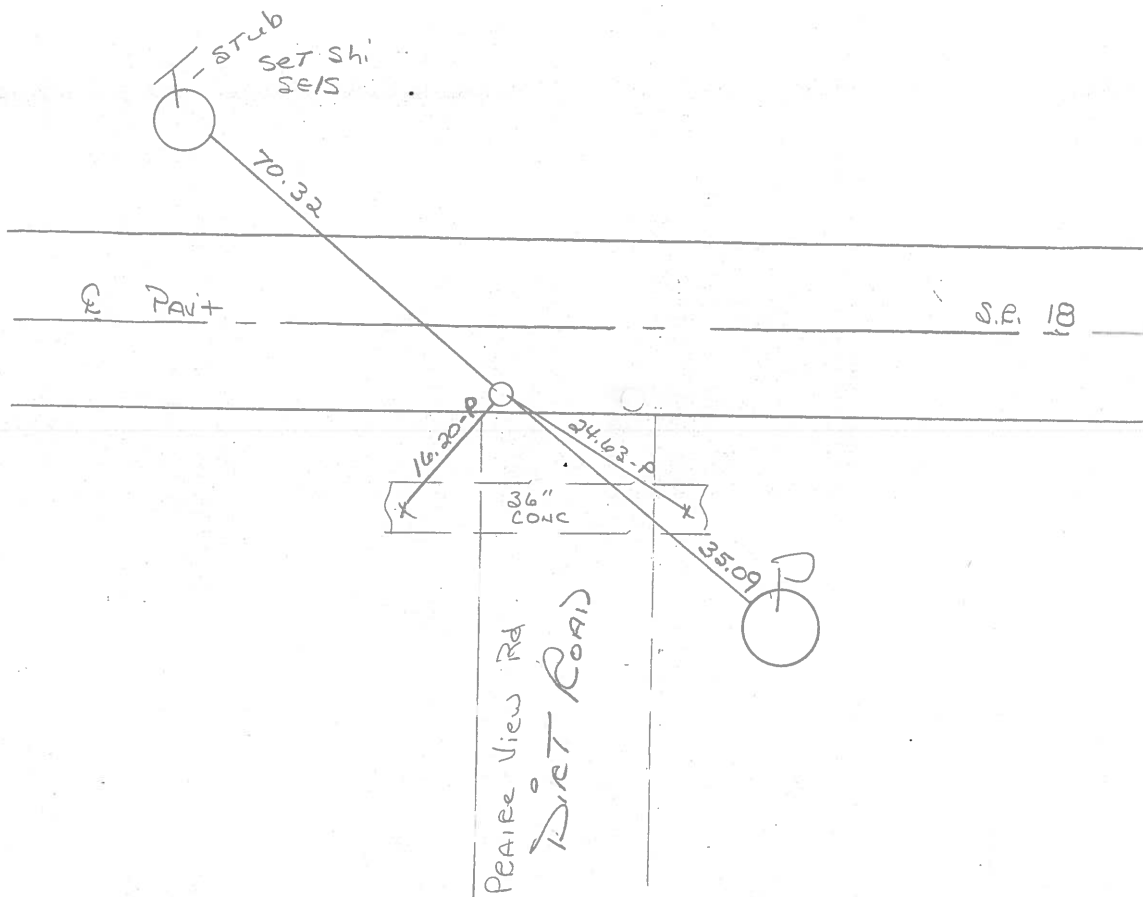

Q.D.O.T. DISTRICT 2 SURVEY OFFICE

SHEET 7-A OF

County Wood S.R. 18

Township Jackson

Section 21

T3N, R9E

Personnel BARNHISEL


Householder

Loehrke

Date 11-28-83

Weather Pt. Cloudy, Windy

Temp. +50°

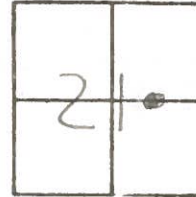

Fd stone 14" deep

@ S.E.P. S.R. 18


S.L.M. 148+65

RESET PK+WASHER

7-24-85

CL.

7-A

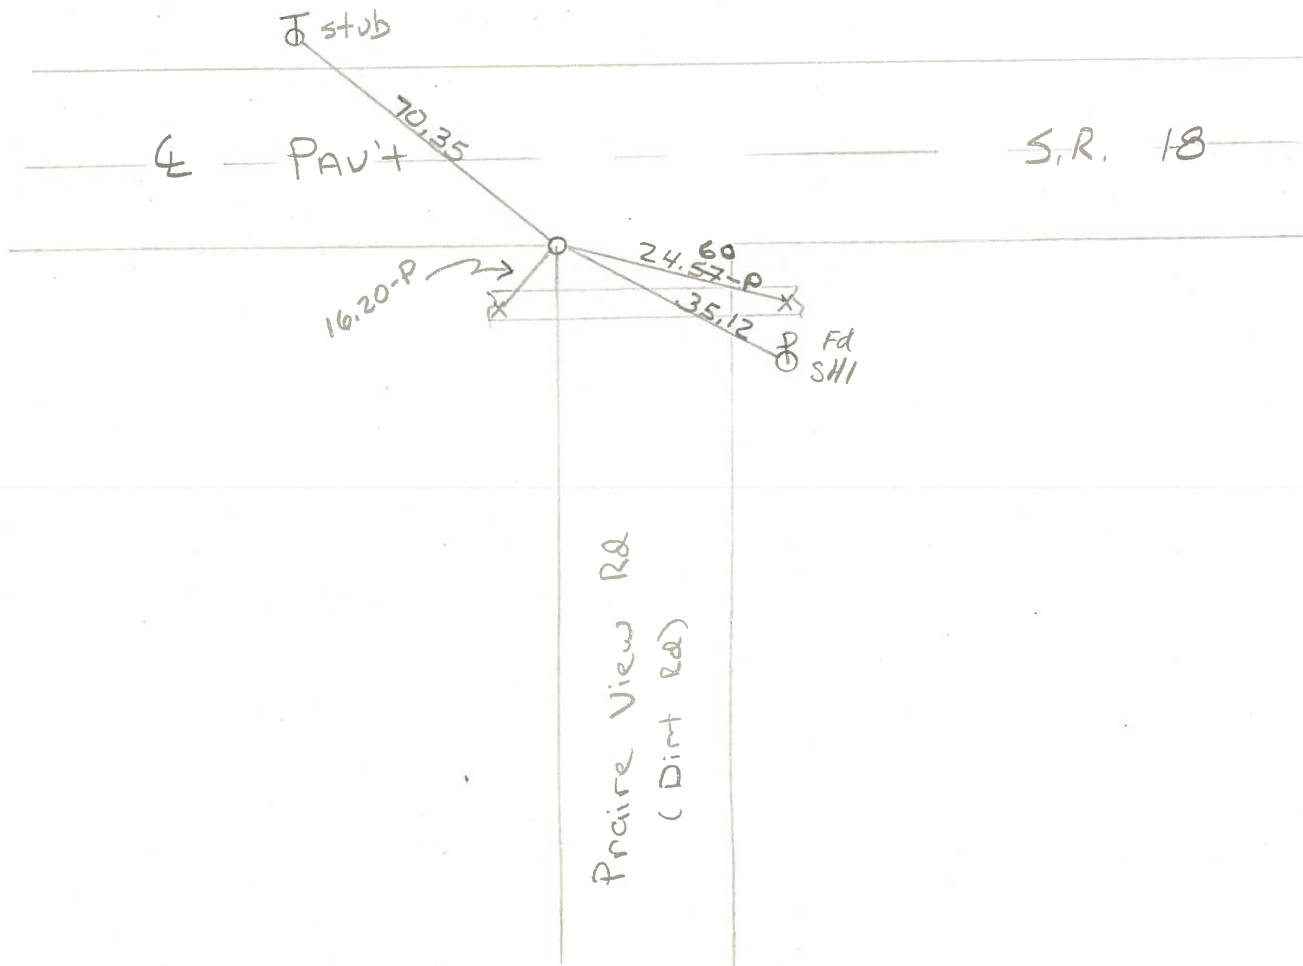

SHEET 7-A OF

Date 11-28-83

Weather Pt. Cloudy, Windy

Temp. + 50°

2A

Loehrke

RESET PK+WASHER

7- 24-85

CC.

Set P.K. / Inlashed

4-11-91

✓
Q stub

4 - PAV't

S.R. 18

16.20-P

24. ~~60~~ 57-P

35.12

Fd
SHI

Prairie View Rd
(Dirt Rd)

T-club

ODOT DISTRICT 2 SURVEY OFFICE

SHEET 7-A OF

County WOOD S.R. 18

Date 7-1-75

Township JACKSON


Weather CLEAR

Section 21

Temp. 78°

T3N, R9E

Personnel BURNSIDE

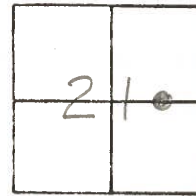

BOWERS

MEAD

7-A

FD. STONE 10" DEEP
@ THE SOUTH EDGE PAVT.
S.R. 18 SET BOAT SPK.
& BRICK OVER STONE

