

O.D.O.T. DISTRICT 2 SURVEY OFFICE (USE ONLY)

PERSONNEL

REFERENCE NO. 8

SHEET 9 OF 15

NOTES RHOADES

DATE 6-12-20

ROUTE SR 18

H.C. AUBLE

WEATHER SUNNY

COUNTY WOOD

R.C. MAHLER

TEMP. 66°F

TOWNSHIP JACKSON

O'DONNELL

SECTION 22

DWG BY MAHLER

PID PAVE TRAIN

T 3 N R 9 E

TYPE MONUMENT MAG/WASHER

ON SURFACE - ~~BELOW~~ ON

OFFSET Q PAVEMENT 4.6'

~~LT~~ : RT

4.7' TO RT EDGE PAVEMENT


STATION: 162+22

HORZ.DATUM: NAD83 (2011)


GEOID: NAVD88-2012A

GRID: NORTHING: 563047.284

EASTING: 1604520.399

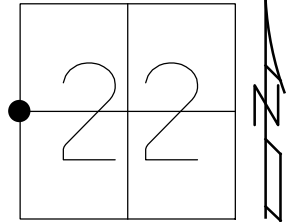

RECORD:
SET MAG/WASHER
7-25-05, DCH
REF8
9-4-15
FD MAG/WASHER
REF8
6-12-20
9-16-21, JFO

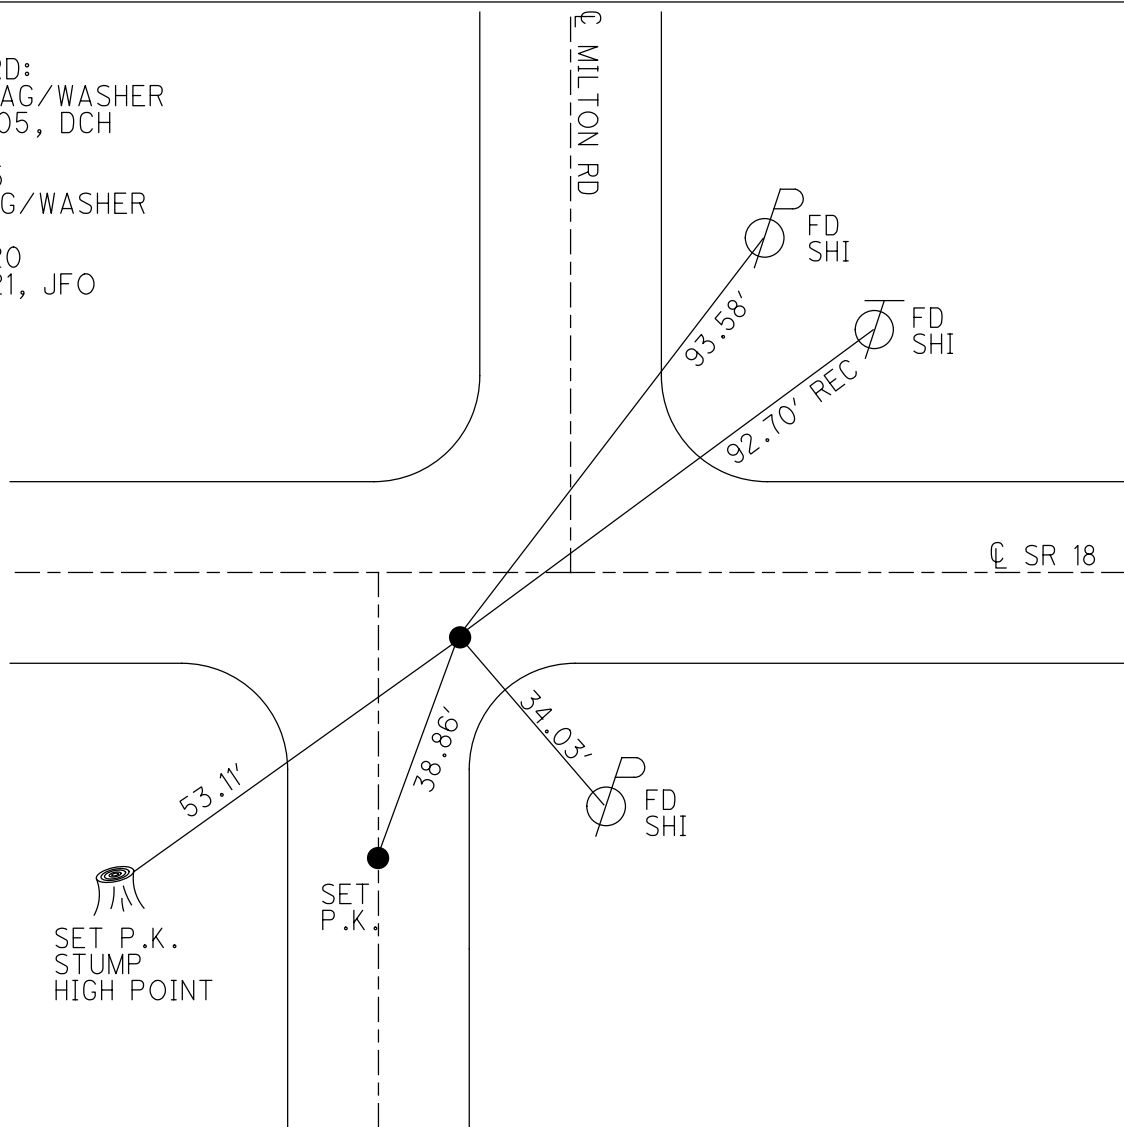

O.D.O.T. DISTRICT 2 SURVEY OFFICE (USE ONLY)

PERSONNEL

REFERENCE NO. 8

SHEET 9 OF 13

NOTES RHOADES

DATE 6-12-20

ROUTE SR 18

H.C. AUBLE

WEATHER SUNNY

COUNTY WOOD

R.C. MAHLER

TEMP. 66°F

TOWNSHIP JACKSON

O'DONNELL

SECTION 22

DWG BY MAHLER

PID PAVE TRAIN

T 3 N R 9 E

TYPE MONUMENT MAG/WASHER

ON SURFACE - ~~BELOW~~ ON

OFFSET CL PAVEMENT 4.6' , 4.0' E OF CL S ~~LT~~ : RT

4.7' TO RT EDGE PAVEMENT


STATION: 162+22

HORIZ.DATUM: NAD83 (2011)


GEOID: NAVD88-2012A

GRID: NORTHING: 563047.284

EASTING: 1604520.399

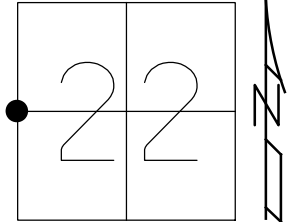


RECORD:
SET MAG/WASHER
7-25-05, DCH
REF8
09-04-15
FD MAG/WASHER
REF8
6-12-20, JFO

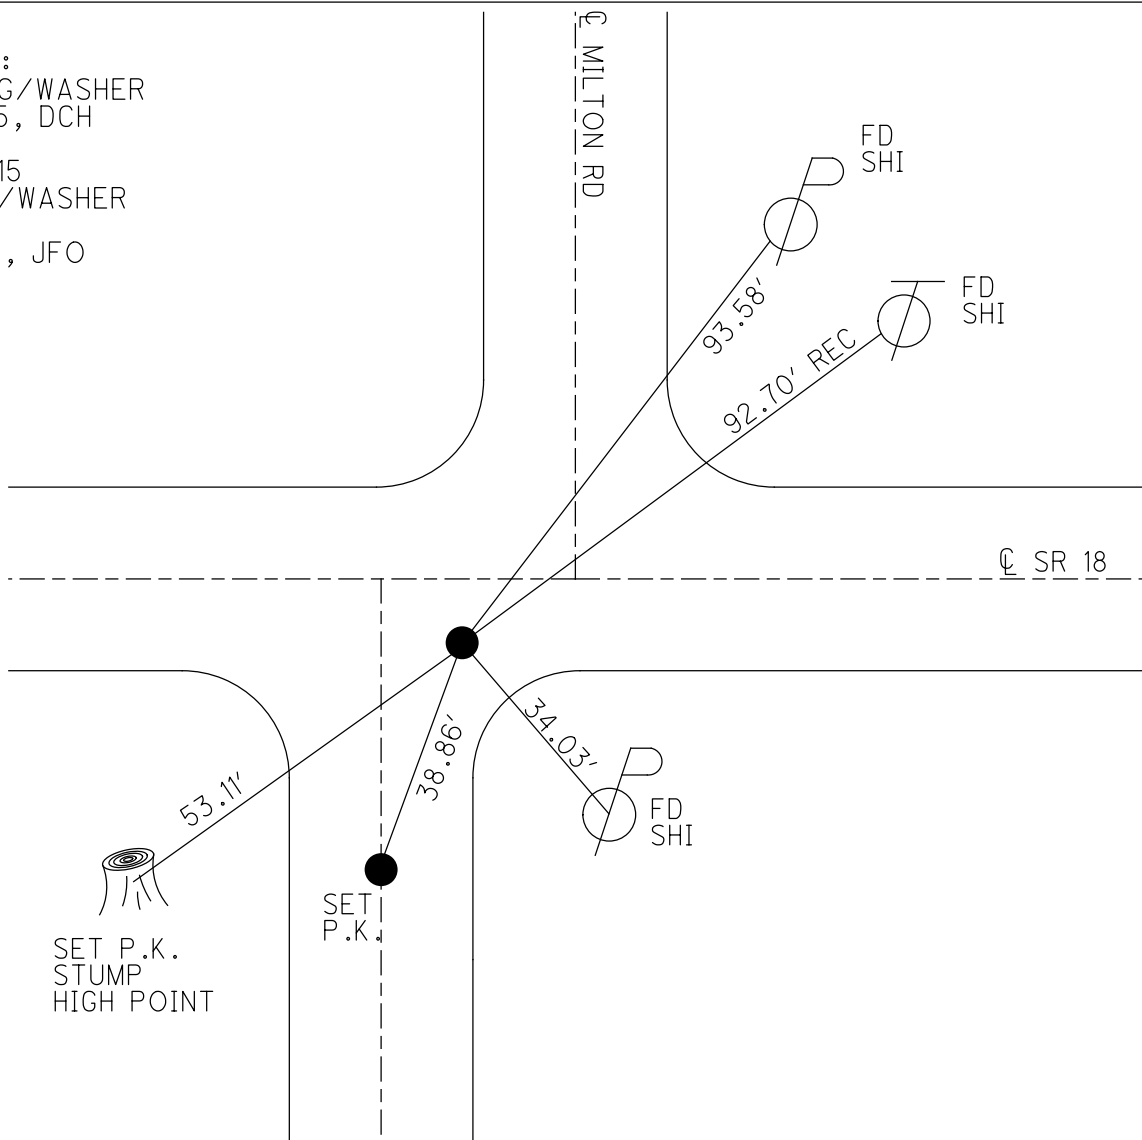

O.D.O.T. DISTRICT 2 SURVEY OFFICE (USE ONLY)


PERSONNEL _____ REFERENCE NO. 8 SHEET 9 OF 13
 NOTES LEU DATE 09-04-15 ROUTE SR 18
 H.C. HOMAN WEATHER PTLY CLOUDY COUNTY WOOD
 R.C. LEU TEMP. 78°F TOWNSHIP JACKSON
 SECTION 22
 T 3 N R 9 E

TYPE MONUMENT MAG/WASHER
 ON SURFACE - ~~BELOW~~ ON
~~LEFT~~ - CL PAV'T - RIGHT 4.6', 4.0' E OF CL SOUTH
4.7' TO RT EDGE PAVEMENT
 S.L.M. 162+22
 GRID: NORTHING: 563047.19 EASTING: 1604520.38

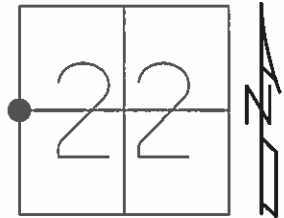

RECORD:
 SET MAG/WASHER
 7-25-05, DCH

GPS, REF8
 09-04-15

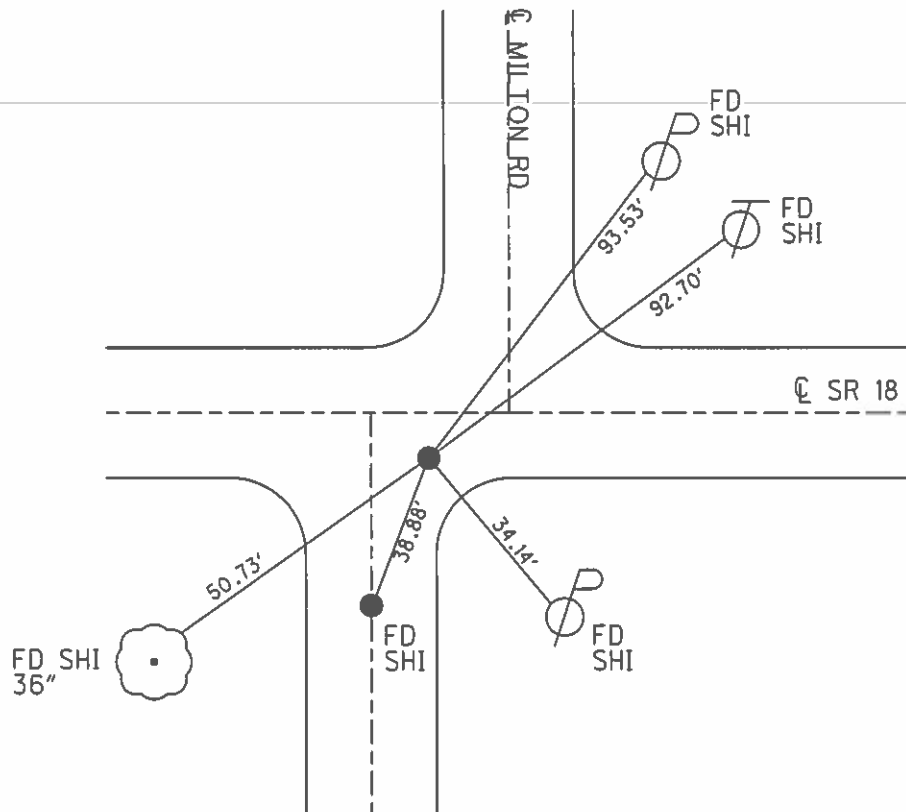

O.D.O.T. DISTRICT 2 SURVEY OFFICE

PERSONNEL

REFERENCE NO. 8

SHEET 8 OF 14

NOTES STEVE

DATE 4-11-05

ROUTE S.R. 18

H.C. JOE

WEATHER CLOUDY

COUNTY WOOD

R.C. DUANE

TEMP. 55°

TOWNSHIP JACKSON

SECTION 22

T 3 N R 9 E


TYPE MONUMENT PK & WASHER

ON SURFACE - ~~BELOW~~ ON


~~LEFT - C PAVT~~ - RIGHT 4.6'

4.7' TO RT EDGE PAVEMENT

S.L.M. 162+22, 4.0' E OF C SOUTH

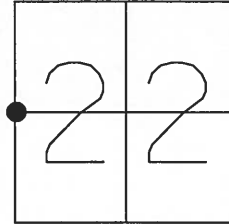

RESET MAG & WASHER
7-25-05
DCH

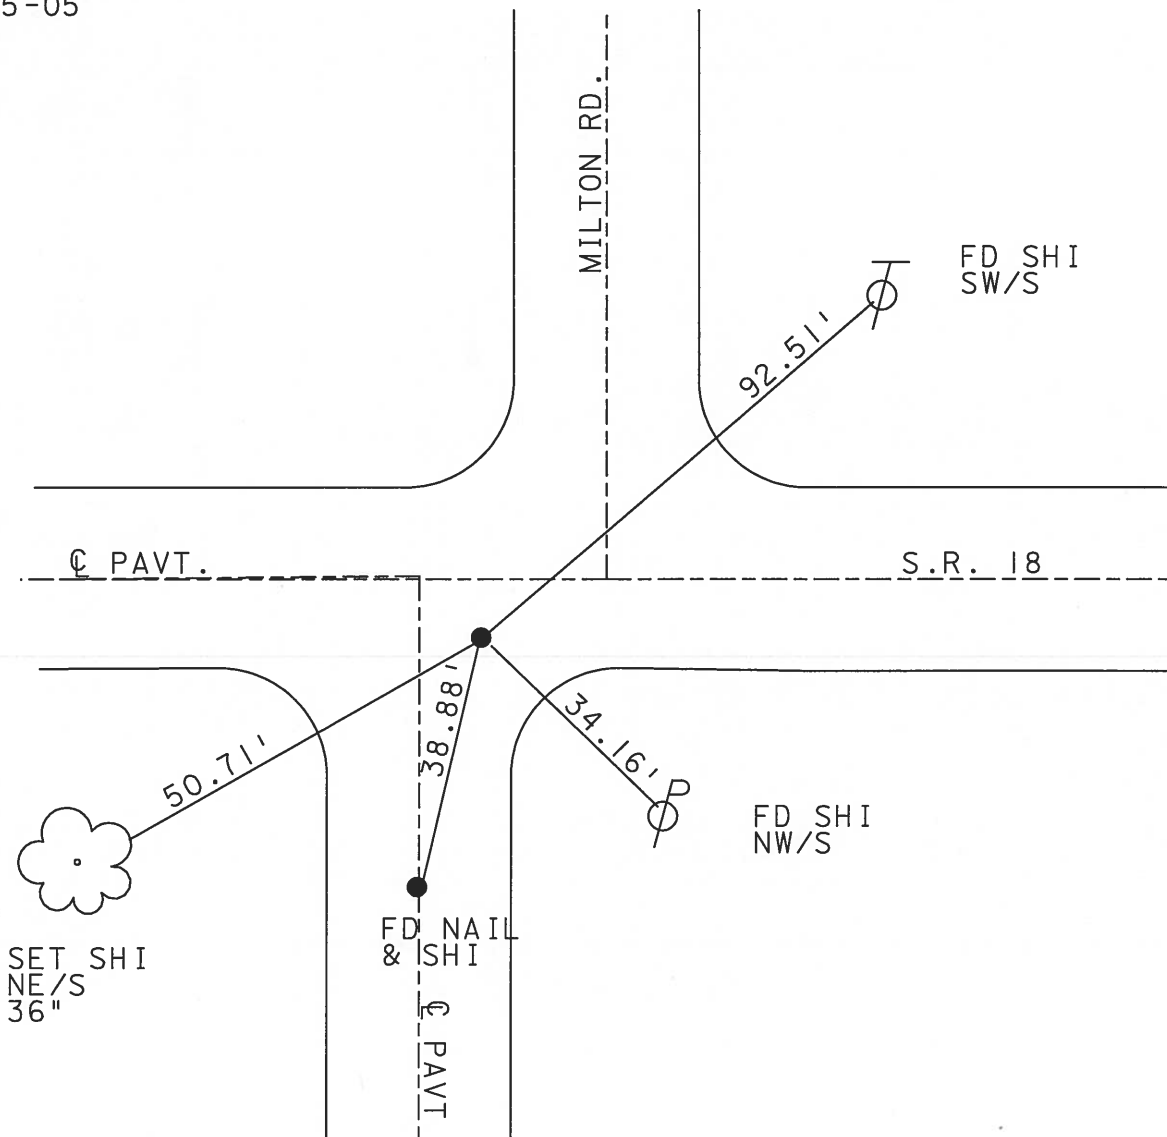

O.D.O.T. DISTRICT 2 SURVEY OFFICE

PERSONNEL

REFERENCE NO. 8

SHEET OF

NOTES BARNHISEL

H.C. Loehcke

R.C. Hoffman

DATE 3-19-91

WEATHER Cloudy-Windy

TEMP. +45°

ROUTE 18

COUNTY WOOD

TOWNSHIP JACKSON

SECTION 22

T 3 N R 9 E


TYPE MONUMENT P.K. & Washer

ON SURFACE - BELOW yes


~~LEFT~~ - & PAV'T. - RIGHT 4.8


4.7 TO RT EDGE PAVEMENT

S.L.M. 162 + 15 4.0 E. OF & South

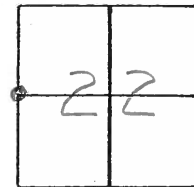

Set P.K. & Washer
4-17-91

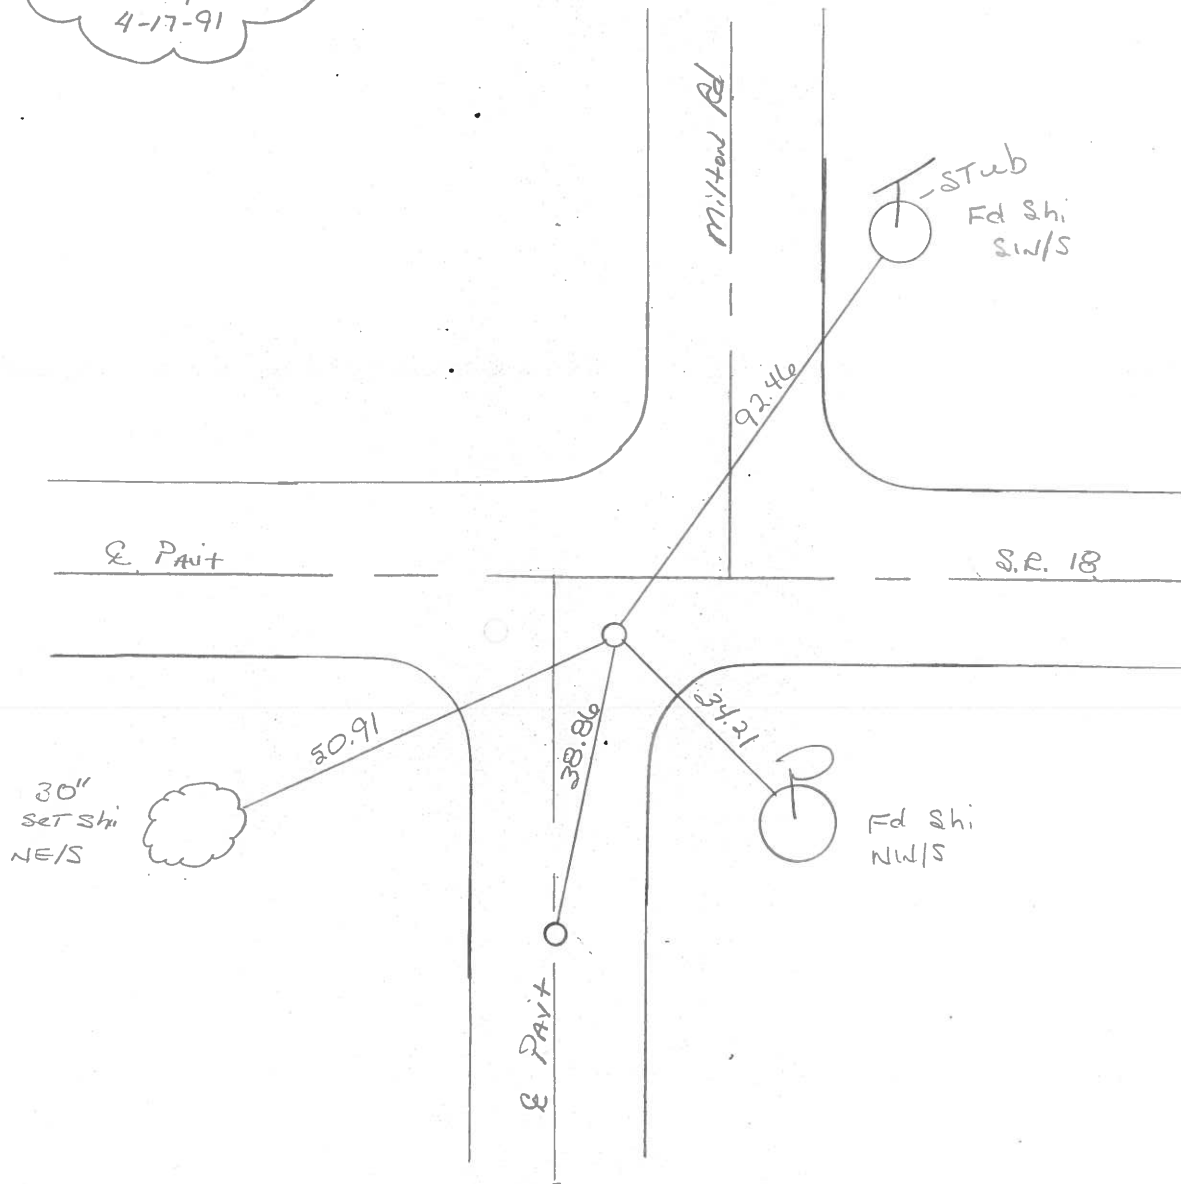

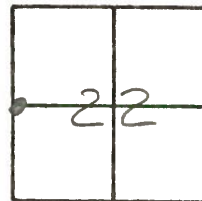County WOOD S.R. 18Township JACKSONSection 22T3N, R9EPersonnel BARNHISEL HCHOUSEHOLDER RCLOEHRIKE Date 11-25-83Weather CLEAR - WINDYTemp. + 38°

Fd RR SPIKE @ SURFACE

4.6' S of $\angle$ PAVT SR 183.2 E of $\angle$ PAVT MILTON Rd South13.9 W of $\angle$ PAVT MILTON Rd NORTH


SLM 162+02

#8

SET PK+WASHER

7-25-85

C.L

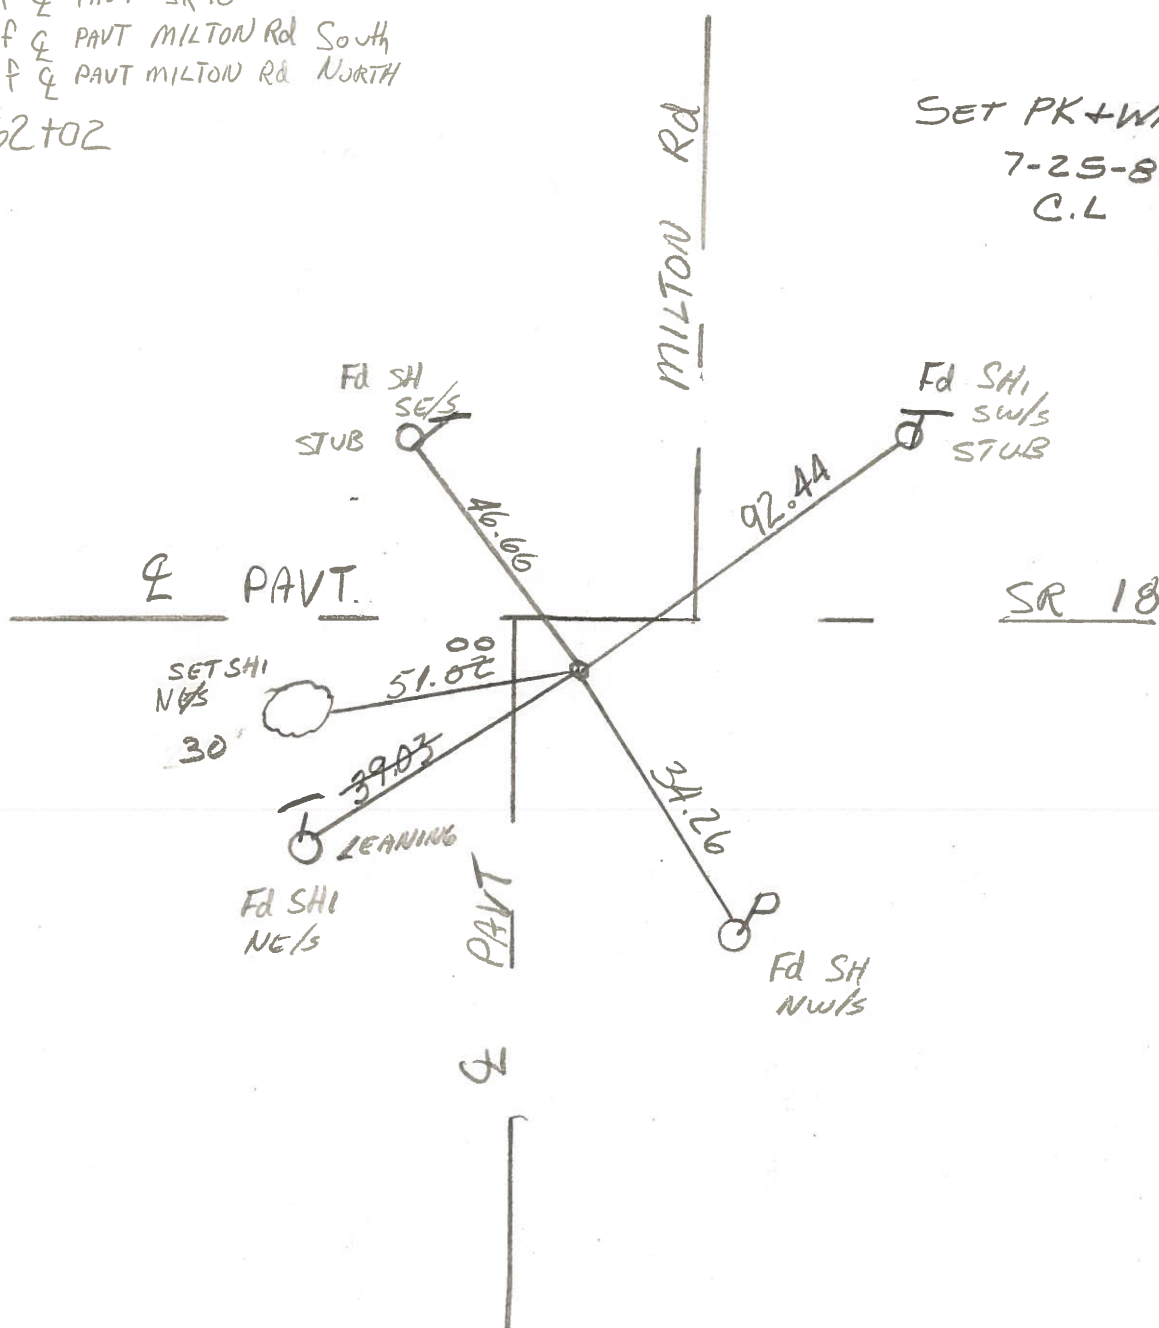

County Wood S.R. 18

Date 11-25-03

Township JACKSON


Weather CLEAR - WINDY

Section 22

Temp. + 38°

T3N, R9E

Personnel BARWISSEL HC
HOUSEHOLDER RC
LOEHKE 

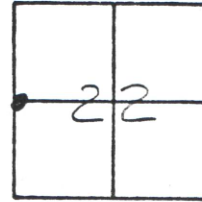

Fd RR SPIKE @ SURFACE


#8


~~4.0' S of & PAVT SR 18 RT ED~~
~~4.0 3.2 E of & PAVT MILTON Rd South~~
~~13.9 W of & PAVT MILTON Rd NORTH~~

SLM 162 ~~102~~
15


LT 4.8 ~~15~~

SET PK+WASHER
 7-25-85
 C.L

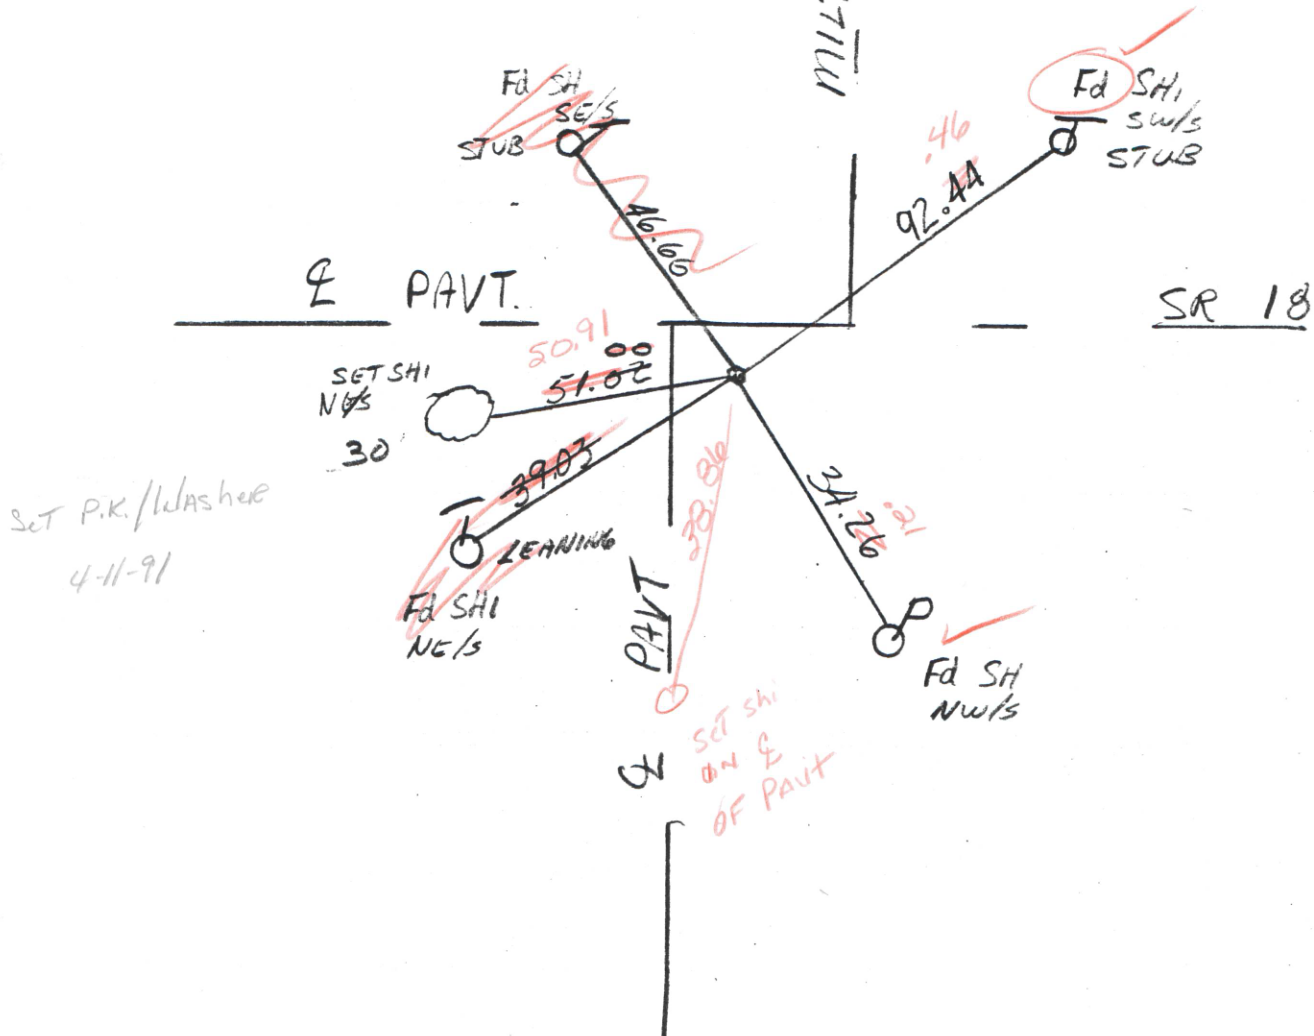

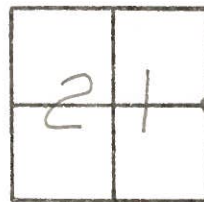County Wood S.R. 18Township JacksonSection 21T3N, R9EPersonnel HoffmanHouseholderLoehrke# 8Date 7-13-82Weather clearTemp. +78°

Fd R.R. spk @ surface

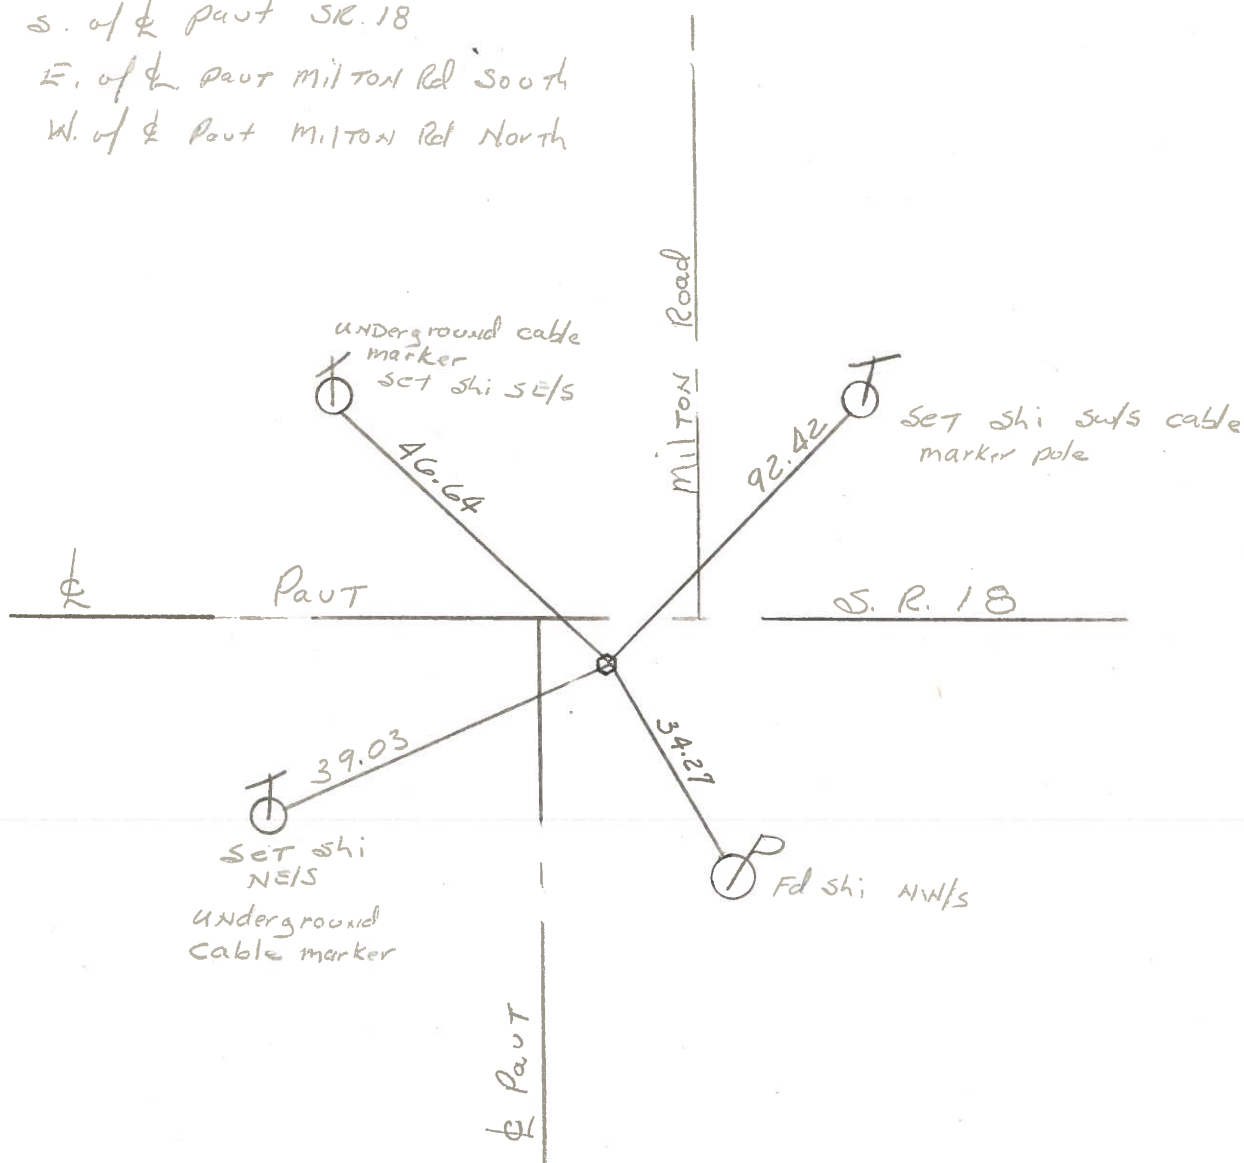4.6' S. of $\frac{1}{2}$ part S.R. 183.2' E. of $\frac{1}{2}$ part Milton Rd South13.9' W. of $\frac{1}{2}$ part Milton Rd North

Q.D.O.T. DISTRICT 2 SURVEY OFFICE

Sht. 8 of

County WOOD S.R. 18

Date 6-17-74

Township JACKSON

Weather CLOUDY

Section 21

Temp. 60°

T3N, R9E


Personnel BURNSIDE

SMITH

BOWERS


MEAD

KISOWSKI

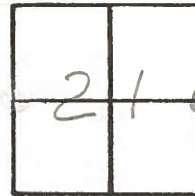

#8

FD. R.R. SPK. 2" DEEP
AND 4' SOUTH OF
CENTER PAUT. S.R. 18 SHI.

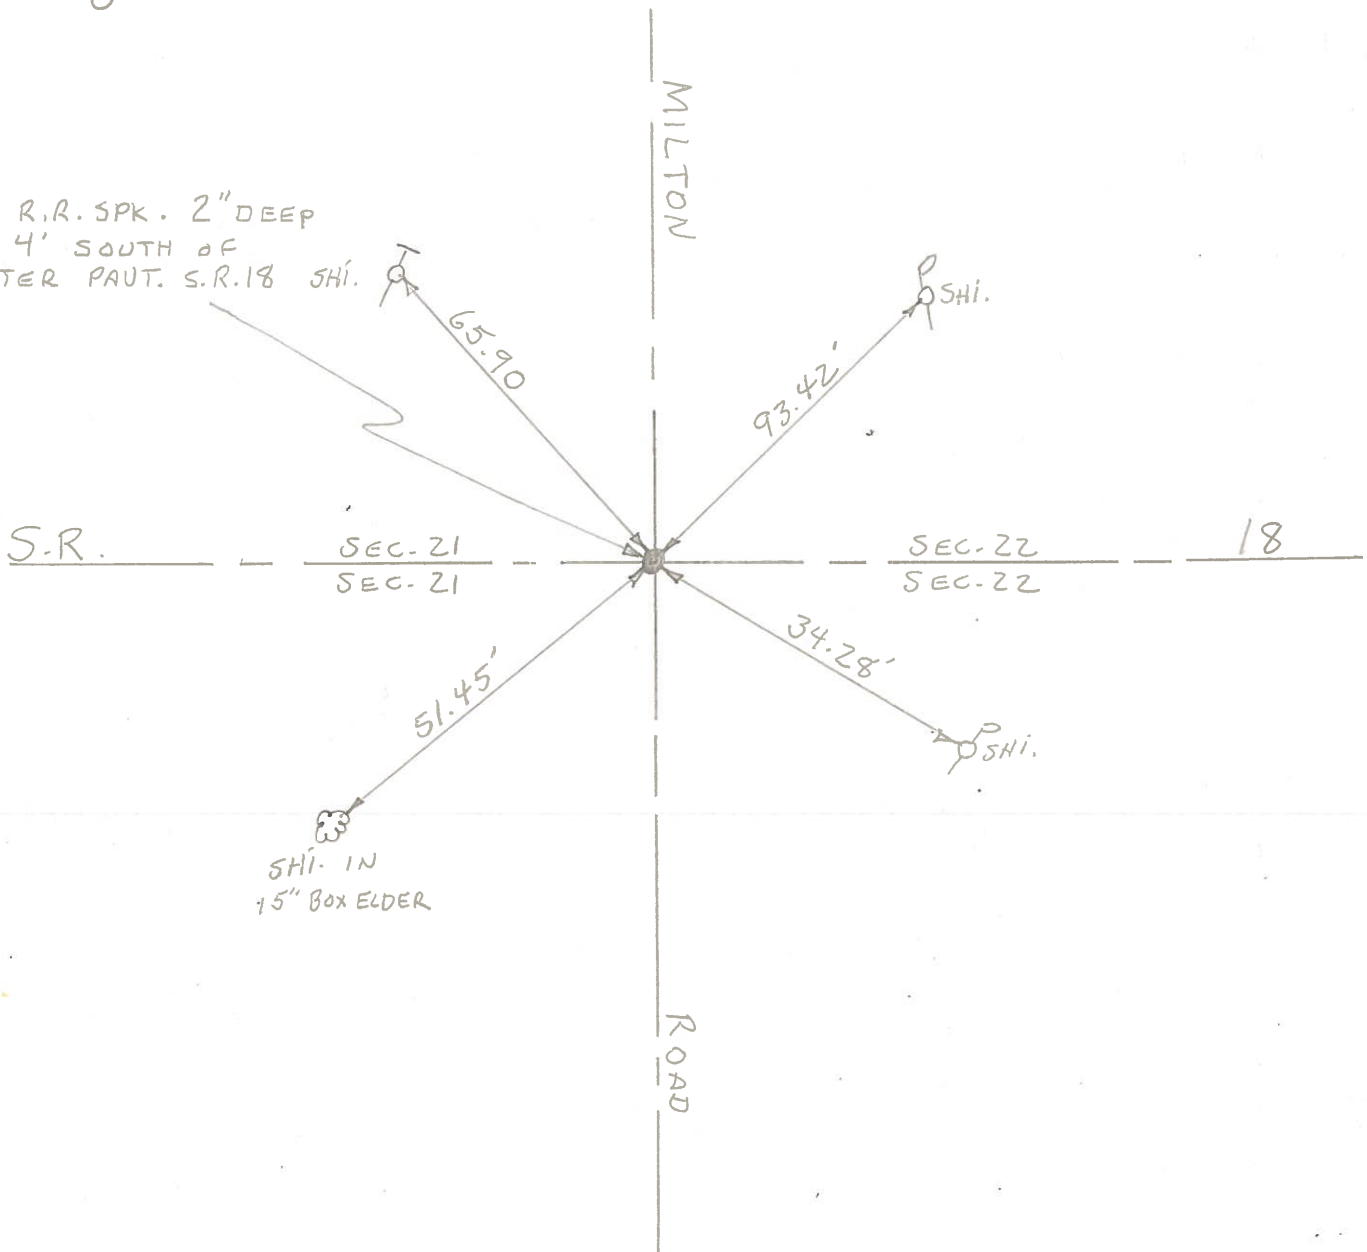

PERSONNEL	TITLE	PERSONNEL	TITLE

COUNTY WOOD DATE 12-28-70

S. R. #18 WEATHER CLOUDY

SEC. HEN. Co. LINE EAST. TEMP. +26°

DESCRIPTION _____ LEFT _____ CENTER LINE _____ RIGHT _____ JOB NO. _____

