

O.D.O.T. DISTRICT 2 SURVEY OFFICE (USE ONLY)

PERSONNEL

REFERENCE NO. 9

SHEET 10 OF 15

NOTES RHOADES

DATE 6-12-20

ROUTE SR 18

H.C. AUBLE

WEATHER SUNNY

COUNTY WOOD

R.C. MAHLER

TEMP. 66°F

TOWNSHIP JACKSON

O'DONNELL

SECTION 22

DWG BY MAHLER

PID PAVE TRAIN

T 3 N R 9 E

TYPE MONUMENT MAG/WASHER

ON SURFACE - ~~BELOW~~ ON

OFFSET CL PAVEMENT 2.9' ± : RT

6.9' TO RT EDGE PAVEMENT


STATION: 188+63

HORZ.DATUM: NAD83 (2011)


GEOID: NAVD88-2012A

GRID: NORTHING: 563020.417

EASTING: 1607159.272

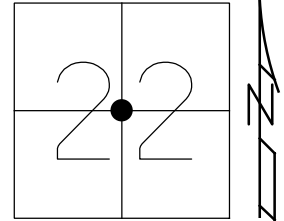

RECORD:
SET MAG/WASHER
6-29-05, DCH
REF9
9-04-15
FD MAG/WASHER
REF9
6-12-20
9-16-21, JFO

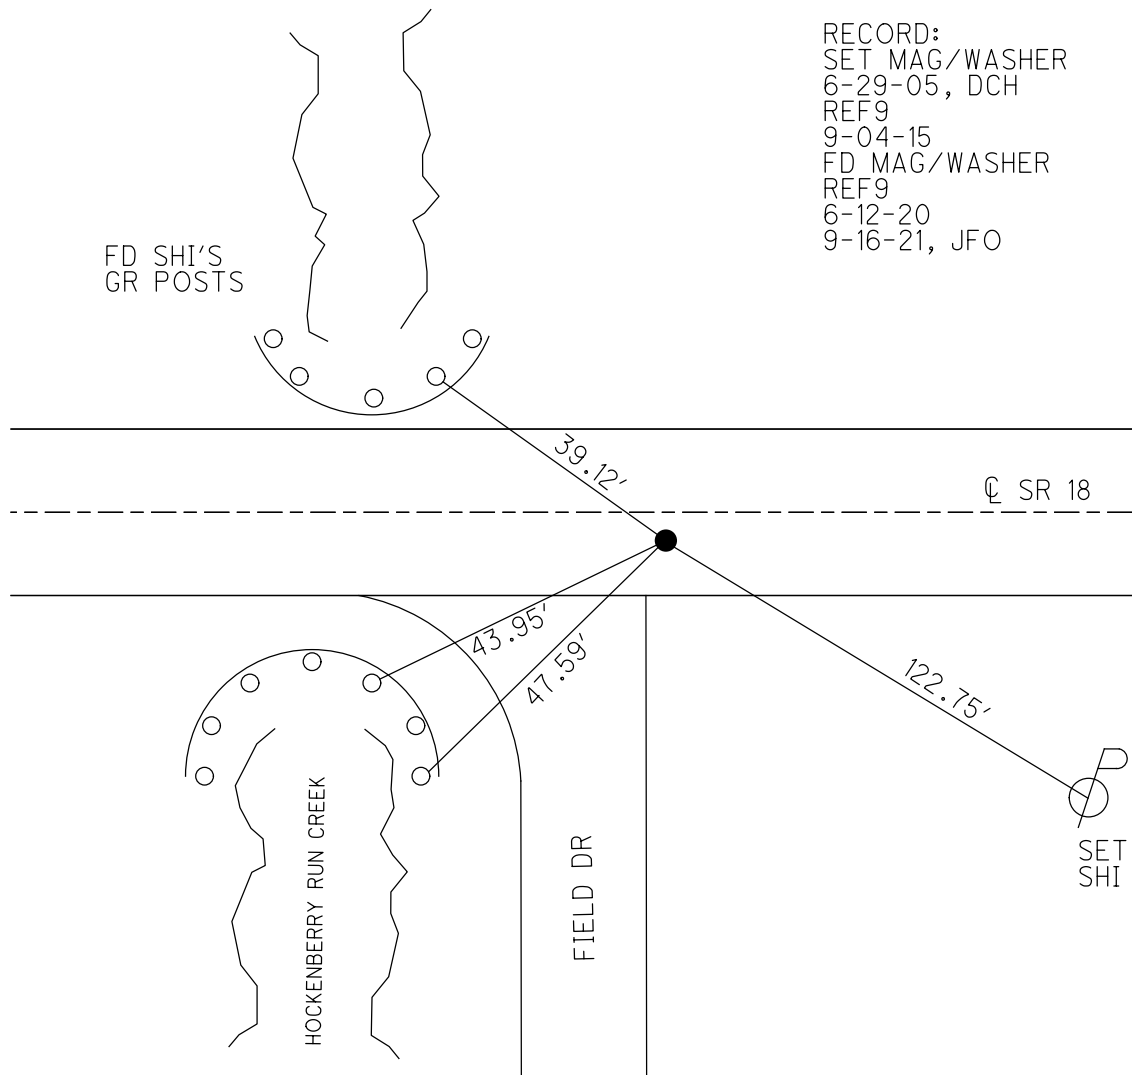

O.D.O.T. DISTRICT 2 SURVEY OFFICE (USE ONLY)

PERSONNEL

REFERENCE NO. 9

SHEET 10 OF 13

NOTES RHOADES

DATE 6-12-20

ROUTE SR 18

H.C. AUBLE

WEATHER SUNNY

COUNTY WOOD

R.C. MAHLER

TEMP. 66°F

TOWNSHIP JACKSON

O'DONNELL

SECTION 22

DWG BY MAHLER

PID PAVE TRAIN

T 3 N R 9 E

TYPE MONUMENT MAG/WASHER

ON SURFACE - ~~BELOW~~ ON

OFFSET CL PAVEMENT 2.9' LT : RT

6.9' TO RT EDGE PAVEMENT


STATION: 188+63

HORZ.DATUM: NAD83 (2011)

GEOID: NAVD88-2012A


GRID: NORTHING: 563020.417

EASTING: 1607159.272

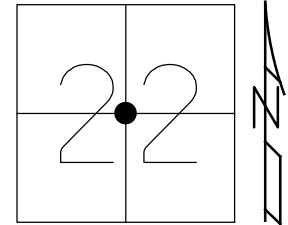

RECORD:
SET MAG/WASHER
6-29-05, DCH
REF9
9-04-15
FD MAG/WASHER
REF9
6-12-20, JFO

FD SHI'S
GR POSTS

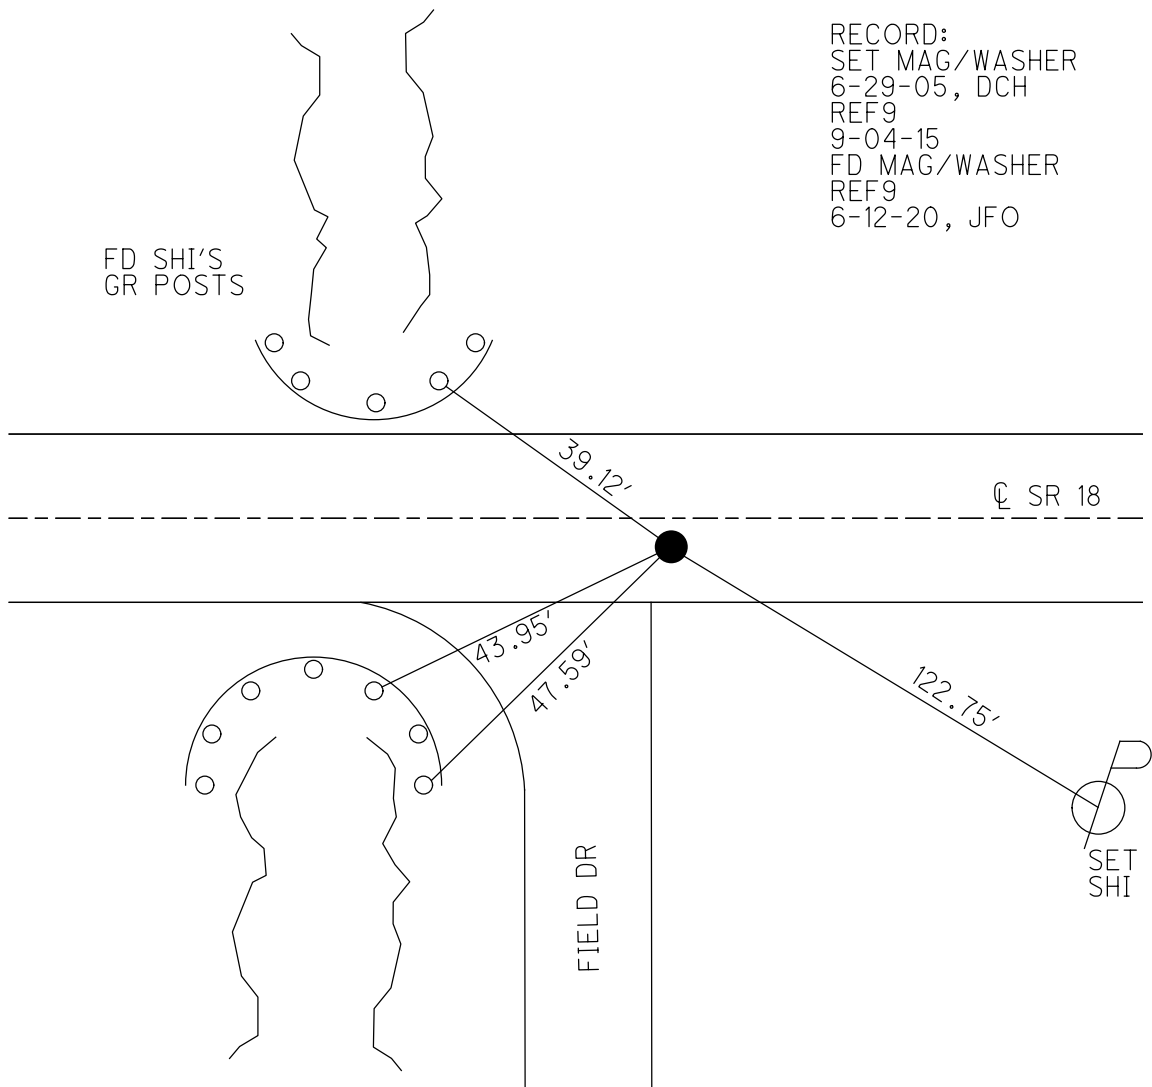

O.D.O.T. DISTRICT 2 SURVEY OFFICE (USE ONLY)

PERSONNEL

REFERENCE NO. 9

SHEET 10 OF 13

NOTES

LEU

DATE 09-04-15

ROUTE SR 18

H.C.

HOMAN

WEATHER PTLY CLOUDY

COUNTY WOOD

R.C.

LEU

TEMP. 85°F

TOWNSHIP JACKSON

SECTION 22

T 3 N R 9 E

TYPE MONUMENT MAG/WASHER


ON SURFACE - ~~BELOW~~ ON

~~LEFT~~ - CL PAV'T - RIGHT 2.9'

6.9' TO RT EDGE PAVEMENT


S.L.M. 188+63

GRID: NORTHING: 563020.38 EASTING: 1607159.29

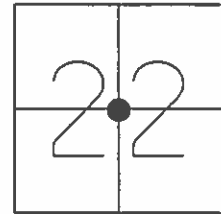

RECORD:
SET MAG/WASHER
6-29-05, DCH

GPS, REF9
09-04-15

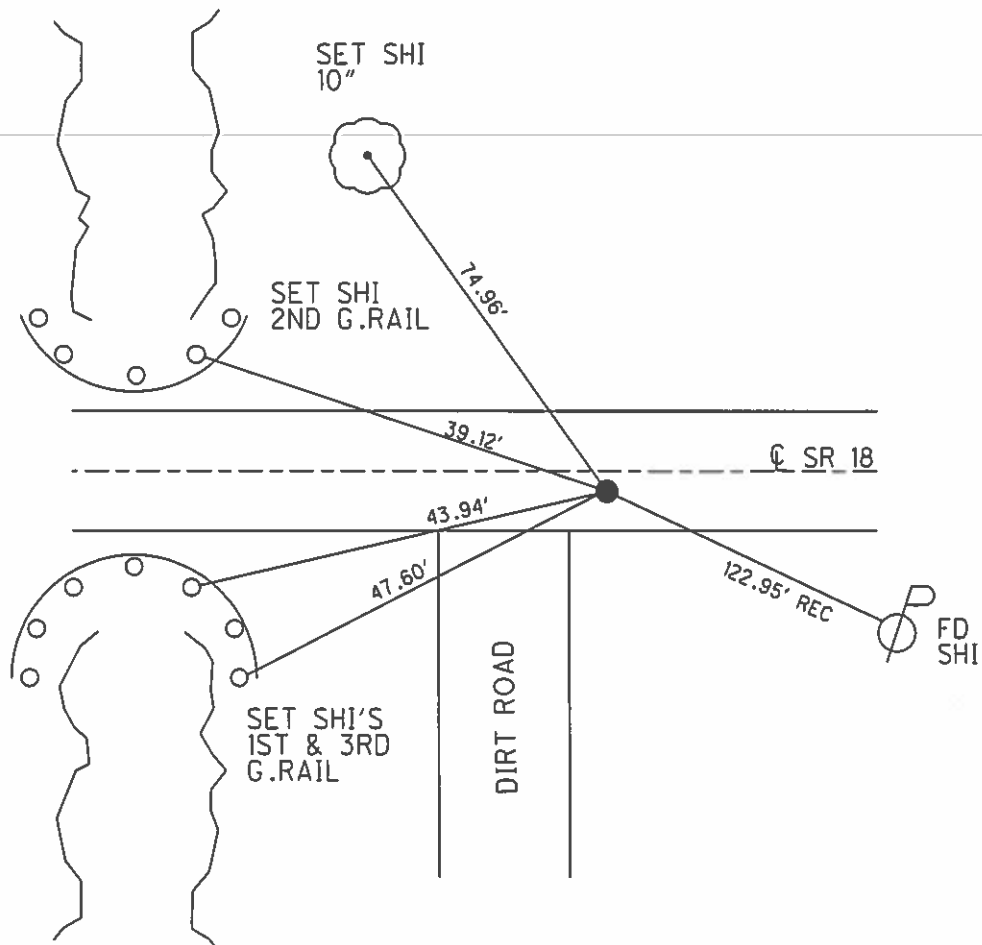

O.D.O.T. DISTRICT 2 SURVEY OFFICE

PERSONNEL

NOTES _____ STEVE
H.C. _____ STEVE
R.C. _____ DUANE

REFERENCE NO. 9

DATE 5-08-05
WEATHER FAIR
TEMP. 74°

SHEET 9 OF 14

ROUTE S.R. 18
COUNTY WOOD
TOWNSHIP JACKSON
SECTION 22
T 3 N R 9 E


TYPE MONUMENT _____ PK & WASHER

ON SURFACE - ~~BELOW~~ _____ ON


~~LEFT~~ ~~Q~~ ~~PAVT~~ - RIGHT _____ 2.9'

6.9' TO RT EDGE PAVEMENT

S.L.M. _____ 188+63

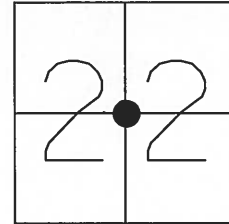

RESET MAG & WASHER
6-29-05
DCH

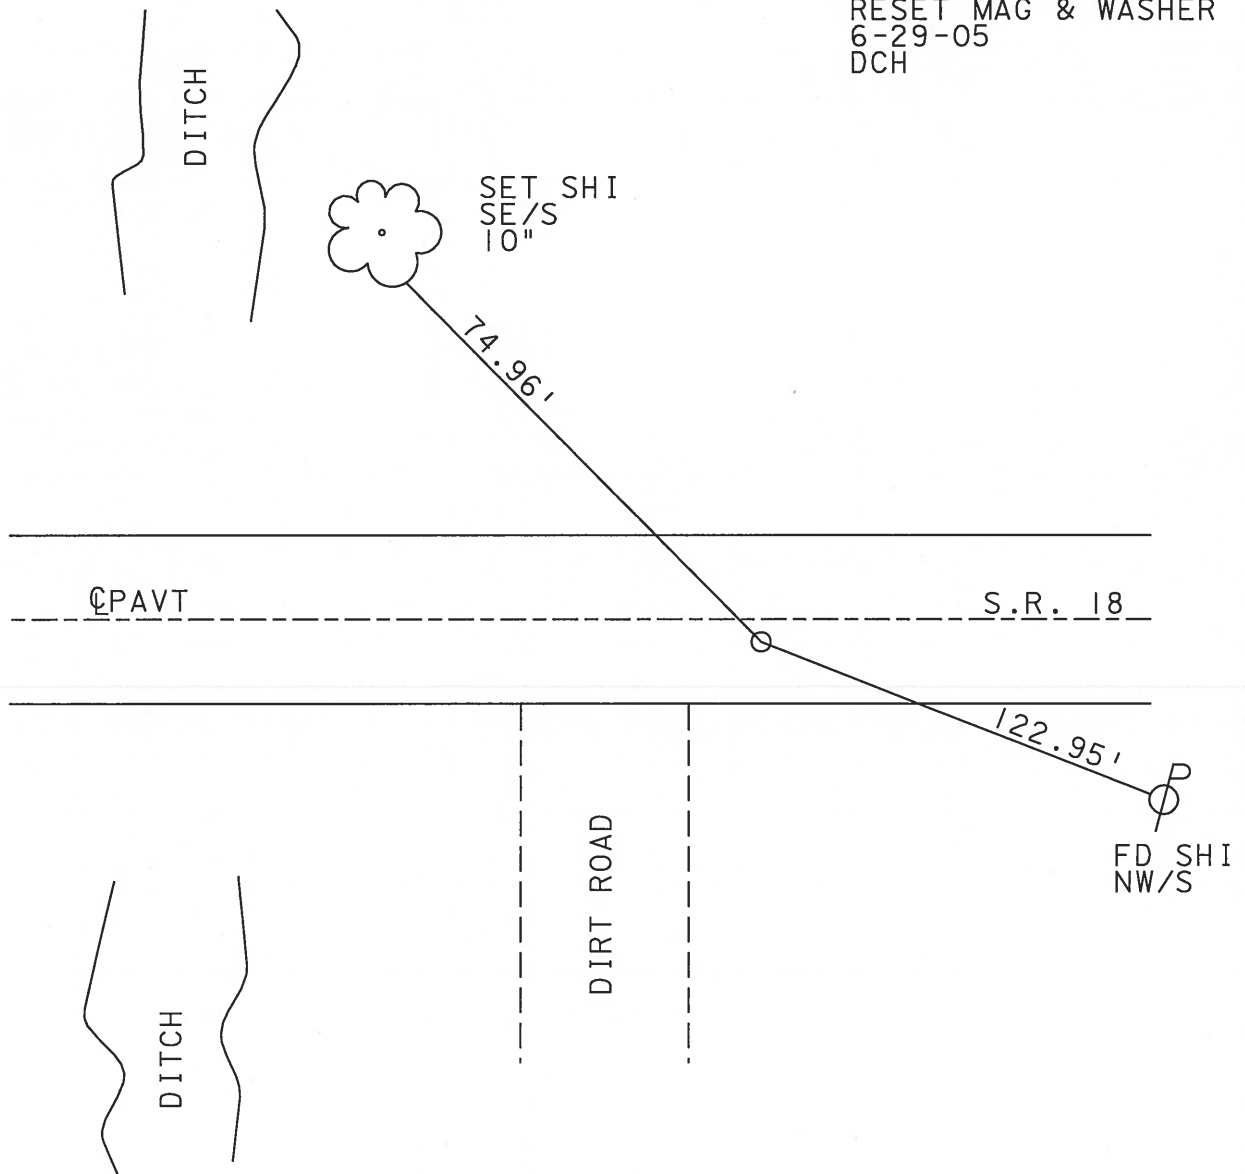

O.D.O.T. DISTRICT 2 SURVEY OFFICE

PERSONNEL

REFERENCE NO. 9

SHEET OF

NOTES BARNHISEL

H.C. Loehke

R.C. Hoffman

DATE 4-17-91

WEATHER cloudy - Wind

TEMP. +45°

ROUTE 18

COUNTY WOOD

TOWNSHIP JACKSON

SECTION 22

T 3 N R 9 E



TYPE MONUMENT P.K. & Washer

ON SURFACE - BELOW yes

LEFT - & PAV'T. - RIGHT 2.9

6.9 TO RT EDGE PAVEMENT

S.L.M. 188+56 27.3 E. OF Q DRT RD

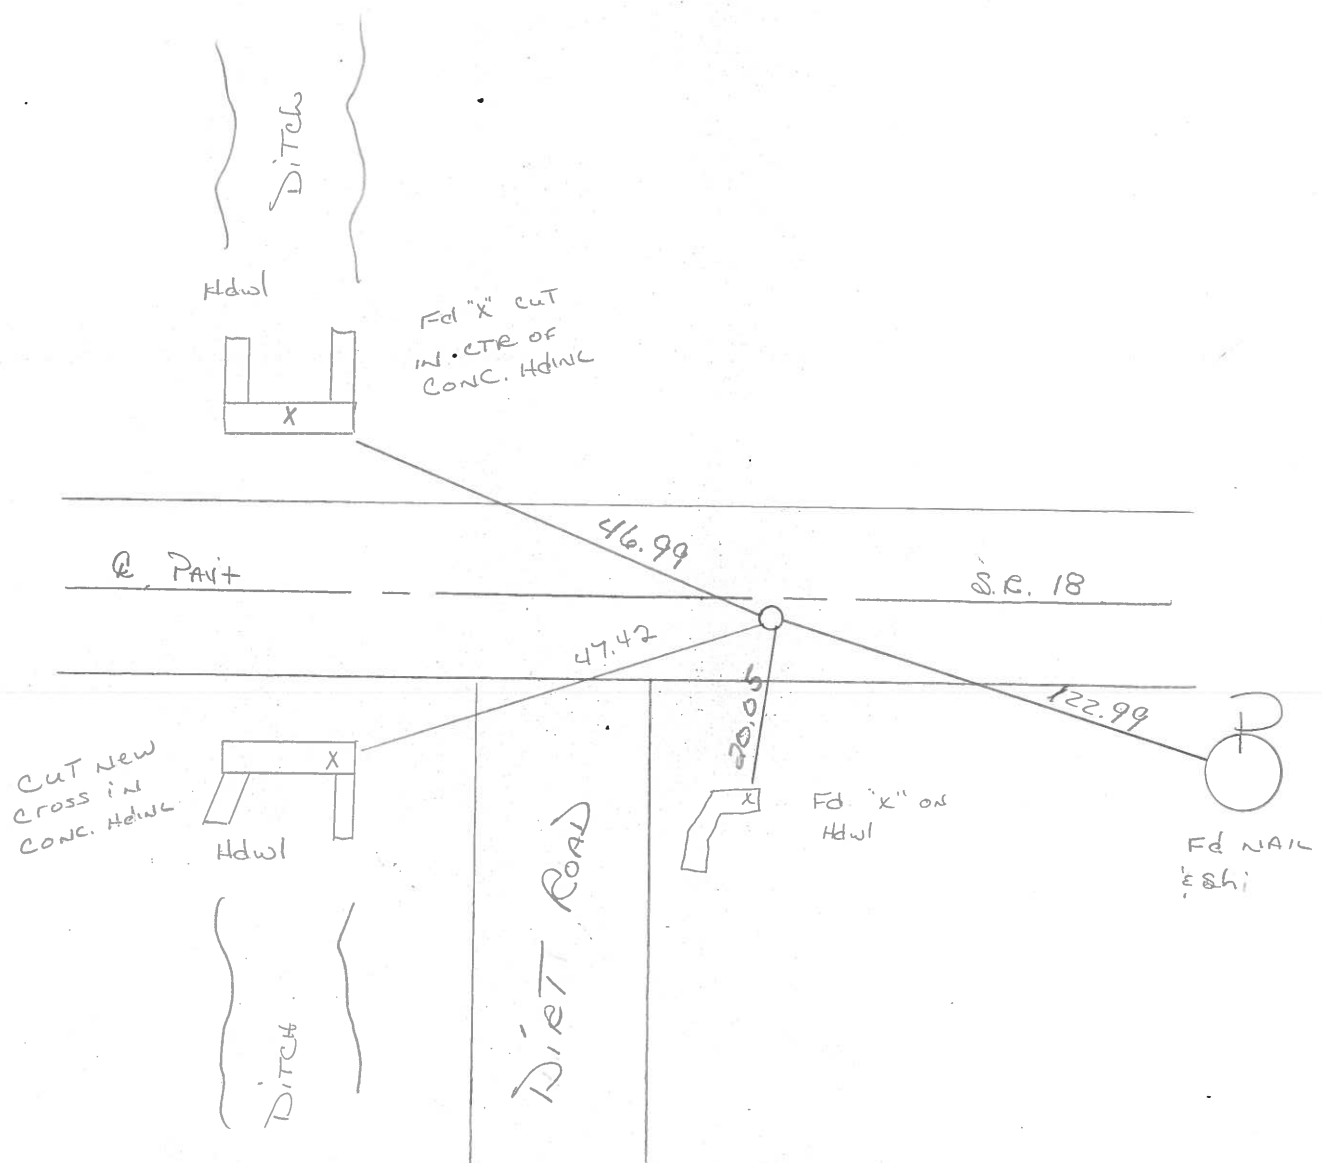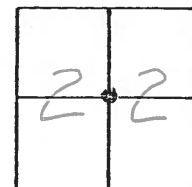

Q.D.O.T. DISTRICT 2 SURVEY OFFICE

SHEET 9 OF

County WOOD S.R. 18

Township JACKSON

Section 22

T3N, R9E

Personnel BARNHISEL


HOUSEHOLDER

LOEHKE

Date 11-25-83

Weather CLEAR, WINDY

Temp. +40°

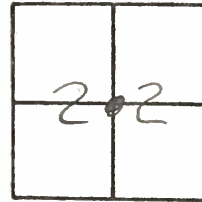

Fd RR SPIRE @ SURFACE

30 Rt of & PAVT 18

5.5 Lf of SEP


SLM 188+41

SET PK + WASHER

7-24-85

C.L

#9

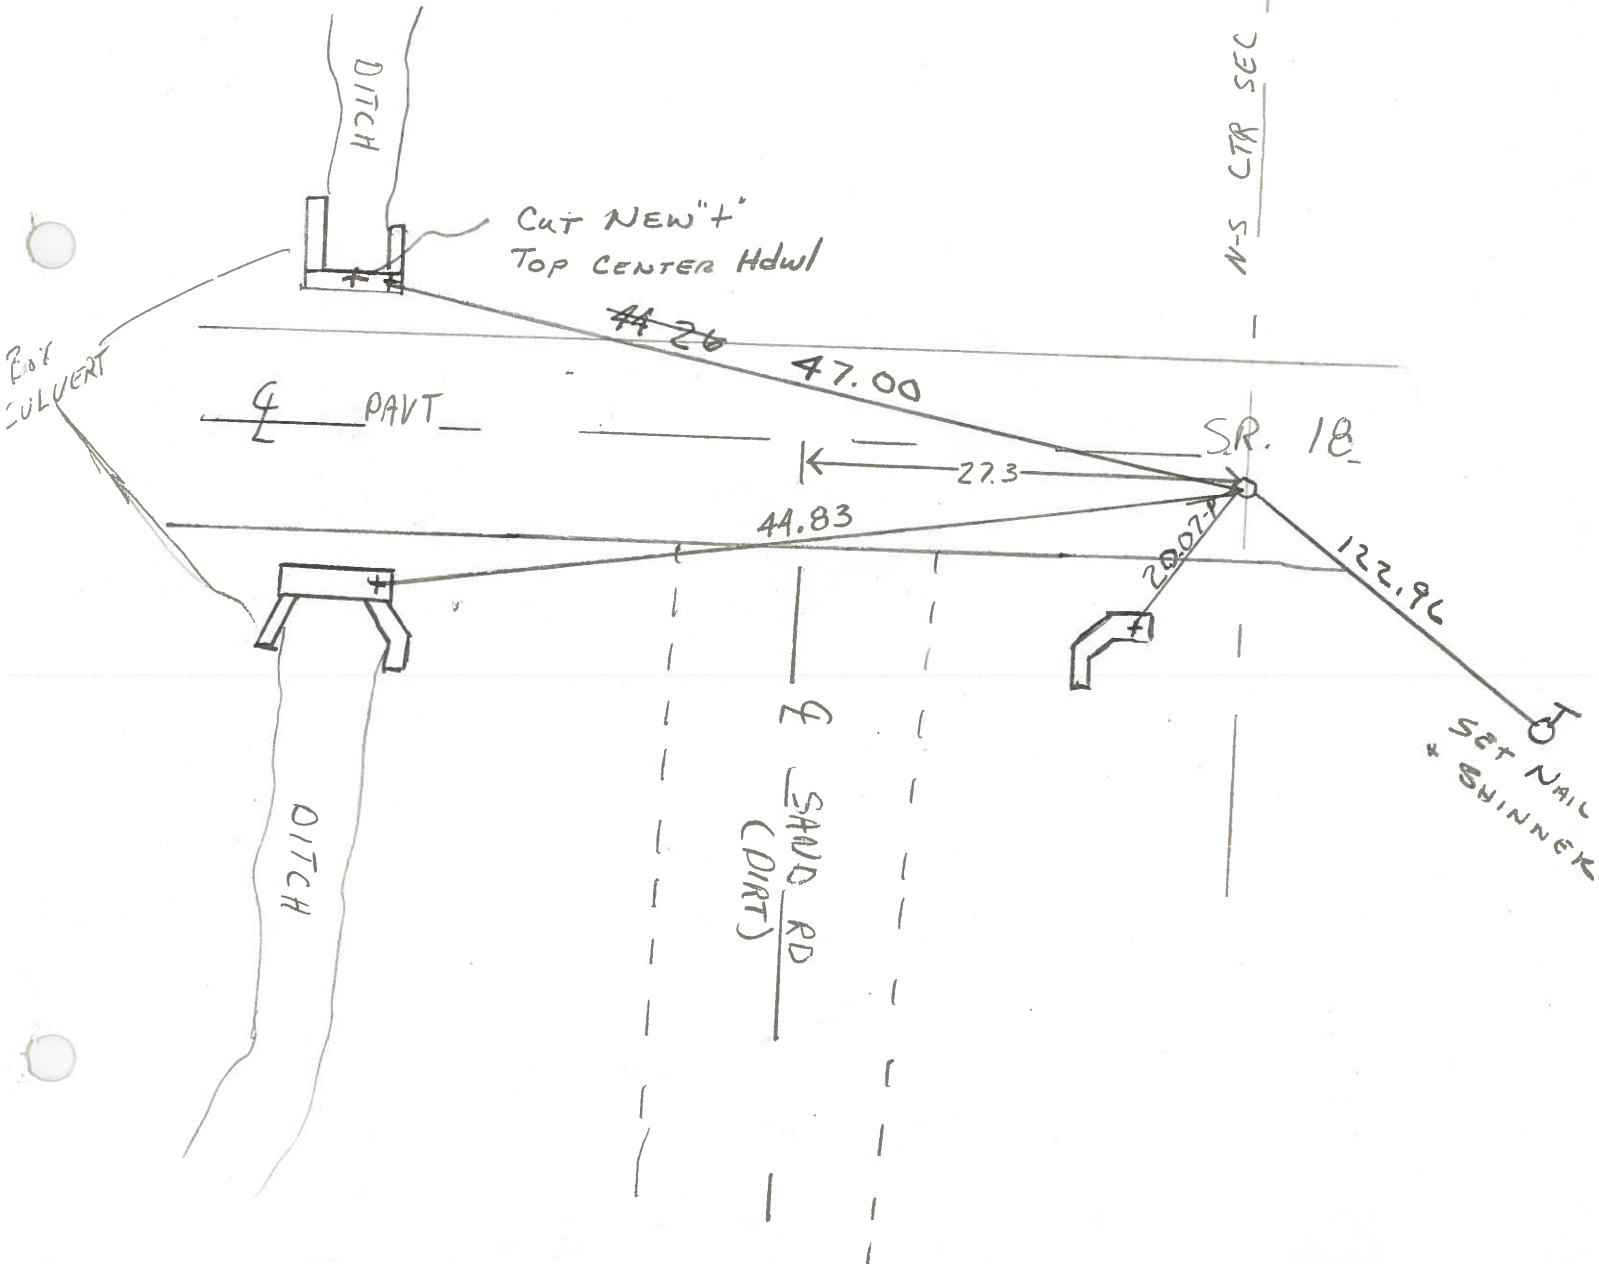

County WOOD S.R. 18

Date 11-25-83

Township JACKSON


Weather CLEAR WINDY

Section 22

Temp. +40°

T3N, R9E

Personnel BARTHISEL
HOUSEHOLDER
LEERKE

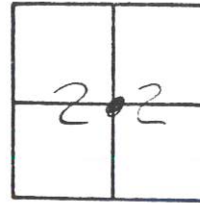


Fd. RR SPIKE @ SURFACE

2.9 30 Rt of C PAVT 18
 6.9 5.5 Lf of SEP
 SLM 188+41
 56

SET PK+WASHER
 7-24-85
 C.L

#9

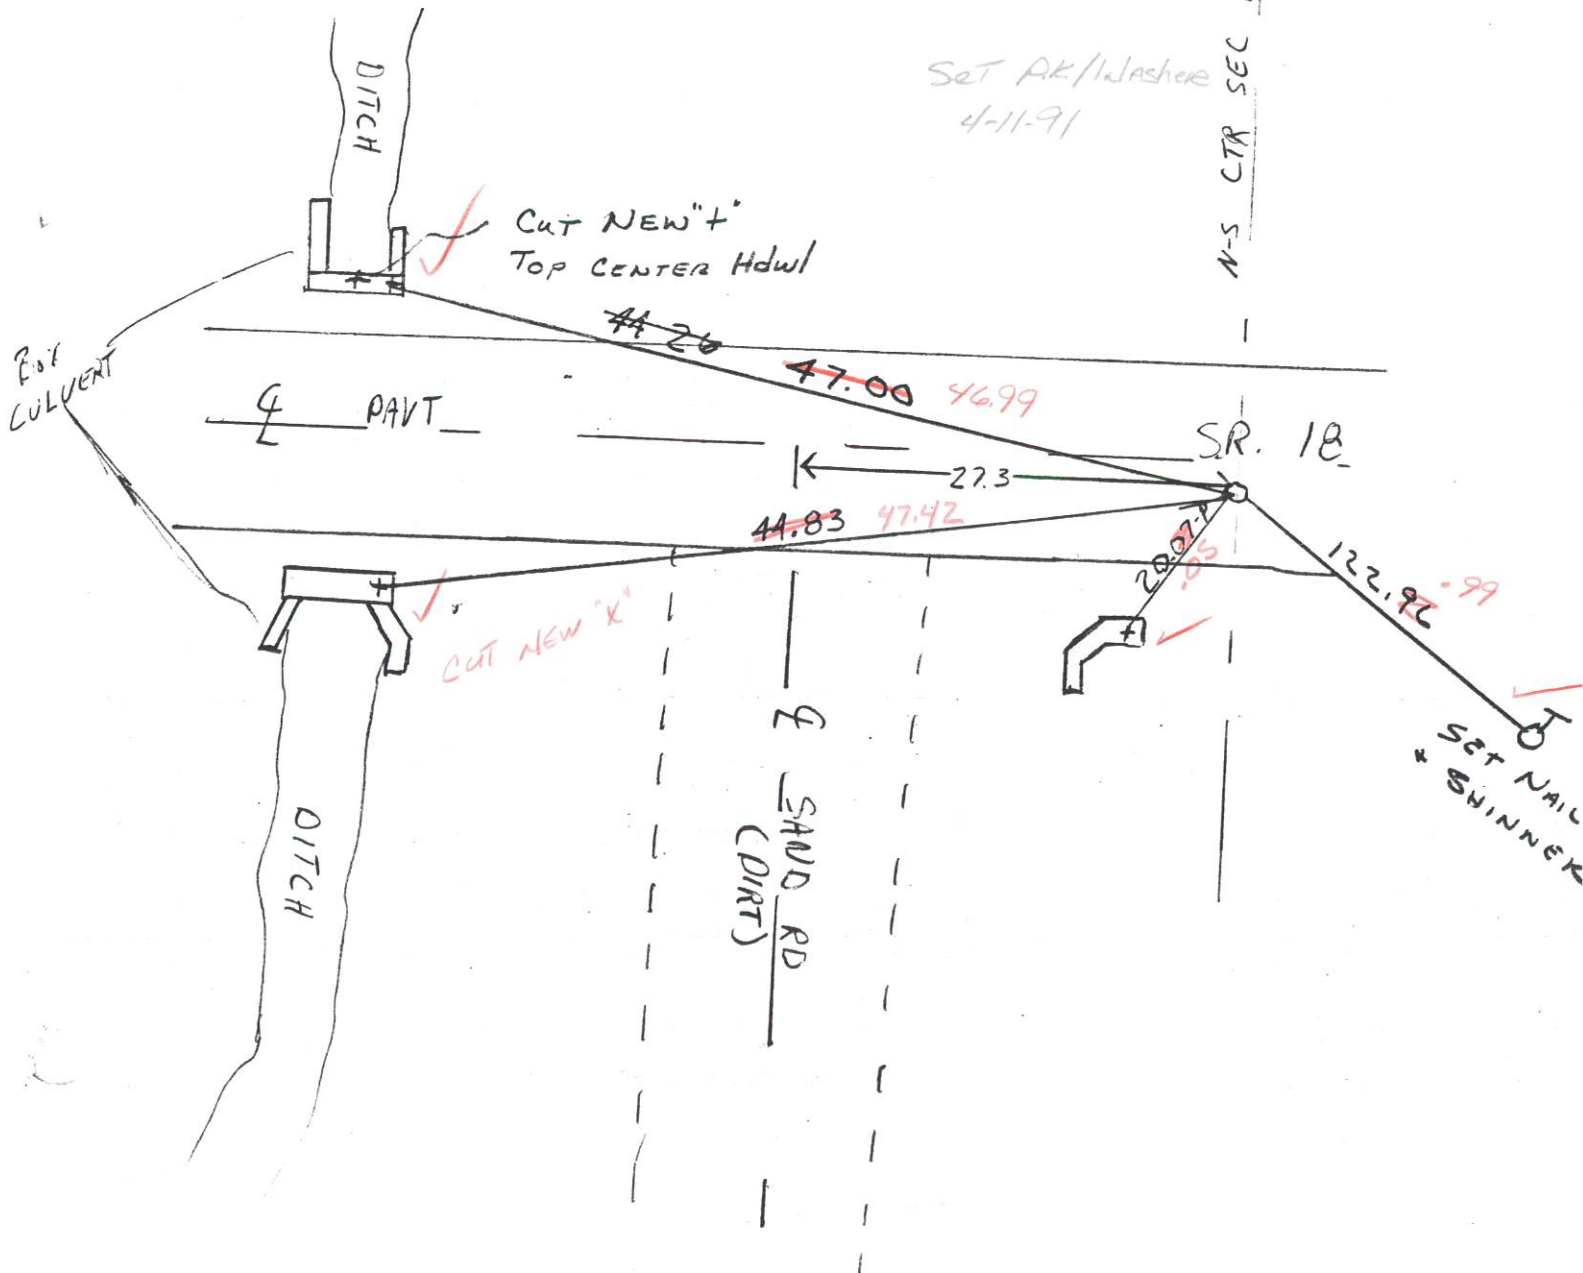

QD.O.T. DISTRICT 2 SURVEY OFFICE

SHEET _____ OF _____

County Wood S.R. 18

Township Jackson

Section 22

T3N, R9E

Personnel Hoffman

Householder


Loehrke

9


Date 7-13-82

Weather Humid - Clear

Temp. +84°

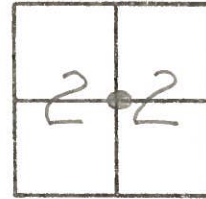

Fd R.R. Spk @ Surface
3.0' RT. of & Pavt SR18
5.5' TO S.E.P.
12.3' TO N.E.P.

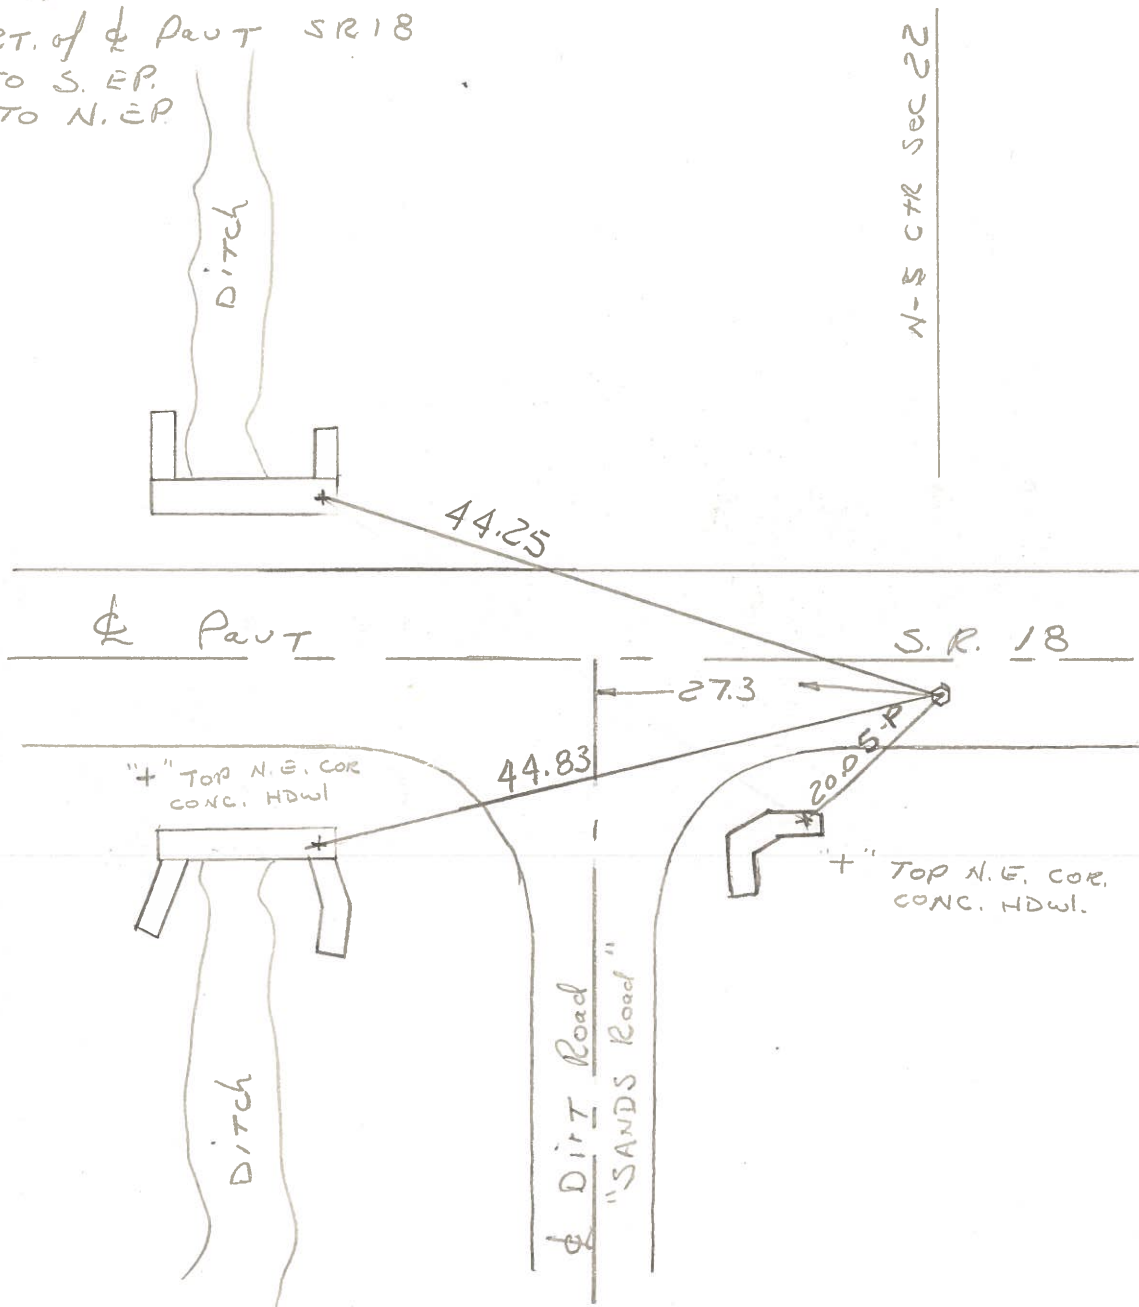

9 OF

