

O.D.O.T. DISTRICT 2 SURVEY OFFICE (USE ONLY)

PERSONNEL

REFERENCE NO. 10

SHEET 11 OF 15

NOTES RHOADES

DATE 6-12-20

ROUTE SR 18

H.C. AUBLE

WEATHER SUNNY

COUNTY WOOD

R.C. MAHLER

TEMP. 66°F

TOWNSHIP JACKSON

O'DONNELL

SECTION 23

DWG BY MAHLER

PID PAVE TRAIN

T 3 N R 9 E

TYPE MONUMENT MAG/WASHER

ON SURFACE - ~~BELOW~~ ON

OFFSET 0.3'

- TO - EDGE PAVEMENT


STATION: 214+98

HORIZ.DATUM: NAD83 (2011)


GEOID: NAVD88-2012A

GRID: NORTHING: 562999.894

EASTING: 1609800.234

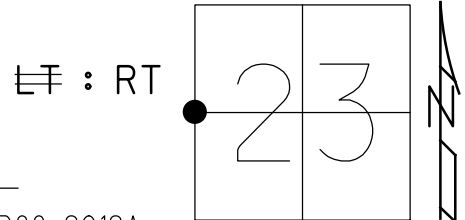

RECORD:
SET MAG/WASHER
7-26-05, DCH
FD P.K./WASHER
FD LG.R.R.SPIKE
3" DOWN
REF10
9-04-15
FD MAG/WASHER
REF10
6-12-20
FD 9-16-21, JFO

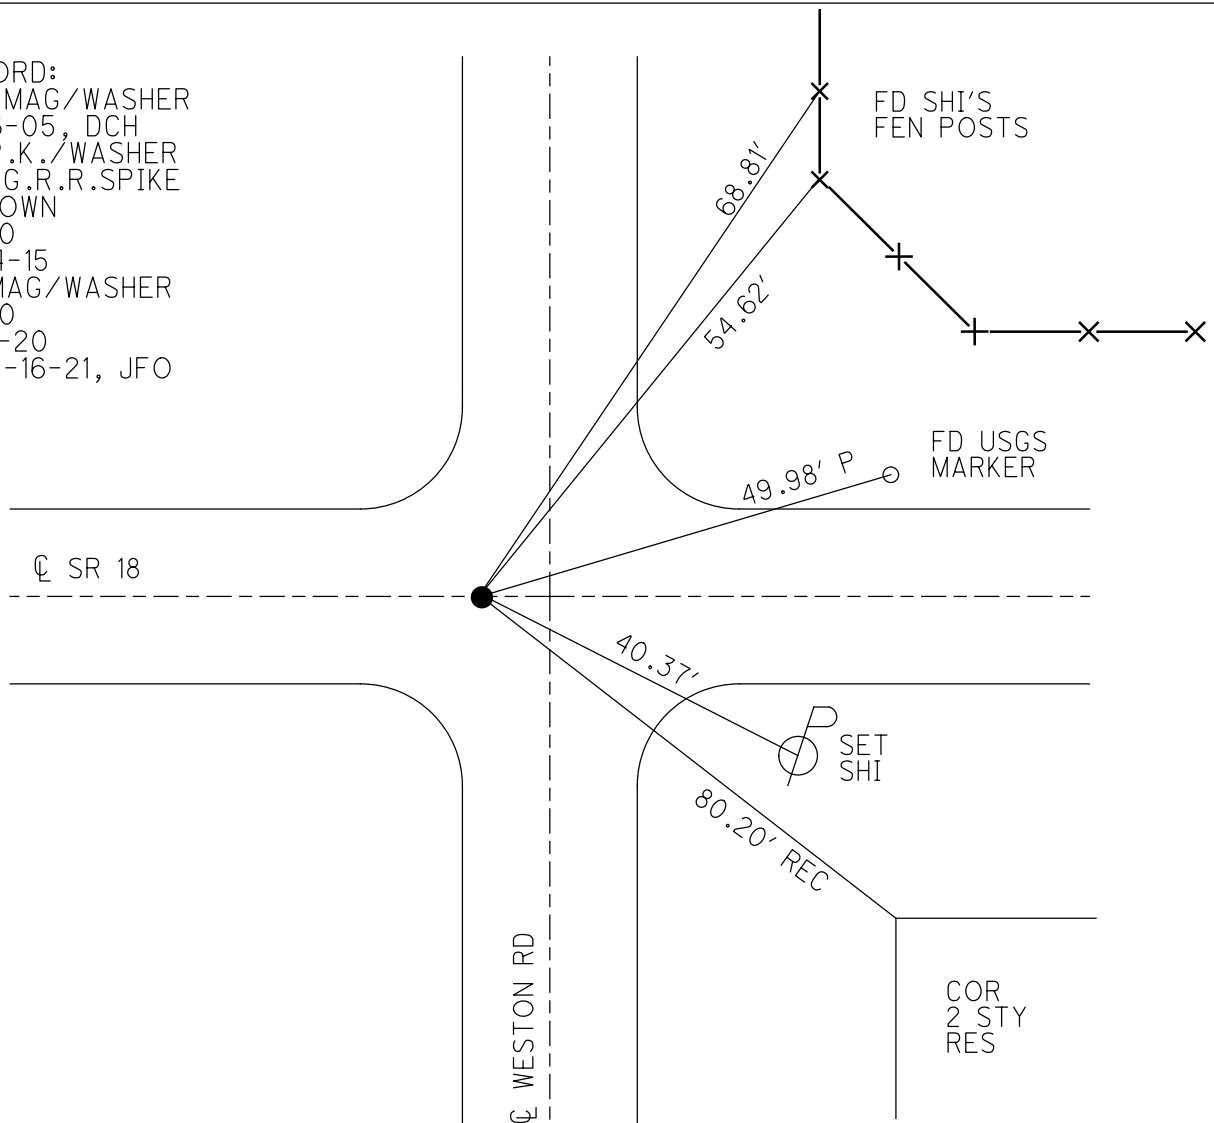

O.D.O.T. DISTRICT 2 SURVEY OFFICE (USE ONLY)

PERSONNEL

REFERENCE NO. 10

SHEET 11 OF 13

NOTES RHOADES

DATE 6-12-20

ROUTE SR 18

H.C. AUBLE

WEATHER SUNNY

COUNTY WOOD

R.C. MAHLER

TEMP. 66°F

TOWNSHIP JACKSON

O'DONNELL

SECTION 23

DWG BY MAHLER

PID PAVE TRAIN

T 3 N R 9 E

TYPE MONUMENT MAG/WASHER

ON SURFACE - ~~BELOW~~ ON

OFFSET 0.3', 9.0' W OF WESTON RD RT

TO EDGE PAVEMENT


STATION: 214+98

HORIZ.DATUM: NAD83 (2011)


GEOID: NAVD88-2012A

GRID: NORTHING: 562999.894

EASTING: 1609800.234

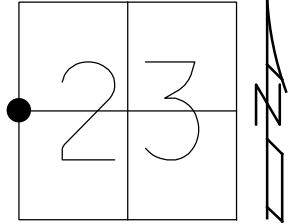

RECORD:
SET MAG/WASHER
7-26-05, DCH
FD PK/WASHER
FD LG RR.SPIKE
3" DOWN
REF10
9-04-15
FD MAG/WASHER
REF10
6-12-20, JFO

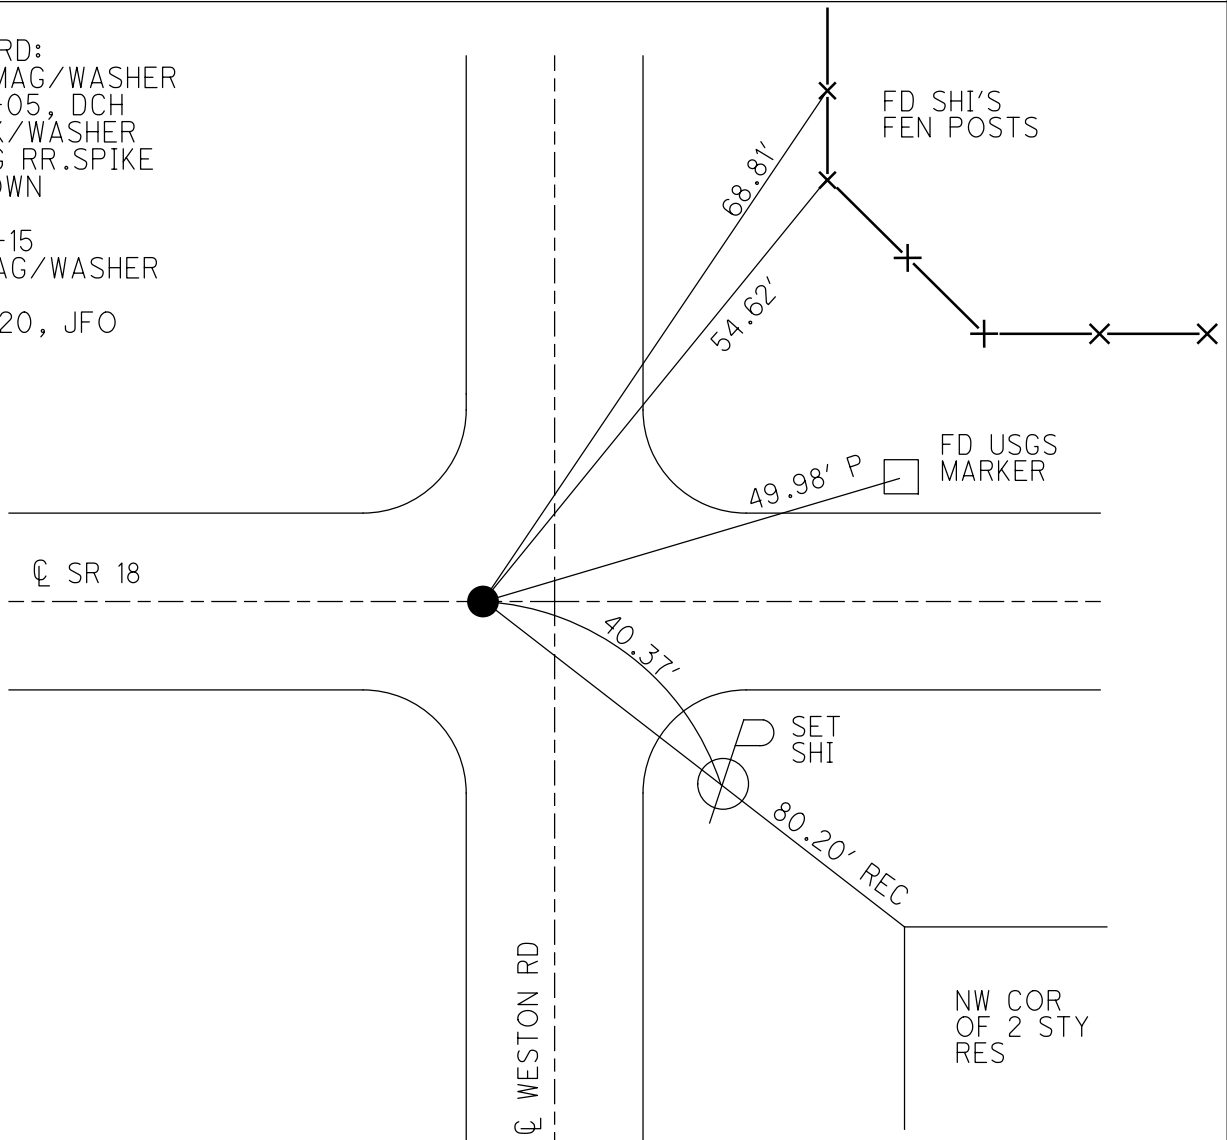

O.D.O.T. DISTRICT 2 SURVEY OFFICE (USE ONLY)

PERSONNEL _____ REFERENCE NO. 10 SHEET 11 OF 13
 NOTES _____ DATE 09-04-15 ROUTE SR 18
 H.C. LEU WEATHER PTLY CLOUDY COUNTY WOOD
 R.C. HOMAN TEMP. 85°F TOWNSHIP JACKSON
 SECTION 23
 T 3 N R 9 E


TYPE MONUMENT _____ MAG/WASHER _____

ON SURFACE - ~~BELOW~~ ON _____

~~LEFT~~ - CL PAV'T - RIGHT 0.3', 9.0' W OF CL WESTON RD
 - TO - EDGE PAVEMENT

S.L.M. 214+98

GRID: NORTHING: 562999.87 EASTING: 1609800.23

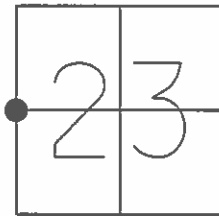


RECORD:
 SET MAG/WASHER
 7-26-05, DCH

FD PK/WASHER ON SURFACE

FD LG RR. SPK. 3" DOWN

GPS, REF10
 09-04-15

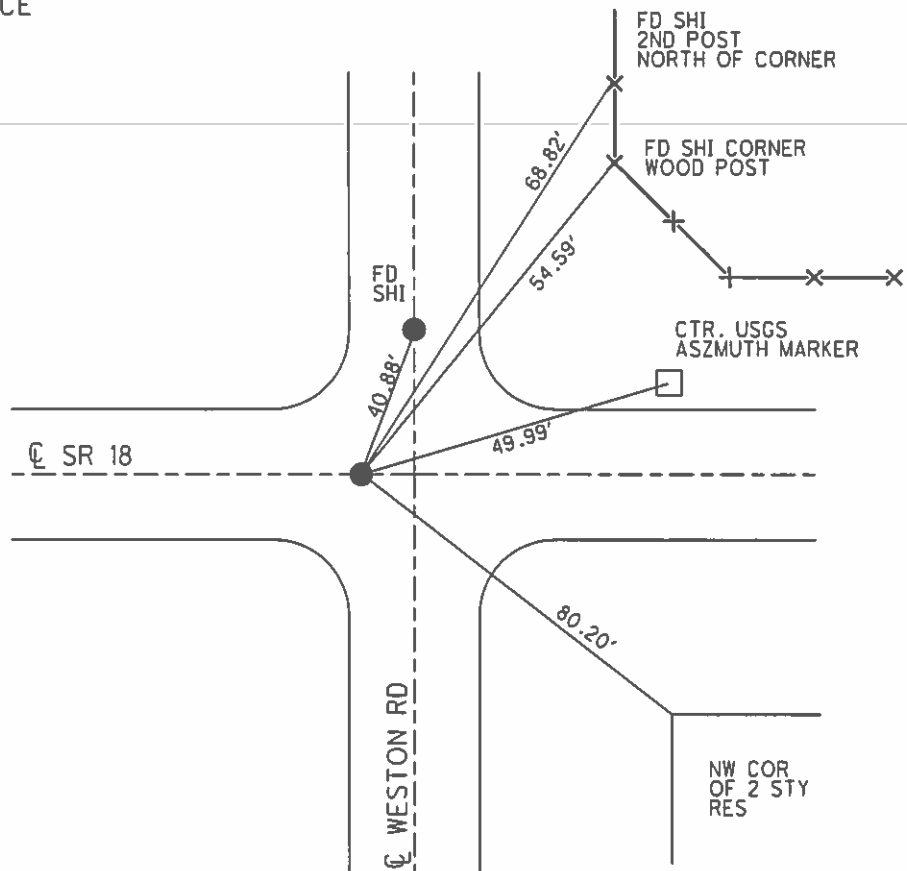

O.D.O.T. DISTRICT 2 SURVEY OFFICE

PERSONNEL

NOTES _____ STEVE
H.C. _____ JOE
R.C. _____ DUANE


REFERENCE NO. 10

DATE 4-16-05
WEATHER CLOUDY
TEMP. 56°

SHEET 10 OF 14


ROUTE S.R. 18
COUNTY WOOD
TOWNSHIP JACKSON
SECTION 23
T 3 N R 9 E

TYPE MONUMENT _____ PK & WASHER
ON SURFACE - ~~BELOW~~ _____ ON
~~LEFT - C PAVT~~ - RIGHT _____ 0.3'
_____ TO _____ EDGE PAVEMENT
S.L.M. 214+98 ; 9.0' W OF C WESTON RD

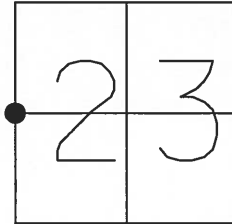

RESET MAG & WASHER
7-26-05
DCH

FD PK & WASHER ON SURFACE
FD LG RR SPIKE 3" DOWN

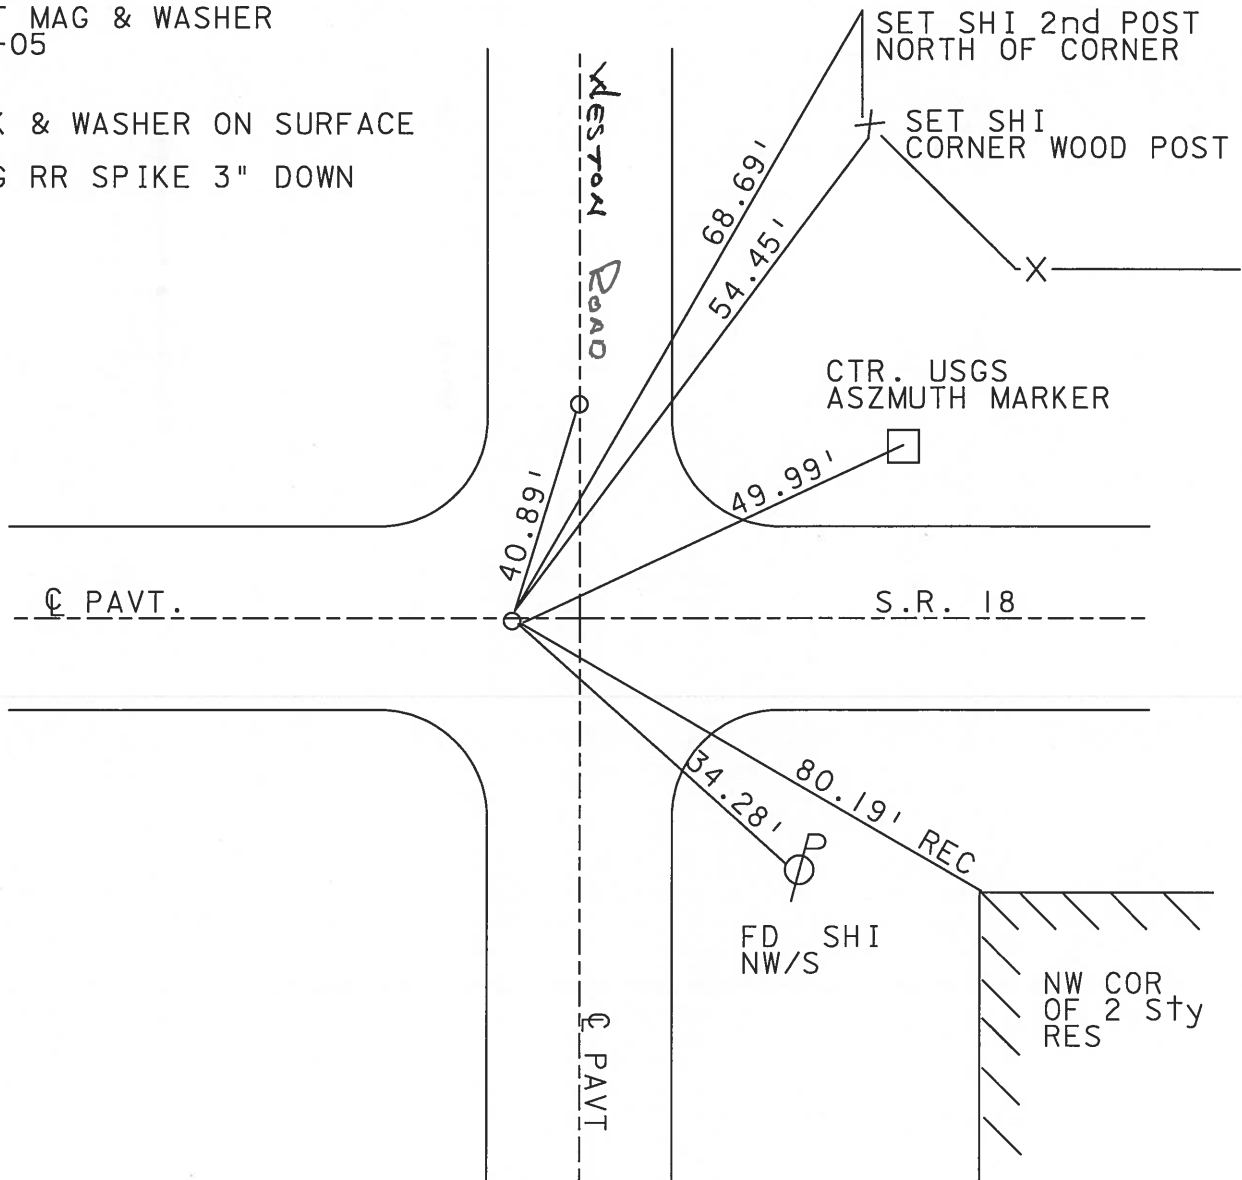

O.D.O.T. DISTRICT 2 SURVEY OFFICE

PERSONNEL

REFERENCE NO. 10

SHEET OF

NOTES BARNHISEL

H.C. Loehrke

R.C. HOFFMAN

DATE 3-19-91

WEATHER cloudy - windy

TEMP. +45°

ROUTE 18

COUNTY Wood

TOWNSHIP JACKSON

SECTION 23

T 3 N R 9 E

TYPE MONUMENT P.K. & Washer


ON SURFACE - BELOW yes

LEFT - & PAV'T. - RIGHT yes


 TO EDGE PAVEMENT

S.L.M. 214+98

9.0 W. OF & Weston Rd

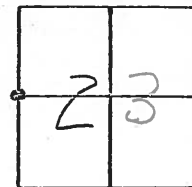

Set P.K./Washer
4-17-91
mB

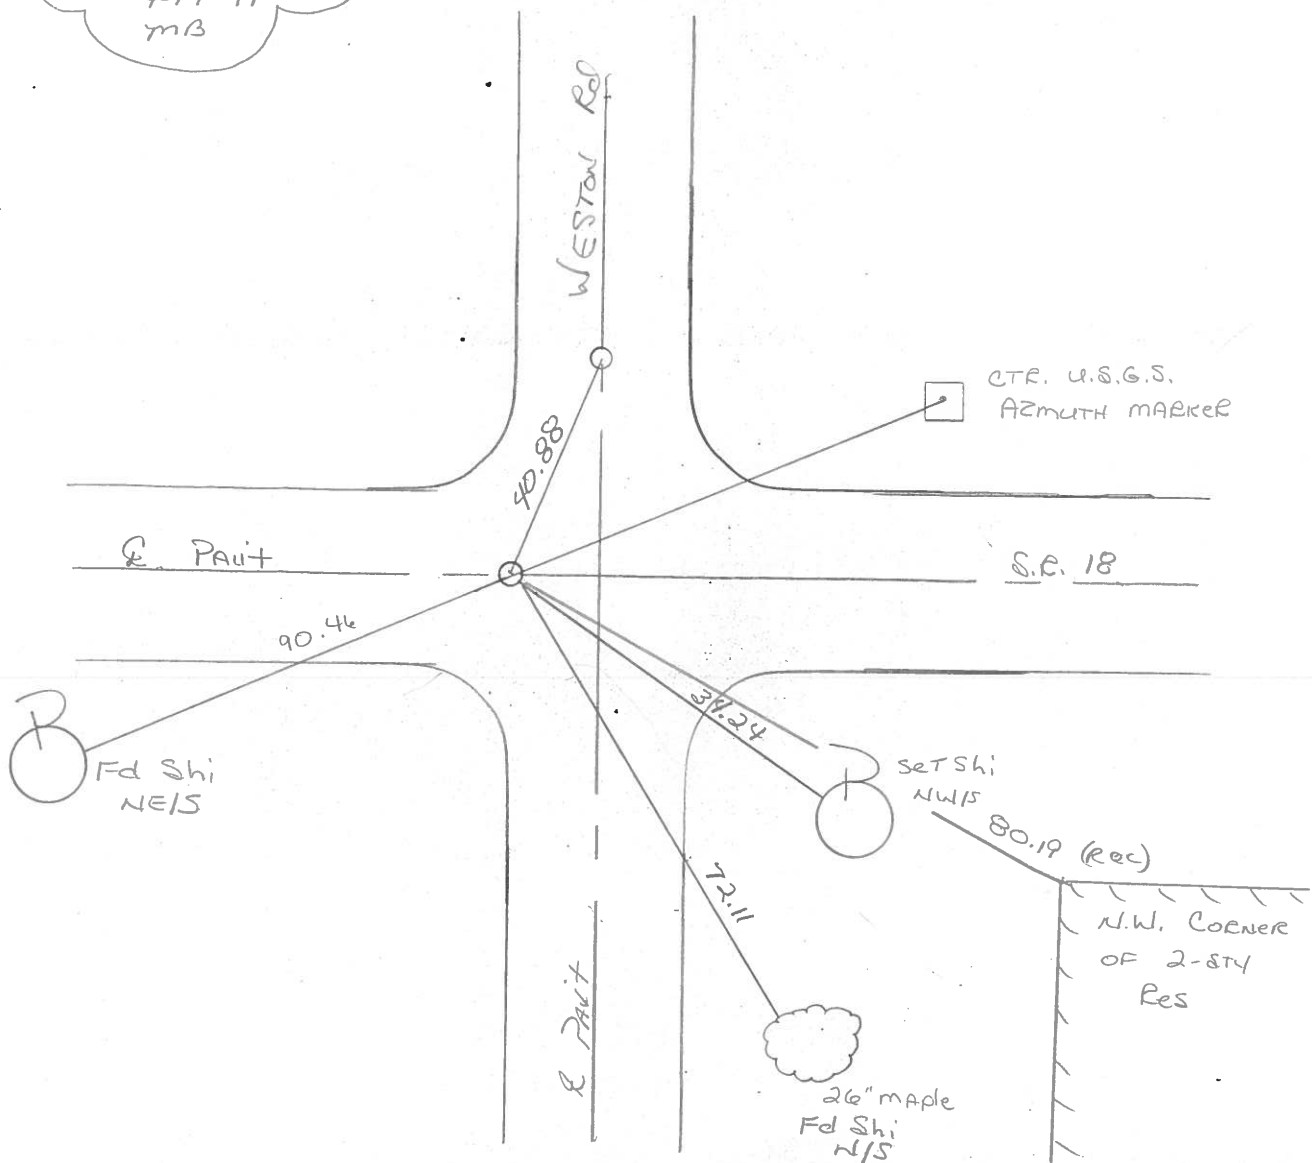

ODOT. DISTRICT 2 SURVEY OFFICE

SHEET 10 OF

County WOOD S.R. 18

Township JACKSON

Section 23

T3N, R9E

Personnel BARNHISEL HC


HOUSEHOLDER R.C

LOEHRKE ☒

Date 11-25-83

Weather CLEAR WINDY

Temp. +40°

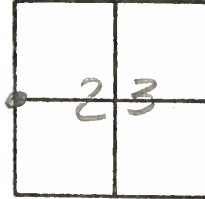

Fd RR SPIKE @ SURFACE

#10

SLM 2/4/83


ON Q PAVT 18

9.0 W of Q of Weston Rd

SET PK+WASHER


7-25-85

C.L.

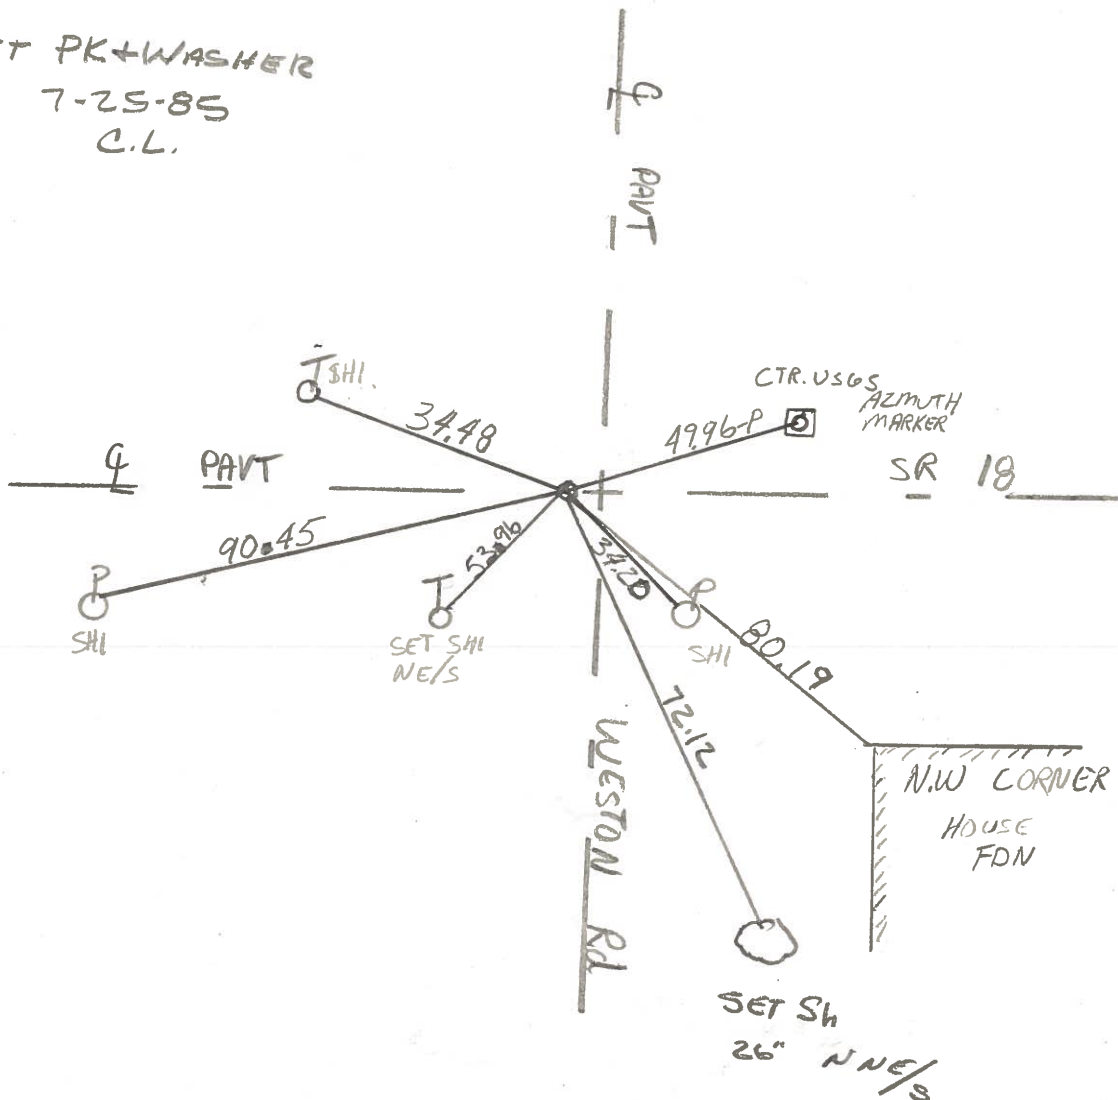

County WOOD S.R. 18Date 11-25-83Township JACKSONWeather CLEAR WINDYSection 23Temp. +40°

T3N, R9E

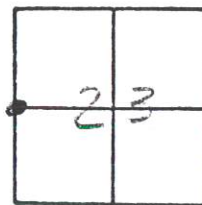Personnel BARNHISEL H.C.HOUSEHOLDER R.C.LOEHKE

Fd RR SPIKE @ SURFACE

SLM 2/4 +83 98


ON Q PAVT 189.0 W of Q of WESTON Rd

#10

SET PK+WASHER

7-25-85

C.L.

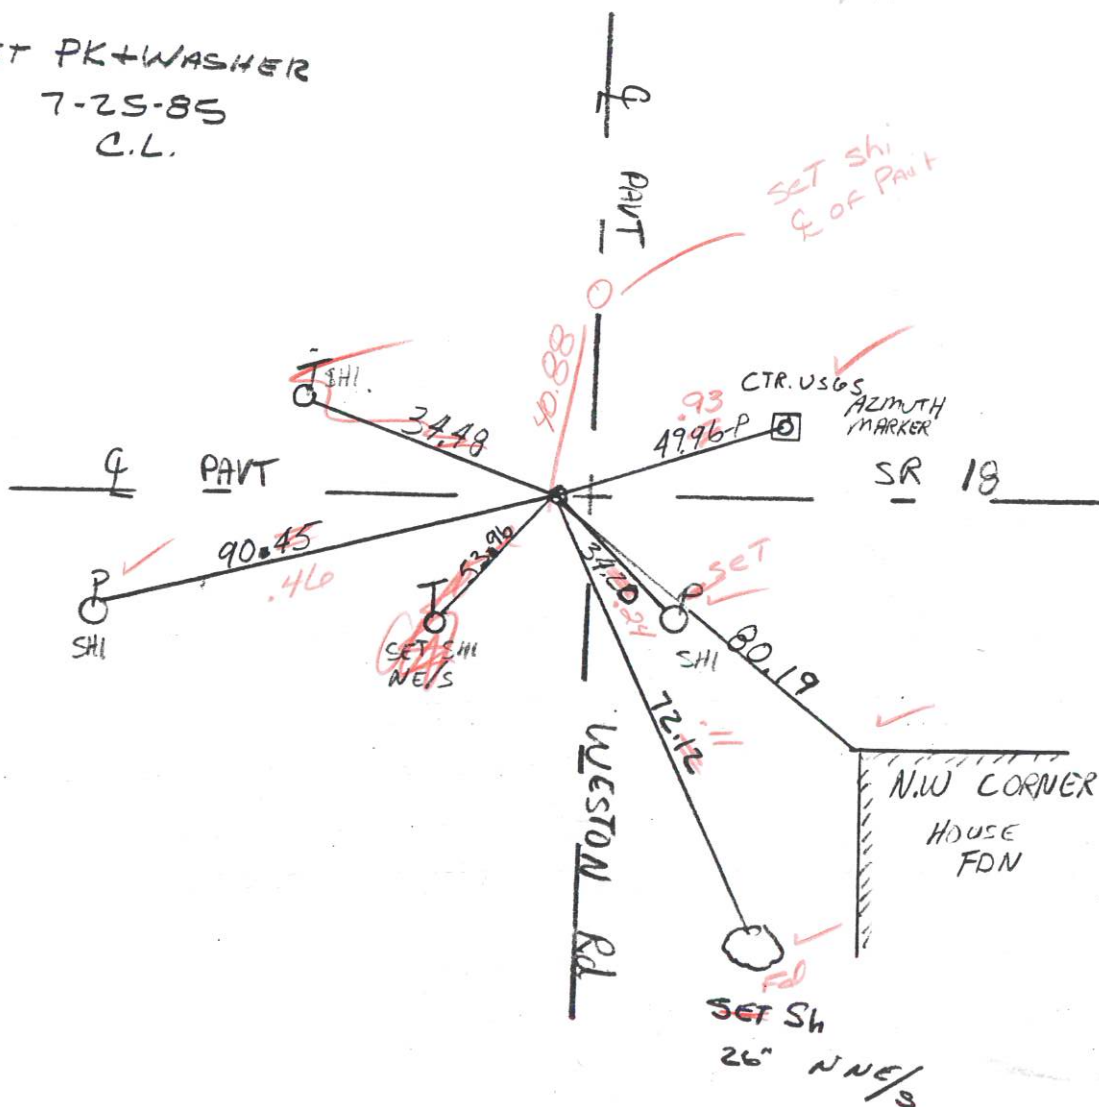SET PK/WASHER
4-11-91

SHEET 10 OF

Date 6-17-74

Weather CLOUDY

Temp. 60°


2	2

24

BOWERS

MEAD

KIOWSKI

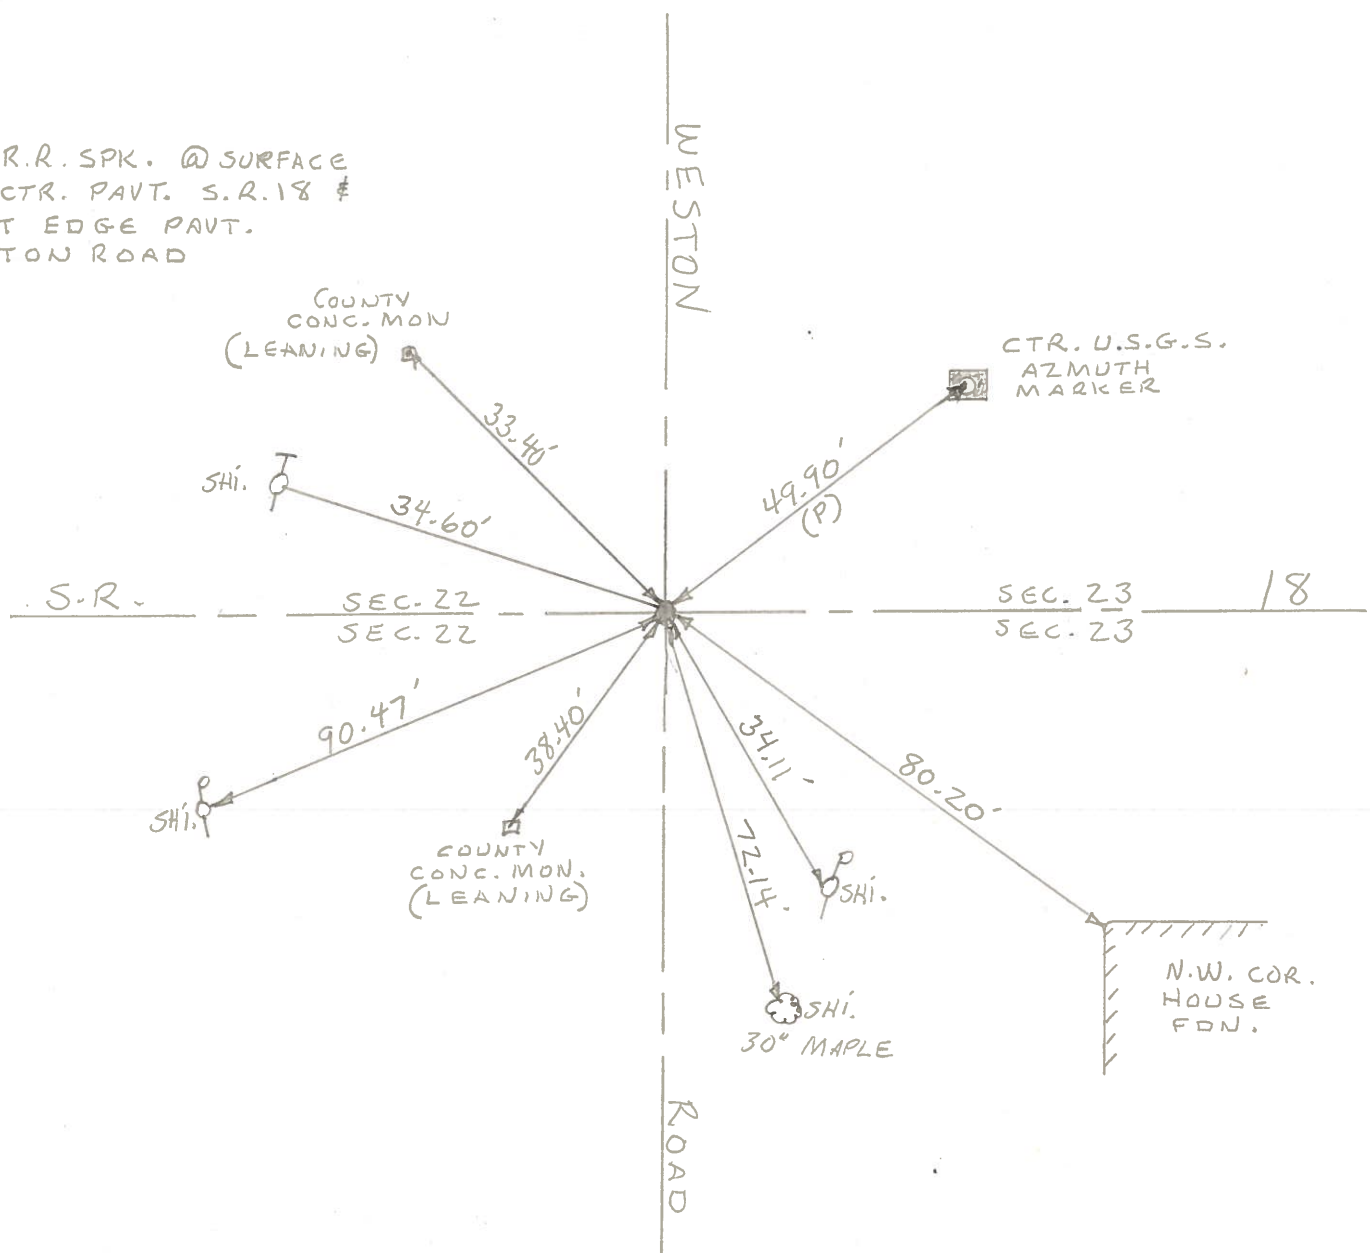

PERSONNEL	TITLE	PERSONNEL	TITLE	COUNTY	DATE
BURNSIDE		ROCCHINI		WOOD	6-18-71
SMITH				S. R. 18	WEATHER CLEAR
BOWERS				SEC. 22	WESTON RD
HOLCOMBE					TEMP. +85°

DESCRIPTION	LEFT	CENTER LINE	RIGHT	JOB NO.
-------------	------	-------------	-------	---------

NOTE:

R.R. Spk. is BELIEVED
TO BE TRUE SEC. COR.

COUNTY RECORD

STONE ABOUT 20' N. OF S. EDGE OF
E. & W. PAVE. & ABOUT 20' WEST OF
W. LINE OF PAVE. TO NORTH

CONC. MON. S.W. 38.53

CONC. MON. N.W. 33.80

CTR. U.S.G.S.
AZMUTH
MARKER



E 1/4 Post
SEC. 22
JACKSON TWP.

10

WESTON

ROAD

CONC. MON.
(LEANING)

SHI

FD. IRON BOLT
5.73' S.W. OF
R.R. Spk.

R.R. Spk.

N.W. COR.
Ho. Fdn.

SHI. IN
30' MAPLE

CONC.
MON.

SHI.

