

O.D.O.T. DISTRICT 2 SURVEY OFFICE (USE ONLY)

PERSONNEL

REFERENCE NO. 11

SHEET 12 OF 15

NOTES RHOADES
H.C. AUBLE
R.C. MAHLER
O'DONNELL

DATE 6-12-20
WEATHER SUNNY
TEMP. 66°F

ROUTE SR 18
COUNTY WOOD
TOWNSHIP JACKSON
SECTION 23

DWG BY MAHLER PID PAVE TRAIN

T 3 N R 9 E

TYPE MONUMENT MAG/WASHER

ON SURFACE - ~~BELOW~~ ON

OFFSET CL PAVEMENT 5.7' ~~LT~~ : RT

4.0' TO RT EDGE PAVEMENT


STATION: 241+43

HORIZ.DATUM: NAD83 (2011)


GEOID: NAVD88-2012A

GRID: NORTHING: 562922.421

EASTING: 1612443.484

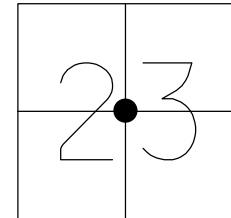

RECORD:
SET MAG/WASHER
6-19-05, DCH
REF11, 9-04-15
FD MAG/WASHER
REF11
6-12-20
9-16-21, JFO

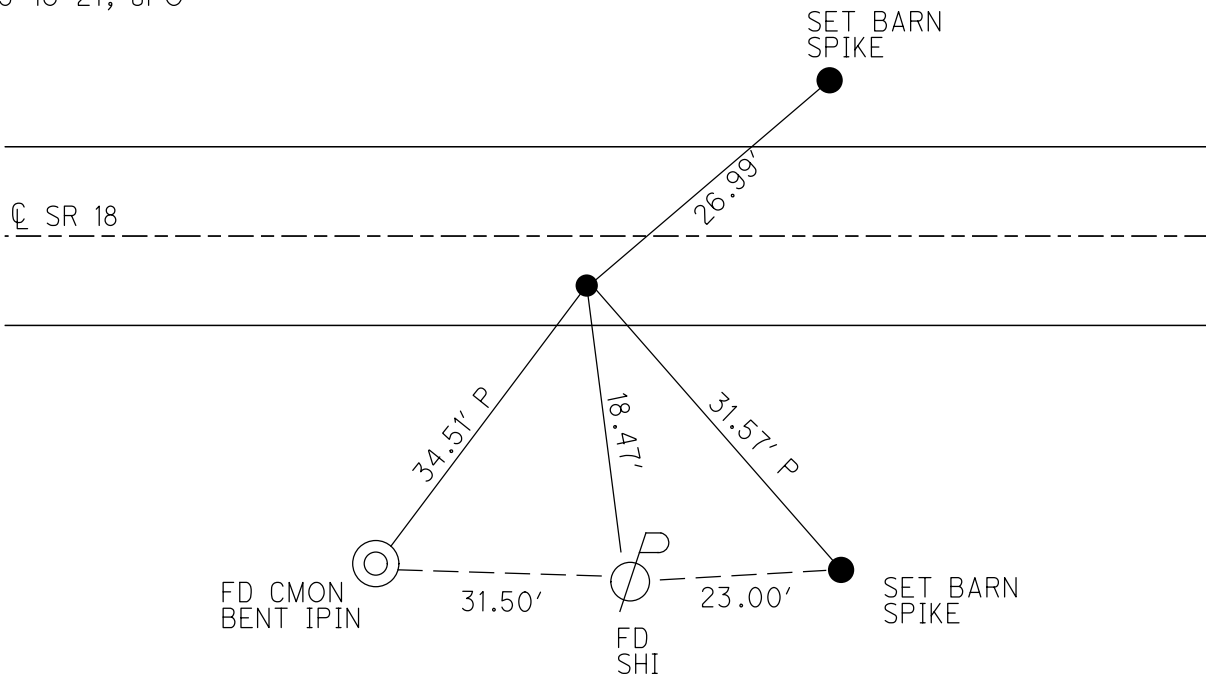

O.D.O.T. DISTRICT 2 SURVEY OFFICE (USE ONLY)

PERSONNEL

REFERENCE NO. 11

SHEET 12 OF 13

NOTES RHOADES

DATE 6-12-20

ROUTE SR 18

H.C. AUBLE

WEATHER SUNNY

COUNTY WOOD

R.C. MAHLER

TEMP. 66°F

TOWNSHIP JACKSON

O'DONNELL

SECTION 23

DWG BY MAHLER

PID PAVE TRAIN

T 3 N R 9 E

TYPE MONUMENT MAG/WASHER

ON SURFACE - ~~BELOW~~ ON

OFFSET 5.7' LT : RT

4.0' TO RT EDGE PAVEMENT


STATION: 241+43

HORIZ.DATUM: NAD83 (2011)


GEOID: NAVD88-2012A

GRID: NORTHING: 562922.421

EASTING: 1612443.484

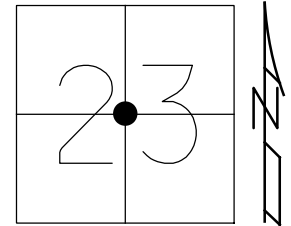

RECORD:
SET MAG/WASHER
6-19-05, DCH
REF11
9-04-15
FD MAG/WASHER
REF11
6-12-20, JFO

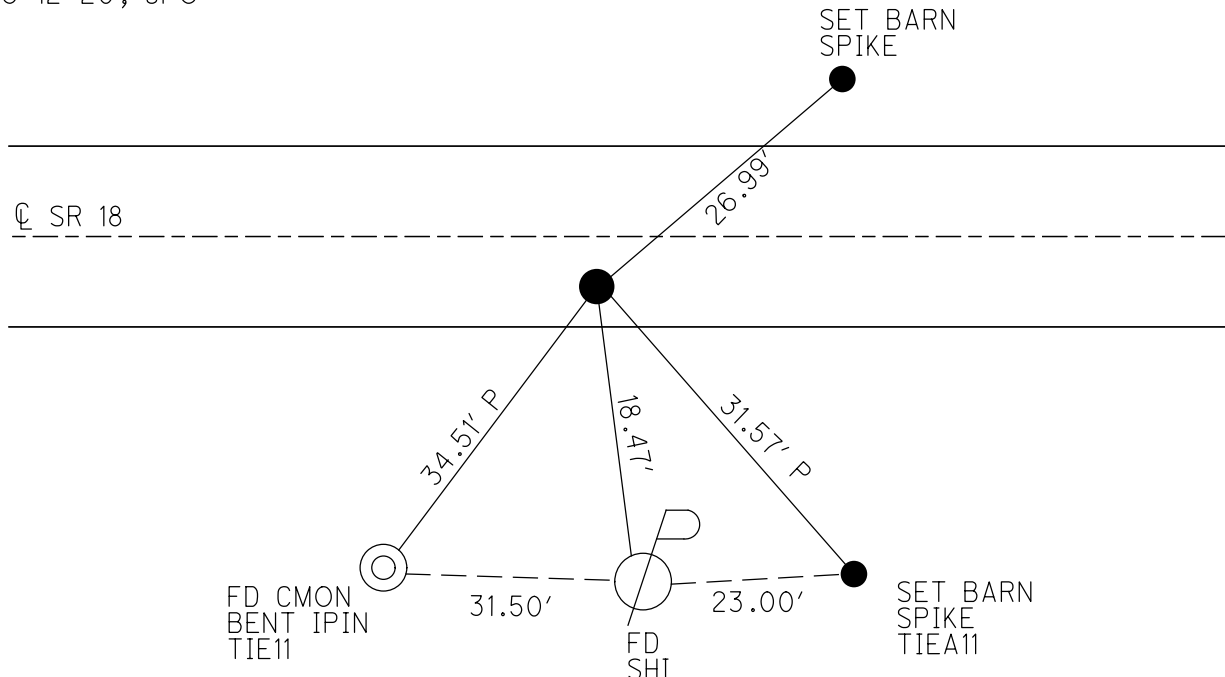

O.D.O.T. DISTRICT 2 SURVEY OFFICE (USE ONLY)

PERSONNEL

REFERENCE NO. 11

SHEET 12 OF 13

NOTES

LEU

DATE 09-04-15

ROUTE SR 18

H.C.

HOMAN

WEATHER PTLY CLOUDY

COUNTY WOOD

R.C.

LEU

TEMP. 85°F

TOWNSHIP JACKSON

SECTION 23

T 3 N R 9 E

TYPE MONUMENT MAG/WASHER


ON SURFACE - ~~BELOW~~ ON

~~LEFT~~ - CL PAV'T - RIGHT 5.7'

4.0' TO RT EDGE PAVEMENT

S.L.M. 241+43

GRID: NORTHING: 562922.35 EASTING: 1612443.52

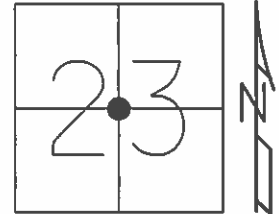


RECORD:
SET MAG/WASHER
6-19-05, DCH

GPS, REF11
09-04-15

CL SR 18

FD IPIN IN
CONC. MON.

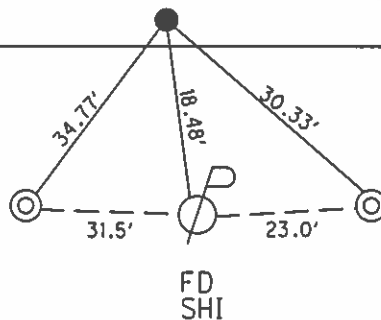

FD IPIN IN
CONC. MON

NOTE:
MONUMENT
DESTROYED.
IPIN BENT SW

O.D.O.T. DISTRICT 2 SURVEY OFFICE

PERSONNEL

REFERENCE NO. 11

SHEET 11 OF 14

NOTES STEVE

DATE 4-11-05

ROUTE S.R. 18

H.C. JOE

WEATHER CLOUDY

COUNTY WOOD

R.C. DUANE

TEMP. 58°

TOWNSHIP JACKSON

SECTION 23

T 3 N R 9 E


TYPE MONUMENT PK & WASHER

ON SURFACE - ~~BELOW~~ ON


~~LEFT - C PAVT~~ - RIGHT 5.7'

4.0' TO RT EDGE PAVEMENT

S.L.M. 241+43

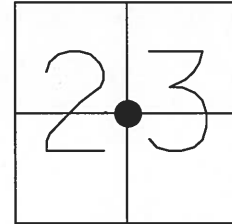

RESET MAG & WAHER
6-19-05
DCH

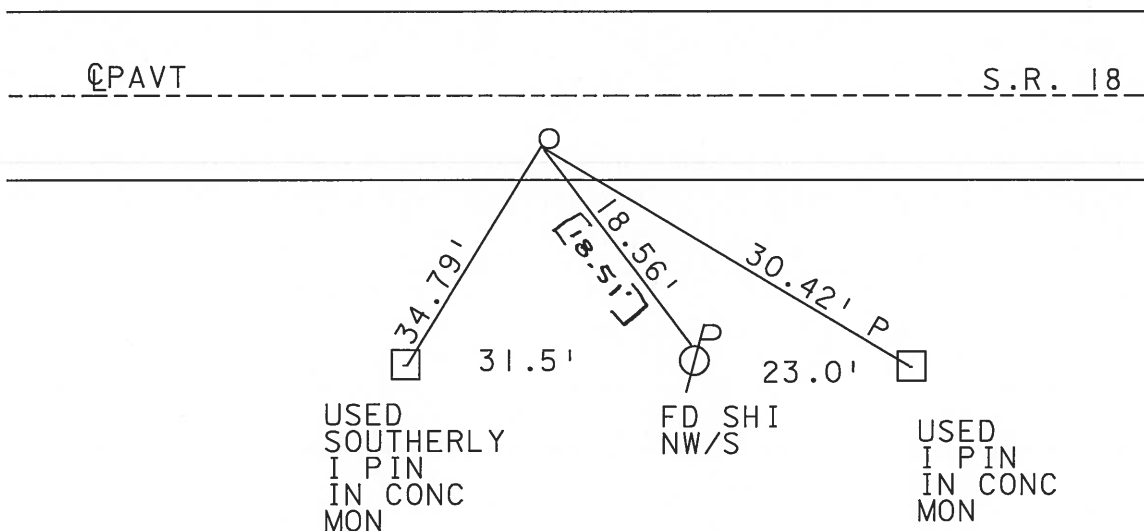

O.D.O.T. DISTRICT 2 SURVEY OFFICE

PERSONNEL

REFERENCE NO. 11

SHEET OF

NOTES BARNHISEL

H.C. Locher

R.C. Hoeffman

DATE 3-19-91

WEATHER cloudy - windy

TEMP. +45°

ROUTE 18

COUNTY WOOD

TOWNSHIP JACKSON

SECTION 23

T 3 N R 9 E


TYPE MONUMENT P.K. & Washer

ON SURFACE - BELOW yes


LEFT - & PAV'T. - RIGHT 5.6

4.4 TO RT EDGE PAVEMENT

S.L.M. 241 + 42

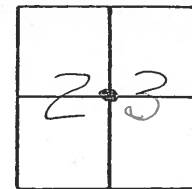

Set P.K. / Washer
4-17-91
MB

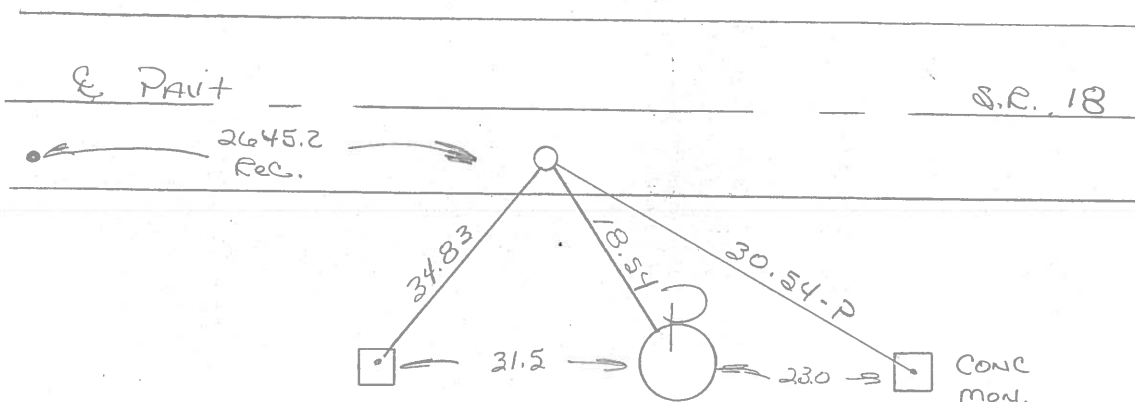

NOTE: THERE ARE "2" IRON RODS
IN BOTH MONU., WE USED THE ONE'S
WE CUT OFF A "2" ABOVE THE CONC.

ODOT. DISTRICT 2 SURVEY OFFICE

SHEET 11 OF

County WOOD S.R. 18

Township JACKSON

Section 23

T3N, R9E

Personnel BARNHISEL HC


HOUSEHOLDER R.C.

LOEMKE AD

Date 11-25-83

Weather CLEAR WINDY

Temp. +41°

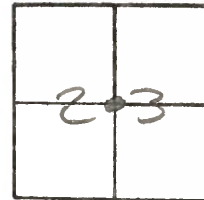

Fd RR SPIKE @ SURFACE

SLM 241+26

5.5 Rtof Q 18

3.7 Ltof SEP

SET PK+WASHEIZ

#11

7-25-85

CL


N-S CTR SEC 23

Q PAVT SR 18


2645.2' Rec

W 1/4 CORNER
Sec 23

E 1/4 COR
Sec 23

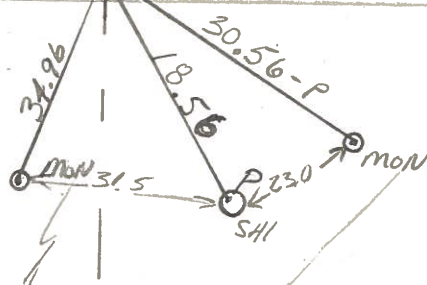

NOTE: IRON PINS IN
BOTH MONS. BECAUSE
MEASUREMENTS TAKEN TO
H WHERE PIN GOES INTO
CONCRETE

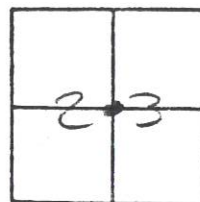County WOOD S.R. 18Date 11-25-83Township JACKSONWeather CLEAR WINDYSection 23Temp. +41°T3N, R9EPersonnel BINDHISEL HCHOUSEHOLDER R.CLEAHKE AD

Fd RR SPIKE @ SURFACE

SLM 241+26 425.6 5.5 RT of 4 184.4 3.7 L of SGP

SET PK+WASHER

#11

7-25-85

CL

SET PK/WASHER
4-11-91

N-S CTR SEC 23

PK.

Hub ①
26.26Hub ②
24.51

Q PAVT

SR 18

2645.2' Rec

W 1/4 CORNER
Sec 23E 1/4 COR
Sec 23

NOTE: IRON PINS IN
BOTH MONS. BENT
MEASUREMENTS TAKEN TO
H WHERE PIN GOES INTO
CONCRETE

NOTE: THERE ARE
2 I. Rods in both mons.
Used the one's we
CUT OFF 1/2" above CONC.

O.D.O.T. DISTRICT 2 SURVEY OFFICE

SHEET 11 OF

County WOOD S.R. 18

Date 6-17-74

Township JACKSON

Weather CLOUDY

Section 23

Temp. 60°

T3N, R9E


Personnel BURNSIDE

SMITH


BOWERS

MEAD

KIJOWSKI

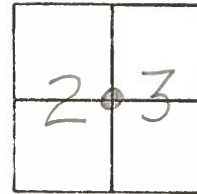

#11

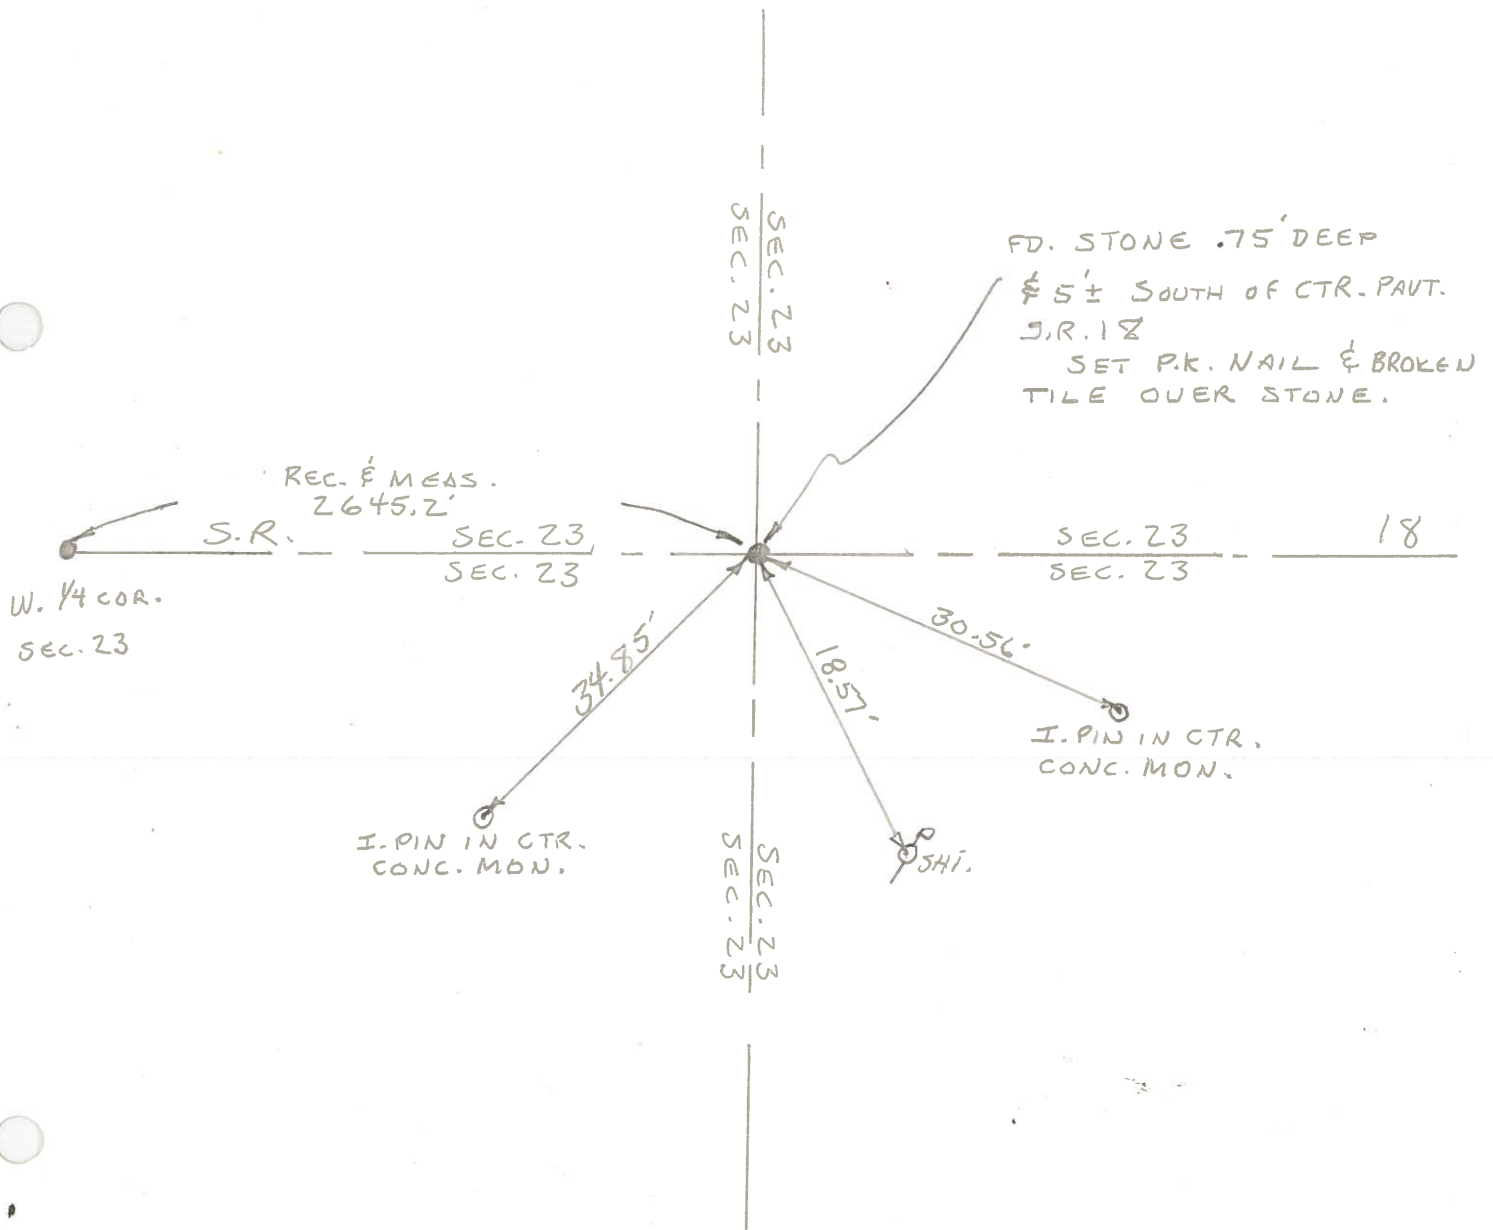

PERSONNEL TITLE PERSONNEL TITLE PERSONNEL TITLE
 DATE DATE DATE
 SHEET NO. 5
 DATE 12-13-57
 WEATHER
 TEMP
 SECS
 Ruffer
 #18

DESCRIPTION ON SOL LEFT CENTER LINE RIGHT JOB NO. (1960)

Int. 1/4 post sec. 23 Jackson Twp. gone Conc. mon. N.E. from stone 3
 Conc. mon. N.W. from stone 28

#112

E 1/4 post sec. 23 Jackson Twp. Stone
 OK 12-13-57 Found Belt
 S.E. #18 69
 2nd Conc. block below E.N.E. Conc. block porch 64
 Shiner in 24" Hickory S.E. 54
 Shiner in 12" Hickory N.W. 47
 Shiner in 30" maple N.E. 55
 Shiner in 20" maple E. 65

#113

S.E. Cor. sec. 23 Jackson Twp. Stone - P.R. spk. Set. Ed. Needles Ed.
 OK 12-13-57 Needles Ed.
 Conc. mon. N.W. 28.2
 Conc. mon. N.E. 36.5
 E.W. mon. S.E. 38.2
 N.E. Cor. Hdwl. S.W. 29.1
 Shiner 12" Red Cedar N.E. 64.2
 Shiner 18" Box Elder E.N.E. 55.7
 Shiner P. Pole S.S.E. 93.1

#114

E 1/4 sec. 26 Haysville Iron pin
 Ties check 12-13-57
 Pump N.W. 40
 Maple S.W. 38
 Intersection of walks S.E. 41

#115

S.E. Cor. sec. 26 Jackson Twp. Stone 30' E. of P.L. & N.S. of 2 of Survey
 No. ties - 12-13-57
 N.E. Cor. E. Conc. Hdwl. S.E. 29
 N.W. Cor. W. Conc. Hdwl. S.W. 32

#116