

O.D.O.T. DISTRICT 2 SURVEY OFFICE (USE ONLY)

PERSONNEL

REFERENCE NO. 12

SHEET 13 OF 15

NOTES RHOADES
H.C. O'DONNELL
R.C. MAHLER

DATE 6-12-20
WEATHER SUNNY
TEMP. 73°F

ROUTE SR 18
COUNTY WOOD
TOWNSHIP JACKSON
SECTION 23

DWG BY MAHLER PID PAVE TRAIN

T 3 N R 9 E

TYPE MONUMENT MAG/WASHER


ON SURFACE - ~~BELOW~~ ON

OFFSET CL PAVEMENT 1.0'

- TO - EDGE PAVEMENT

STATION: 267+94

RT : RT

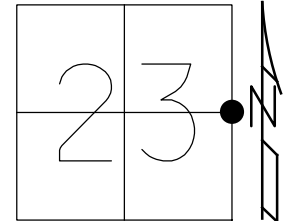


HORIZ.DATUM: NAD83 (2011)

GEOID: NAVD88-2012A

GRID: NORTHING: 562849.858

EASTING: 1615087.899

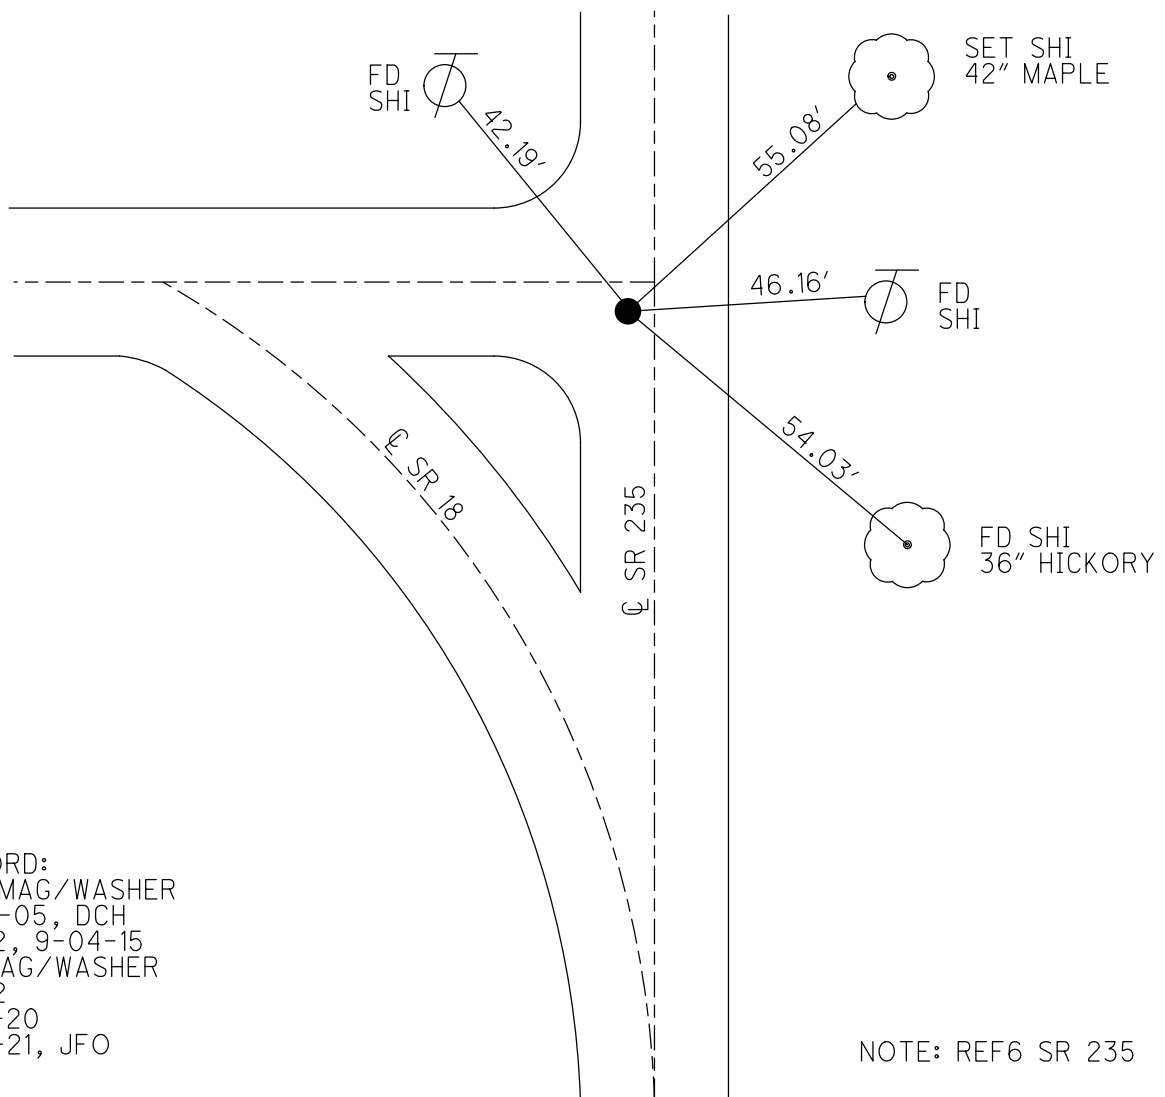

RECORD:
SET MAG/WASHER
7-26-05, DCH
REF12, 9-04-15
FD MAG/WASHER
REF12
6-12-20
9-16-21, JFO

NOTE: REF6 SR 235

O.D.O.T. DISTRICT 2 SURVEY OFFICE (USE ONLY)

PERSONNEL

REFERENCE NO. 12

SHEET 13 OF 13

NOTES RHOADES

DATE 6-12-20

ROUTE SR 18

H.C. O'DONNELL

WEATHER SUNNY

COUNTY WOOD

R.C. MAHLER

TEMP. 73°F

TOWNSHIP JACKSON

DWG BY MAHLER PID PAVE TRAIN

SECTION 23

T 3 N R 9 E

TYPE MONUMENT MAG/WASHER

ON SURFACE - ~~BELOW~~ ON

OFFSET CL PAVEMENT 1.0', 1.2' W OF CL SR 235 ~~LT~~ : RT

- TO - EDGE PAVEMENT



STATION: 267+94

HORZ.DATUM: NAD83 (2011)

GEOID: NAVD88-2012A

GRID: NORTHING: 562849.858

EASTING: 1615087.899

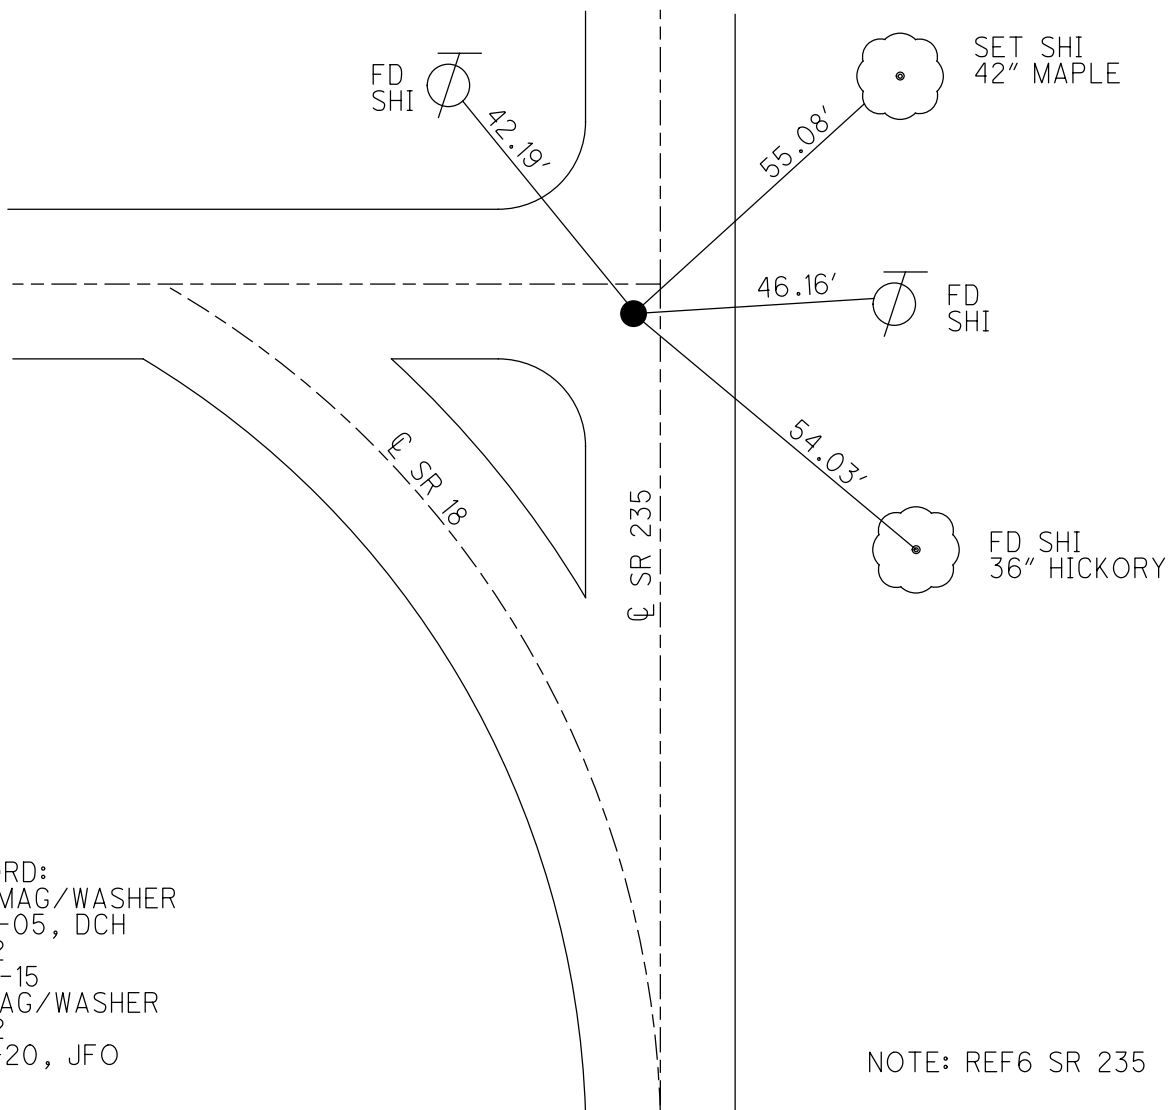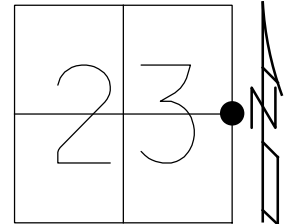


RECORD:
SET MAG/WASHER
7-26-05, DCH
REF12
9-04-15
FD MAG/WASHER
REF12
6-12-20, JFO

NOTE: REF6 SR 235

O.D.O.T. DISTRICT 2 SURVEY OFFICE (USE ONLY)


PERSONNEL _____ REFERENCE NO. 12 SHEET 13 OF 13
 NOTES LEU DATE 09-04-15 ROUTE SR 18
 H.C. HOMAN WEATHER PTLY CLOUDY COUNTY WOOD
 R.C. LEU TEMP. 85°F TOWNSHIP JACKSON
 _____ SECTION 23
 _____ T 3 N R 9 E

TYPE MONUMENT MAG/WASHER
 ON SURFACE - ~~BELOW~~ ON
~~LEFT~~ - CL PAV'T - RIGHT 1.0', 1.2' W OF CL SR 235
- TO - EDGE PAVEMENT
 S.L.M. 267+94
 GRID: NORTHING: 562849.89 EASTING: 1615087.83

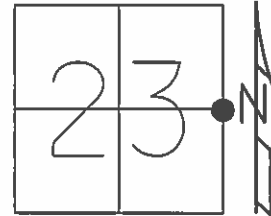

RECORD:
 SET MAG/WASHER
 7-26-05, DCH


GPS, REF12
 09-04-15

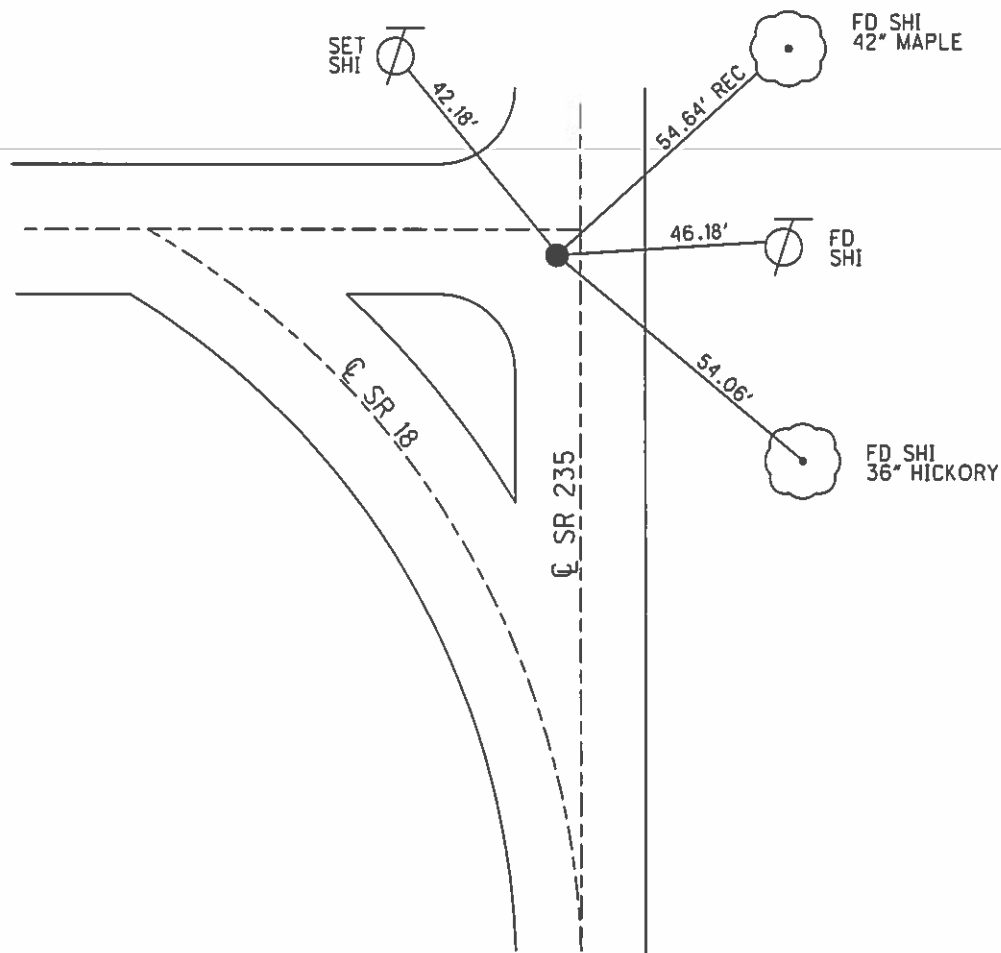

O.D.O.T. DISTRICT 2 SURVEY OFFICE (USE ONLY)

PERSONNEL	REFERENCE NO.	<u>6</u>	SHEET	<u>3</u>	OF	<u>26</u>
NOTES	<u>RHOADES</u>	DATE	<u>8-27-15</u>	ROUTE	<u>SR 235</u>	
H.C.	<u>O'DONNELL</u>	WEATHER	<u>CLOUDY</u>	COUNTY	<u>WOOD</u>	
R.C.	<u>RHOADES</u>	TEMP.	<u>70°F</u>	TOWNSHIP	<u>JACKSON</u>	
				SECTION	<u>23</u>	
				T	<u>3</u>	N
				R	<u>9</u>	E

TYPE MONUMENT PK/WASHER
 ON SURFACE - ~~BELOW~~ ON
 LEFT - Q PAV'T - ~~RIGHT~~ 1.4'
7.9' TO LT EDGE PAVEMENT
 S.L.M. 132+92.51

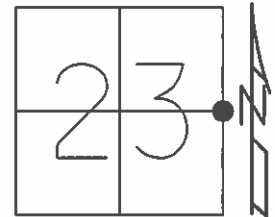


Grid: Northing: 562849.898 Easting: 1615087.839

RECORD:
 SET SM RR. SPIKE
 6-26-86, MDB

SET MAG/WASHER
 7-26-05, DCH

GPS, REF6
 8-27-15

GPS, REF12
 09-04-15

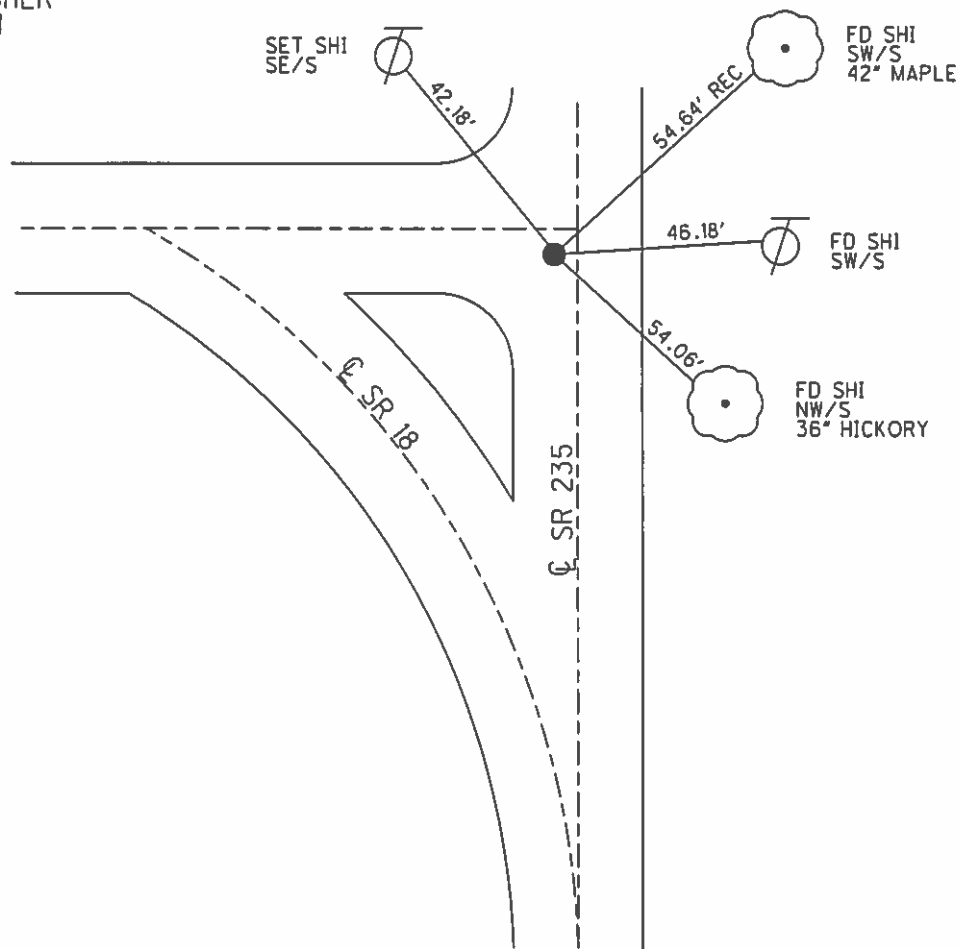

O.D.O.T. DISTRICT 2 SURVEY OFFICE

PERSONNEL

NOTES _____ STEVE
H.C. _____ DUANE
R.C. _____ JOE


REFERENCE NO. 12

DATE 4-06-05
WEATHER CLEAR
TEMP. 65°


SHEET 12 OF 14

ROUTE S.R. 18
COUNTY WOOD
TOWNSHIP JACKSON
SECTION 23
T 3 N R 9 E

TYPE MONUMENT PK & WASHER
ON SURFACE - ~~BELOW~~ ON
~~LEFT - C PAVT~~ - RIGHT 1.0'
TO EDGE PAVEMENT
S.L.M. 267+94 ; 1.2' W OF C SR 235

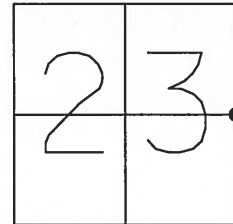

RESET MAG & WAHER
7-26-05
DCH

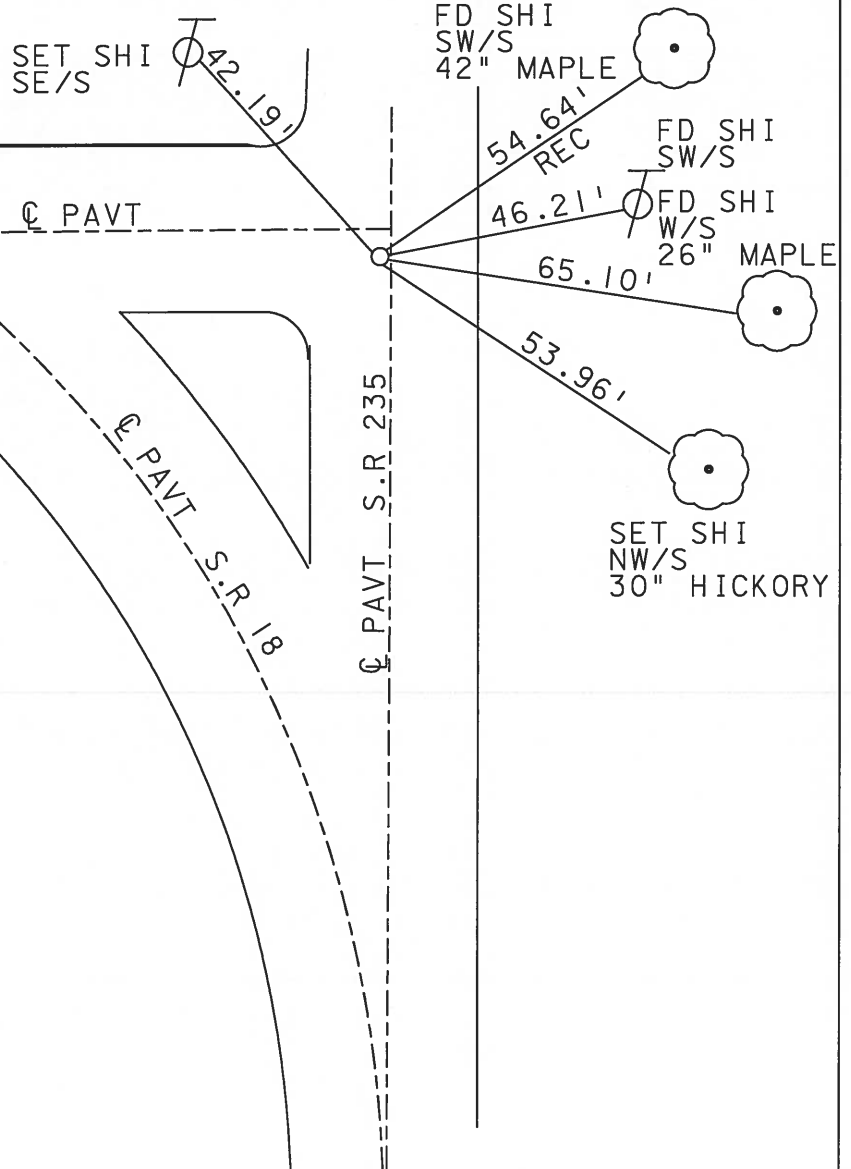

O.D.O.T. DISTRICT 2 SURVEY OFFICE

PERSONNEL

REFERENCE NO. 12

SHEET OF

NOTES BARNHISEL

H.C. Loehke

R.C. HOFFMAN

DATE 3-19-91

WEATHER cloudy - windy

TEMP. +45°

ROUTE 18

COUNTY WOOD

TOWNSHIP JACKSON

SECTION 23

T 3 N R 9 E


TYPE MONUMENT Sm RE Spk

ON SURFACE - BELOW yes

LEFT - E PAV'T. - RIGHT 0.9 E S.E. 235

10.0 TO LT EDGE PAVEMENT OF S.E. 235

S.L.M. 2.2 S. OF E West

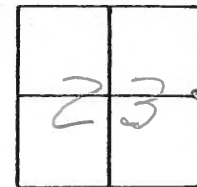

Set P.K./Washer
4-17-91
MB



S.E. 235



54.64

42" maple

46.24



26" maple
Fd Shi W/S

65.09

54.22



30" Hickory
Fd Shi NW/S

E PAV'T

E PAV'T

GRASS

S.E. 13

E PAV'T

Q.D.O.T. DISTRICT 2 SURVEY OFFICE

SHEET 12 OF

County WOOD S.R. 18

Township JACKSON

Section 23

T.N, R.E

Personnel BARNHISEL HC


HOUSEHOLDER RC

LOEHRKE

Date 11-25-83

Weather CLEAR, WINDY


Temp. + 40°

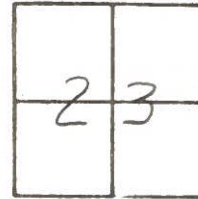

Fd RR SPIKE 1" BELOW SURFACE
ON & PAVT SR 18 TO WEST
ON & PAVT SR 235

NOT COVERED
THIS JOB

#12

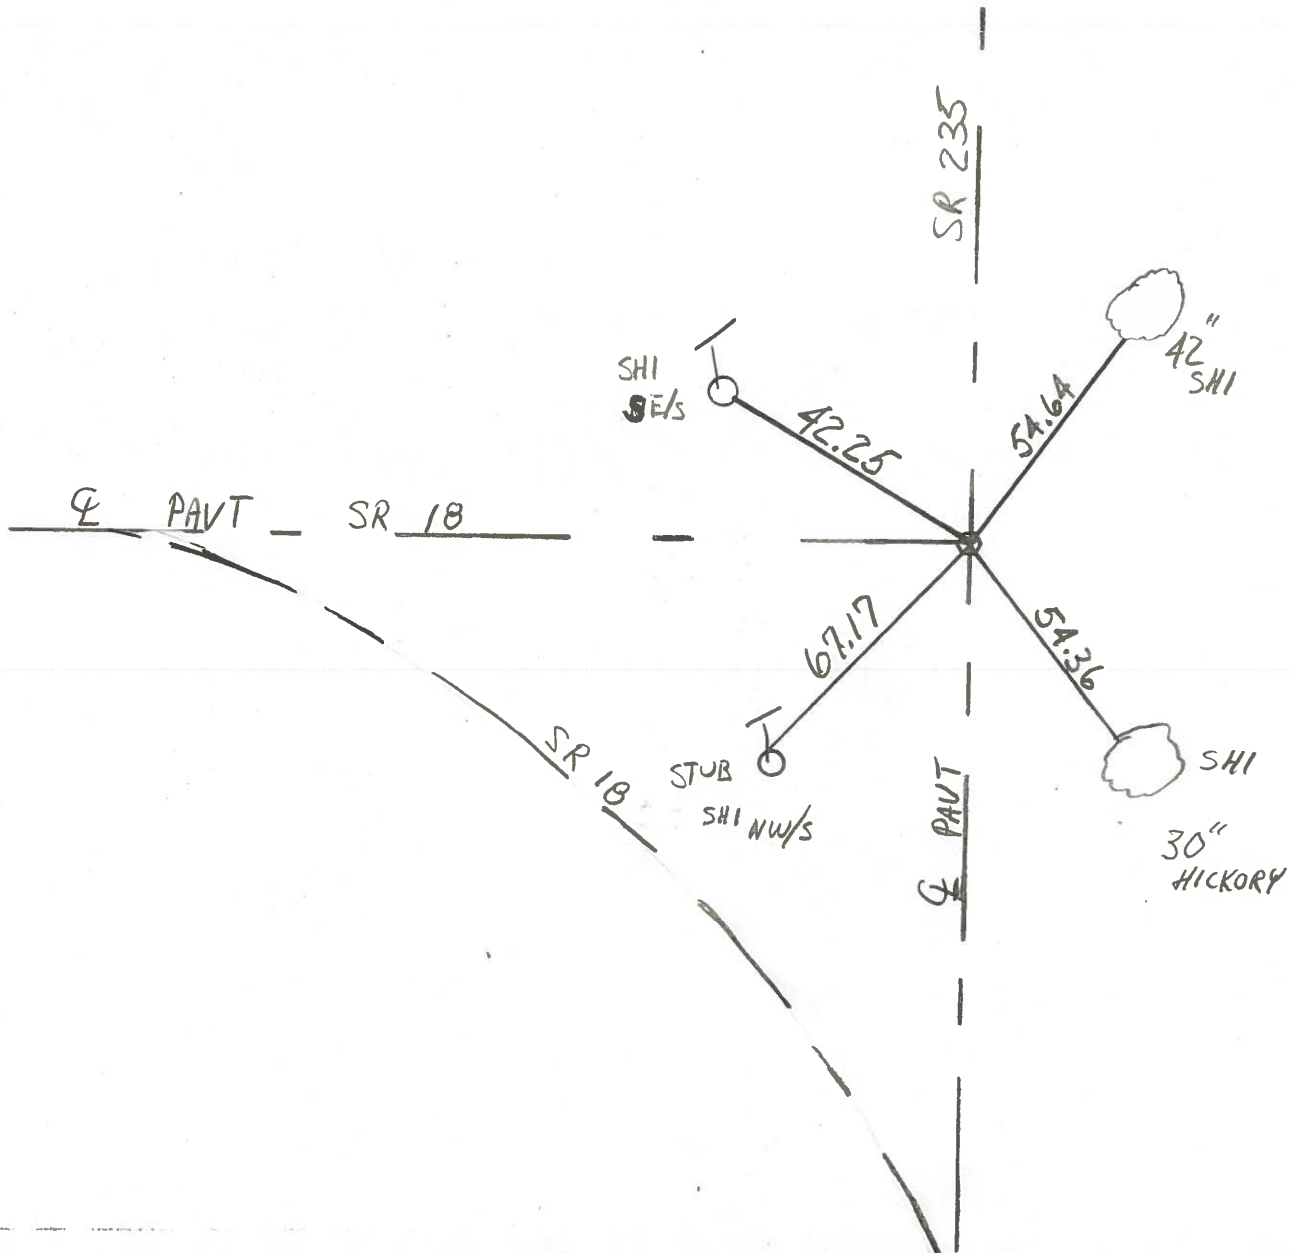

County WOOD S.R. 18

Date 11-25-83

Township JACKSON


Weather CLEAR, WINDY

Section 23

Temp. + 40°

T.N., R.E


Personnel BARNHISEL HC
HOUSEHOLDER RC
LOEHKE

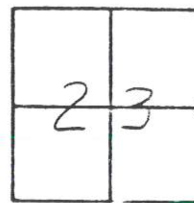

Fd RR SPIKE 1" BELOW SURFACE
2.2 S ON & PAVT SR 18 TO WEST
.9 ON & PAVT SR 235
10. W. OF E. Edge 235

NOT COVERED
THIS JOB

#12

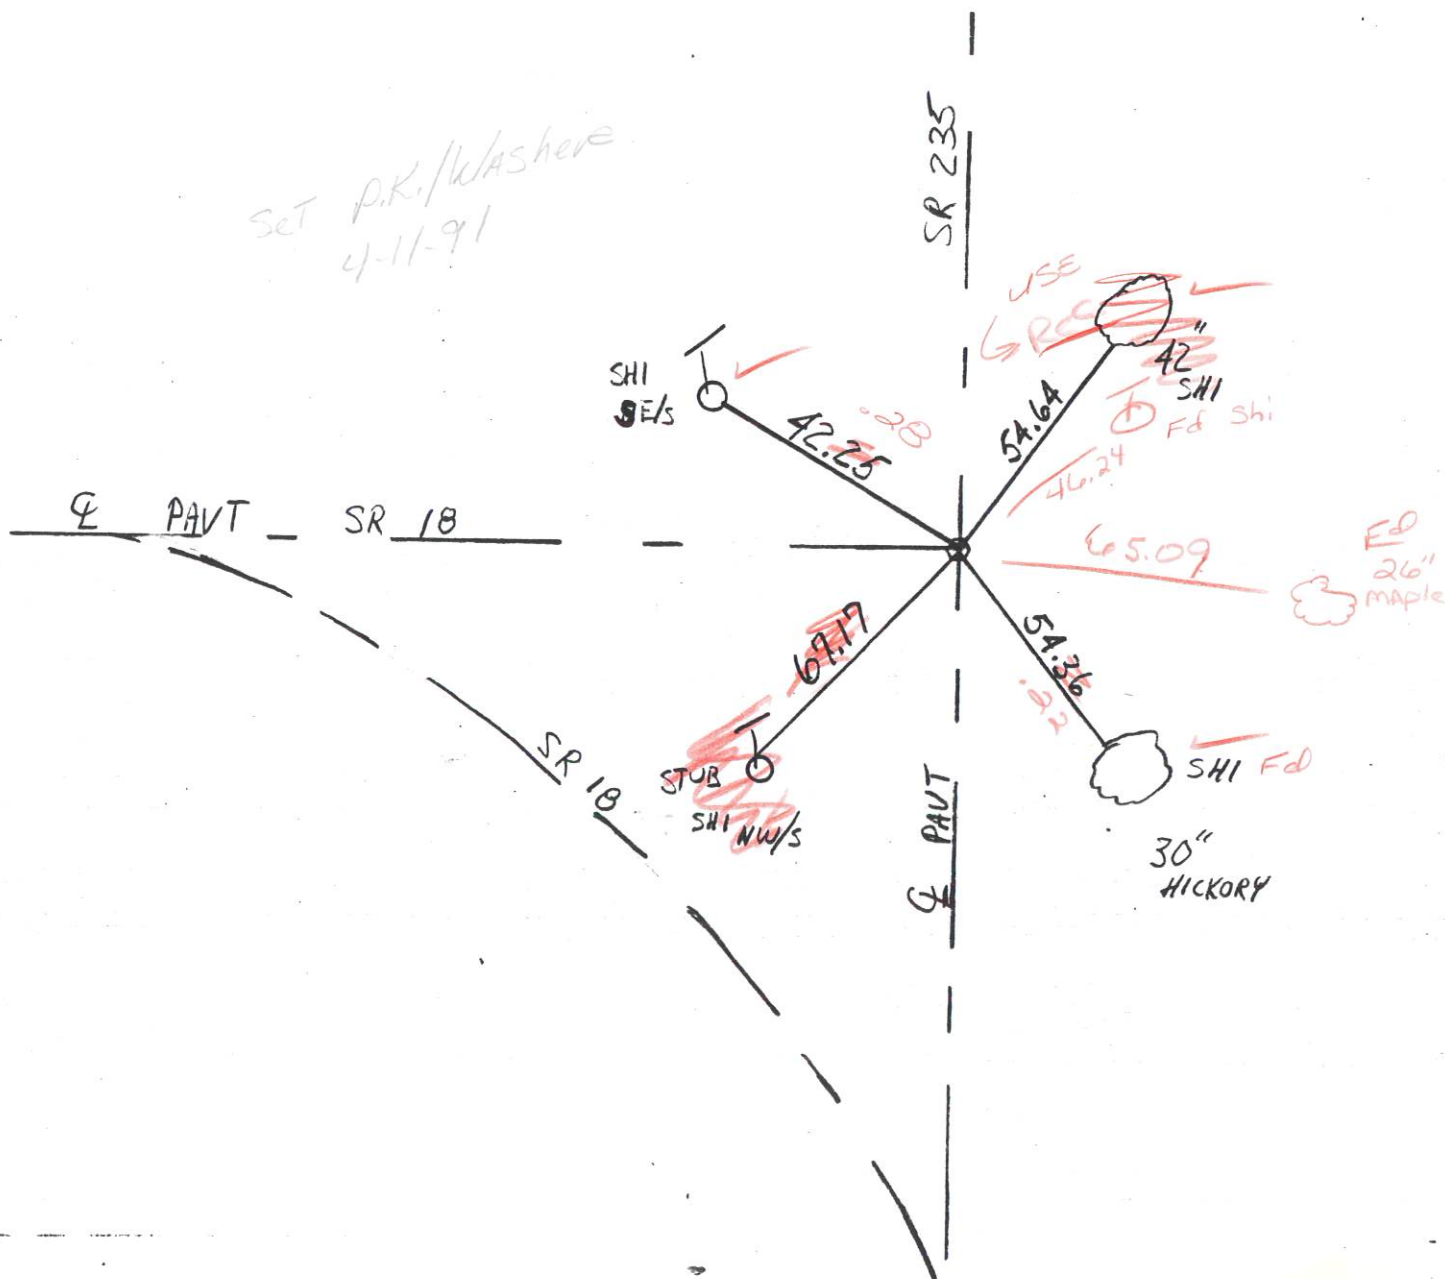

O.D.O.T. DISTRICT 2 SURVEY OFFICE

SHEET 12 OF

County WOOD S.R. 18

Date 5-31-74

Township JACKSON


Weather CLOUDY

Section 23


Temp. 78°

T3N, R9E

Personnel BURNSIDE

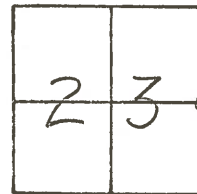


#12

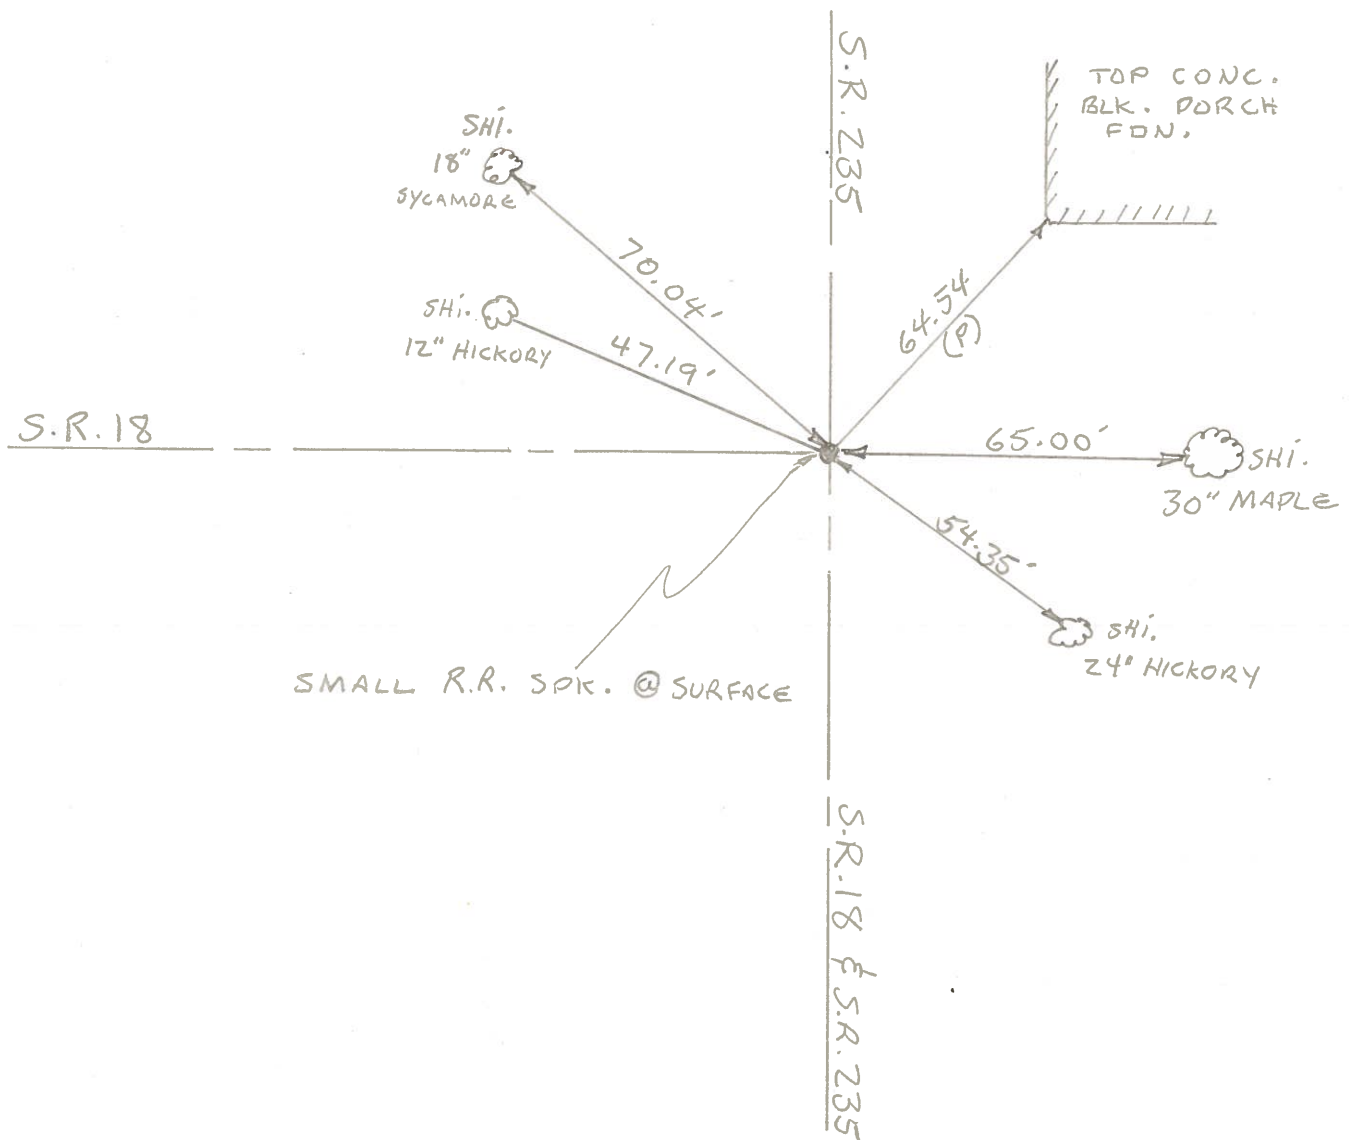

PERSONNEL	TITLE	PERSONNEL	TITLE	COUNTY	DATE	WEATHER	TEMP.
BURNSIDE		ROCCHINI		WOOD	6-18-71	CLEAR	+88°
SMITH				S. R. 18E 235			
BOWERS				SEC.			
HOLCOMBE							

DESCRIPTION	LEFT	CENTER LINE	RIGHT	JOB NO.
-------------	------	-------------	-------	---------

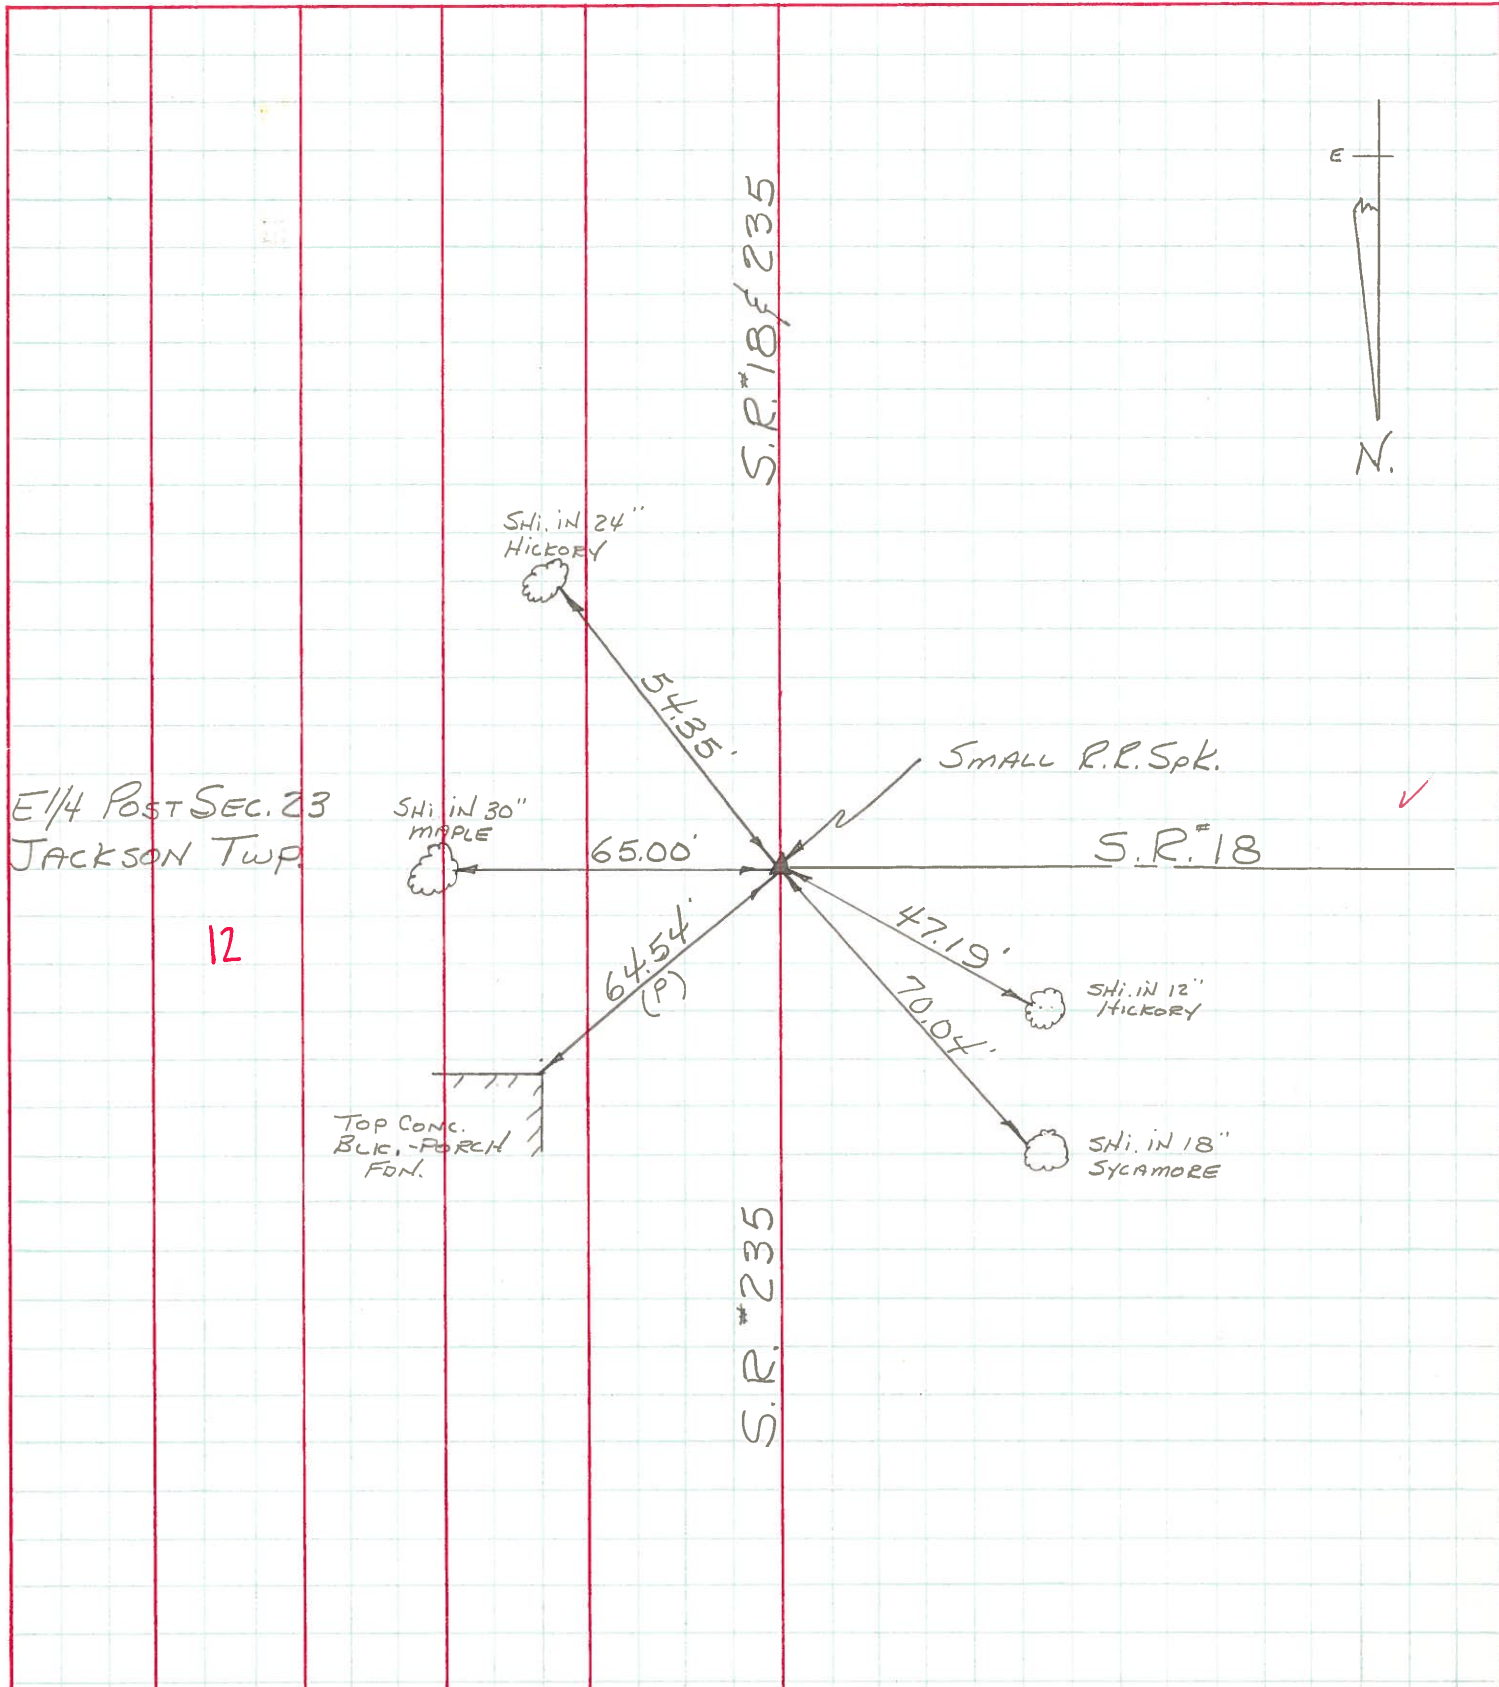

PERSONNEL TITLE PERSONNEL TITLE PERSONNEL TITLE
 DATE DATE DATE
 WIND #18 WEATHER
 TEMP SECS TEMP

DESCRIPTION ON SOL LEFT CENTER LINE RIGHT JOB NO. (1960)

Int. 1/4 post sec. 23 Jackson Twp. gone Conc. mon. N.E. from stone 3
 Conc. mon. N.W. from stone 28

#112

E 1/4 post sec. 23 Jackson Twp. Stone
 OK 12-13-57 Found Bolt
 S.E. #18 69
 2nd Conc. block below E.N.E. Conc. block porch 64
 Shiner in 24" Hickory S.E. 54
 Shiner in 12" Hickory N.W. 47
 Shiner in 30" maple N.E. 55
 Shiner in 20" maple E. 65

#113

S.E. Cor. sec. 23 Jackson Twp. Stone - P.R. spk. Set. Ed. Needles Ed.
 OK 12-13-57 Needles Ed.
 Conc. mon. N.W. 28.2
 Conc. mon. N.E. 36.5
 E.W. mon. S.E. 38.2
 N.E. Cor. Hdwl. S.W. 29.1
 Shiner 12" Red Cedar N.E. 64.2
 Shiner 18" Box Elder E.N.E. 55.7
 Shiner P. Pole S.S.E. 93.1

#114

E 1/4 sec. 26 Haysville Iron pin
 Ties check 12-13-57
 Pump N.W. 40.
 Maple S.W. 38.
 Intersection of walks S.E. 41.

#115

S.E. Cor. sec. 26 Jackson Twp. Stone 30' E. of P.L. & N.S. of 2 of Survey
 No. ties - 12-13-57
 N.E. Cor. E. Conc. Hdwl. S.E. 29
 N.W. Cor. W. Conc. Hdwl. S.W. 32

#116