

O.D.O.T. DISTRICT 2 SURVEY OFFICE (USE ONLY)

PERSONNEL

REFERENCE NO. 13

SHEET 5 OF 52

NOTES NIESE DATE 10/28/24
H.C. NIESE WEATHER CLEAR
R.C. PRESTON-COLVIN TEMP. 42°F

ROUTE SR 18
COUNTY WOOD
TOWNSHIP JACKSON
SECTION 23
T 3 N R 9 E

DWG BY BARRIERE PID 101290

TYPE MONUMENT MAGNAIL/WASHER

ON SURFACE - BELOW ON

OFFSET $\varnothing$ PAVEMENT 1' LT LT : RT

TO EDGE PAVEMENT

STATION: 293+41

HORIZ.DATUM: WOOD LDP


GEOID: 18

GRID: NORTHING: 381555.564

EASTING: 127071.129


LDP: NORTHING: 560205.168

EASTING: 1615073.130

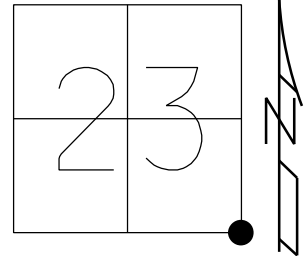

RECORD:
SET MAG/WASHER
7-26-05, DCH
FD MAG/WASHER
REF13
6-12-20
9-16-21, JFO
5/21/24, TDN
SET MAG/WASHER
10/28/24, TDN

NOTE: REF5 SR 235

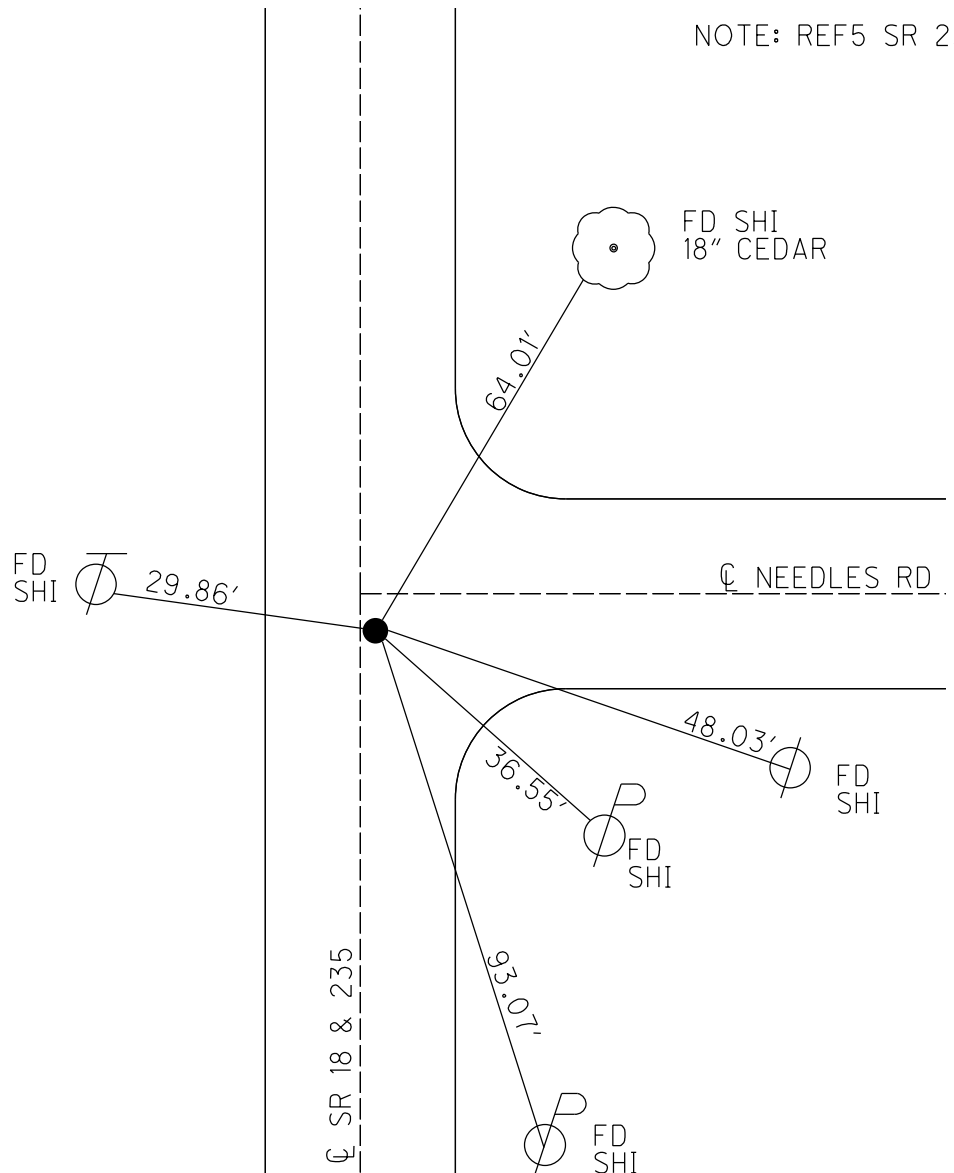

O.D.O.T. DISTRICT 2 SURVEY OFFICE (USE ONLY)

PERSONNEL

REFERENCE NO. 13

SHEET 14 OF 15

NOTES RHOADES

DATE 6-12-20

ROUTE SR 18

H.C. O'DONNELL

WEATHER SUNNY

COUNTY WOOD

R.C. MAHLER

TEMP. 73°F

TOWNSHIP JACKSON

DWG BY MAHLER

PID PAVE TRAIN

SECTION 23

T 3 N R 9 E

TYPE MONUMENT MAG/WASHER

ON SURFACE - ~~BELOW~~ ON

OFFSET Q PAVEMENT 1' ~~LT~~ : RT

11.2' TO RT EDGE PAVEMENT


STATION: 293+41

HORIZ.DATUM: NAD83 (2011)

GEOID: NAVD88-2012A


GRID: NORTHING: 560205.191


EASTING: 1615073.132

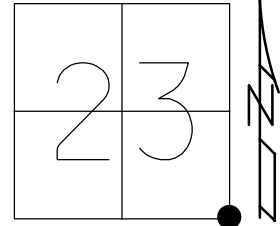

RECORD:
SET MAG/WASHER
7-26-05, DCH
FD MAG/WASHER
REF13
6-12-20
9-16-21, JFO

NOTE: REF5 SR 235

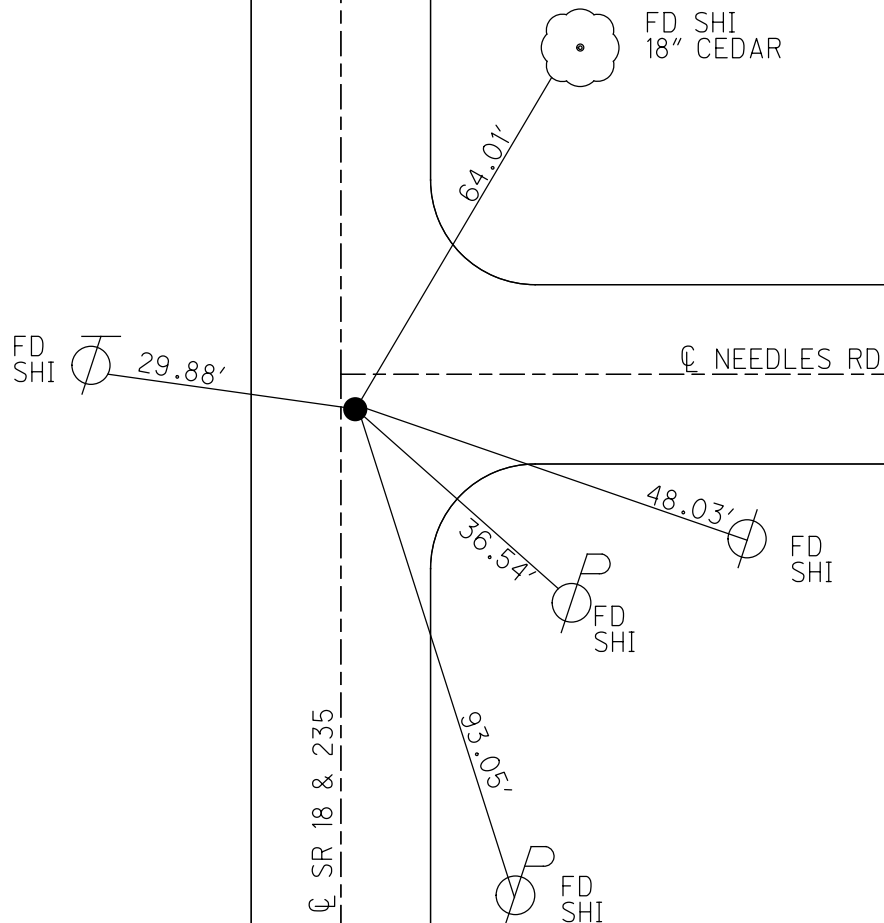

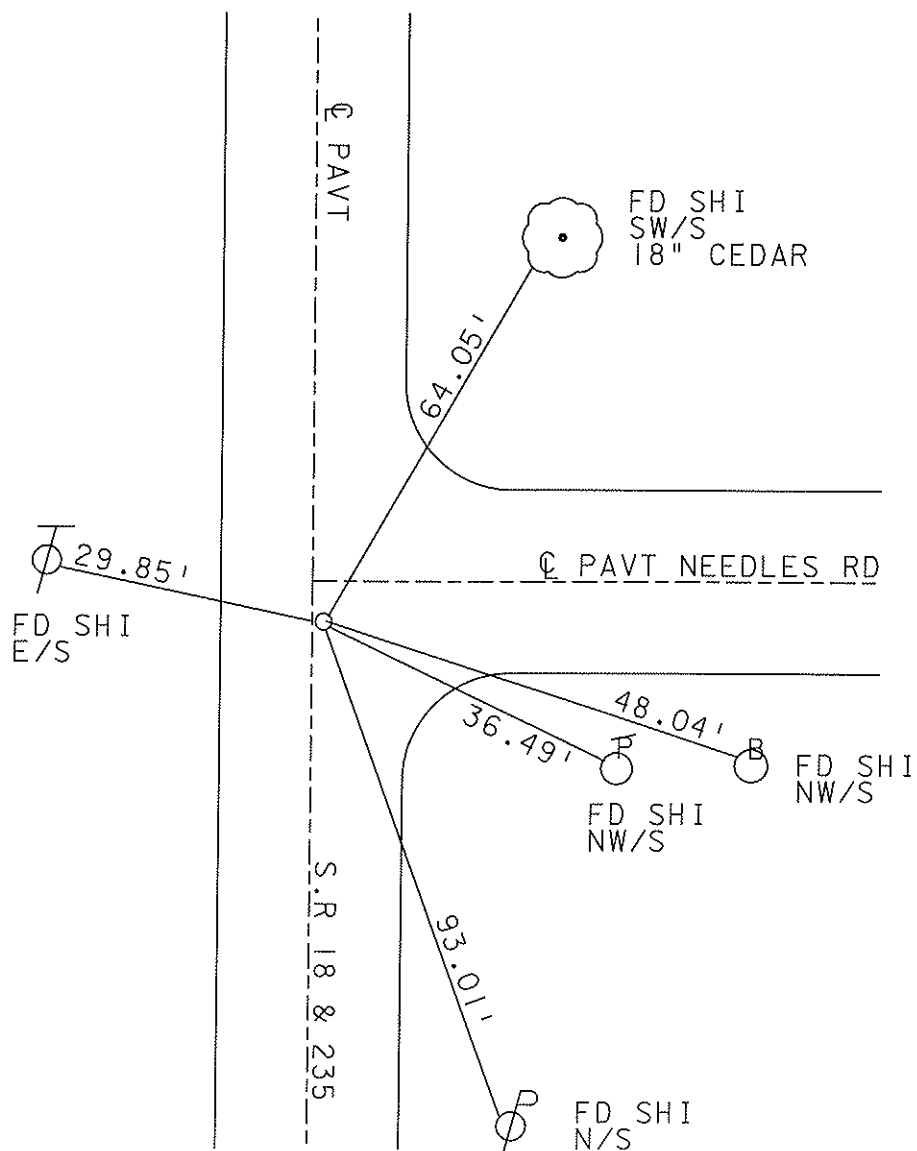

O.D.O.T. DISTRICT 2 SURVEY OFFICE (USE ONLY)

PERSONNEL

REFERENCE NO. 5

SHEET 2 OF 26

NOTES HOMAN

DATE 9-24-03

ROUTE SR 235

H.C. NUHFER

WEATHER CLDY

COUNTY WOOD

R.C. BALLMER

TEMP. 60°F

TOWNSHIP JACKSON

SECTION 23

T 3 N R 9 E

TYPE MONUMENT PK/WASHER


ON SURFACE - ~~BELOW~~ ON

~~LEFT~~ - Q PAV'T - RIGHT 1.6'


11.5' TO RT EDGE PAVEMENT

S.L.M. 106+47.77

Grid: Northing: 560205.196 Easting: 1615073.094

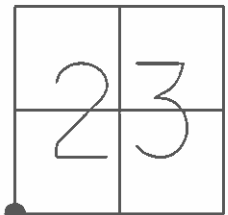

SET PK/WASHER
4-17-91, MB

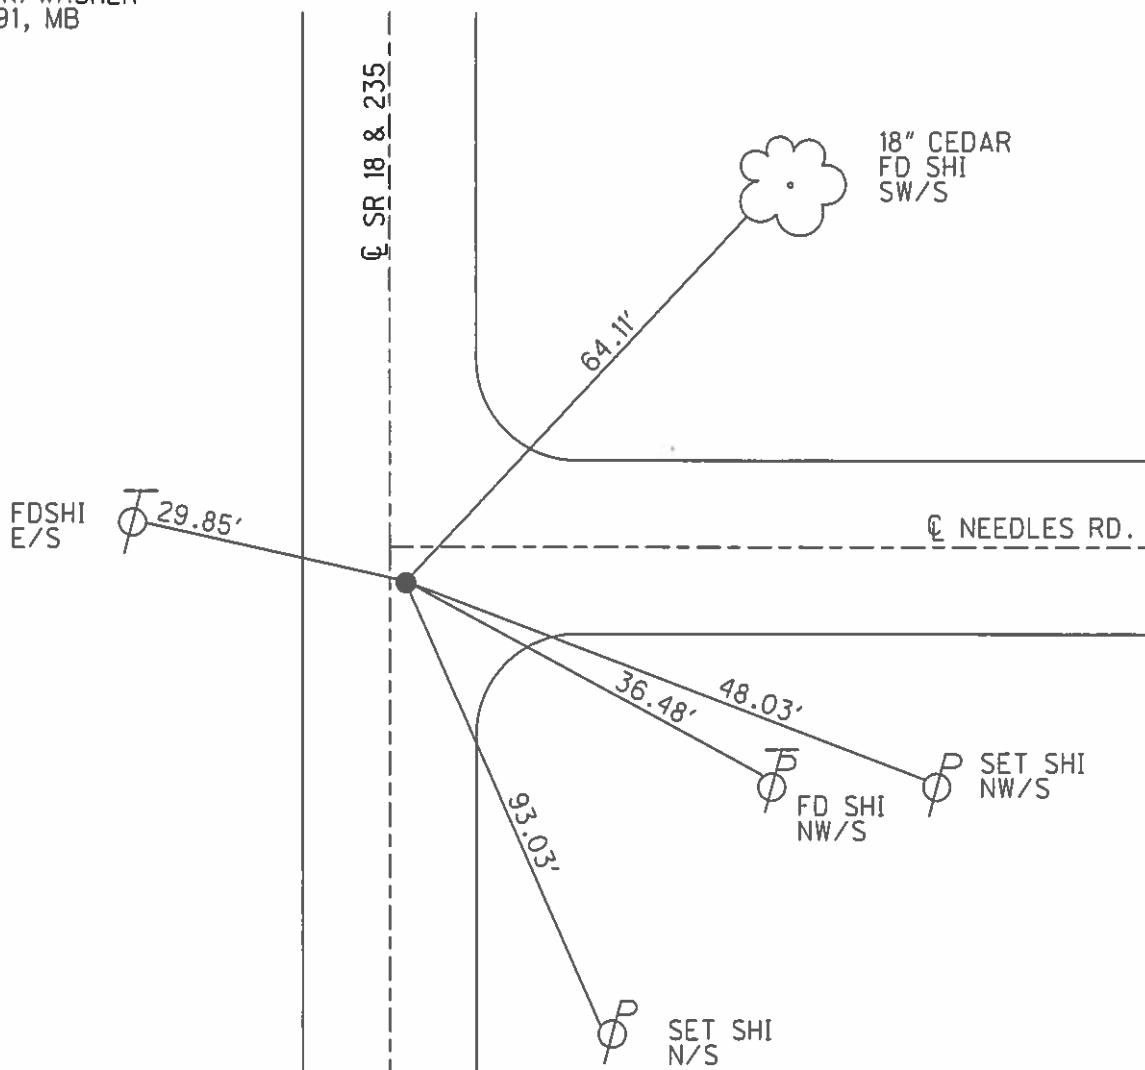

O.D.O.T. DISTRICT 2 SURVEY OFFICE

PERSONNEL

REFERENCE NO. 13

SHEET OF

NOTES BARNHISEL

H.C. Lochak

R.C. HEFFMAN

DATE 3-19-91

WEATHER cloudy - Windy

TEMP. +45°

ROUTE 18

COUNTY WOOD

TOWNSHIP JACKSON

SECTION 23

T 3 N R 9 E


TYPE MONUMENT P.R. & Washer

ON SURFACE - BELOW YES


LEFT - & PAV'T. - RIGHT 1.6

11.5 TO RT EDGE PAVEMENT

S.L.M. 293+39 3.0 S. of E Rd E.

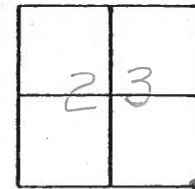

Set P.R. / Washer
4-17-91
MB

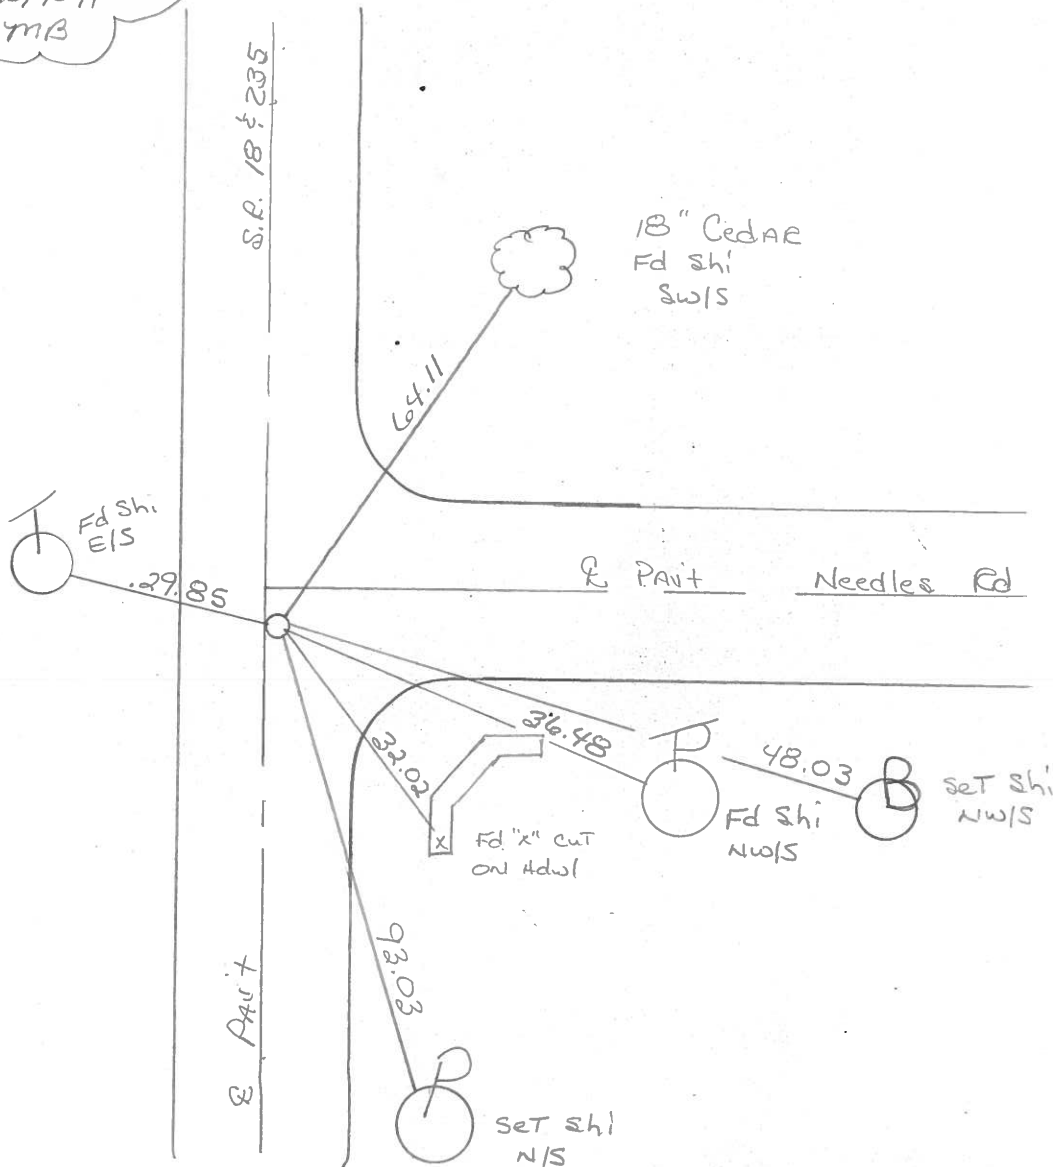

Q.D.O.T. DISTRICT 2 SURVEY OFFICE

SHEET 13 OF

County WOOD S.R. 18

Township JACKSON

Section 23

T3N, R9E

Personnel BARNHISEL HC


HOUSEHOLDER R.C

LOENRKE

Date 11-25-83

Weather CLEAR WINDY

Temp. +41°

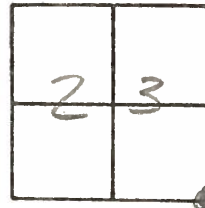


#13

Fd RR SPIKE @ SURFACE
2.0 LF of Q 18
3.0 S of Q Needles Rd

SLM 293+21

SET PK+WASHER
7-25-85
C.L.

#13

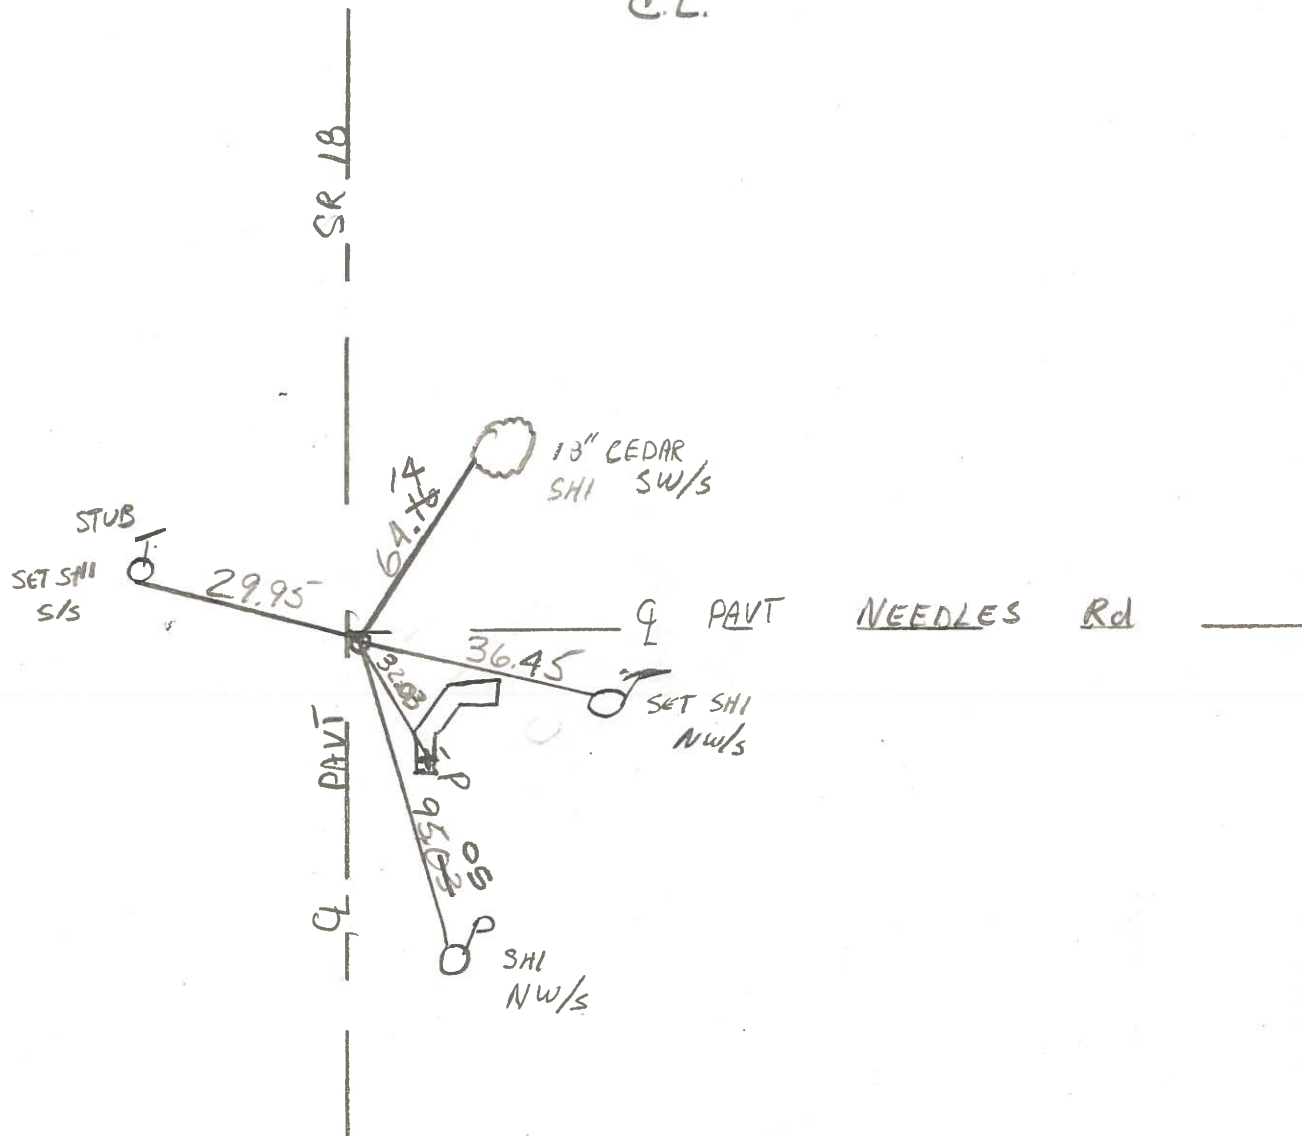

Date 11-25-83

Weather CLEAR WINDY

Temp. +41°

2	3


N
4

HOUSE HOLDER R.C

LOENRKE 

SLM 293+21 39
SET PK+WASHER #13
7-25-85
C.L.

Set P.K./Washer
4-11-91

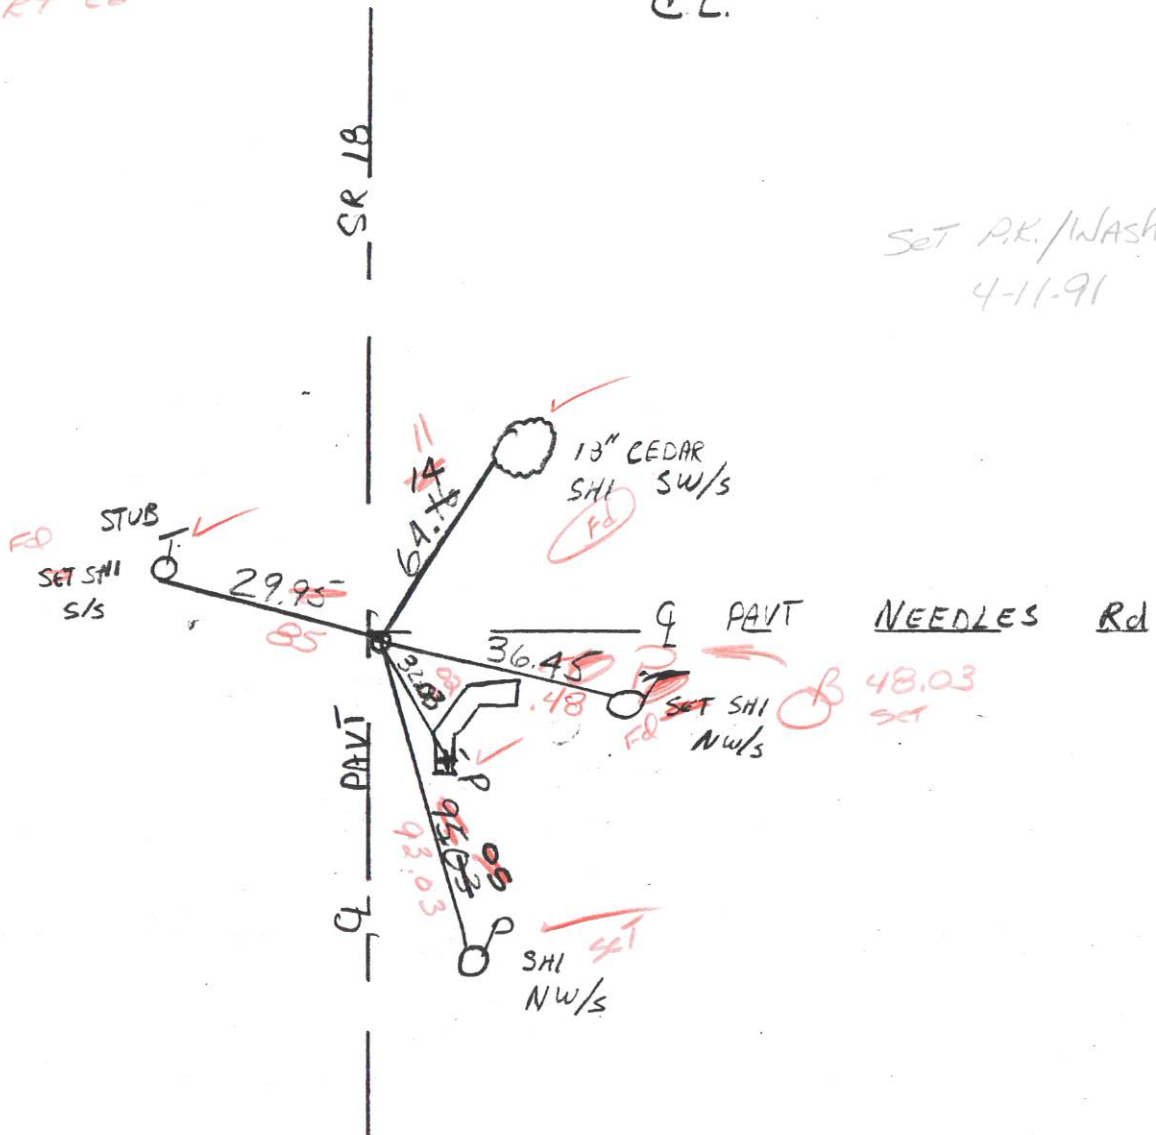

O.D.O.T. DISTRICT 2 SURVEY OFFICE

SHEET 13 OF

County WOOD S.R. 18

Date 6-17-74

Township JACKSON

Weather CLOUDY

Section 23

Temp. 62°

T3N, R9E


Personnel BURNSIDE

SMITH


BOWERS

INEAD

KIJOWSKI

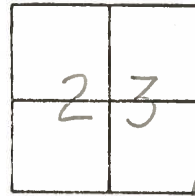


#13

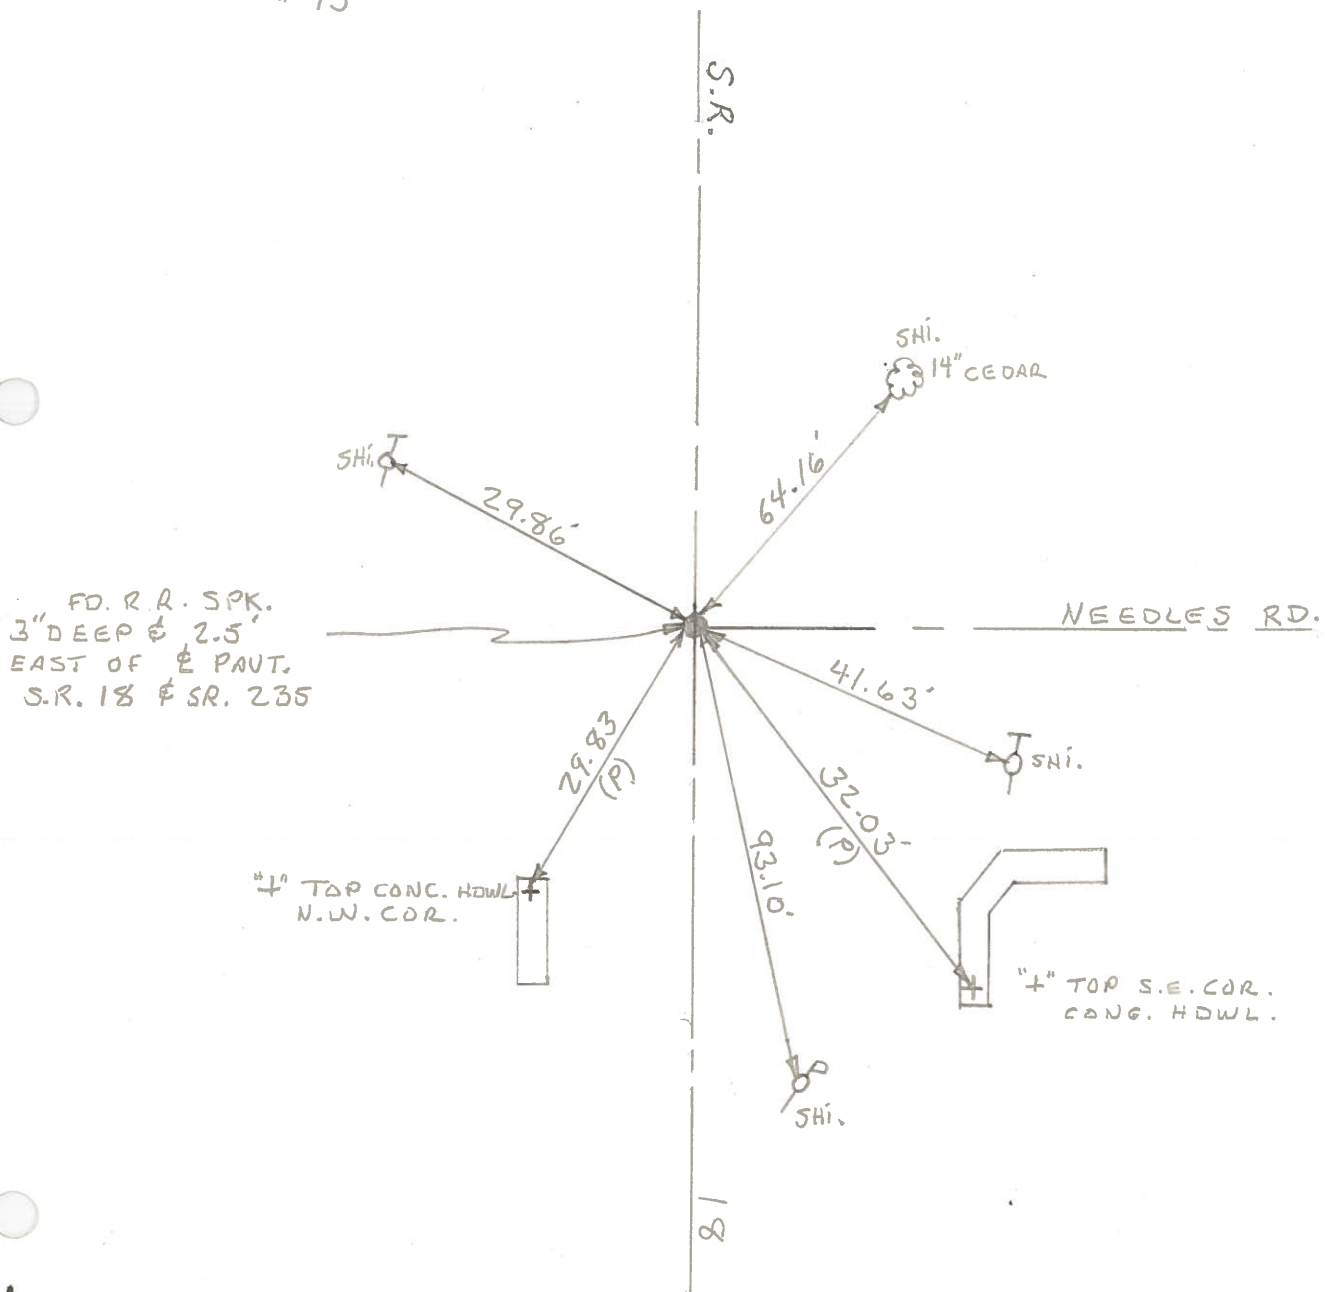

PERSONNEL	TITLE	PERSONNEL	TITLE	COUNTY	DATE
BURNSIDE		ROCCHINI		WOOD	6-18-71
SMITH				S. R. 18 E 235	WEATHER CLEAR
BOWERS				SEC. 23	NEEDLES RD
HOLCOMBE				TEMP.	+88°

DESCRIPTION	LEFT	CENTER LINE	RIGHT	JOB NO.
-------------	------	-------------	-------	---------

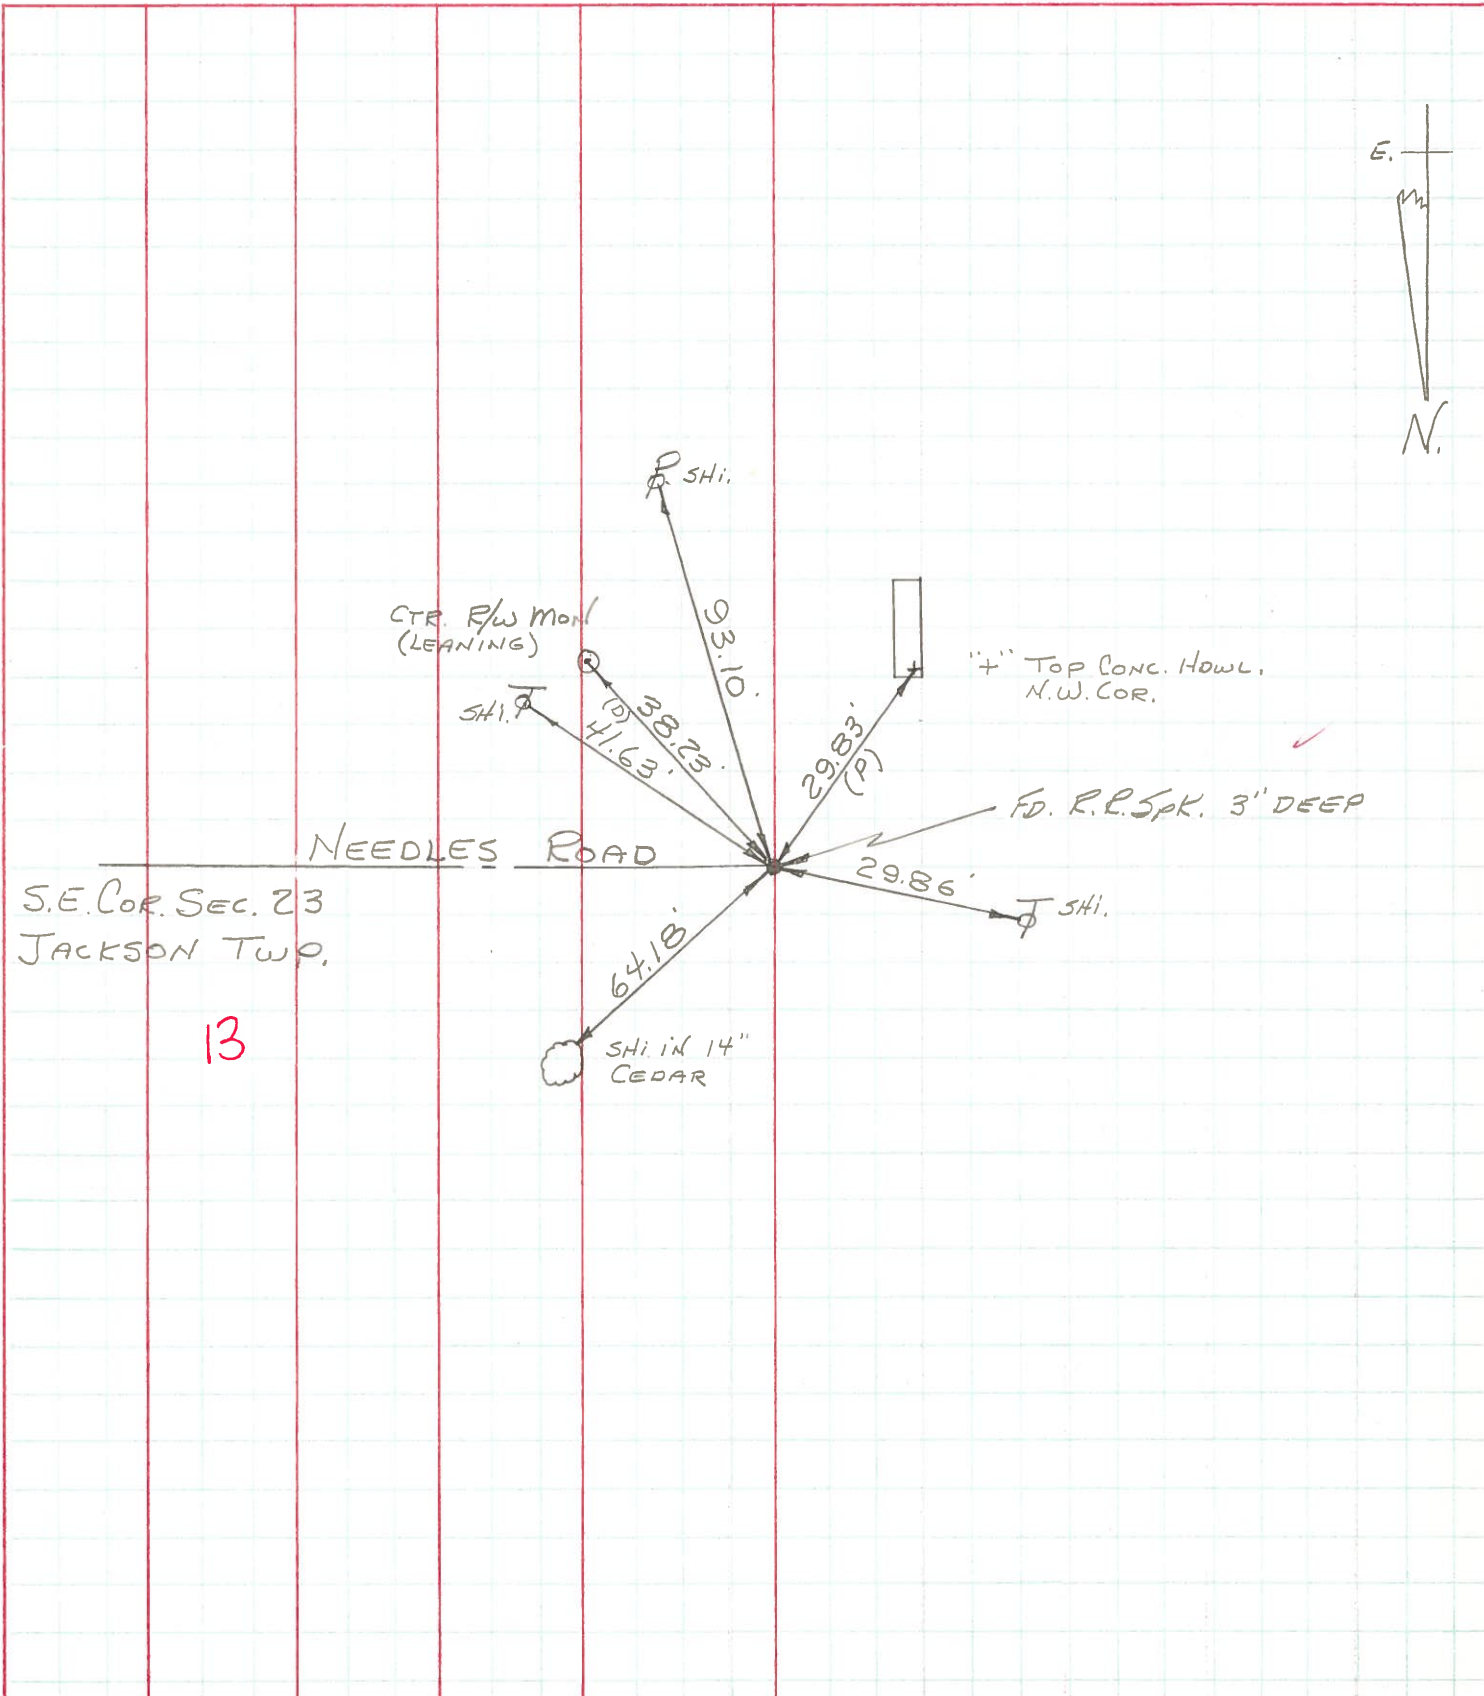

PERSONNEL TITLE PERSONNEL TITLE PERSONNEL TITLE
 DATE DATE DATE
 SHEET NO. 5
 DATE 1960
 WEATHER
 TEMP
 SECS
 Ruffer
 #18

DESCRIPTION ON SOL LEFT CENTER LINE RIGHT JOB NO. 13 (1960)

Int. 1/4 post sec. 23 Jackson Twp. gone Conc. mon. N.E. from stone 3
 Conc. mon. N.W. from stone 28

#112

E 1/4 post sec. 23 Jackson Twp. Stone
 OK 12-13-57 Found Belt
 S.E. #18 69
 2nd Conc. block below E.N.E. Conc. block porch 64
 Shiner in 24" Hickory S.E. 54
 Shiner in 12" Hickory N.W. 47
 Shiner in 30" maple N.E. 55
 Shiner in 20" maple E. 65

#113

S.E. Cor. sec. 23 Jackson Twp. Stone - P.R. spk. Set. Ed. Needles Ed.
 OK 12-13-57 Needles Ed.
 Conc. mon. N.W. 28.2
 Conc. mon. N.E. 36.5
 E.W. mon. S.E. 38.2
 N.E. Cor. Hdwl. S.W. 29.1
 Shiner 12" Red Cedar N.E. 64.2
 Shiner 18" Box Elder E.N.E. 55.7
 Shiner P. Pole S.S.E. 93.1

#114

E 1/4 sec. 26 Haysville Iron pin
 Ties check 12-13-57
 Pump N.W. 40
 Maple S.W. 38
 Intersection of walks S.E. 41

#115

S.E. Cor. sec. 26 Jackson Twp. Stone 30' E. of P.L. & N.S. of 2 of Survey
 No. ties - 12-13-57
 N.E. Cor. E. Conc. Hdwl. S.E. 29
 N.W. Cor. W. Conc. Hdwl. S.W. 32

#116