

O.D.O.T. DISTRICT 2 SURVEY OFFICE (USE ONLY)

PERSONNEL

REFERENCE NO. 14

SHEET 5 OF 52

NOTES NIESE DATE 10/28/24
 H.C. NIESE WEATHER CLEAR
 R.C. PRESTON-COLVIN TEMP. 42°F

ROUTE SR 18
 COUNTY WOOD
 TOWNSHIP JACKSON
 SECTION 25
 T 3 N R 9 E

DWG BY BARRIERE PID 101290

TYPE MONUMENT MAGNAIL/WASHER

ON SURFACE - BELOW ON

OFFSET Q PAVEMENT LT : RT


 TO EDGE PAVEMENT

STATION: 319+72

HORIZ.DATUM: WOOD LDP GEOID: 18


GRID: NORTHING: 378924.939 EASTING: 127076.686


LDP: NORTHING: 557574.922 EASTING: 1615044.014

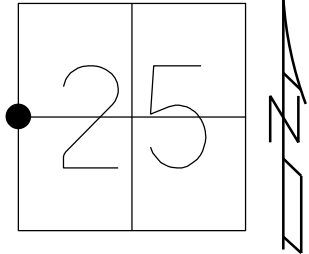

RECORD:
 SET MAG/WASHER
 7-26-05, DCH
 FD P.K./WASHER
 3.5" DOWN
 REF14
 6-12-20, JFO
 FD SM RR SPIKE
 5/21/24, TDN
 SET MAG/WASHER
 10/28/24, TDN

NOTE: REF4 SR 235

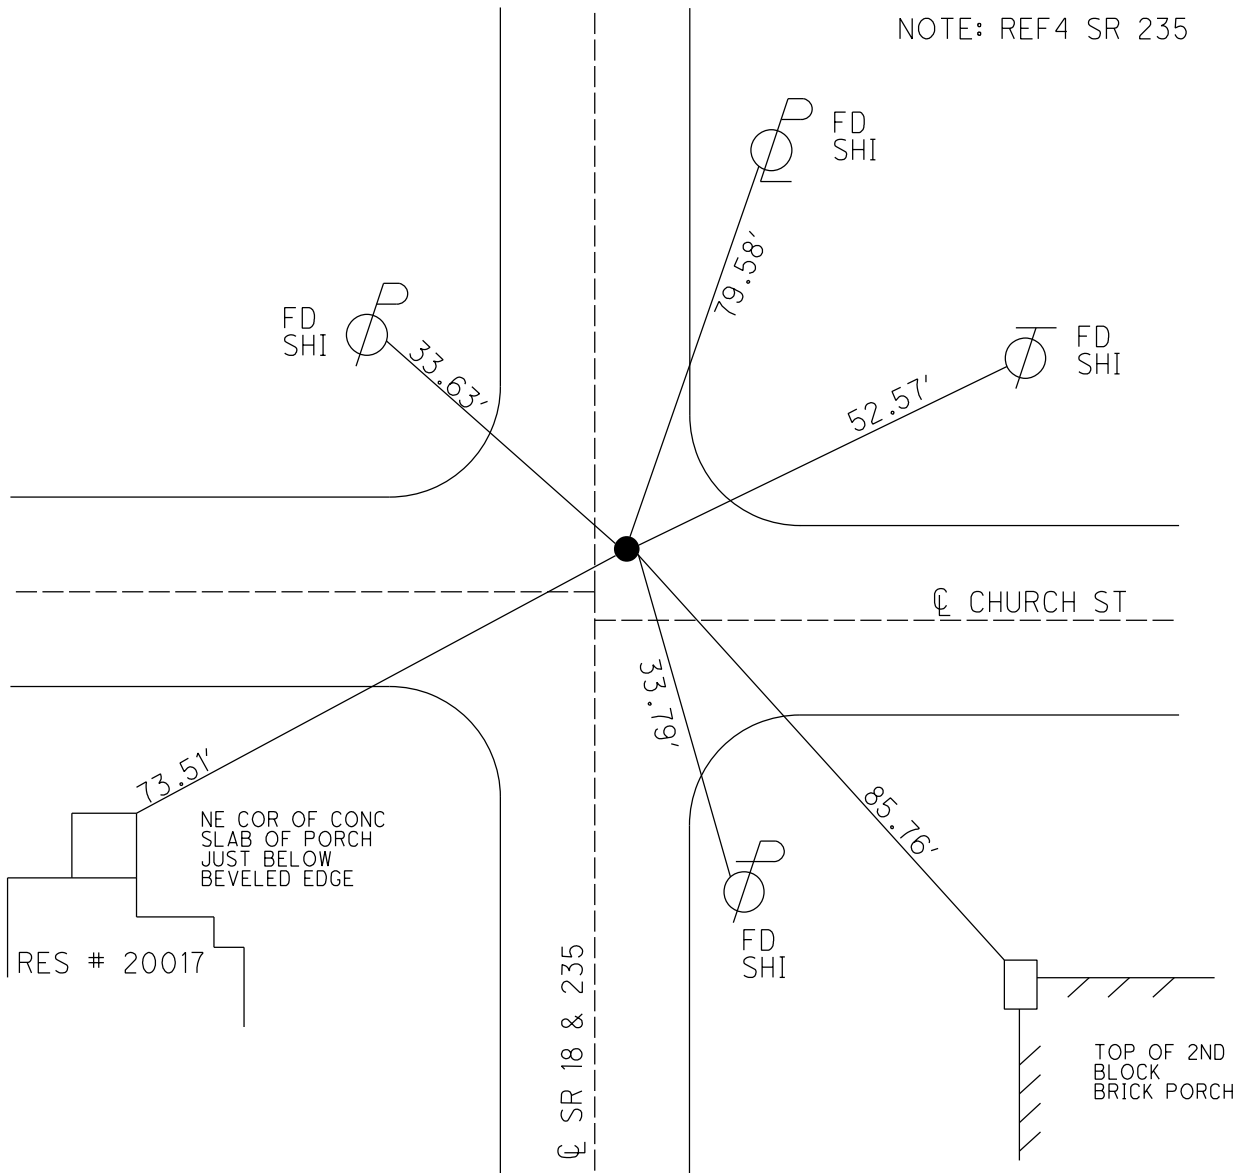

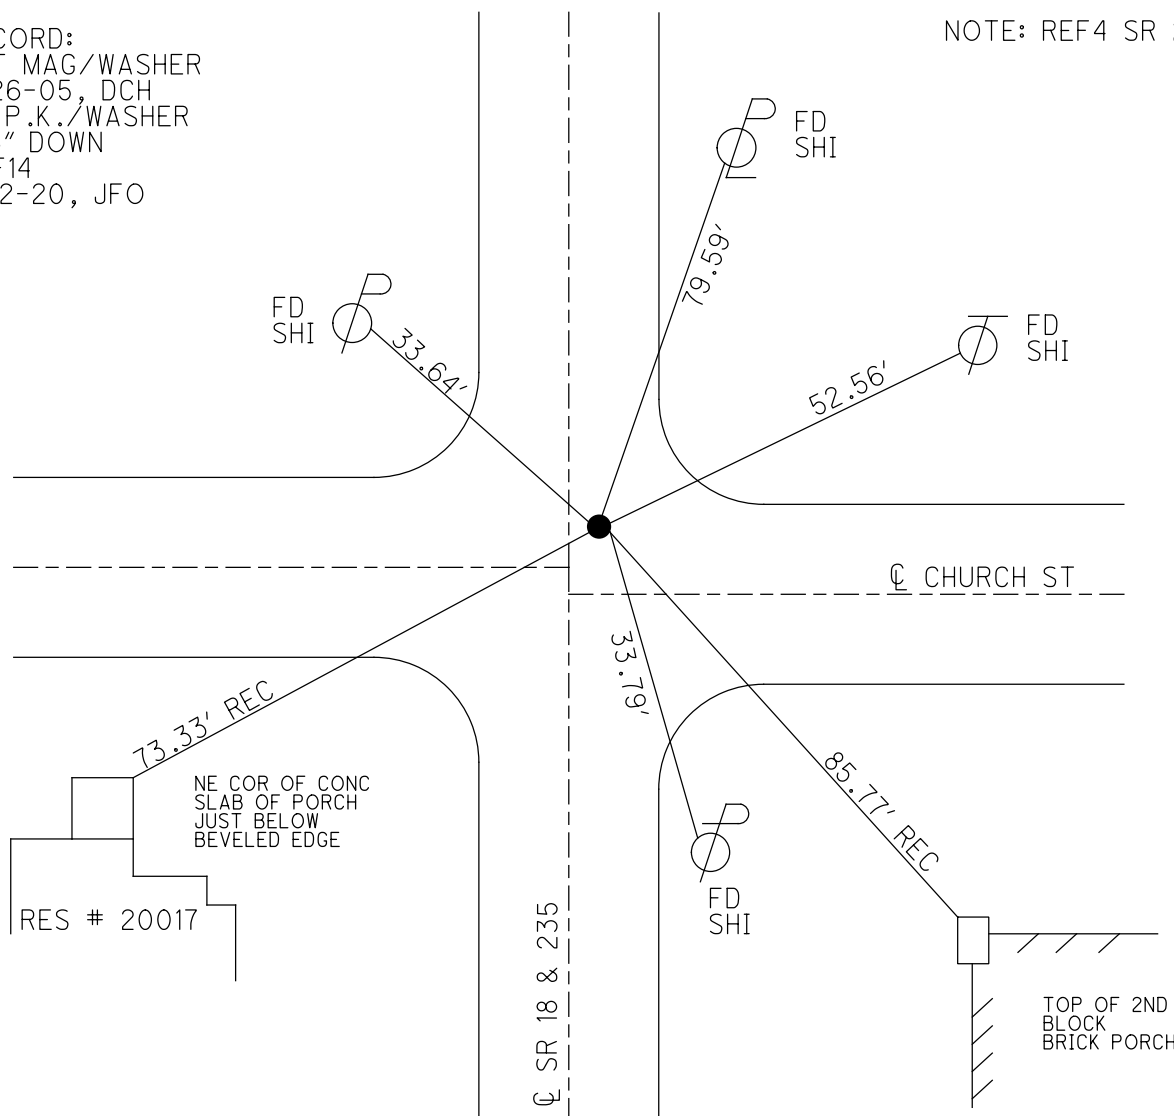

O.D.O.T. DISTRICT 2 SURVEY OFFICE

PERSONNEL

REFERENCE NO. 14

SHEET 14 OF 14

NOTES STEVE

DATE 4-06-05

ROUTE S.R. 18

H.C. DUANE

WEATHER CLEAR

COUNTY WOOD

R.C. JOE

TEMP. 62°

TOWNSHIP JACKSON

SECTION 25

T 3 N R 9 E


TYPE MONUMENT PK & WASHER

ON SURFACE - ~~BELOW~~ ON


LEFT - ~~Q PAVT~~ RIGHT 0.6'

TO EDGE PAVEMENT

S.L.M. 319+72 ON Q EAST

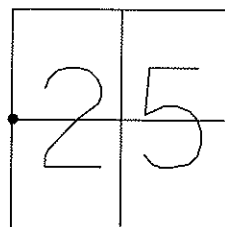


RESET MAG & WAHER
7-26-05
DCH

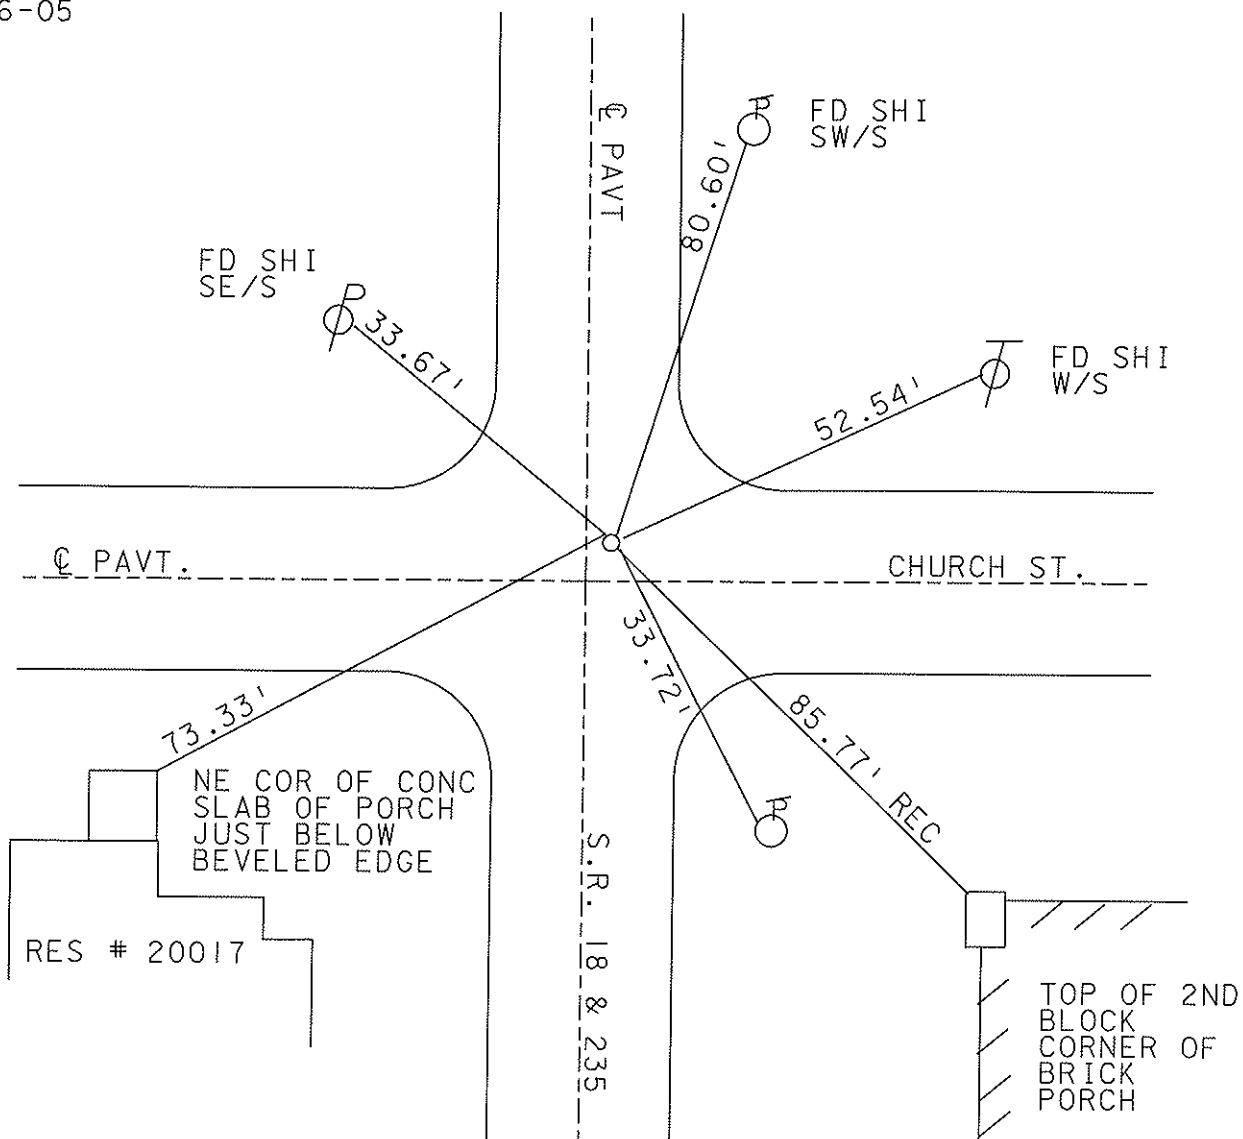

O.D.O.T. DISTRICT 2 SURVEY OFFICE (USE ONLY)


PERSONNEL	REFERENCE NO.	4	SHEET	1	OF	26
NOTES	BARNHISEL	DATE	3-19-91	ROUTE	SR 235	
H.C.	LOEHRKE	WEATHER	CLDY WINDY	COUNTY	WOOD	
R.C.	HOFFMAN	TEMP.	45°F	TOWNSHIP	JACKSON	
				SECTION	25	
				T	3	N
				R	7	E

TYPE MONUMENT PK/WASHER
 ON SURFACE - ~~BELOW~~ ON
~~LEFT~~ Q PAV'T - RIGHT 0.9'
- TO - EDGE PAVEMENT
 S.L.M. 80+17.37

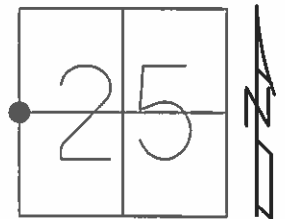

Grid: Northing: 557574.959 Easting: 1615044.096

RECORD:
 SET PK/WASHER
 4-17-91, MB

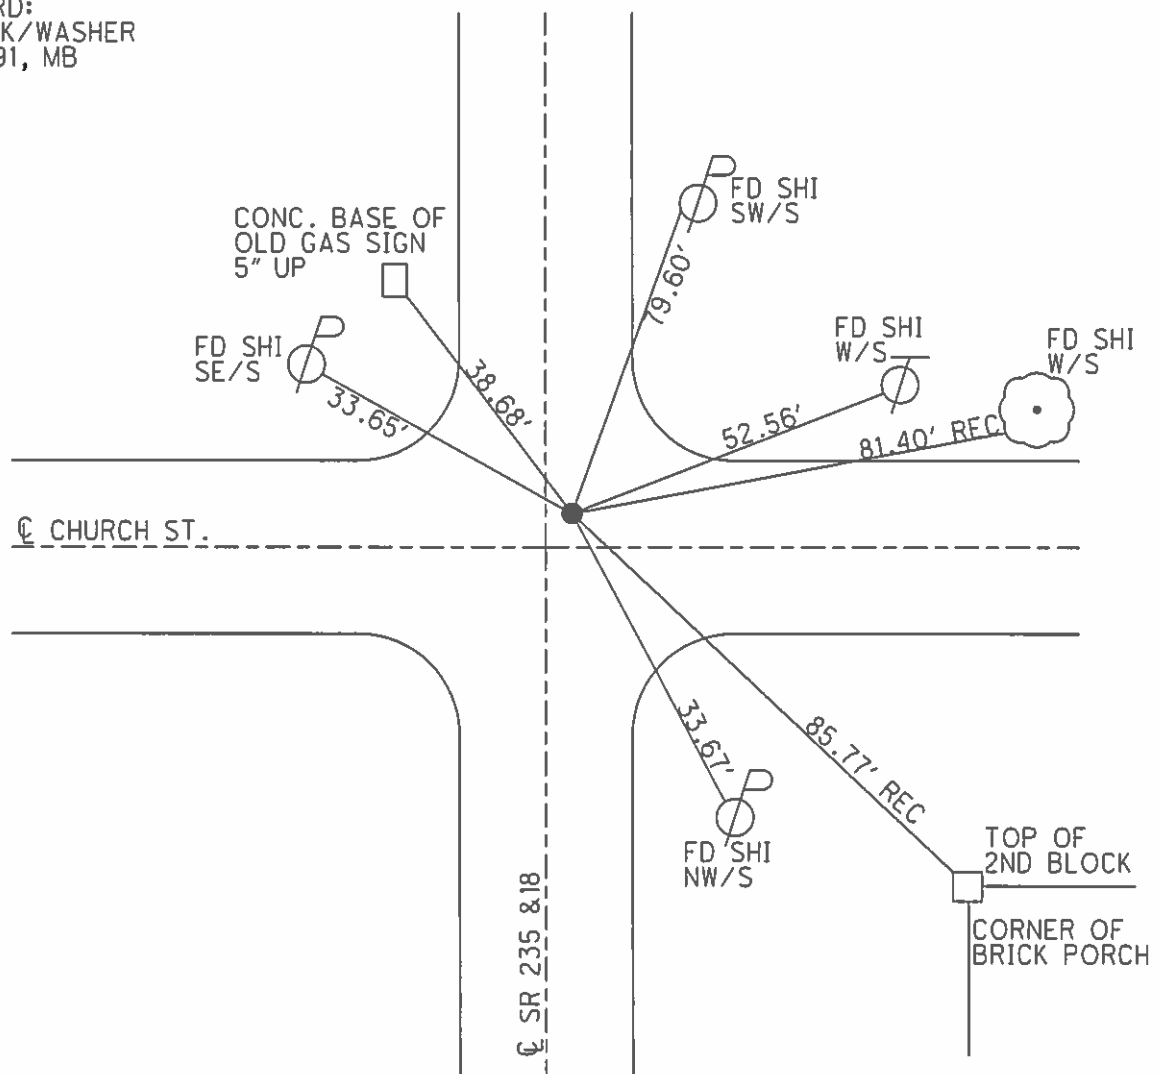

O.D.O.T. DISTRICT 2 SURVEY OFFICE

PERSONNEL

REFERENCE NO. 14

SHEET OF

NOTES BARNHISEL

H.C. Loehke

R.C. HOFFMAN

DATE 3-19-91

WEATHER cloudy-windy

TEMP. +45°

ROUTE 18

COUNTY WOOD

TOWNSHIP JACKSON

SECTION 25

T 3 N R 9 E


TYPE MONUMENT P.K. & Washer

ON SURFACE - BELOW yes


LEFT - & PAV'T. - RIGHT 0.9

TO - EDGE PAVEMENT

S.L.M. 319+71 2.0 N. OF & E.

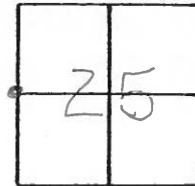

Set P.K. / Washer
4-17-91
mB

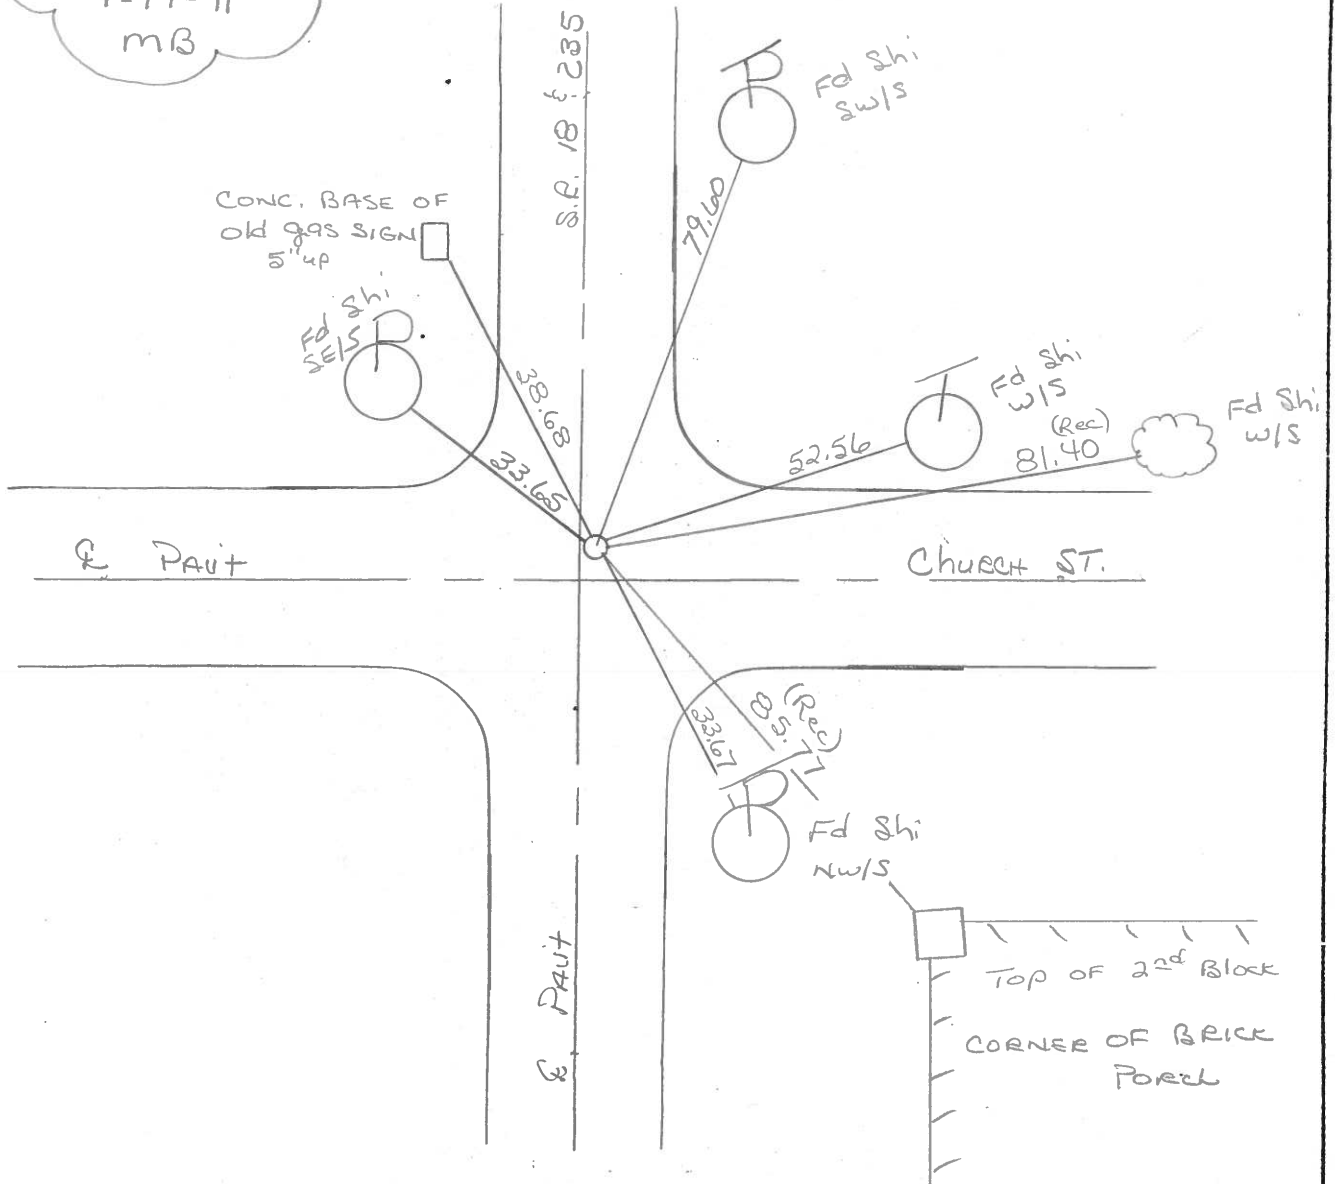

ODOT. DISTRICT 2 SURVEY OFFICE

SHEET 14 OF

County WOOD S.R. 18

Township JACKSON

Section 25

T3N, R9E

Personnel BARNHISEL H.C.


HOUSEHOLDER R.C.

LOEHRKE 

Date 11-28-83

Weather CLOUDY, RAIN

Temp. +40°

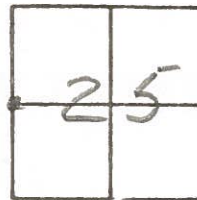

Fd SMALL RR SPIKE @ SURFACE
ON & PAVT SR 18
ON & PAVT CHURCH ST EAST

SLM


319+54

#14

SET PK + WASHER

7-25-85

C.L.

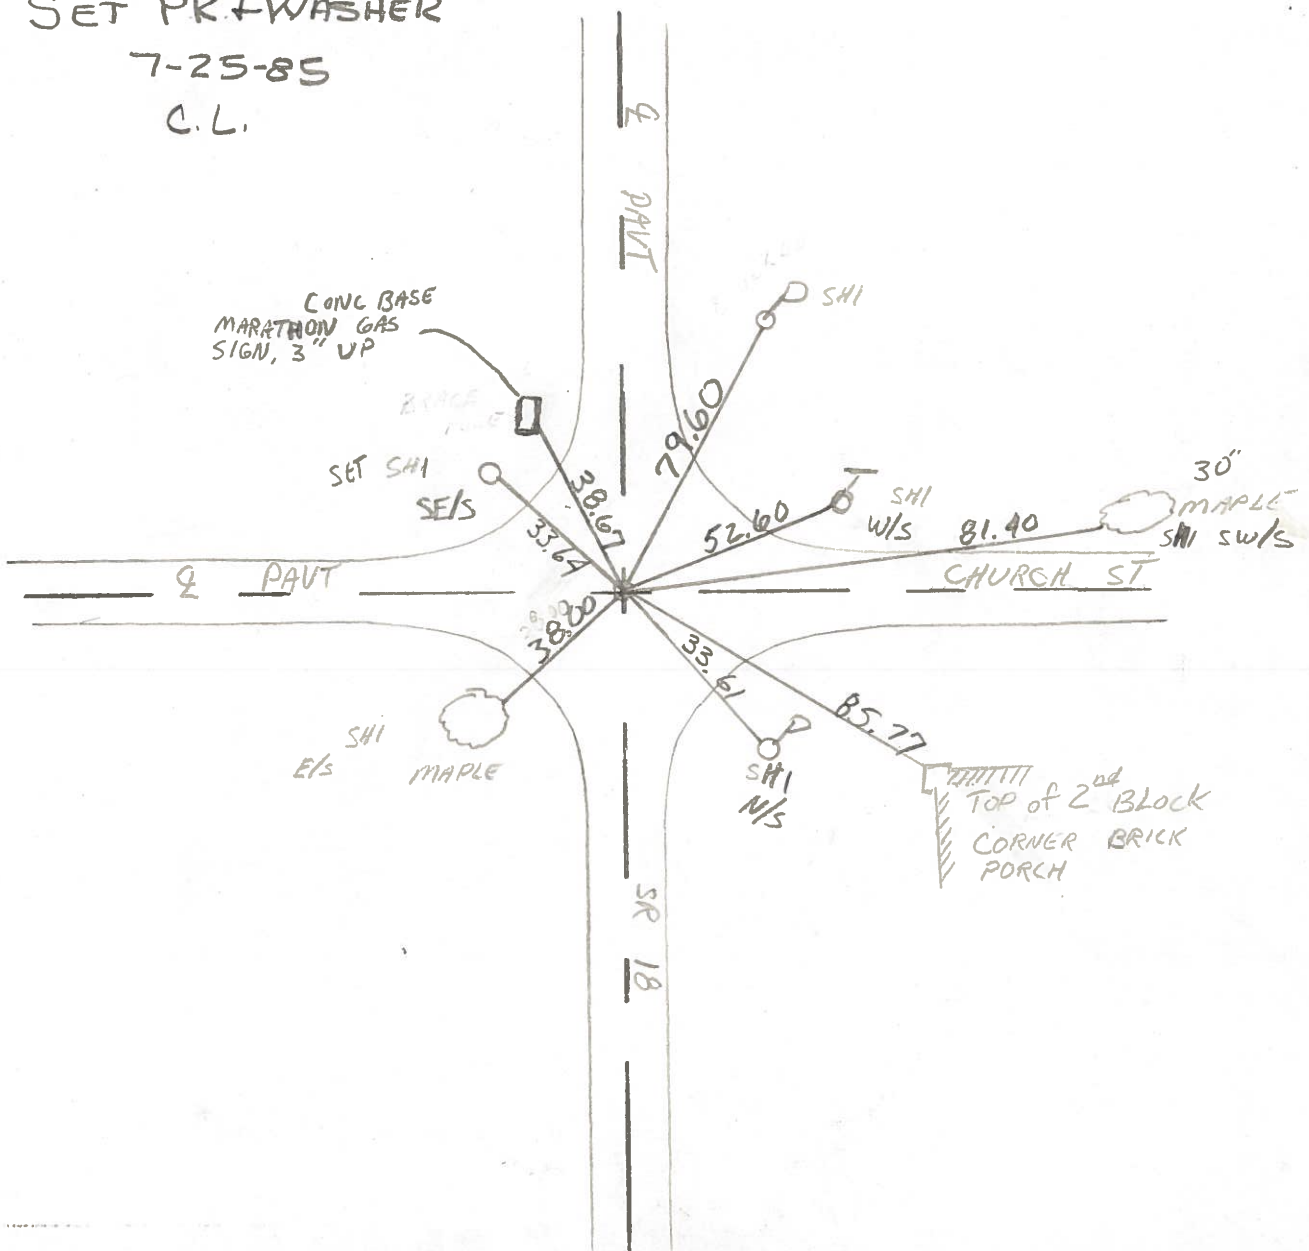

ODOT DISTRICT 2 SURVEY OFFICE

SHEET 14 OF

County WOOD S.R. 18

Date 5-31-74

Township JACKSON


Weather PT. CLOUDY

Section 25


Temp. 78°

T3N, R9E

Personnel BURNSIDE

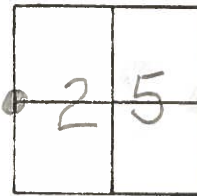

#14

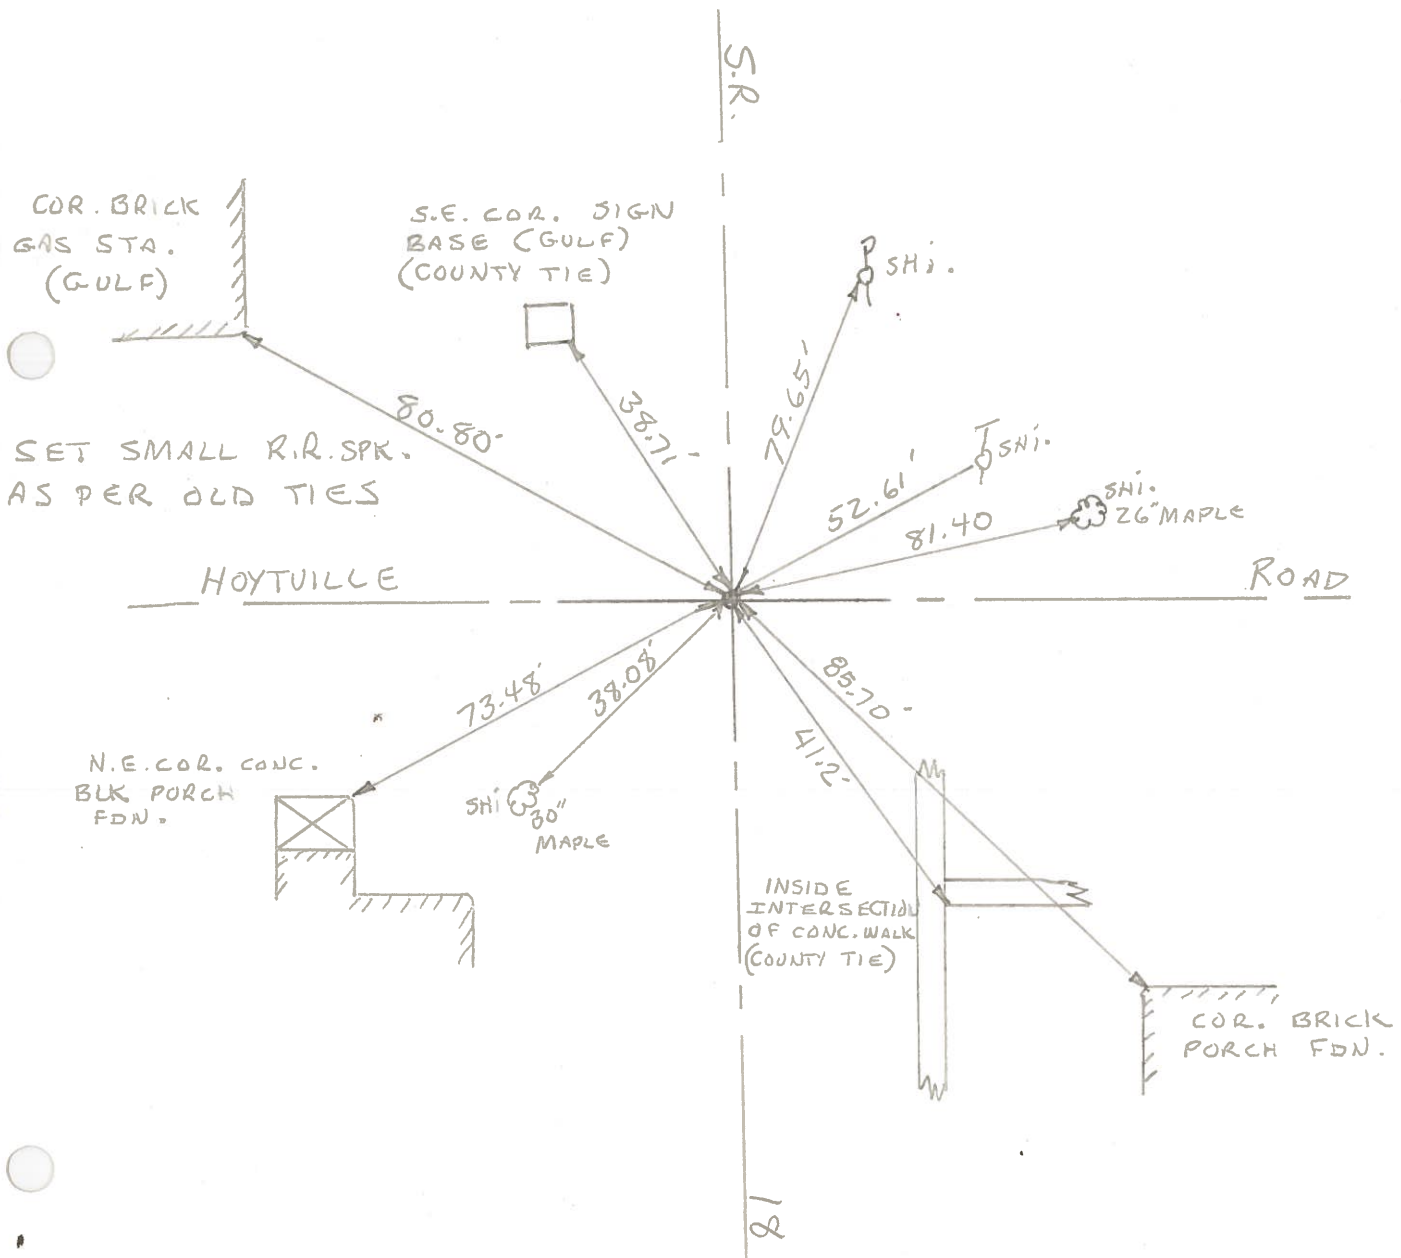

PERSONNEL	TITLE	PERSONNEL	TITLE	COUNTY	DATE	S. R.	WEATHER	TEMP.
BURNSIDE				Wood	6-29-71	18	CLEAR	+88°
SMITH								
BOWERS								
HOLCOMBE				SEC. 25 HOYTVILLE				

DESCRIPTION	LEFT	CENTER LINE	RIGHT	JOB NO.
-------------	------	-------------	-------	---------

