

PERSONNEL

SHEET 5 OF 52

ROUTE	SR 18
COUNTY	WOOD
TOWNSHIP	JACKSON
SECTION	25

T_3_N R_9_E

ON SURFACE - BELOW ON

_____TO_____EDGE PAVEMENT

STATION: 343+18

HORZ.DATUM: WOOD LDP

GEOID: 18


GRID: NORTHING: 376284.344

EASTING: 127044.992

LDP: NORTHING: 554935.199EASTING: 1614977.520

NOTE: 2.5' W. OF $\odot$ SR 235

SR 235 REF 3

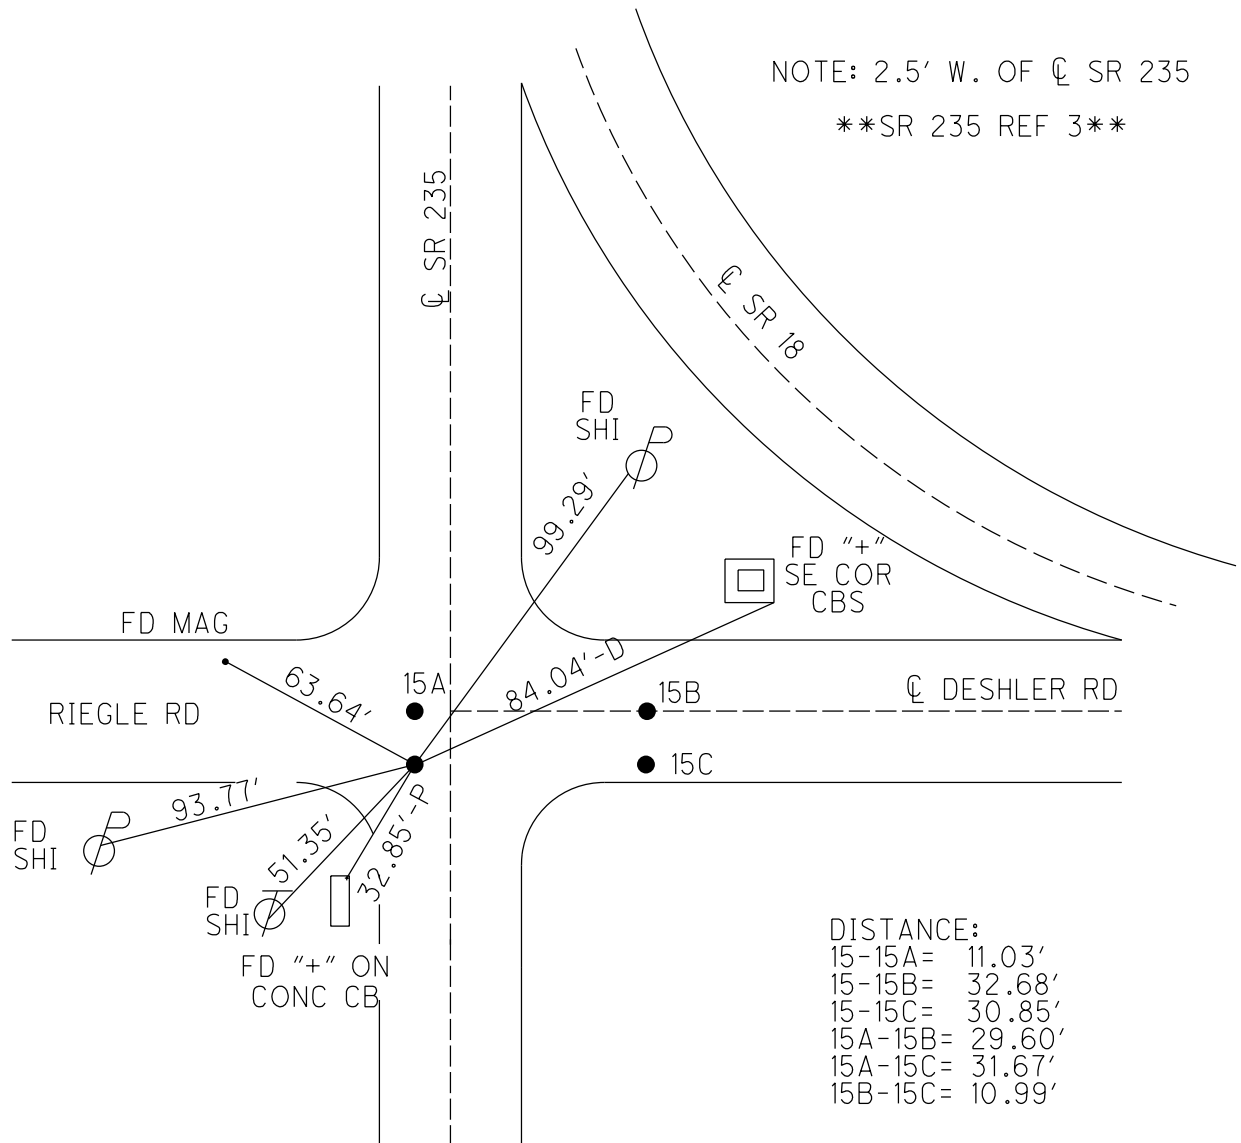

DISTANCE:

15-15A=	11.03'
15-15B=	32.68'
15-15C=	30.85'
15A-15B=	29.60'
15A-15C=	31.67'
15B-15C=	10.99'

PERSONNEL

REFERENCE NO.

15

SHFFT

1

O

51

NOTES BARNHISEL

DATE _____

3/19/91

ROUTE

SR 18

H.C. LOEHRKE

WEATHER

CLOUDY/WINDY

COUNTY

WOOD

R.C. HOFFMAN

TEMP.

$$\overline{45^\circ}$$

TOWNSHIP

JACKSON

SECTION

26

DWG BY O'DONNELL

PID PAVETRAIN

T_3_N R_9_E

TYPE MONUMENT

1/2" IPIN

~~ON SURFACE~~ - BELOW

2.0"

LEFT - C PAV'T - RIGHT 11.0' S. OF C E.

T 11.0' S. OF C E.

TO EDGE PAVEMENT NOTE: 2.5' W. OF C SR 235

STATION: 343+18

HORZ.DATUM: NAD83 (2011)


GEOID: NAVD88-2012A

GRID: NORTHING: 554935.233

EASTING: 1614977.503

RECORD:
FD MAG/WASHER
SVD15
6/16/10, BG
FD MAG/WASHER
REF15
6/15/20, JFO

NOTE: 2.5' W. OF C SR 235

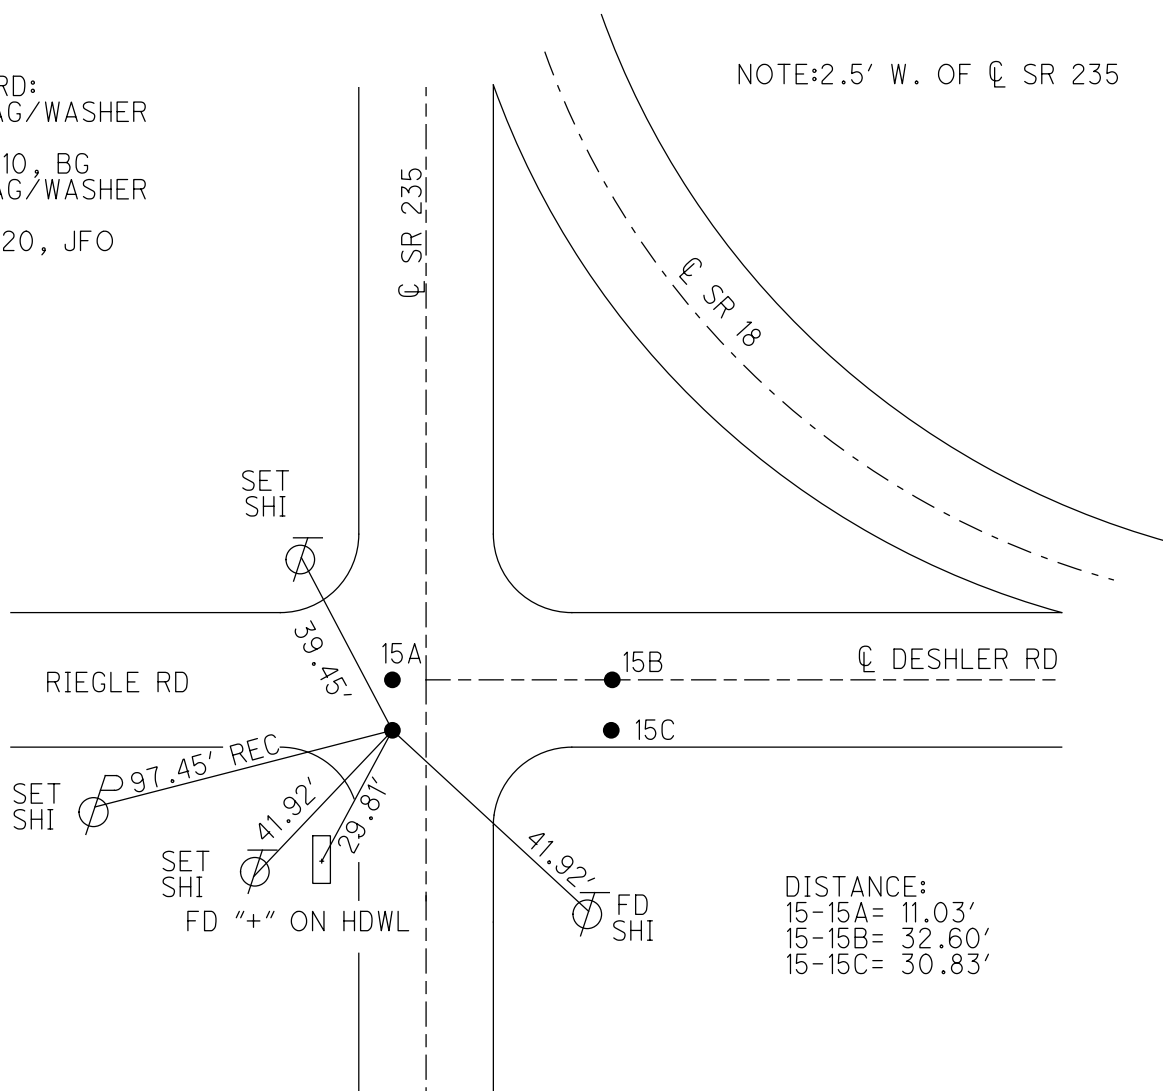


O.D.O.T. DISTRICT 2 SURVEY OFFICE (USE ONLY)

PERSONNEL _____ REFERENCE NO. 3 SHEET 5 OF 8

NOTES	NUHFER	DATE	5-06-04	ROUTE	SR 235
H.C.	CANERBURY	WEATHER	SUNNY	COUNTY	WOOD
R.C.	ARMS	TEMP.	65°F	TOWNSHIP	JACKSON
				SECTION	25
				T	3 N R 9 E

TYPE MONUMENT MAG/WASHER
 ON SURFACE - ~~BELOW~~ ON
 LEFT - CL PAV'T - ~~RIGHT~~ 2.5'
TO EDGE PAVEMENT
 S.L.M. 53+76.82

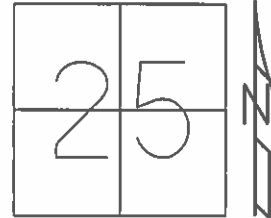


Grid: Northing: 554935.163 Easting: 1614977.299

RECORD:
 PK WASHER @SURFACE
 11.0 S. OF CL EAST
 2.5 LT. OF CL S.R. 235
 ON CL WEST

SET MAG/WASHER
 ALL FOUR POINTS
 08-03-04, MC

REF 3B TO REF 3C = 10.99'
 REF 3B TO REF 3A = 31.68'
 REF 3B TO REF 3 = 30.84'
 REF 3C TO REF 3A = 29.60'
 REF 3C TO REF 3 = 32.65'
 REF 3A TO REF 3 = 11.05'

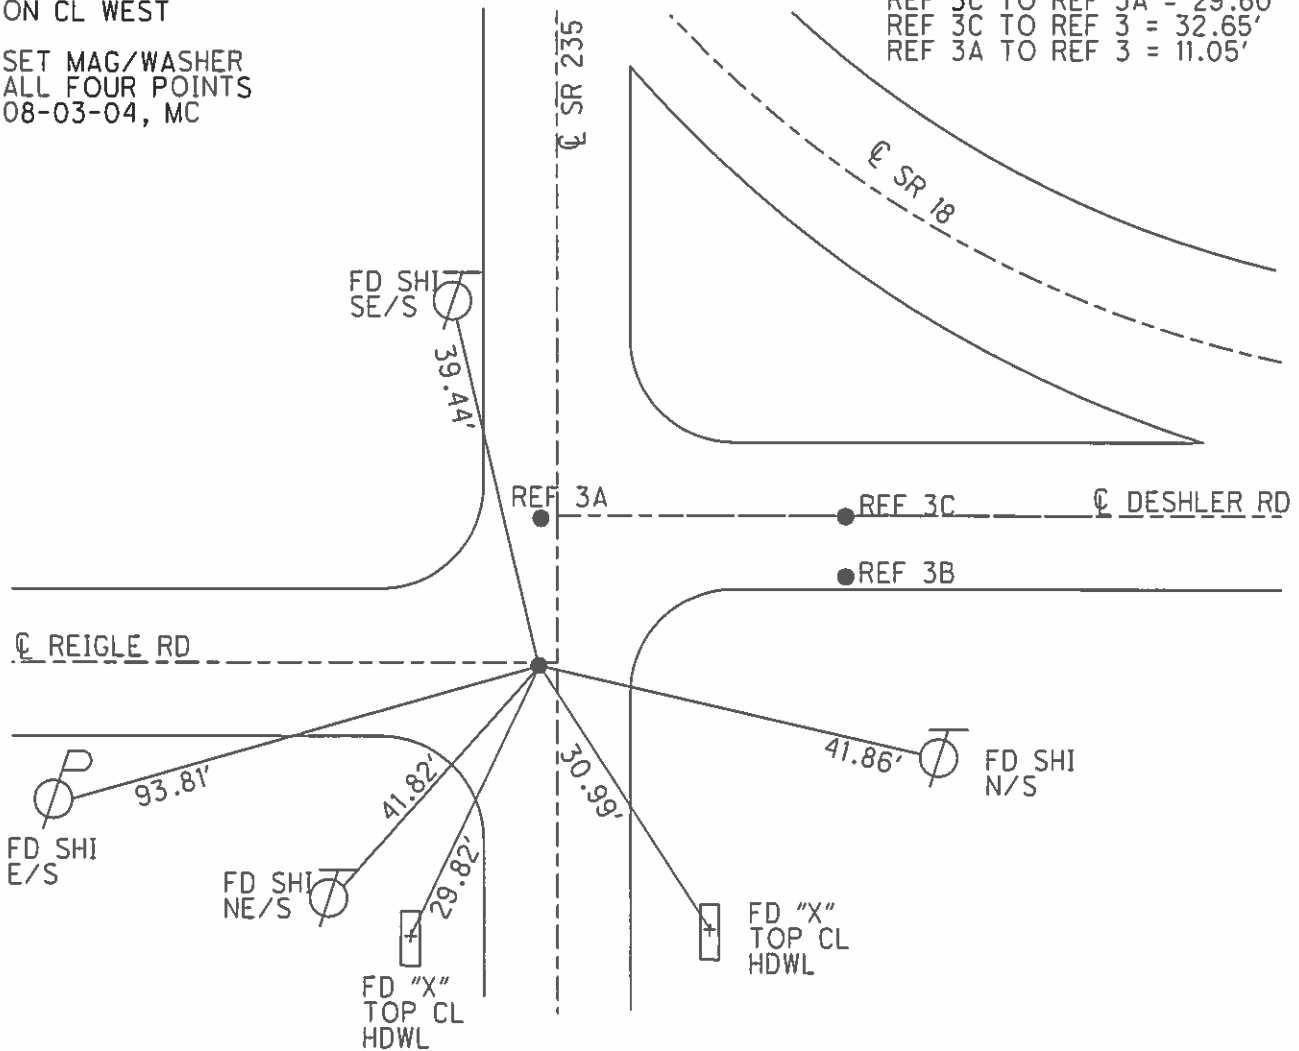

O.D.O.T. DISTRICT 2 SURVEY OFFICE (USE ONLY)

PERSONNEL

REFERENCE NO.

15

SHEET 1 OF 26

1 OF 26

NOTES BARNHISEL

DATE 3/19/91

3/19/91

ROUTE SR 18

SR 18

H.C. LOEHRKE

WEATHER CLOUDY/WINDY

CLOUDY/WINDY

COUNTY WOOD

WOOD

R.C. HOFFMAN

TEMP. 45°

45°

TOWNSHIP JACKSON

JACKSON

SECTION 26

26

T_3_N R_9_E

R_9_E

TYPE MONUMENT 1/2" IPIN

1/2" IPIN

~~ON SURFACE~~ - BELOW 2.0"

2.0"

LEFT - C PAV'T - RIGHT 11.0' S. OF C E.

11.0' S. OF C E.

____TO____EDGE PAVEMENT

____TO____EDGE PAVEMENT

S.L.M. 343+18

 $343+18$

Grid: Northing: 554935.163 Easting: 1614977.299

Easting: 1614977.299


NOTE:

2.5' W. OF C SR 235

FD MAG/WASHER

GPS, SV D15

6/16/10, BG

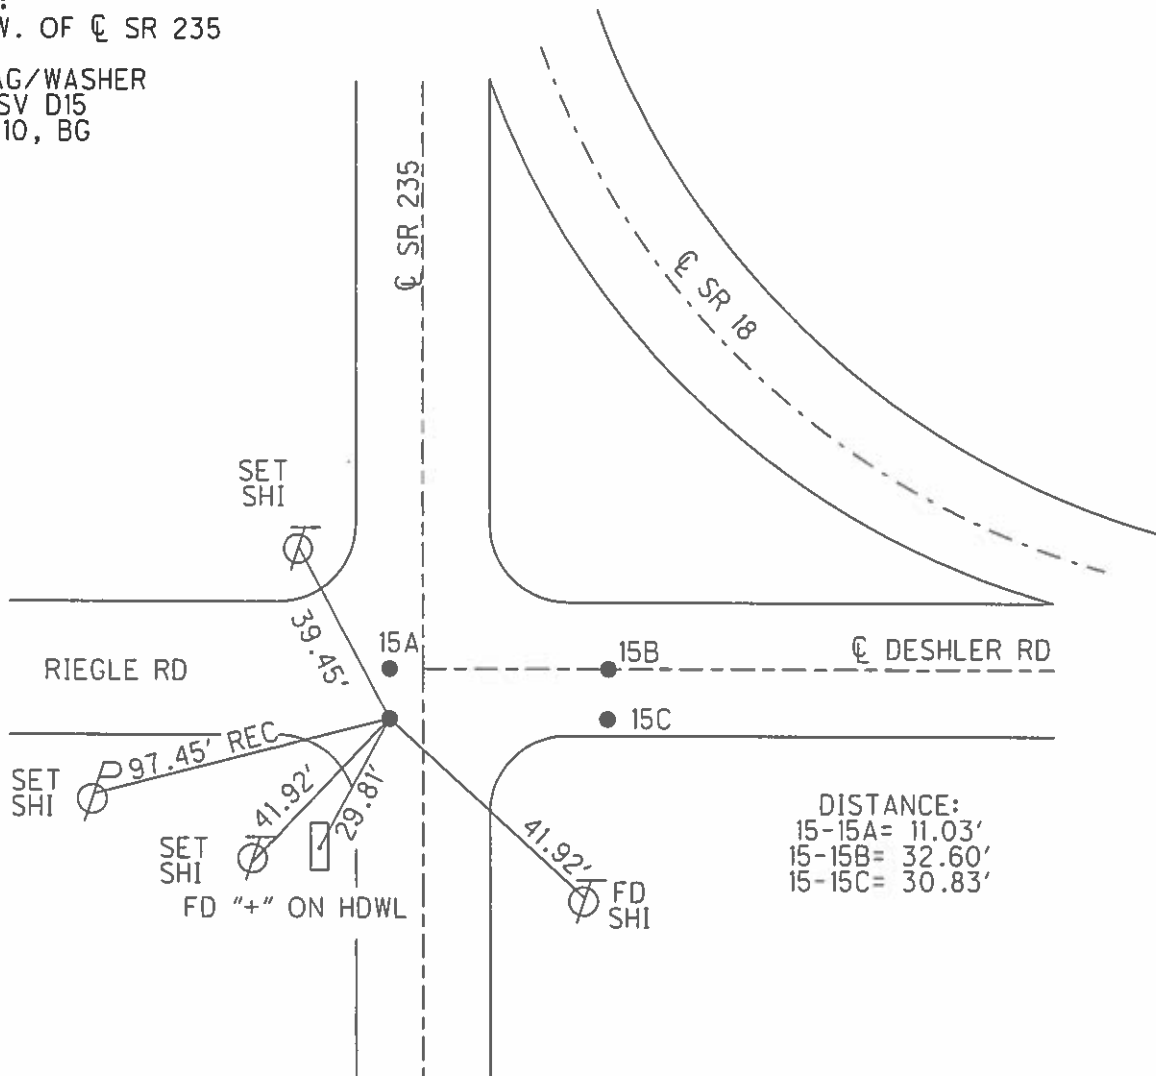

DISTANCE:
15-15A= 11.03'
15-15B= 32.60'
15-15C= 30.83'

O.D.O.T. DISTRICT 2 SURVEY OFFICE (USE ONLY)

PERSONNEL

REFERENCE NO.

15

SHEET

3

OF 26

NOTES BARNHISEL

DATE _____

3/19/91

ROUTE

SR 18

H.C. LOEHRKE

WEATHER

CLOUDY/WINDY

COUNTY

WOOD

R.C. HOFFMAN

TEMP.

$$\overline{45^\circ}$$

TOWNSHIP

JACKSON

SECTION

26

T 3 N R 9 E

TYPE MONUMENT 1/2" IPIN


~~ON SURFACE~~ - BELOW 2.0"

LEFT - C PAV'T - RIGHT 11.0' S. OF C E.

____ TO ____ EDGE PAVEMENT

S.I.M. 343+18

Grid: Northing: 1614977.299

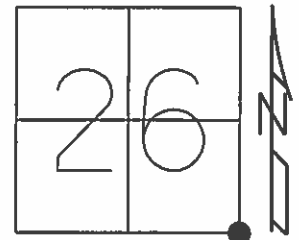Easting: 554935.163


NOTE:

2.5' W. OF C SR 235

FD MAG/WASHER

GPS, SV D15

6/16/10, BG

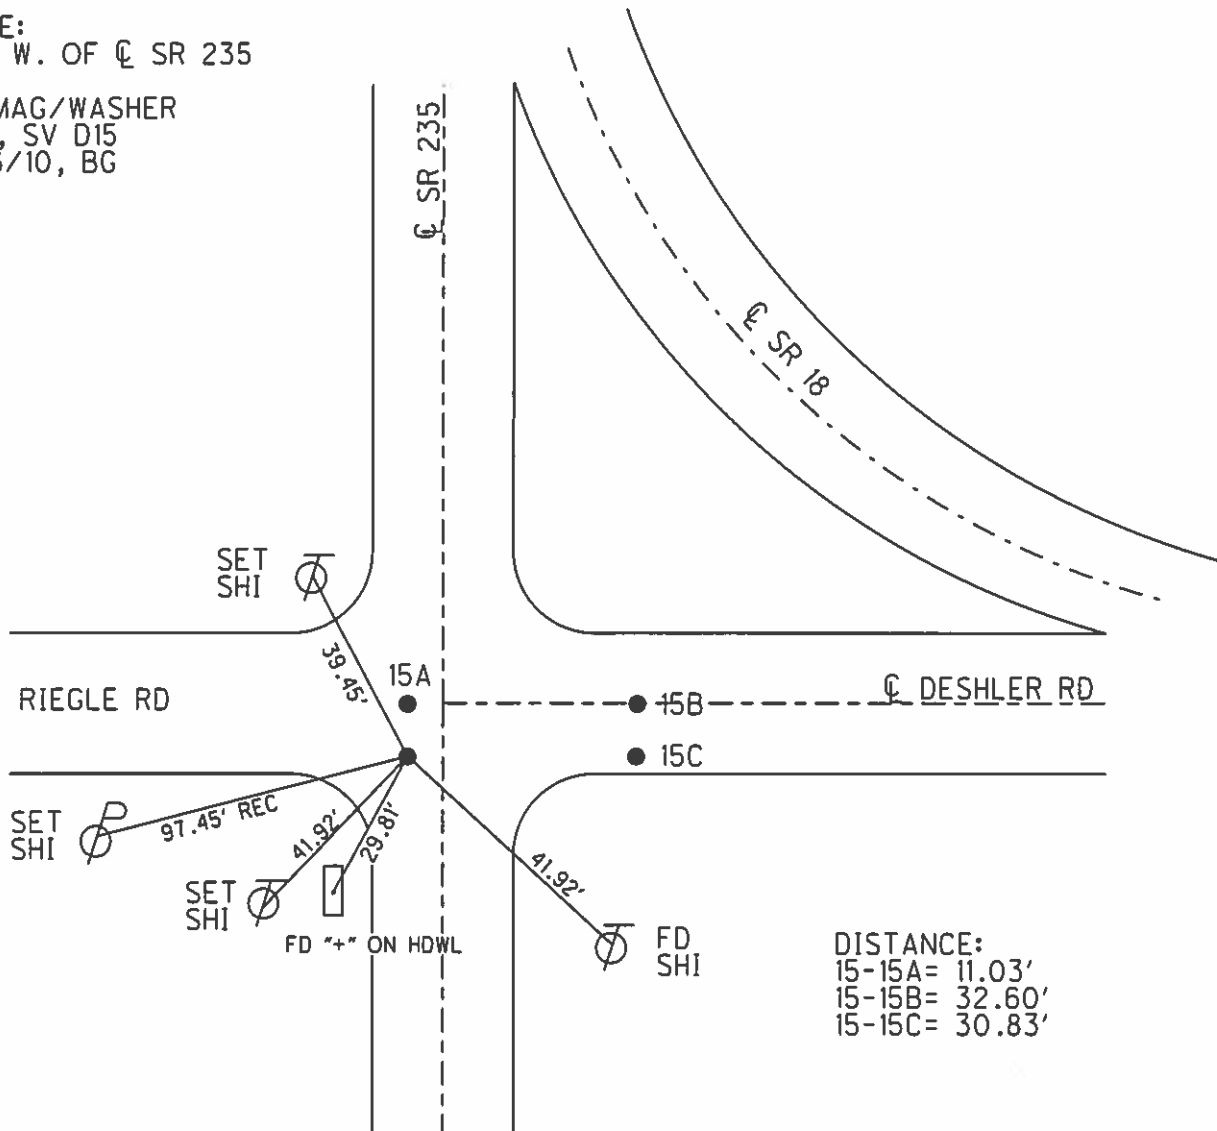

DISTANCE:

15-15A= 11.03'

15-15B= 32.60'

$$15-15C = 30.83'$$

O.D.O.T. DISTRICT 2 SURVEY OFFICE

PERSONNEL

REFERENCE NO. 15

SHEET OF

NOTES BARNHISEL

H.C. Loehake

R.C. HOFFMAN

DATE 3-19-91

WEATHER cloudy - windy

TEMP. +45°

ROUTE 18 & 235

COUNTY Wood

TOWNSHIP JACKSON


SECTION 26

T 3 N R 9 E

TYPE MONUMENT P.K.'s & Washers
ON SURFACE - BELOW YES (ALL)
LEFT- & PAV'T. - RIGHT Information Below
- TO - EDGE PAVEMENT

S.L.M. NOT COVERED IN 1991 RESURFACING OF S.R. 18

PT. "D"
1/2" IRON PIN
1 1/2" DOWN

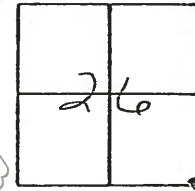


PT. "A"
11.0 S. OF & EAST,
27.5 E. OF & S.R. 235

PT. "B"
ON & PAV'T E.
27.5 E. OF & S.R. 235

PT. "C"
ON & PAV'T E.
2.2 W. OF & S.R. 235

PT. "D"
11.0 S. OF & E.
2.5 W. OF & S.R. 235
2" DOWN

A TO B = 10.86
B TO C = 29.58
A TO C = 31.63
C TO D = 11.03
D TO A = 30.83
D TO B = 32.60

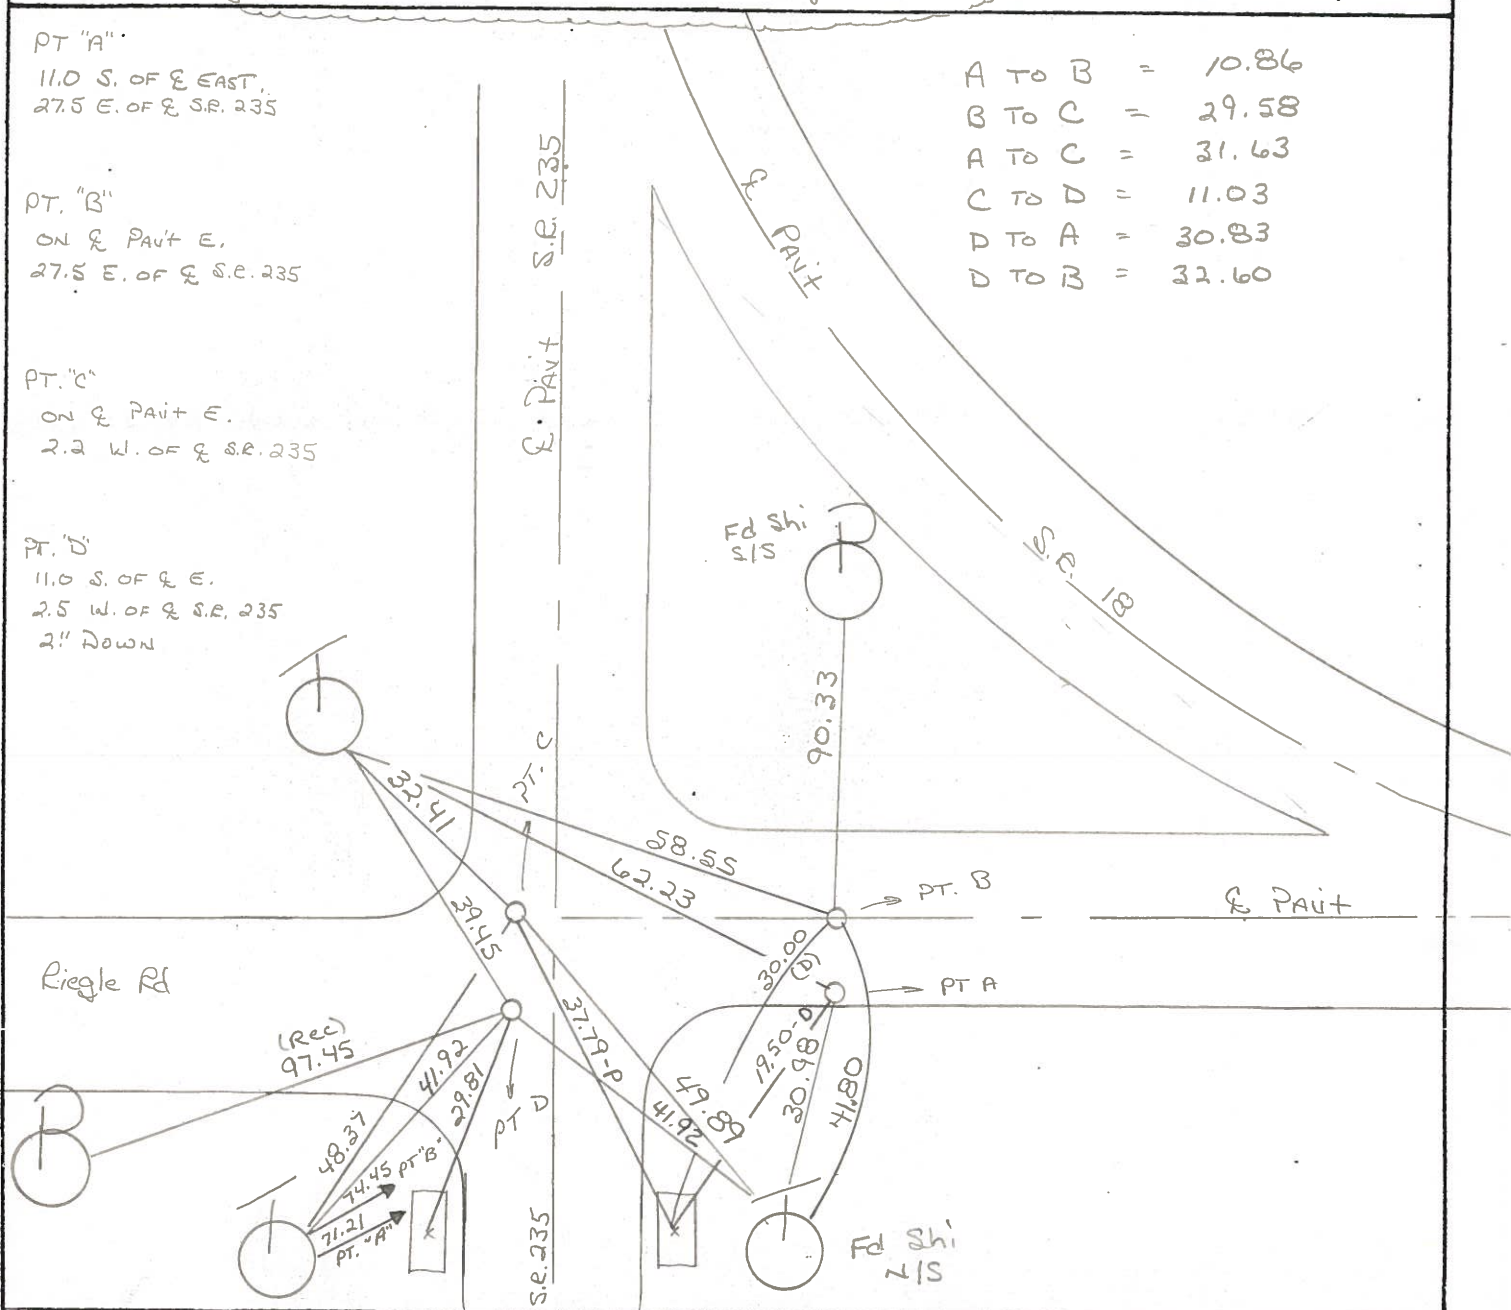

ED "X" ON BOTH HDWS

Q.D.O.T. DISTRICT 2 SURVEY OFFICE

SHEET 15 OF

County WOOD S.R. 18

Township JACKSON

Section 26

T N, R E

Personnel BARNHISEL H.C


HOUSEHOLDER R.C

LOEHRKE ☒

Date 11-28-83

Weather RAIN, CLOUDY

Temp. +40°

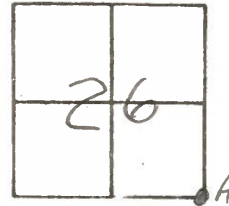


"A" RR SPIKE @ SURFACE OVER STONE
SLM 53+75 (SR 235)
10.9 S of Q PAVT 18
27.1 E of Q PAVT 235

"C" RR SPIKE @ SURFACE
SLM 53+86 (SR 235)
ON Q PAVT SR 18 E
2.5' W of Q PAVT 235

#15

"B" BOAT SPIKE @ SURFACE
SLM 53+86 (SR 235)
ON CL PAVT 18
27.1 E of Q PAVT 235

SET PK+WASHEN
@ ALL PTS
7-25-85
C.L.

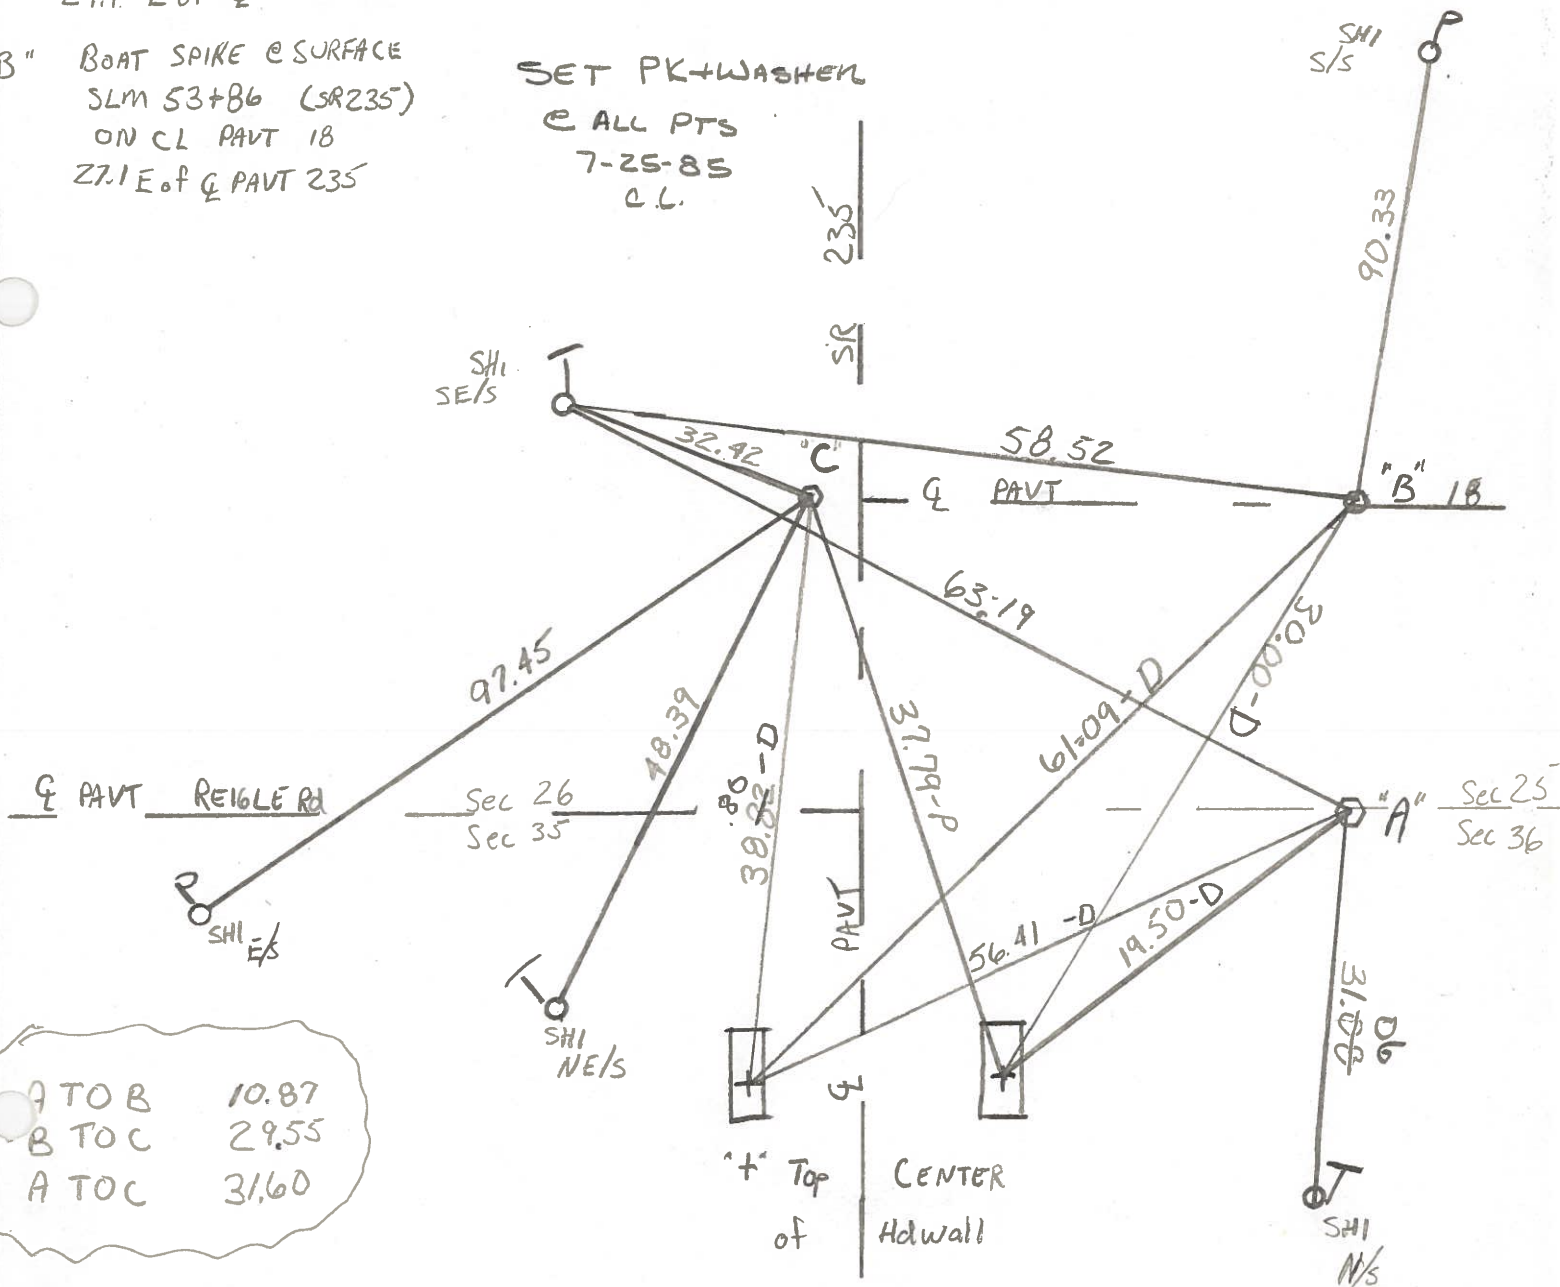

A TO B 10.87
B TO C 29.55
A TO C 31.60

"+" Top
of
CENTER
of
Hdwall

County WOOD S.R. 18

Township JACKSON

Section 26


T.N, R.E

Personnel BARNHISEL H.C
HOUSEHOLDER R.C
LOEHM 

Date 11-28-83

Weather RAIN CLOUDY

Temp. +40°

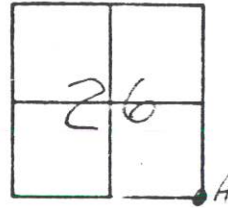


"A" RR SPIKE @ SURFACE OVER STONE
 SLM 53+75 (SR 235)
 10.9 S of & PAVT 18
 27.1 E of & PAVT 235

"C" RR SPIKE @ SURFACE
 SLM 53+86 (SR 235)
 ON & PAVT SR 18 E
 2.5' W of & PAVT 235

#15

"B" BOAT SPIKE @ SURFACE
 SLM 53+86 (SR 235)
 ON CL PAVT 18
 27.1 E of & PAVT 235

SET PK+WASHEN
 @ ALL PTS
 7-25-85
 C.L.

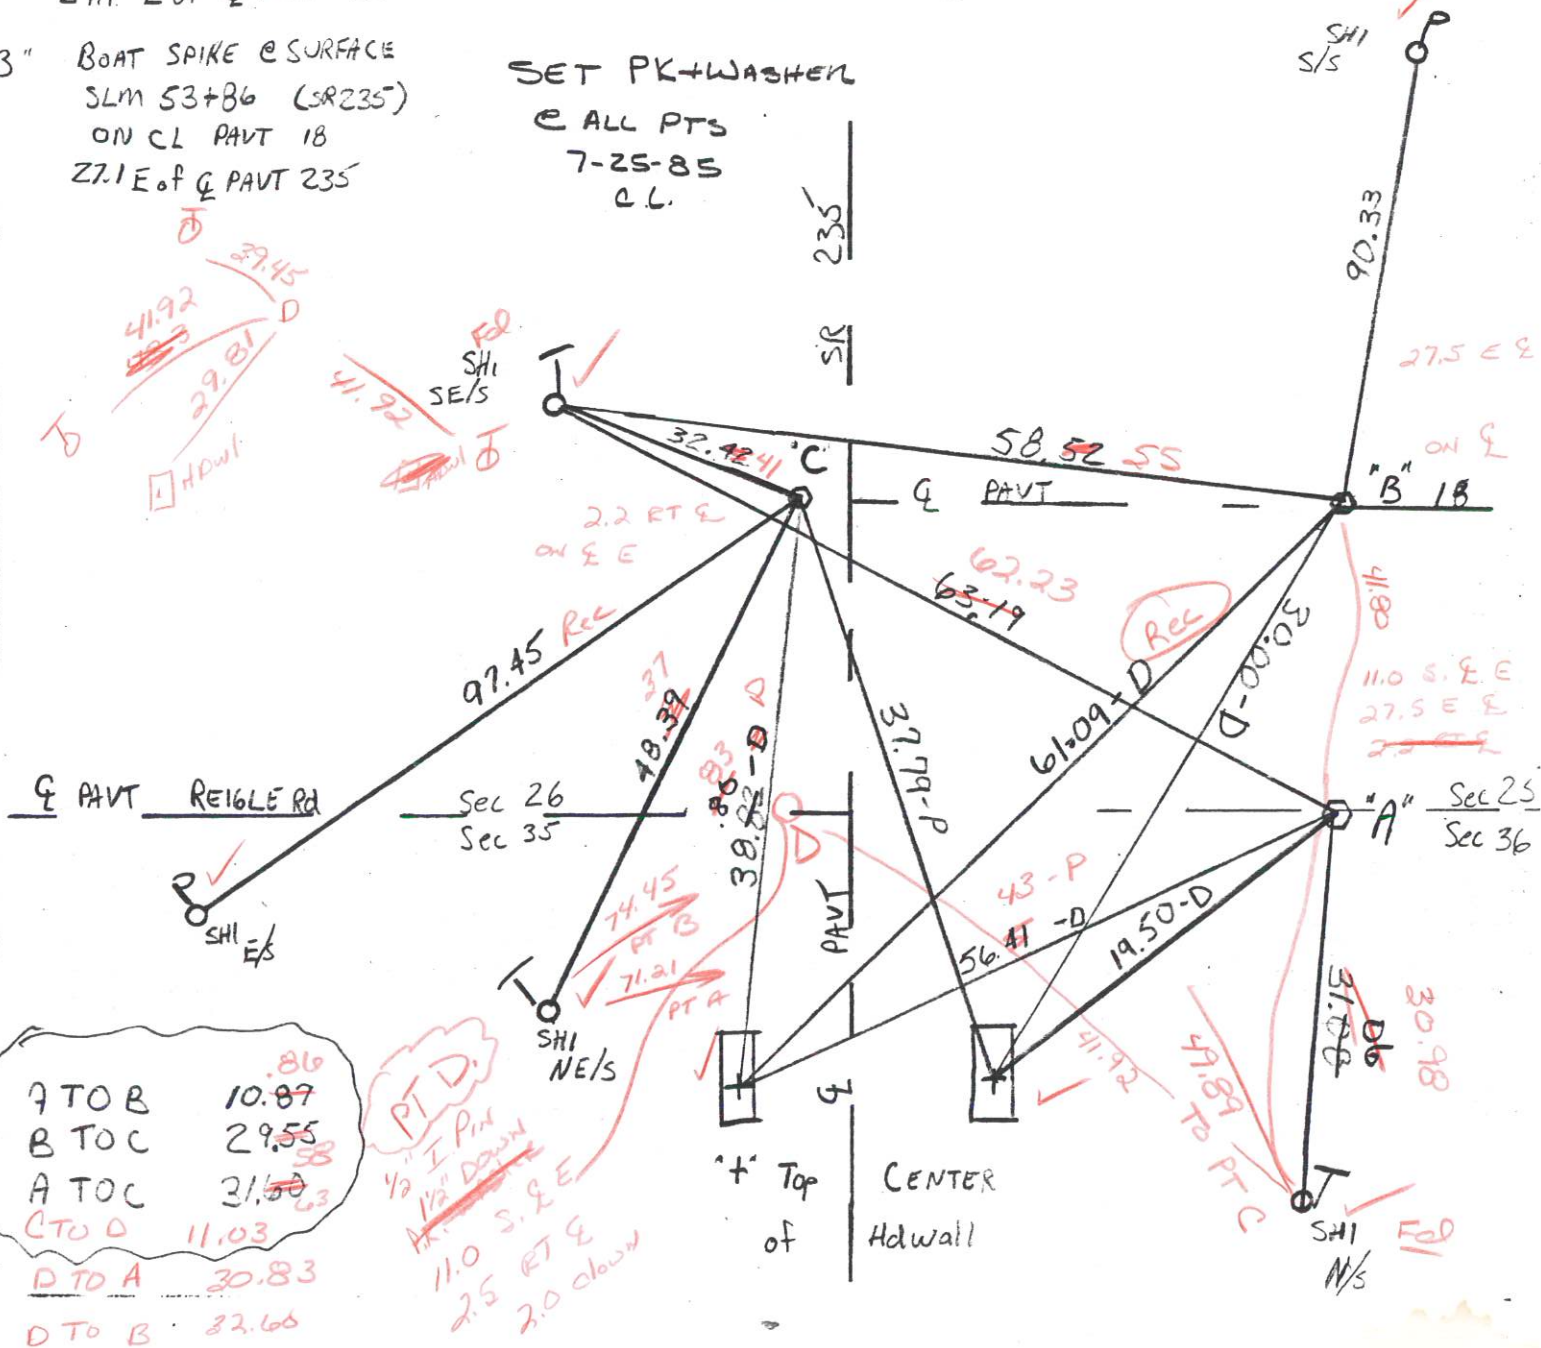

7 TO B 10.87
 B TO C 29.55
 A TO C 31.50
 C TO D 11.03
 D TO A 30.83
 D TO B 32.60

PT D
 1/2" I Pin
 1 1/2" DOWN
 11.0 S. & E
 2.5 RT &
 2.0 down

O.D.O.T. DISTRICT 2 SURVEY OFFICE

SHEET 15 OF

County WOOD S.R. 18

Date 6-18-71

Township JACKSON


Weather CLEAR

Section 26

Temp. 88°

T3N, R9E

Personnel BURNSIDE

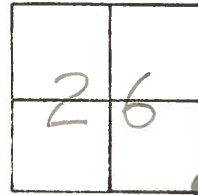

SMITH

BOWERS

HOLCOMBE

ROCCHINI

#15

STONE 30' E. OF P.I. &
11'-S. OF E. OF SURVEY

FD. 1" IRON ROD
OVER STONE

REIGLE ROAD

S.R. 18

