

O.D.O.T. DISTRICT 2 SURVEY OFFICE (USE ONLY)

PERSONNEL

REFERENCE NO. 15A

SHEET 5 OF 52

NOTES NIESE

DATE 10/28/24

ROUTE SR 18

H.C. NIESE

WEATHER CLEAR

COUNTY WOOD

R.C. PRESTON-COLVIN

TEMP. 42°F

TOWNSHIP JACKSON

DWG BY BARRIERE

PID 101290

SECTION 25

T 3 N R 9 E

TYPE MONUMENT MAGNAIL/WASHER

ON SURFACE - BELOW ON

OFFSET Q PAVEMENT LT : RT

 TO EDGE PAVEMENT

STATION: 343+18

HORZ.DATUM: WOOD LDP

GEOID: 18

GRID: NORTHING: 376295.312

EASTING: 127046.020

LDP: NORTHING: 554946.152

EASTING: 1614978.692

26	25
35	36




P.I. FOR APPROACHES
STA 346+43.13
(1927 PLANS)

FD MAG/WASHER
GPS, SV C15
6/16/10, BC
FD MAG/WASHER
REFA15
6/15/20, JFO
5/21/24, TDN
SET MAG/WASHER
10/28/24, TDN


NOTE: 2.5' W. OF Q SR 235

****SR 235 REF A3****

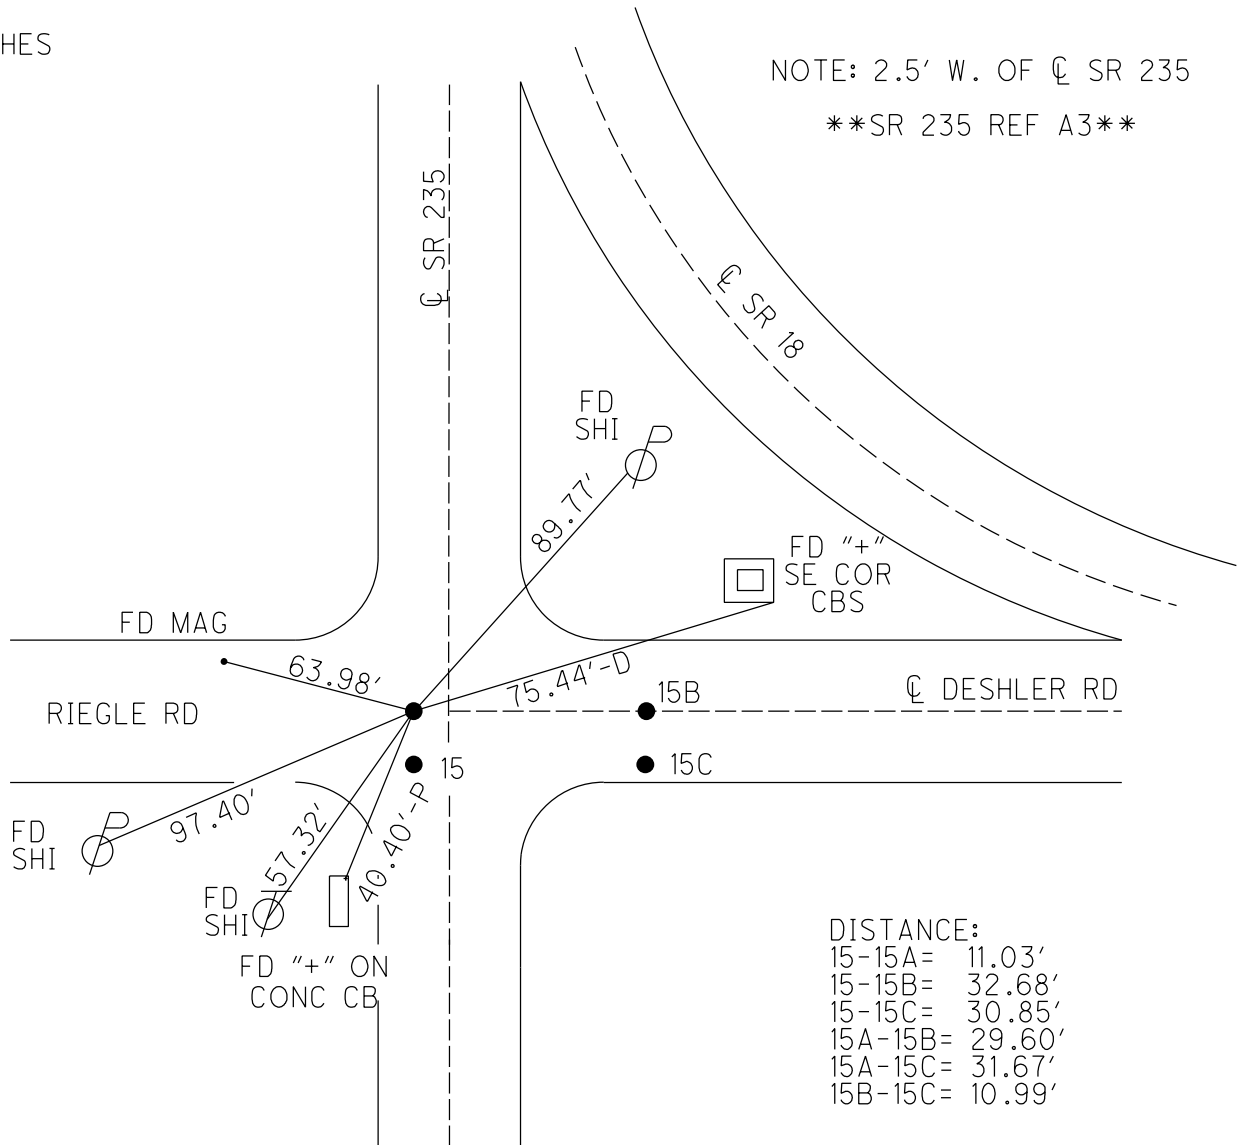

DISTANCE:
15-15A= 11.03'
15-15B= 32.68'
15-15C= 30.85'
15A-15B= 29.60'
15A-15C= 31.67'
15B-15C= 10.99'

PERSONNEL	REFERENCE NO.	15 A	SHEET	2	OF	51
NOTES	BARNHISEL	DATE	3/19/91	ROUTE	SR	18
H.C.	LOEHRKE	WEATHER	CLOUDY/WINDY	COUNTY	WOOD	
R.C.	HOFFMAN	TEMP.	45°	TOWNSHIP	JACKSON	
				SECTION	26	
DWG BY	O'DONNELL	PID	PAVETRAIN	T	3	N R 9 E

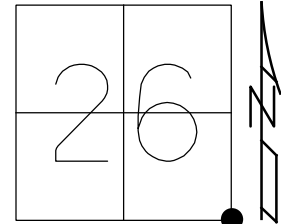EASTING: 1614978.705

W. OF C SR 235

MAG/WASHER
SV C15
S/10, BG
MAG/WASHER
A15
S/20, JFO

C SR 235

SET SHI

RIEGLE RD

DESHER RD

15B

15C

15

FD "+" ON HDWL

FD SHI

DISTANCE:
15A-15= 11.03'
15A-15B= 29.58'
15A-15C= 31.63'


DISTANCE:
15A-15= 11.03'
15A-15B= 29.58'
15A-15C= 31.63'

O.D.O.T. DISTRICT 2 SURVEY OFFICE (USE ONLY)

PERSONNEL _____ REFERENCE NO. 3 A SHEET 6 OF 8
 NOTES NUHFER DATE 5-06-04 ROUTE SR 235
 H.C. CANERBURY WEATHER SUNNY COUNTY WOOD
 R.C. ARMS TEMP. 65°F TOWNSHIP JACKSON
 _____ SECTION 25
 _____ T 3 N R 9 E

TYPE MONUMENT MAG/WASHER
 ON SURFACE - ~~BELOW~~ ON
 LEFT - CL PAV'T - ~~RIGHT~~ 2.2'
 - TO - EDGE PAVEMENT
 S.L.M. 53+87.81


Grid: Northing: 554946.224 Easting: 1614978.645

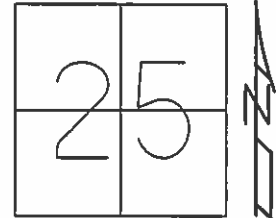

RECORD:
 PK WASHER@2"DOWN
 ON CL OF PAVEMENT EAST
 2.2 LT. OF CL S.R. 235

SET MAG/WASHER
 ALL FOUR POINTS
 08-03-04, MC

REF 3B TO REF 3C = 10.99'
 REF 3B TO REF 3A = 31.68'
 REF 3B TO REF 3 = 30.84'
 REF 3C TO REF 3A = 29.60'
 REF 3C TO REF 3 = 32.65'
 REF 3A TO REF 3 = 11.05'

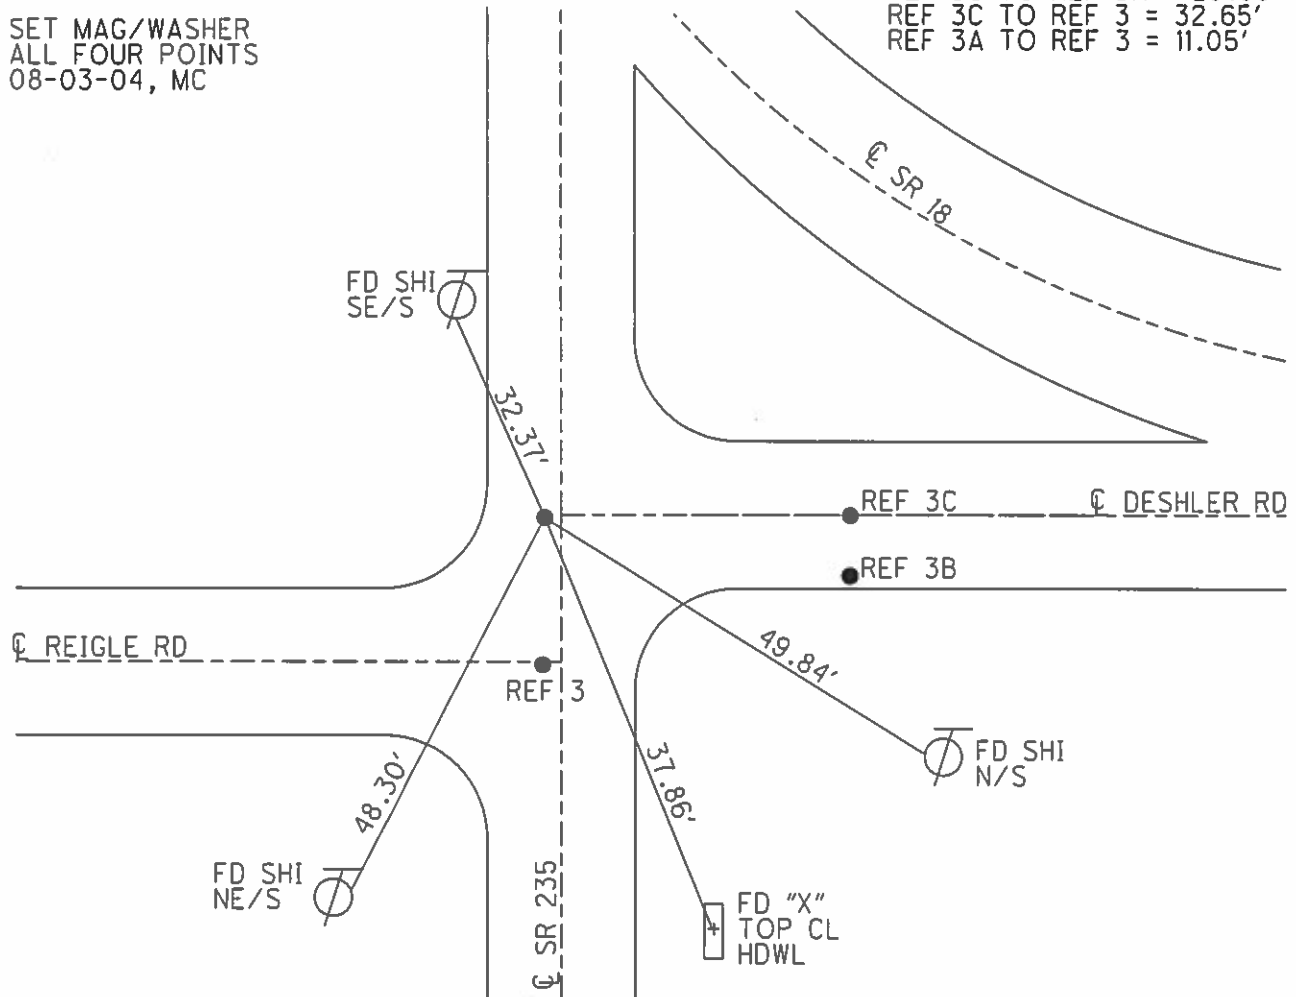


O.D.O.T. DISTRICT 2 SURVEY OFFICE (USE ONLY)

PERSONNEL	REFERENCE NO. <u>15 A</u>	SHEET <u>2</u> OF <u>26</u>	
NOTES <u>BARNHISEL</u>	DATE <u>3/19/91</u>	ROUTE <u>SR 18</u>	
H.C. <u>LOEHRKE</u>	WEATHER <u>CLOUDY/WINDY</u>	COUNTY <u>WOOD</u>	
R.C. <u>HOFFMAN</u>	TEMP. <u>45°</u>	TOWNSHIP <u>JACKSON</u>	
		SECTION <u>26</u>	
		T <u>3</u> N R <u>9</u> E	


TYPE MONUMENT P.K./WASHER
 ON SURFACE - ~~BELOW~~ ON
 LEFT - CL PAV'T - RIGHT ON CL E.
 - TO - EDGE PAVEMENT
 S.L.M. 343+18

Grid: Northing: 554946.224 Easting: 1614978.645

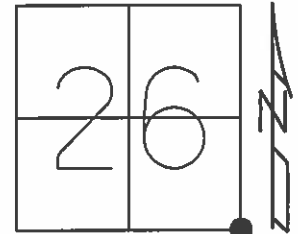

NOTE:
2.2' W. OF CL SR 235

FD MAG/WASHER
GPS, SV C15
6/16/10, BG

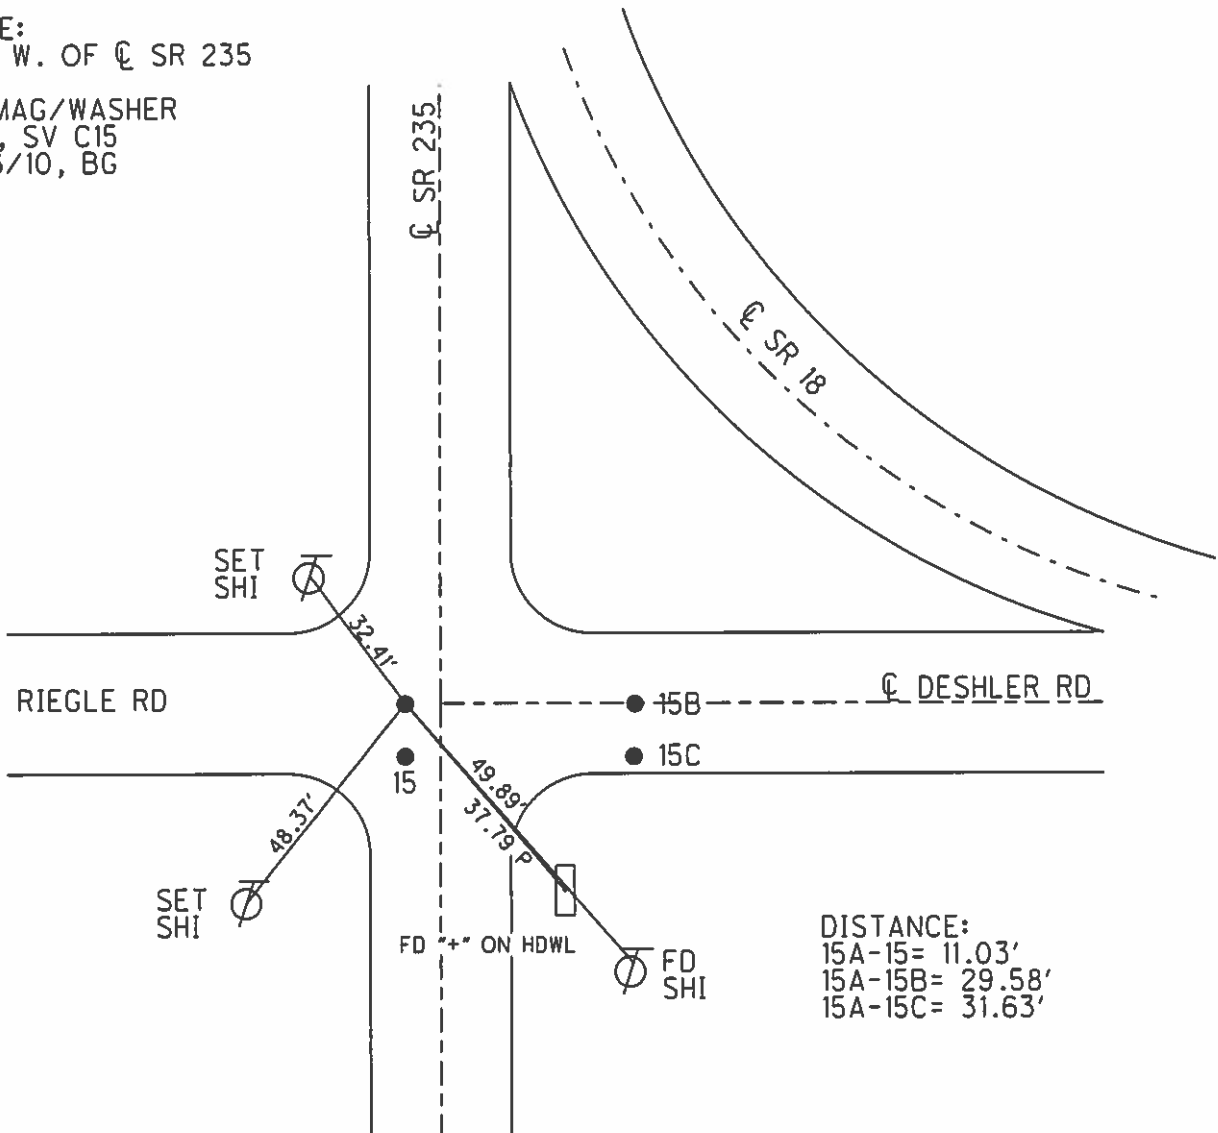

DISTANCE:
15A-15= 11.03'
15A-15B= 29.58'
15A-15C= 31.63'

O.D.O.T. DISTRICT 2 SURVEY OFFICE

PERSONNEL

REFERENCE NO. 15

SHEET OF

NOTES BARNHISEL

H.C. Loehake

R.C. HOFFMAN

DATE 3-19-91

WEATHER cloudy - windy

TEMP. +45°

ROUTE 18 & 235

COUNTY Wood

TOWNSHIP JACKSON

SECTION 26

T 3 N R 9 E

TYPE MONUMENT P.K.'s & Washers


ON SURFACE - BELOW YES (ALL)

LEFT- & PAV'T. - RIGHT Information Below

- TO - EDGE PAVEMENT

S.L.M. NOT COVERED IN 1991 RESURFACING OF S.R. 18

PT. "D"
1/2" IRON PIN
1 1/2" DOWN

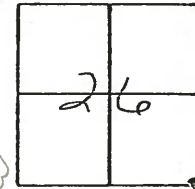


PT. "A"
11.0 S. OF & EAST,
27.5 E. OF & S.R. 235

PT. "B"
ON & PAV'T E.
27.5 E. OF & S.R. 235

PT. "C"
ON & PAV'T E.
2.2 W. OF & S.R. 235

PT. "D"
11.0 S. OF & E.
2.5 W. OF & S.R. 235
2" DOWN

A TO B = 10.86
B TO C = 29.58
A TO C = 31.63
C TO D = 11.03
D TO A = 30.83
D TO B = 32.60

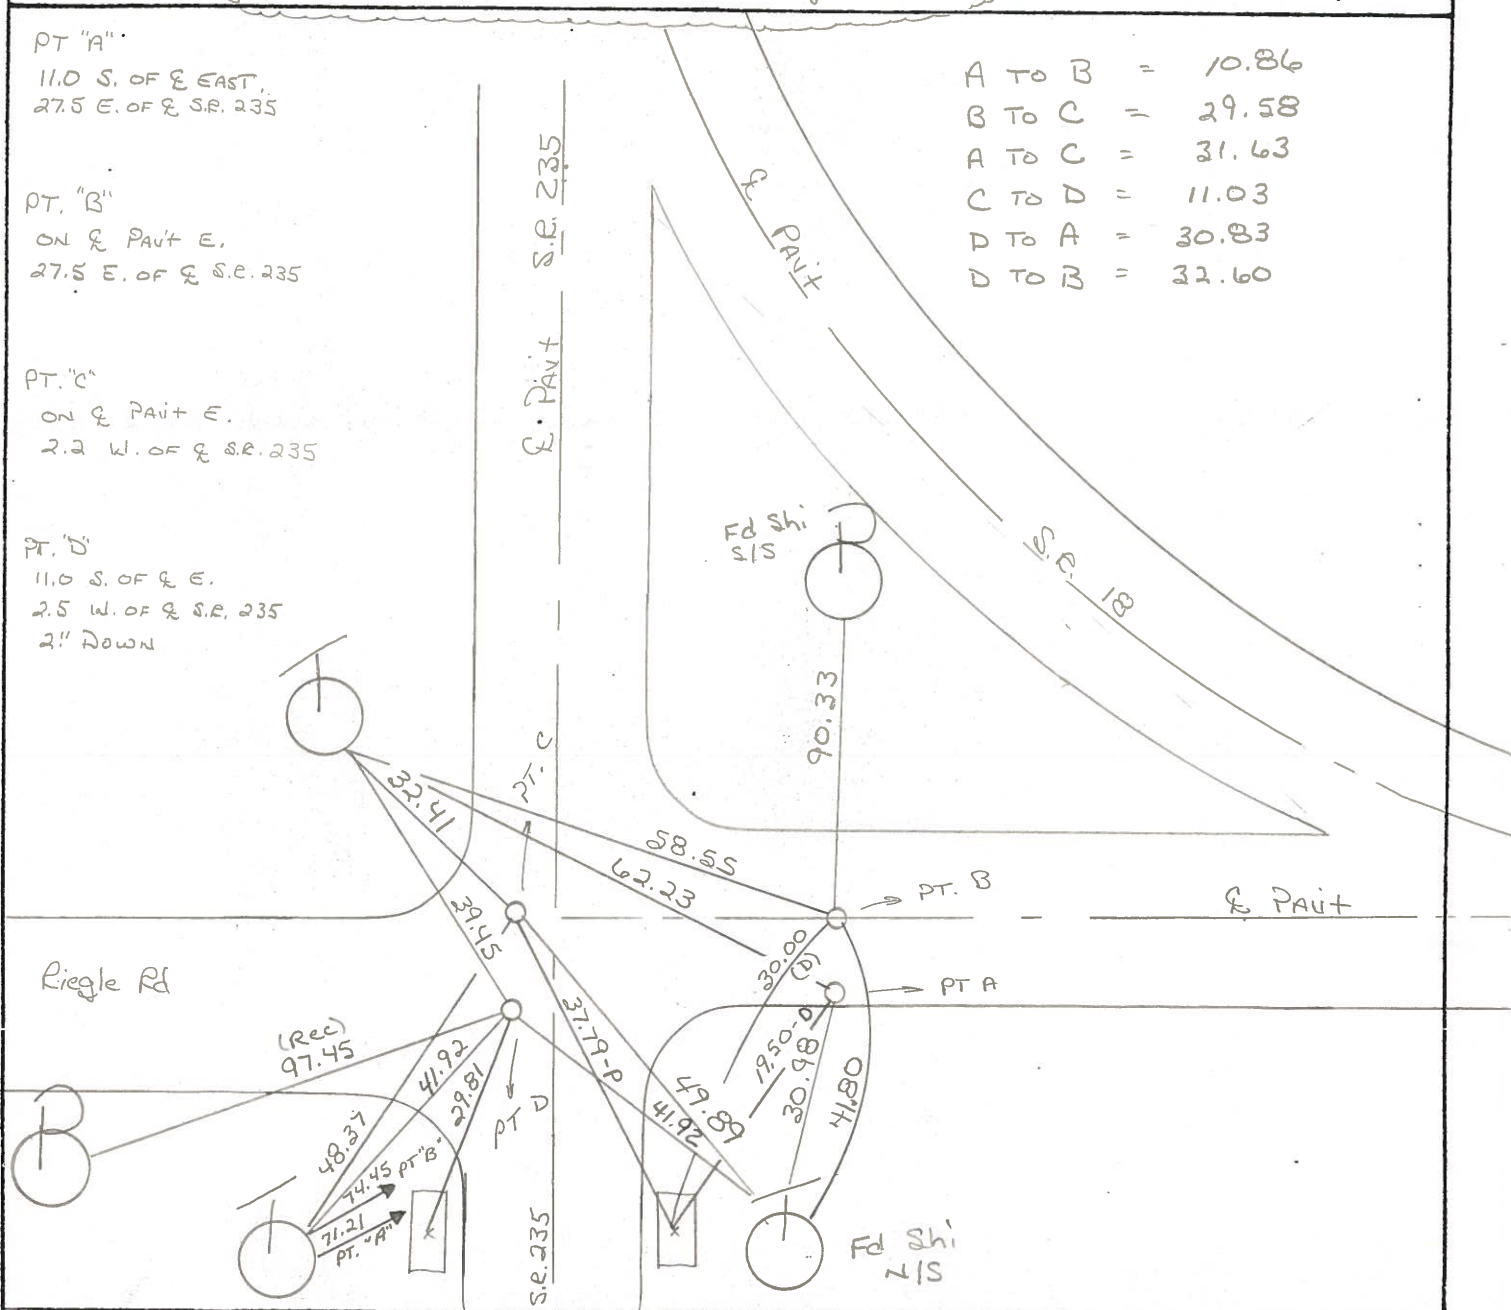

Q.D.O.T. DISTRICT 2 SURVEY OFFICE

SHEET 15 OF

County WOOD S.R. 18

Township JACKSON

Section 26

T N, R E

Personnel BARNHISEL H.C


HOUSEHOLDER R.C

LOEHRKE ☒

Date 11-28-83

Weather RAIN, CLOUDY

Temp. +40°

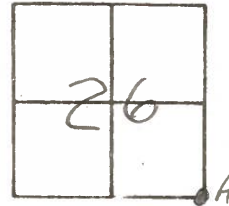

"A" RR SPIKE @ SURFACE OVER STONE
SLM 53+75 (SR 235)
10.9 S of Q PAVT 18
27.1 E of Q PAVT 235

"C" RR SPIKE @ SURFACE
SLM 53+86 (SR 235)
ON Q PAVT SR 18 E
2.5' W of Q PAVT 235

#15

"B" BOAT SPIKE @ SURFACE
SLM 53+86 (SR 235)
ON CL PAVT 18
27.1 E of Q PAVT 235

SET PK+WASHEN
@ ALL PTS
7-25-85
C.L.

