

DISTANCE:


15-15A=	11.03'
15-15B=	32.68'
15-15C=	30.85'
15A-15B=	29.60'
15A-15C=	31.67'
15B-15C=	10.99'

O.D.O.T. DISTRICT 2 SURVEY OFFICE (USE ONLY)

PERSONNEL _____ REFERENCE NO. 15 C SHEET 4 OF 51
NOTES BARNHISEL DATE 3/19/91 ROUTE SR 18
H.C. LOEHRKE WEATHER CLOUDY/WINDY COUNTY WOOD
R.C. HOFFMAN TEMP. 45°F TOWNSHIP JACKSON
SECTION 26
DWG BY O'DONNELL PID PAVETRAIN T 3 N R 9 E


TYPE MONUMENT P.K./WASHER
ON SURFACE - ~~BELOW~~ ON
LEFT - ℄ PAV'T - RIGHT 11.0' S. OF ℄ E.
- TO - EDGE PAVEMENT
STATION: 343+47.58

HORIZ.DATUM: NAD83 (2011) GEOID: NAVD88-2012A
GRID: NORTHING: 554935.113 EASTING: 1615008.337

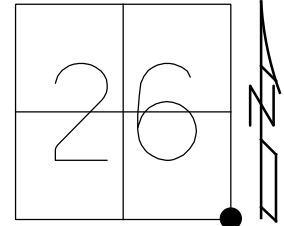

NOTE:
27.5' E. OF ℄ SR 235

FD MAG/WASHER
GPS, SV A15
6/16/10, BG
FD PK/WASHER
1-1/2" DOWN
REFC15
6/15/20, JFO

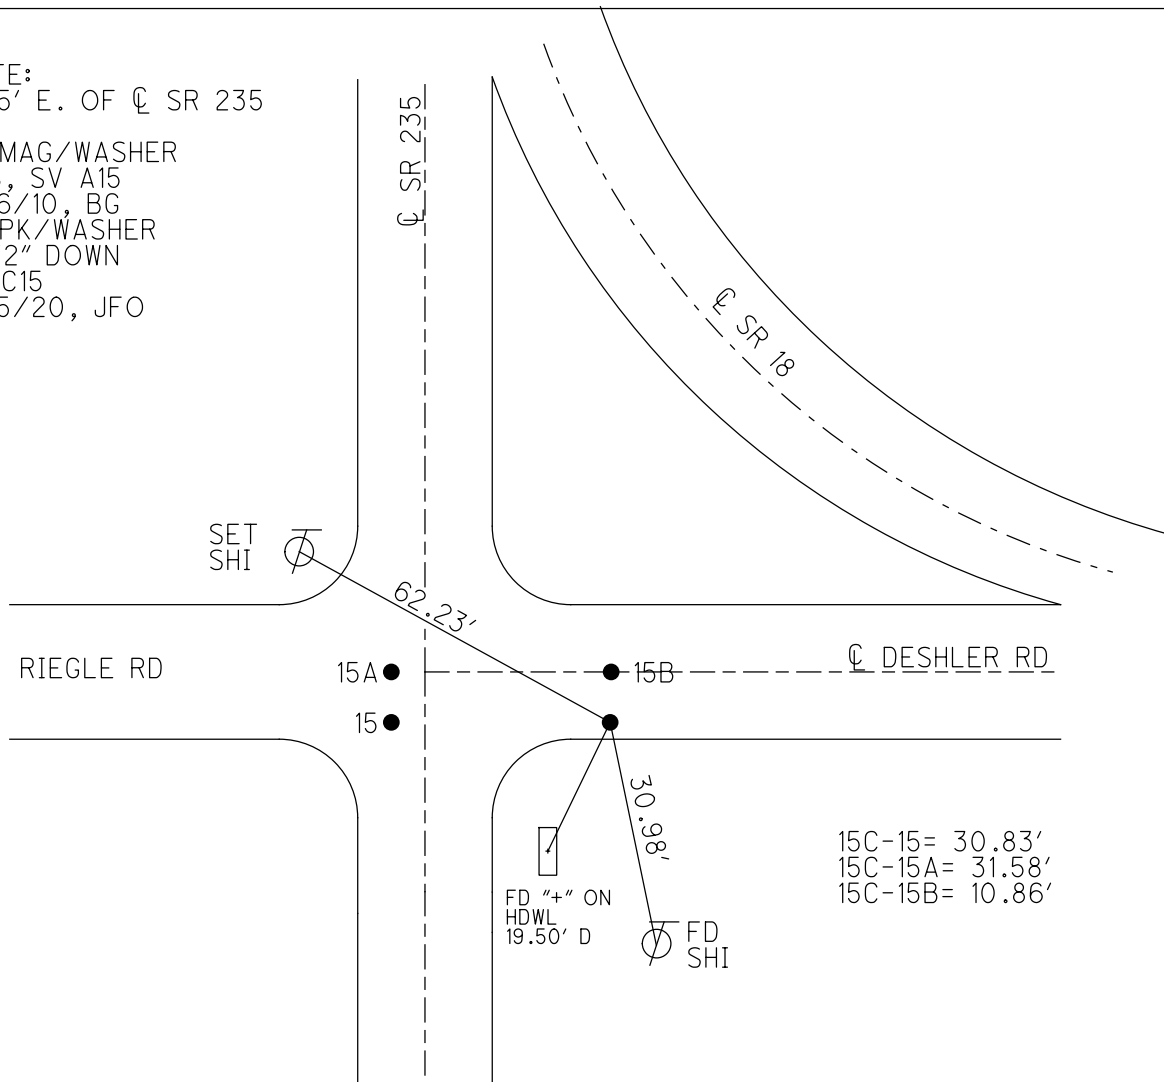


15C-15= 30.83'
15C-15A= 31.58'
15C-15B= 10.86'

O.D.O.T. DISTRICT 2 SURVEY OFFICE (USE ONLY)

PERSONNEL _____ REFERENCE NO. 3 B SHEET 7 OF 8

NOTES NUHFER DATE 5-06-04 ROUTE SR 235
H.C. CANERBURY WEATHER SUNNY COUNTY WOOD
R.C. ARMS TEMP. 65°F TOWNSHIP JACKSON
SECTION 25
T 3 N R 9 E

TYPE MONUMENT MAG/WASHER
ON SURFACE - ~~BELOW~~ ON _____
~~LEFT~~ - ℄ PAV'T - RIGHT 27.5'
- TO - EDGE PAVEMENT
S.L.M. 53+77

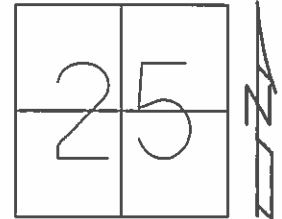


Grid: Northing: 554935.000 Easting: 1615008.353

RECORD:
OVER STONE

PK SHINER@SURFACE
11.0 S. OF ℄ EAST
27.5 E. OF ℄ S.R. 235

SET MAG/WASHER
ALL FOUR POINTS
08-03-04, MC

REF 3B TO REF 3C = 10.99'
REF 3B TO REF 3A = 31.68'
REF 3B TO REF 3 = 30.84'
REF 3C TO REF 3A = 29.60'
REF 3C TO REF 3 = 32.65'
REF 3A TO REF 3 = 11.05'

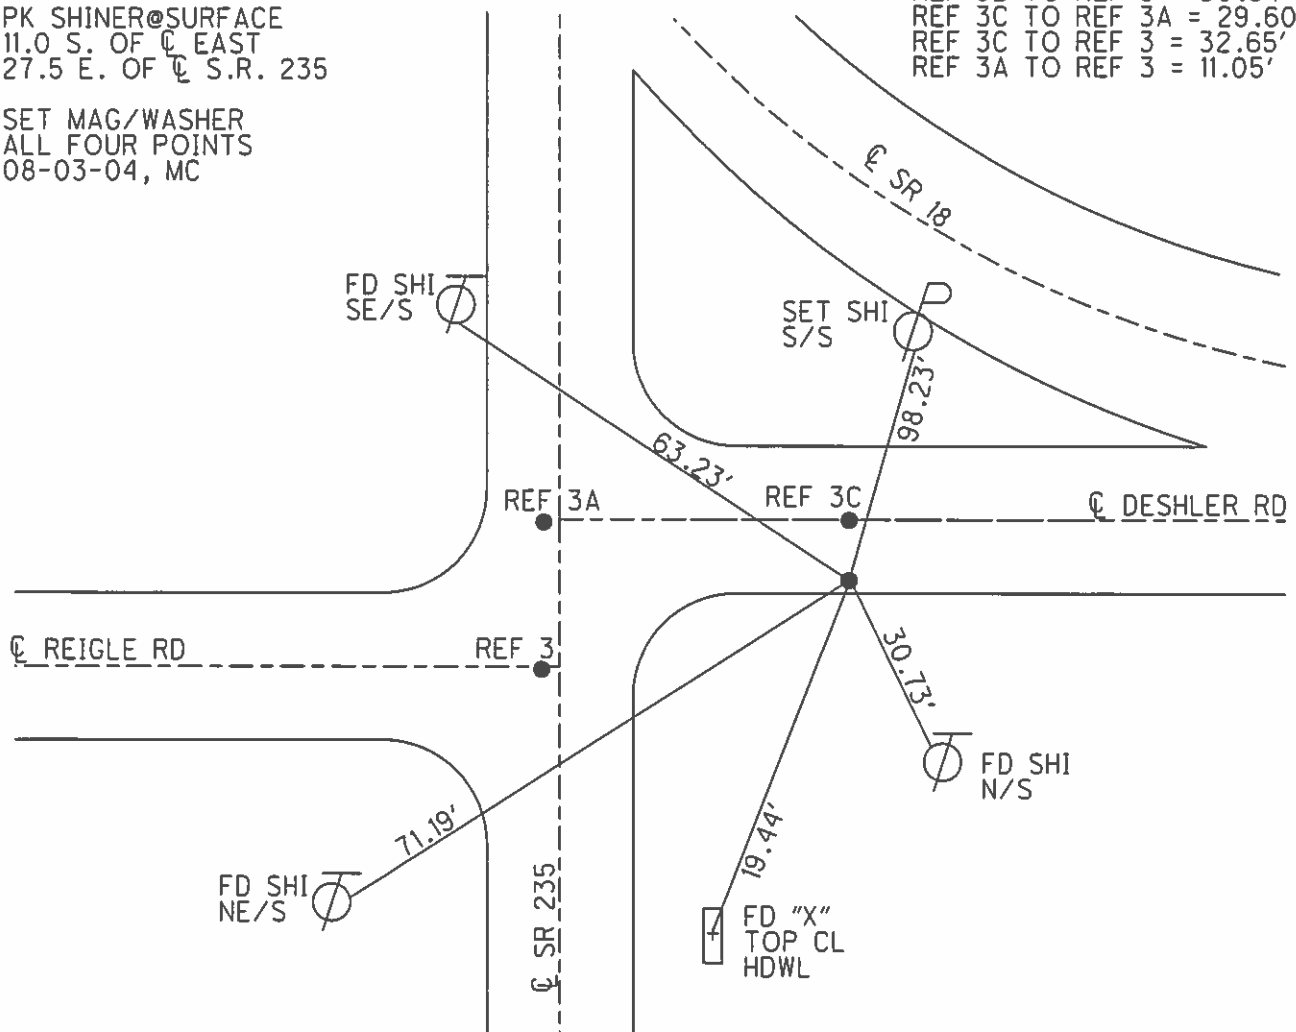

15C-15= 30.83'
15C-15A= 31.58'
15C-15B= 10.86'

O.D.O.T. DISTRICT 2 SURVEY OFFICE

PERSONNEL

REFERENCE NO. 15

SHEET OF

NOTES BARNHISEL

H.C. Loehake

R.C. HOFFMAN

DATE 3-19-91

WEATHER cloudy - windy

TEMP. +45°

ROUTE 18 & 235

COUNTY Wood

TOWNSHIP JACKSON


SECTION 26

T 3 N R 9 E

TYPE MONUMENT P.K.'s & Washers
ON SURFACE - BELOW YES (ALL)
LEFT- & PAV'T. - RIGHT Information Below
- TO - EDGE PAVEMENT

S.L.M. NOT COVERED IN 1991 RESURFACING OF S.R. 18

PT. "D"
1/2" IRON PIN
1 1/2" DOWN

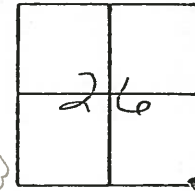


PT. "A"
11.0 S. OF & EAST,
27.5 E. OF & S.R. 235

PT. "B"
ON & PAV'T E.
27.5 E. OF & S.R. 235

PT. "C"
ON & PAV'T E.
2.2 W. OF & S.R. 235

PT. "D"
11.0 S. OF & E.
2.5 W. OF & S.R. 235
2" DOWN

A TO B = 10.86
B TO C = 29.58
A TO C = 31.63
C TO D = 11.03
D TO A = 30.83
D TO B = 32.60

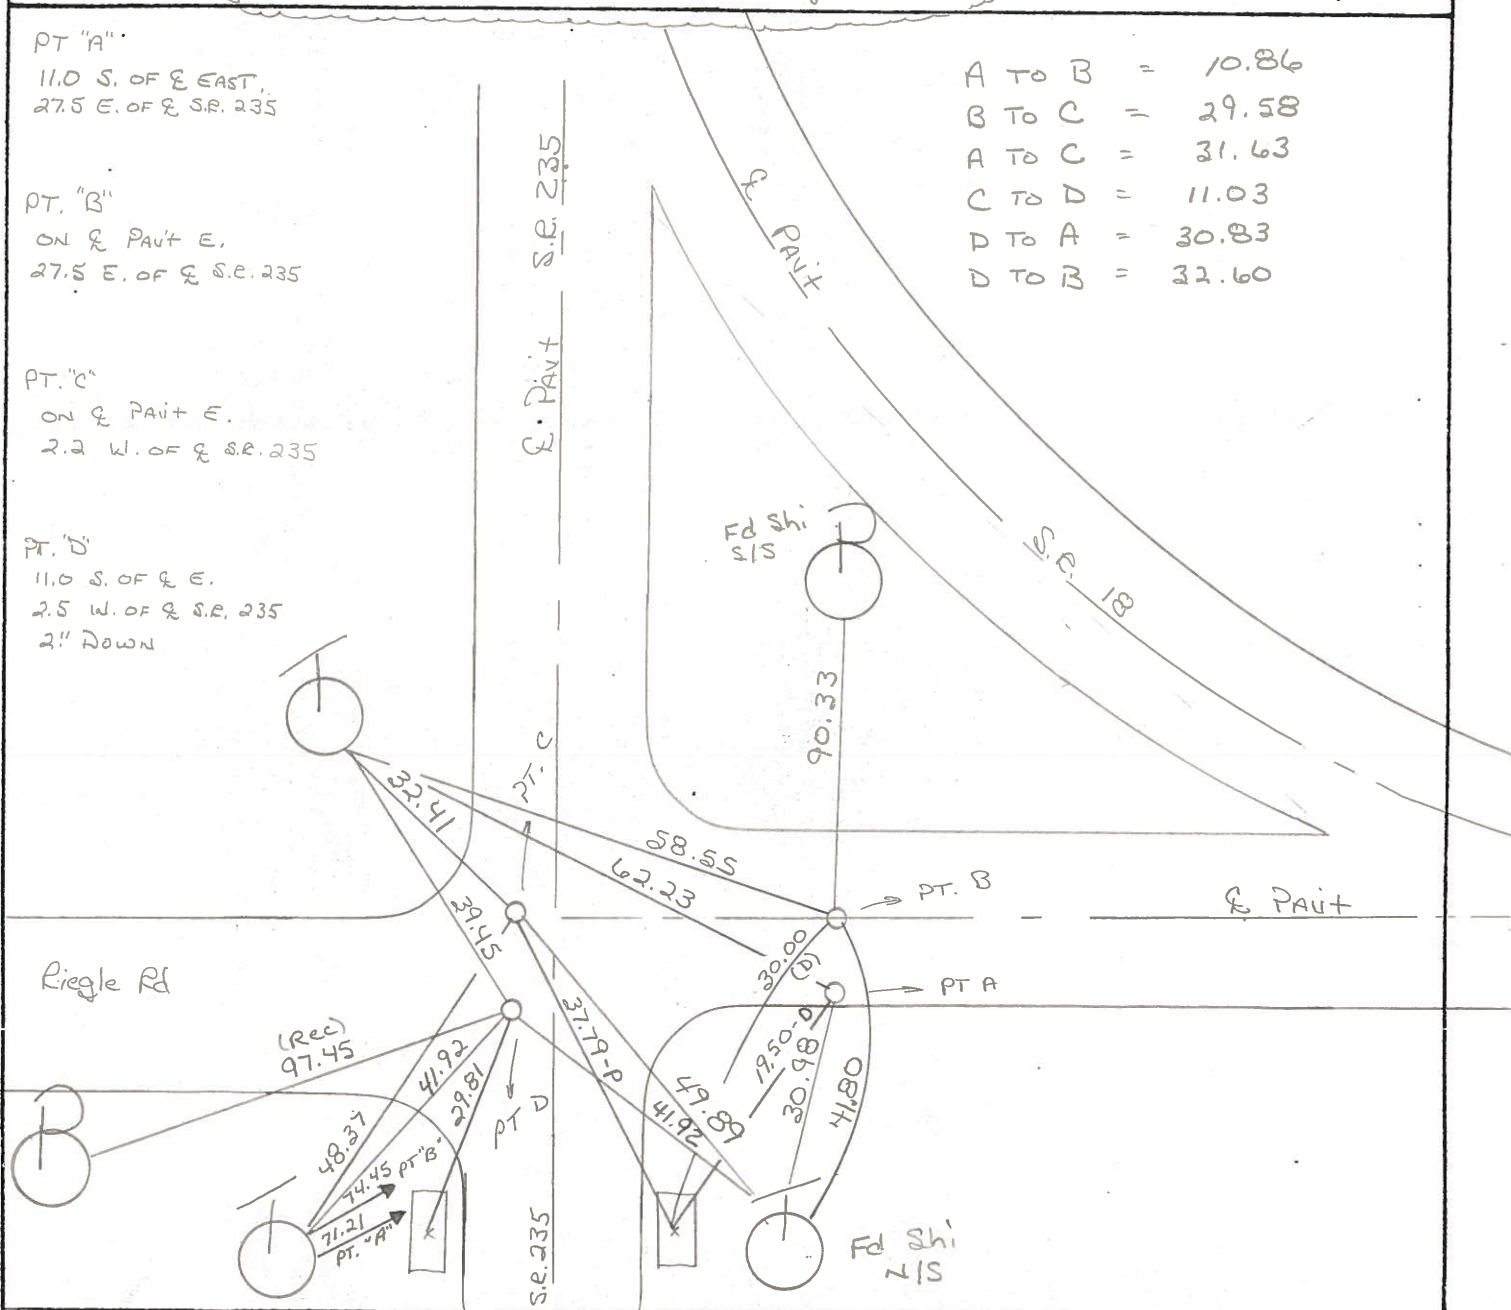

Q.D.O.T. DISTRICT 2 SURVEY OFFICE

SHEET 15 OF

County WOOD S.R. 18

Township JACKSON

Section 26

T N, R E

Personnel BARNHISEL H.C


HOUSEHOLDER R.C

LOEHRKE ☒

Date 11-28-83

Weather RAIN, CLOUDY

Temp. +40°

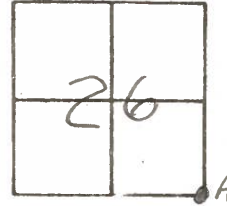

"A" RR SPIKE @ SURFACE OVER STONE
SLM 53+75 (SR 235)
10.9 S of & PAVT 18
27.1 E of & PAVT 235

"C" RR SPIKE @ SURFACE
SLM 53+86 (SR 235)
ON & PAVT SR 18 E
2.5' W of & PAVT 235

#15

"B" BOAT SPIKE @ SURFACE
SLM 53+86 (SR 235)
ON CL PAVT 18
27.1 E of & PAVT 235

SET PK+WASHEN
@ ALL PTS
7-25-85
C.L.

