

O.D.O.T. DISTRICT 2 SURVEY OFFICE (USE ONLY)

PERSONNEL

REFERENCE NO. 16

SHEET 5 OF 52

NOTES ASTON

DATE 5/22/24

ROUTE SR 18

H.C. NIESE

WEATHER WINDY

COUNTY WOOD

R.C. PRESTON-COLVIN

TEMP. 78°F

TOWNSHIP JACKSON

DWG BY BARRIERE

PID PAVING TRAIN

SECTION 25

T 3 N R 9 E

TYPE MONUMENT PK NAIL, 3/4" IRON PIPE

ON SURFACE - BELOW 1' BELOW

OFFSET $\varnothing$ PAVEMENT _____ LT : RT

_____ TO _____ EDGE PAVEMENT

STATION: 369+80.32

HORIZ.DATUM: NAD83 (2011)


GEOID: 18

GRID: NORTHING: 554927.219


EASTING: 1617640.526

LDP: NORTHING: _____

EASTING: _____

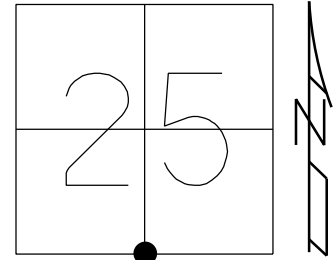

RECORD:
 FD STONE
 1' DOWN
 3/4" IPIPE ATOP
 3/19/91. CL
 FD P.K. NAIL IN PIPE
 BENT OVER STONE
 1.0' DOWN
 6/3/11, SAH
 FD P.K. NAIL IN 3/4" IPIPE
 BENT SE
 REF16
 6/15/20, JFO
 4/30/21, JFO
 FD IPIN
 8-10-23, TDN
 FD P.K. NAIL IN 3/4" IPIPE
 5/22/24, TDN

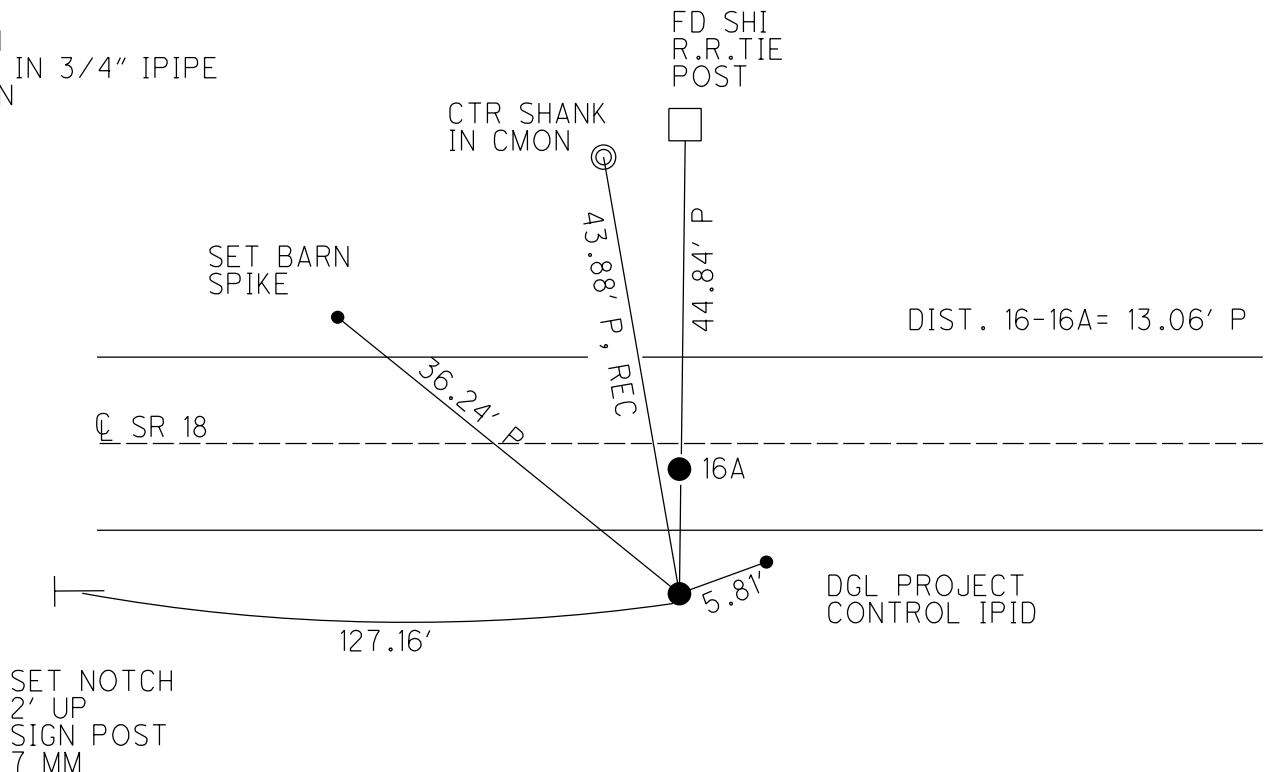

O.D.O.T. DISTRICT 2 SURVEY OFFICE (USE ONLY)

PERSONNEL

REFERENCE NO. 16

SHEET 5 OF 52

NOTES AUBLE

DATE 5-23-23

ROUTE SR 18

H.C. NIESE

WEATHER CALM

COUNTY WOOD

R.C. AUBLE

TEMP. 79°

TOWNSHIP JACKSON

DWG BY NIESE

PID PAVETRAIN

SECTION 25

T 3 N R 9 E

TYPE MONUMENT P.K./NAIL IN PIPE BENT OVER STONE

~~ON SURFACE~~ - BELOW ON

OFFSET CL PAVEMENT 14.2' ~~LT~~ : RT

4.9' RT TO RT EDGE PAVEMENT


STATION: 369+80.32

HORZ.DATUM: NAD83(2011)


GEOID: NAVD88 2012A

GRID: NORTHING: 554927.219

EASTING: 1617640.526

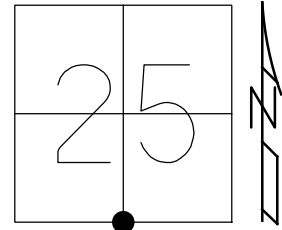

RECORD:
FD STONE
1' DOWN
3/4" IPIPE ATOP
3/19/91. CL
FD P.K. NAIL IN PIPE
BENT OVER STONE
1.0' DOWN
6/3/11, SAH
FD P.K. NAIL IN 3/4" IPIPE
BENT SE
REF16
6/15/20, JFO
4/30/21, JFO
FD IPIN
8-10-23, TDN

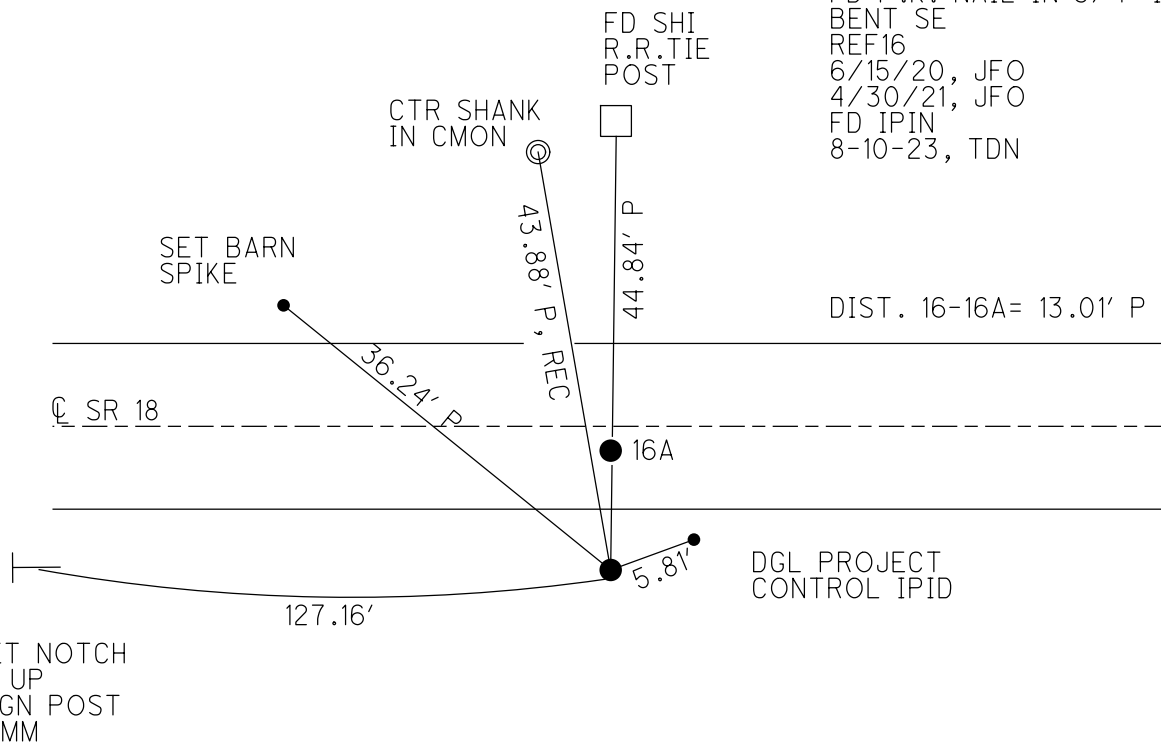

PERSONNEL

REFERENCE NO. 16

SHEET 5 OF 52

NOTES RHOADES

DATE 4/30/21

ROUTE SR 18

H.C. O'DONNELL

WEATHER PTLY. CLOUDY

COUNTY _____ WOOD

R.C. RHOADES

TEMP. 48°

TOWNSHIP JACKSON

SECTION 25

DWG BY NIESE

PID PAVETRAN

T 3 N R 9 E

TYPE MONUMENT P.K./NAIL IN PIPE BENT OVER STONE

~~ON SURFACE - BELOW~~ 1.0'

OFFSET @ PAVEMENT 14.2' ~~LT~~ : RT

4.9' RT TO RT EDGE PAVEMENT


STATION: 369+80.32

HORIZ.DATUM: NAD83(2011)

GEOID: NAVD88 2012A

GRID: NORTHING: 554927.219

EASTING: 1617640.526

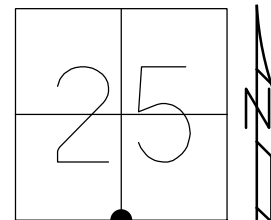

RECORD:

FD STONE

1' DOWN

3/4" IPIPE ATOP

3/19/91. CL

FD P.K. NAIL IN PIPE

BENT OVER STONE

1.0' DOWN

6/3/11, SAH

FD P.K. NAIL IN 3/4" IPIPE

BENT SE

REF 16

6/15/20, JFO

4/30/21, JFO

FD SHI
R.R.TIE
POST

CTR SHANK
IN CMON

43.88' P, REC

44.78' P

© SR 18

DIST. 16-16A= 13.19' P

18.30' P

SET NOTCH
2.2' UP
SIGN POST
7 MM

O.D.O.T. DISTRICT 2 SURVEY OFFICE (USE ONLY)

PERSONNEL _____ REFERENCE NO. 16 SHEET 5 OF 51

NOTES CANTERBURY DATE 6/3/11 ROUTE SR 18

H.C. HUSS WEATHER PTLY.CLOUDY COUNTY WOOD

R.C. HARBAUGH TEMP. 60° TOWNSHIP JACKSON

SECTION 25

DWG BY O'DONNELL PID PAVETRAIN T 3 N R 9 E

TYPE MONUMENT P.K./NAIL IN PIPE BENT OVER STONE

~~ON SURFACE~~ - BELOW 1.0'

~~LEFT - C~~ PAV'T - RIGHT 14.2'

4.9' RT TO RT EDGE PAVEMENT


STATION: 369+80.32

HORIZ.DATUM: NAD83 (2011)

GEOID: NAVD88-2012A


GRID: NORTHING: 554927.219

EASTING: 1617640.526

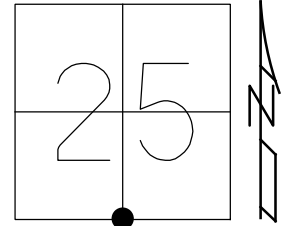

RECORD: 3/19/91
FD STONE 1' BELOW SURFACE,
WITH 3/4" IPIPE. IPIPE BENT OVER
TOP OF STONE. ADJUSTED IPIPE SO
THE END OF PIPE IS OVER THE HIGH
POINT OF STONE. CL

RECORD:
FD PK NAIL IN
3/4" IPIPE
REF16
6/15/20, JFO

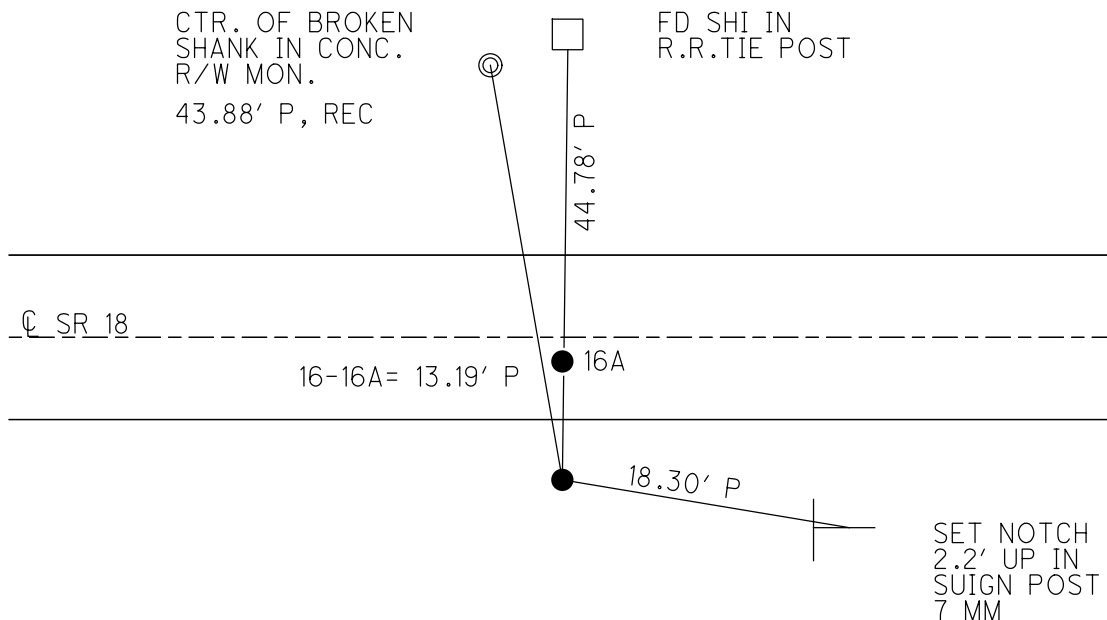

O.D.O.T. DISTRICT 2 SURVEY OFFICE (USE ONLY)

PERSONNEL _____ REFERENCE NO. 16 SHEET 5 OF 26
 NOTES CANTERBURY DATE 6/3/11 ROUTE SR 18
 H.C. HUSS WEATHER PTLY.CLOUDY COUNTY WOOD
 R.C. HARBAUGH TEMP. 60° TOWNSHIP JACKSON
 _____ SECTION 25
 _____ T 3 N R 9 E

TYPE MONUMENT P.K./NAIL IN PIPE BENT OVER STONE


~~ON SURFACE~~ - BELOW 1.0'

~~LEFT~~ - CL PAV'T - RIGHT 14.2'


4.9' RT TO RT EDGE PAVEMENT

S.L.M. 369+80.32

Grid: Northing: - Easting: -

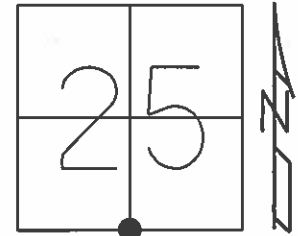

RECORD: 3/19/91
 FD STONE 1' BELOW SURFACE,
 WITH $\frac{3}{4}$ " IPIPE. IPIPE BENT OVER
 TOP OF STONE. ADJUSTED IPIPE SO
 THE END OF PIPE IS OVER THE HIGH
 POINT OF STONE. CL

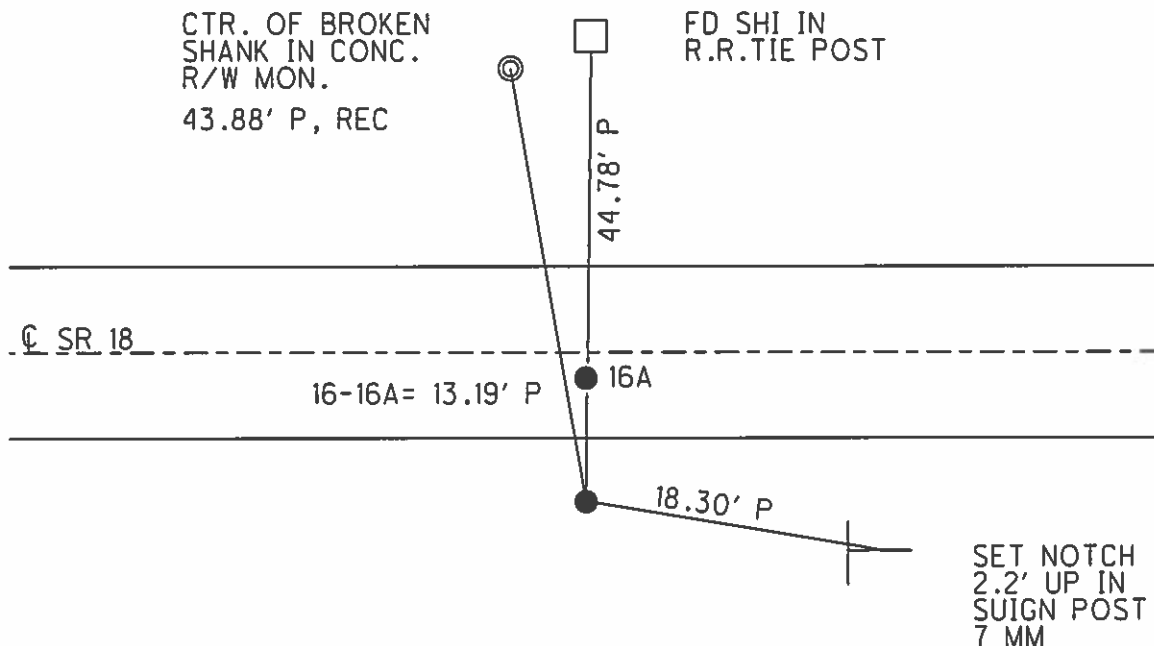

O.D.O.T. DISTRICT 2 SURVEY OFFICE

PERSONNEL

REFERENCE NO. 16

SHEET OF

NOTES BARNHISEL

H.C. Loehake

R.C. HOFFMAN

DATE 3-19-91

WEATHER cloudy, Windy

TEMP. +45°

ROUTE 18

COUNTY WOOD

TOWNSHIP JACKSON

SECTION 25

T 3 N R 9 E

TYPE MONUMENT 3/4" Iron Pin PT "B"

ON SURFACE - BELOW 1'


LEFT - & PAVT. - RIGHT 14.2

5.5 RT OF RT EDGE PAVEMENT

S.L.M. 370+94

PT "A" = 16

PT "B" = 16A

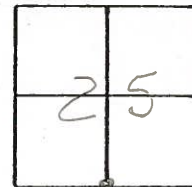

P.K. & Washer

370+94


1.4 RT OF &

8.1 TO RT Edge PAVT

Set P.K./Washer

4-17-91

PT "B" mB
ON old survey line
OF 1927

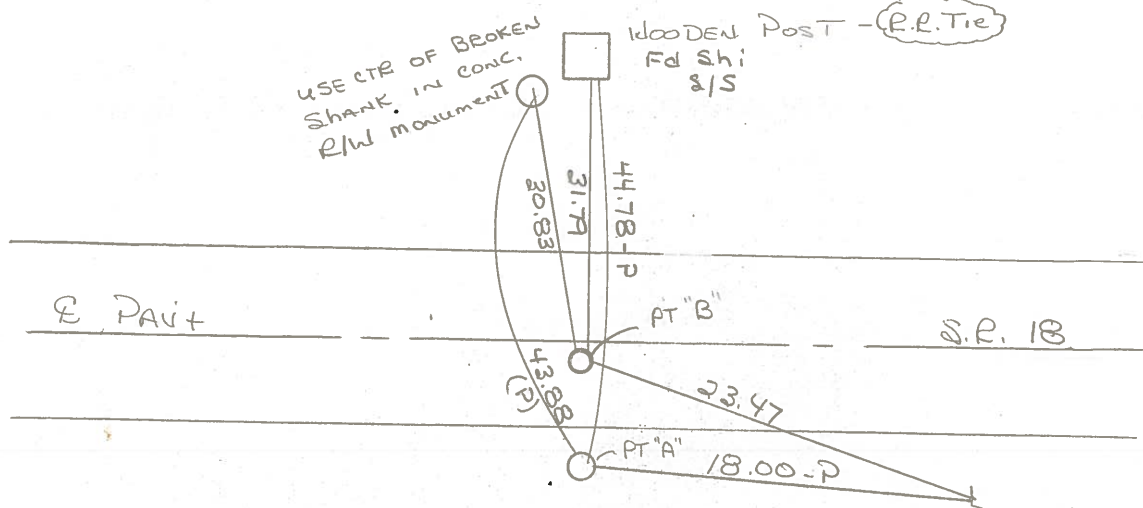

mile marker
Sign #7
(POST)

RECORD = FOUND STONE 1' Below Surface, with 3/4" Iron Pipe.

Iron Pipe Bent over Top of Stone, Adjusted Pipe so the end of the Pipe is over the High Point of Stone

RECORD = PT "B" Fd small CONC. NAIL 1.2 RT OF & PAVT / SET 11-21-83 by

HOFFMAN & CREW ON RECONSTRUCTED SURVEY LINE OF 1927

O.D.O.T. DISTRICT 2 SURVEY OFFICE

PERSONNEL

REFERENCE NO. #16

SHEET 1 OF

NOTES HOFFMAN

H.C. LOEHRKE

R.C. BAKTHUIS

Spr Kmax

DATE 6-16-87

WEATHER Clear

TEMP. 80°

ROUTE SR 18

COUNTY Wood

TOWNSHIP Jackson

SECTION 25

T.3 N. R. 9 E

TYPE MONUMENT I. PIPE OVER STONE


ON SURFACE - BELOW 1'

LEFT- & PAW'T. - RIGHT 14.2'

5.5 TO 2nd EDGE PAVEMENT

S.L.M. 370+74

Set P.K. WASHER
Point "B"
7.27.87
SUN

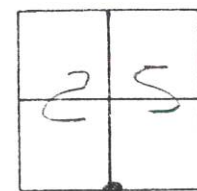

Found stone 1' below surface, with 3/4" I.D. I. PIPE Bent over top of stone. Adjusted pipe so the end of the pipe is over the high point of stone. Put Field tile pieces over stone.

PK & Washer
370+94
1.4 RT &
8.1 RT ED

22.90
T-Hub

USE CTR of BRIDGE
SHANK IN CONC
R/W Monument

30.84-P

Fd sh. & S Post
RR TIE

31.75 79

44.78-P

43.88-P

13.03-P

18.00-P

23.47-D

Fd "t" NW/Face
Steel Post

m.m. #7

"B" Fd SMALL CONC Nail ~~1.2'~~ RT of & post set 11.21.83 by HOFFMAN on
Re constructed survey line of 1927

O.D.O.T. DISTRICT 2 SURVEY OFFICE

PERSONNEL

REFERENCE NO. #16

SHEET 1 OF

NOTES HOFFMAN

H.C. LOEHRKE

R.C. BARNHISEL

SOCKMAN

DATE 6-16-87

WEATHER Clear

TEMP. 85°

ROUTE SR 18

COUNTY Wood

TOWNSHIP Jackson

SECTION 25

T3 N R 9 E

TYPE MONUMENT I. PIPE OVER STONE

ON SURFACE - BELOW 1'

LEFT- & PAW'T. - RIGHT 14.2'


5.5 TO 2nd EDGE PAVEMENT

S.L.M. 370+74


Set P.K. / WASHER
Point "B"
7.27.87
SOCK

PT "A" = 16

PT "B" = 16A

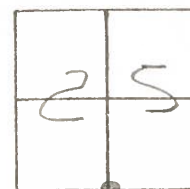

Found stone 1' below surface, with $\frac{3}{4}$ " I.D. I. PIPE Bent over top of stone. Adjusted pipe so the end of the pipe is over the high point of stone. Put field tile pieces over stone.

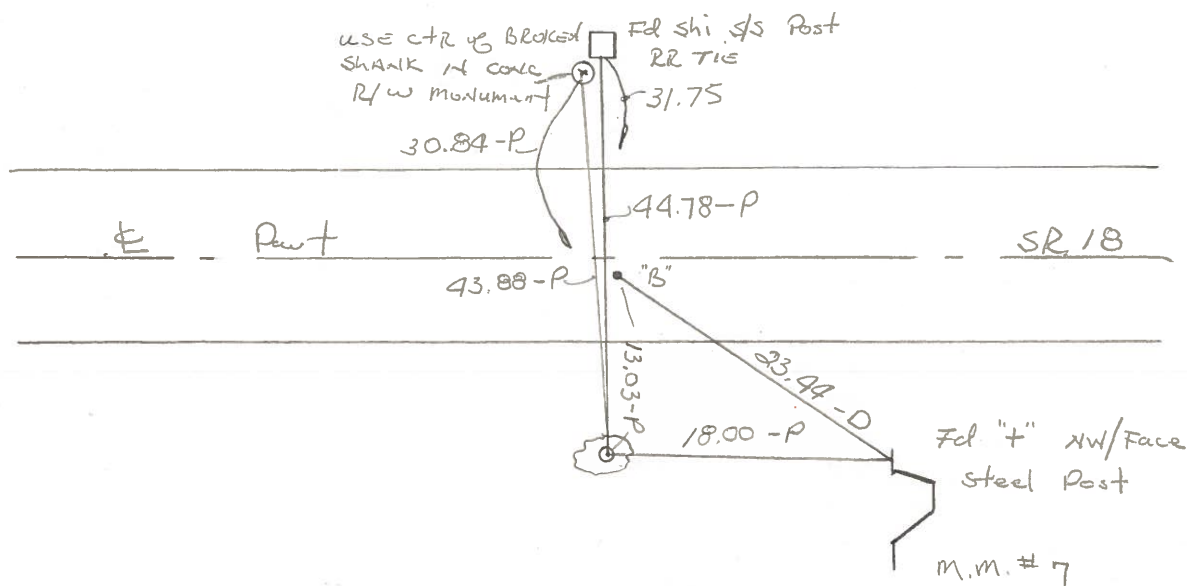

"B" Fd SMALL CONC Nail 1.2' Rt of & post set 11-21-83 by HOFFMAN ON
Re constructed survey line of 1927

PERSONNEL	TITLE	PERSONNEL	TITLE
HOFFMAN			
LOHRKE	T		
HOUSCHDER			
BARNHISEL			

COUNTY Woon

DATE Nov 21, 83


S. R. 18

WEATHER clear - windy

SEC. 07.19 / RADER Creek TEMP. +40°

DESCRIPTION Relationship btw survey line of 1982 & 1927

JOB NO.

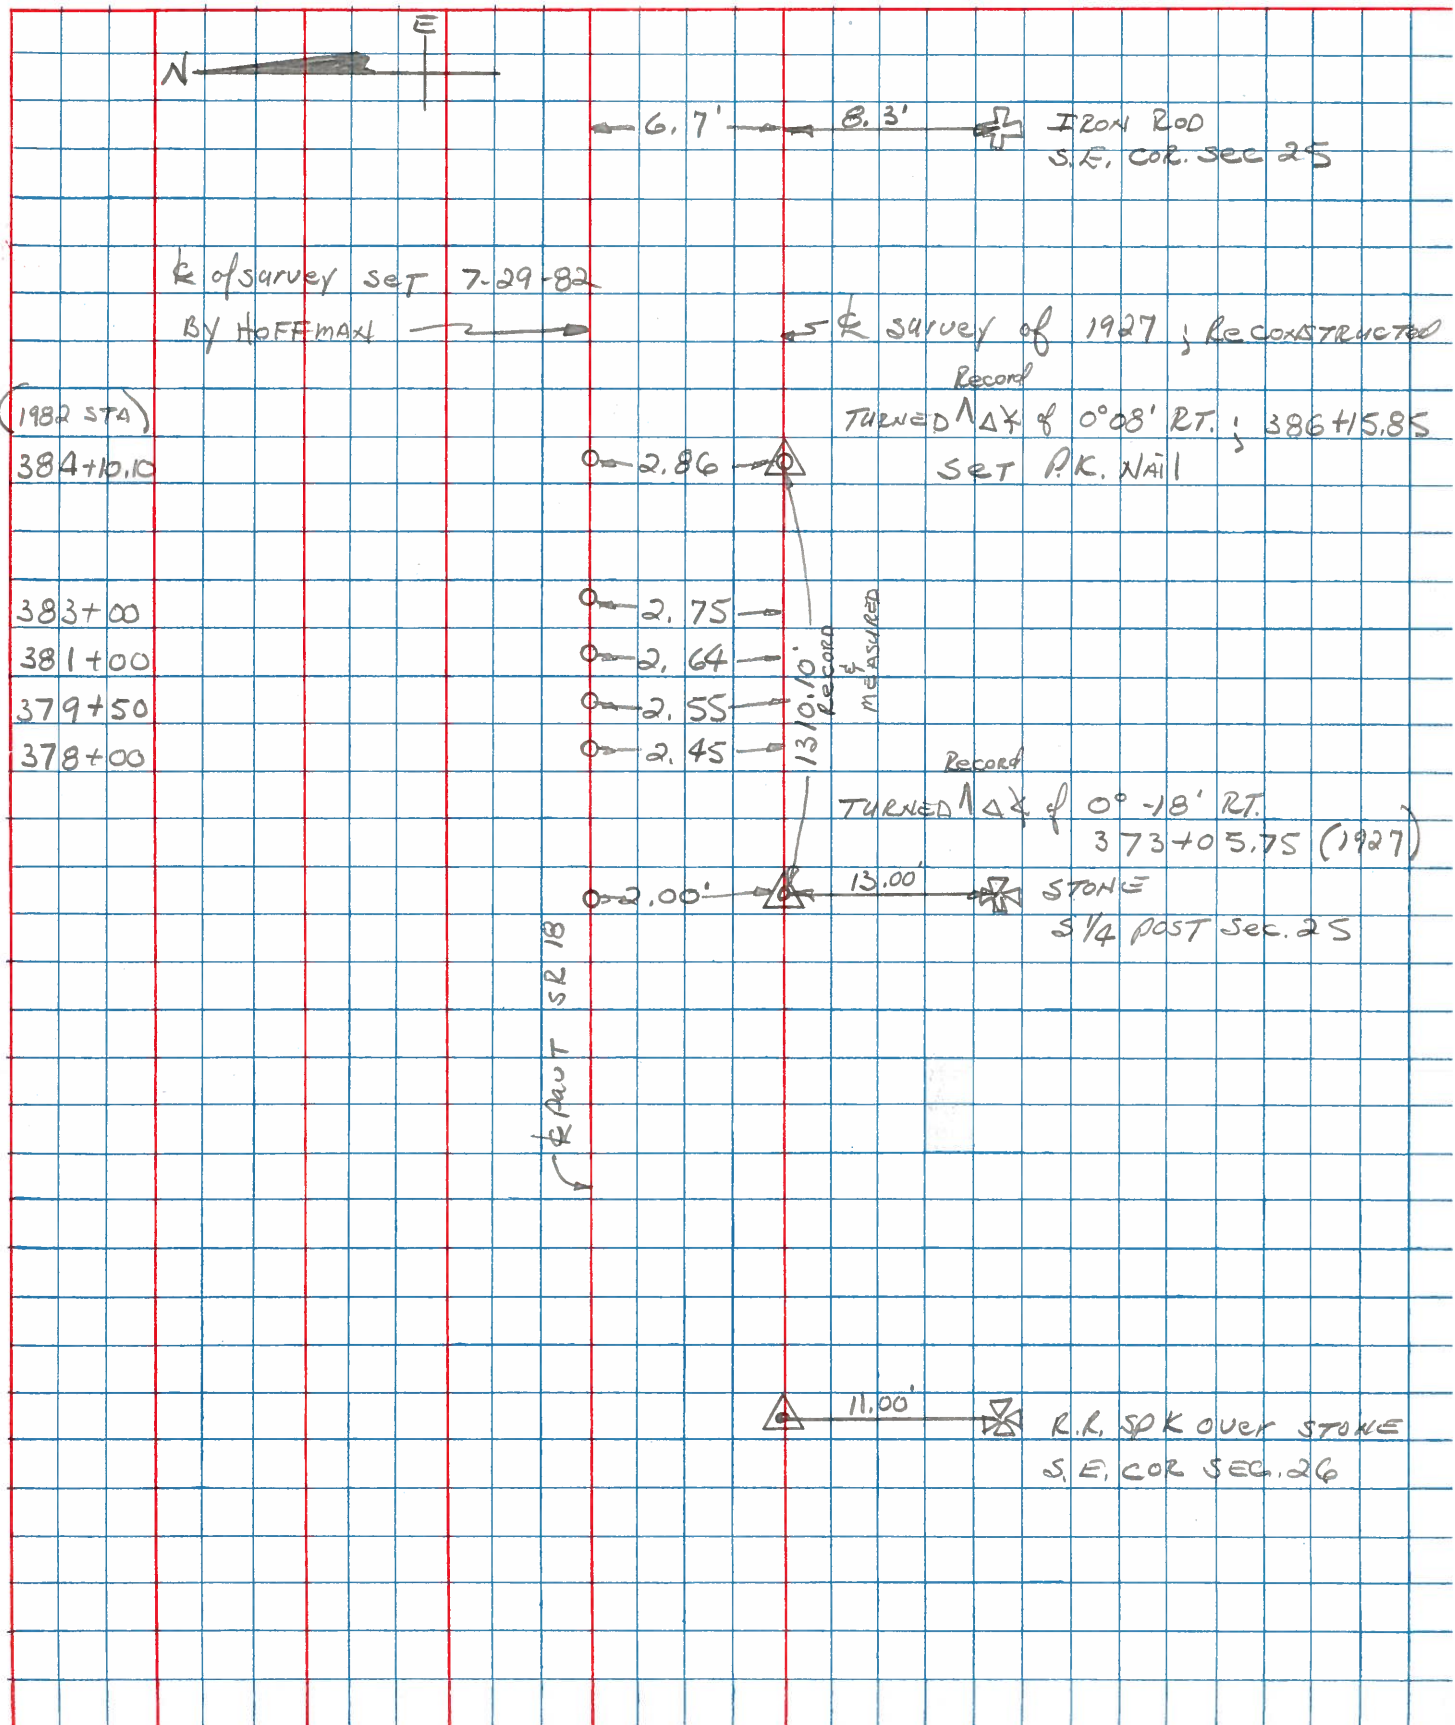


County Wood S.R. 18Township JacksonSection 25

T3N, R9E

Personnel HoffmanHouseholderLoehrke


#16

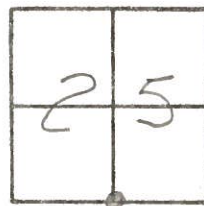Date 7-13-82Weather clearTemp. +75°

Fd. stone; 1' below surface; with $\frac{3}{4}$ " I.D. IRON PIPE BENT OVER
TOP OF STONE. ADJUSTED PIPE SO THE END OF THE PIPE IS OVER
THE HIGH POINT OF STONE. PUT FIELD TILE PIECES OVER STONE,

5.5' TO S. EP.

14.2' S. of & PAUT S.R. 18

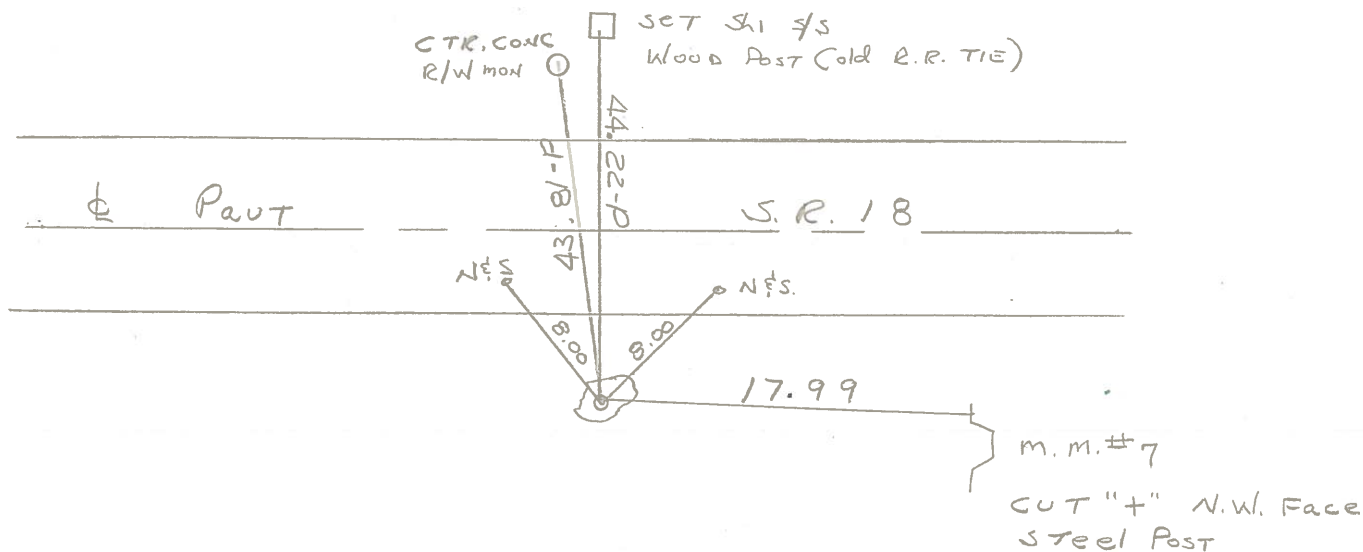

Q.D.O.T. DISTRICT 2 SURVEY OFFICE

SHEET 16 OF

County WOOD S.R. 18

Date 6-18-71

Township JACKSON


Weather CLEAR

Section 25

Temp. 88°

T3N, R9E

Personnel BURNSIDE

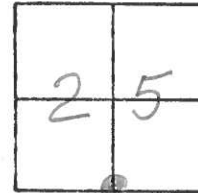

SMITH

BOWERS

HOLCOMBE

ROGGINI

#16

