

O.D.O.T. DISTRICT 2 SURVEY OFFICE (USE ONLY)

PERSONNEL

REFERENCE NO. 16 A

SHEET 5 OF 52

NOTES ASTON
H.C. NIESE
R.C. PRESTON-COLVIN

DATE 5/22/24
WEATHER WINDY
TEMP. 78°F

ROUTE SR 18
COUNTY WOOD
TOWNSHIP JACKSON
SECTION 25

DWG BY BARRIERE PID PAVING TRAIN

T 3 N R 9 E

TYPE MONUMENT MAGNAIL/WASHER

ON SURFACE - BELOW ON

OFFSET Q PAVEMENT LT : RT

 TO EDGE PAVEMENT

STATION: 369+80.32

HORIZ.DATUM: NAD83 (2011)


GEOID: 18

GRID: NORTHING: 554940.188


EASTING: 1617641.073

LDP: NORTHING:

EASTING:

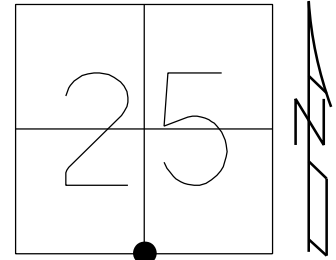

RECORD:
SET SM.CONC.NAIL
11/21/83, HOFFMAN
FD SM.CONC.NAIL
3/19/91
SET P.K./WASHER
4/17/91, MB
FD P.K./WASHER
6/3/11, SAH
SET MAG/WASHER
9/1/11, SAH
FD MAG/WASHER
REFA16
6/15/20, JFO
4/30/21, JFO
1/21/22, TDN
8-10-23, TDN
9/22/24, TDN

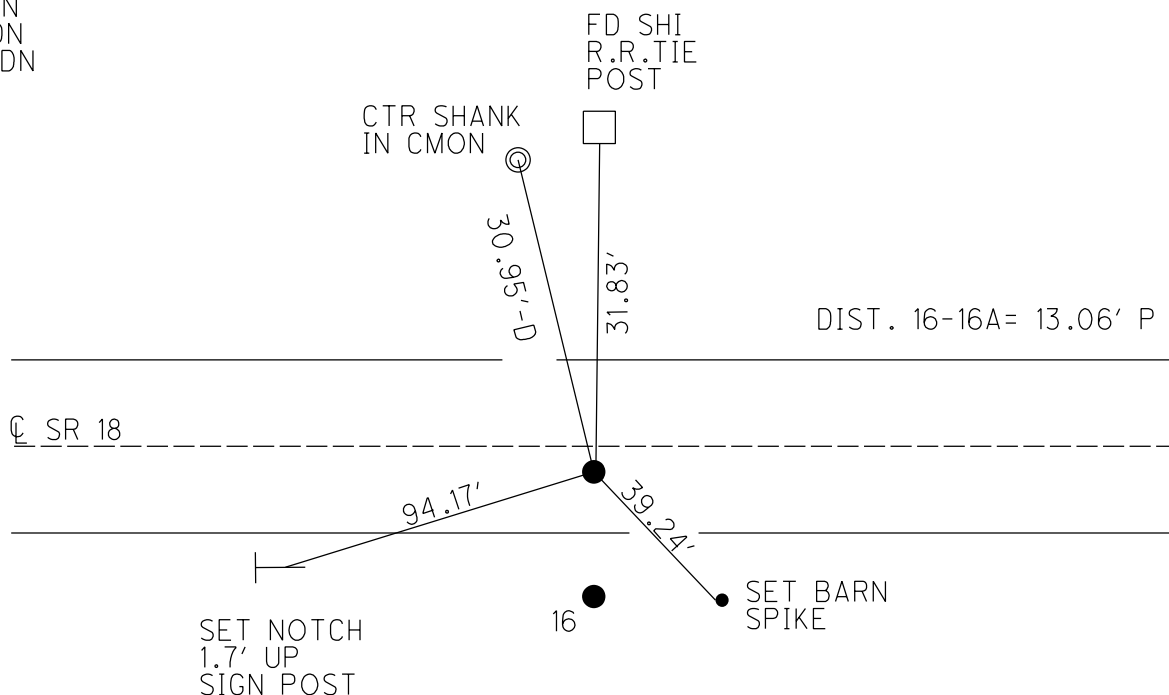

O.D.O.T. DISTRICT 2 SURVEY OFFICE (USE ONLY)

PERSONNEL

REFERENCE NO. 16 A

SHEET 6 OF 52

NOTES AUBLE

DATE 5-23-23

ROUTE SR 18

H.C. NIESE

WEATHER CALM

COUNTY WOOD

R.C. AUBLE

TEMP. 79°

TOWNSHIP JACKSON

SECTION 25

DWG BY NIESE PID PAVETRAIN

T 3 N R 9 E

TYPE MONUMENT MAG/WASHER

ON SURFACE - ~~BELOW~~ ON

OFFSET CL PAVEMENT 1.2' ~~LT~~ : RT

8.2' TO RT EDGE PAVEMENT


STATION: 369+80.32

HORZ.DATUM: NAD83(2011)


GEOID: NAVD88 2012A

GRID: NORTHING: 554940.188

EASTING: 1617641.073

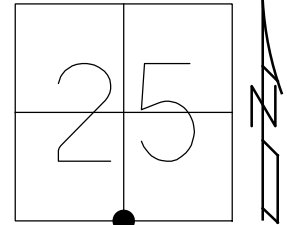


RECORD:
SET SM.CONC.NAIL
11/21/83, HOFFMAN
FD SM.CONC.NAIL
3/19/91
SET P.K./WASHER
4/17/91, MB
FD P.K./WASHER
6/3/11, SAH
SET MAG/WASHER
9/1/11, SAH
FD MAG/WASHER
REFA16
6/15/20, JFO
4/30/21, JFO
1/21/22, TDN
8-10-23, TDN

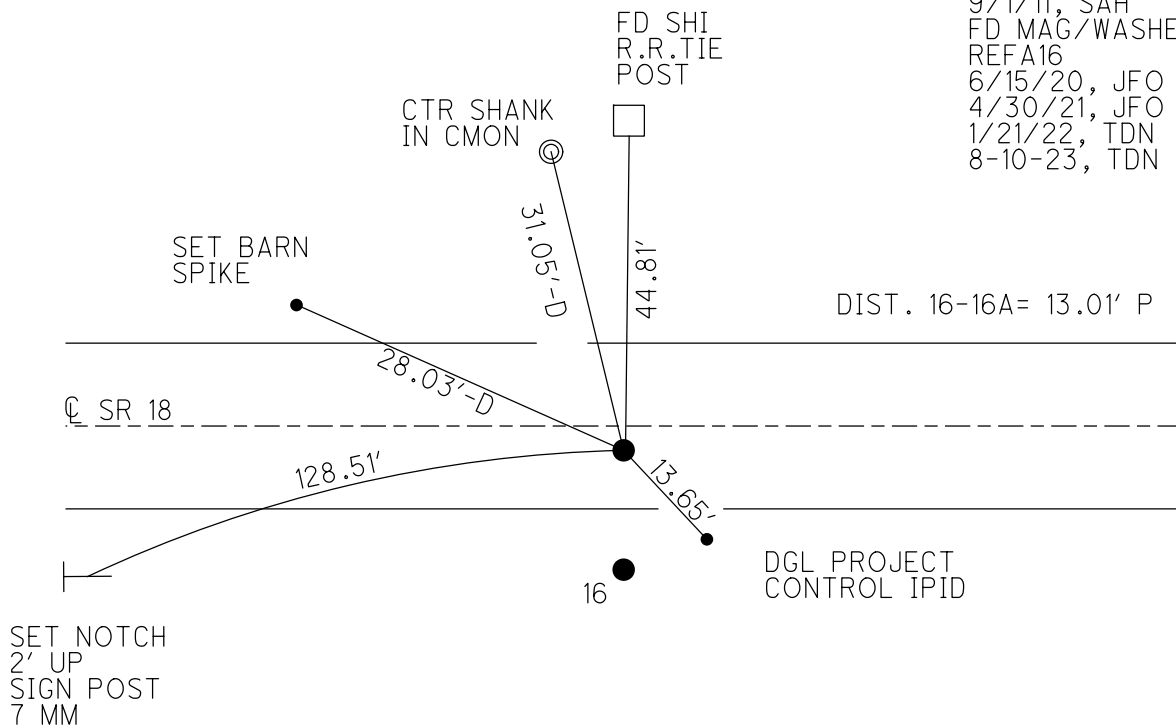


O.D.O.T. DISTRICT 2 SURVEY OFFICE (USE ONLY)

PERSONNEL	REFERENCE NO. <u>16 A</u>	SHEET <u>6</u> OF <u>52</u>
NOTES <u>RHOADES</u>	DATE <u>4/30/21</u>	ROUTE <u>SR 18</u>
H.C. <u>O'DONNELL</u>	WEATHER <u>PTLY. CLOUDY</u>	COUNTY <u>WOOD</u>
R.C. <u>RHOADES</u>	TEMP. <u>48°</u>	TOWNSHIP <u>JACKSON</u>
		SECTION <u>25</u>
DWG BY <u>NIESE</u>	PID <u>PAVETRAN</u>	T <u>3</u> N R <u>9</u> E
TYPE MONUMENT <u>MAG/WASHER</u>		
ON SURFACE - BELOW <u>ON</u>		
OFFSET <u>CL</u> PAVEMENT <u>1.2'</u> LT : RT		
<u>8.2'</u> TO RT EDGE PAVEMENT		
STATION: <u>369+80.32</u>		
HORIZ.DATUM: <u>NAD83(2011)</u>	GEOID: <u>NAVD88 2012A</u>	
GRID: NORTHING: <u>554940.188</u>	EASTING: <u>1617641.073</u>	

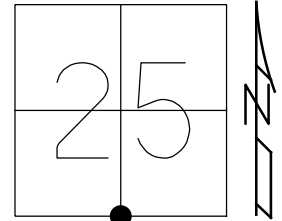

RECORD:
 SET SM.CONC.NAIL
 11/21/83, HOFFMAN
 FD SM.CONC.NAIL
 3/19/91
 SET P.K./WASHER
 4/17/91, MB
 FD P.K./WASHER
 6/3/11, SAH
 SET MAG/WASHER
 9/1/11, SAH
 FD MAG/WASHER
 REFA16
 6/15/20, JFO
 4/30/21, JFO
 1/21/22, TDN

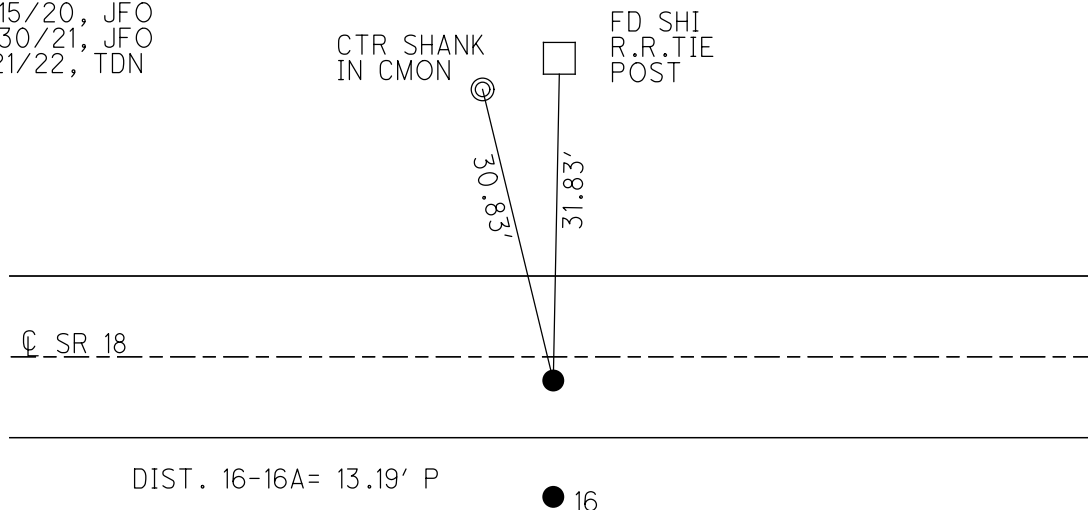

O.D.O.T. DISTRICT 2 SURVEY OFFICE (USE ONLY)

PERSONNEL _____ REFERENCE NO. 16 A SHEET 6 OF 51
NOTES CANTERBURY DATE 6/3/11 ROUTE SR 18
H.C. HUSS WEATHER PTLY.CLOUDY COUNTY WOOD
R.C. HARBAUGH TEMP. 60° TOWNSHIP JACKSON
SECTION 25
DWG BY O'DONNELL PID PAVETRAIN T 3 N R 9 E

TYPE MONUMENT P.K./WASHER

ON SURFACE - ~~BELOW~~ ON

~~LEFT~~ - CL PAV'T - RIGHT 1.2'

8.2' TO RT EDGE PAVEMENT



STATION: 369+80.32

HORZ.DATUM: NAD83 (2011)

GEOID: NAVD88-2012A

GRID: NORTHING: 554940.188

EASTING: 1617641.073

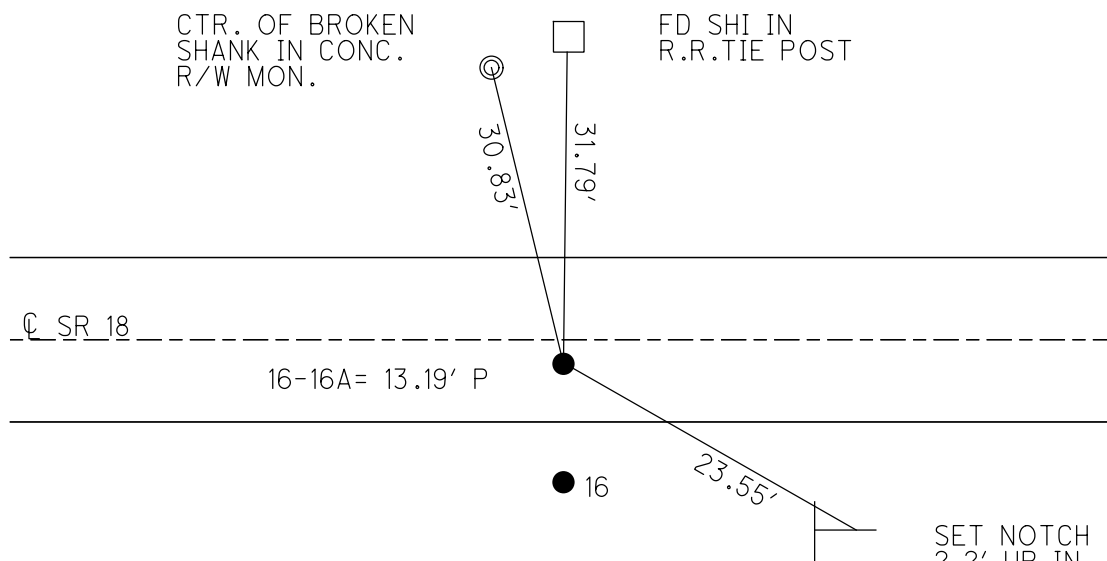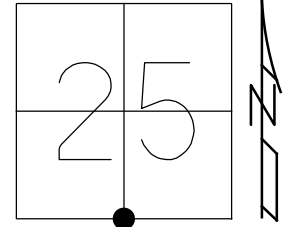

RECORD: 3/19/91
FD SMALL CONC. NAIL 1.2' RT OF CL
PAV'T. SET 11/21/83 BY HOFFMAN
AND CREW ON RECONSTRUCTED SURVEY
LINE OF 1927.



SET P.K./WASHER
ON OLD SURVEY LINE, 1927.
4/17/91, MB

FD P.K./WASHER
GPS, REFB16
SET MAG/WASHER
9/1/11, SAH
FD MAG/WASHER
REFA16
6/15/20, JFO

O.D.O.T. DISTRICT 2 SURVEY OFFICE (USE ONLY)

PERSONNEL	REFERENCE NO.	<u>16 A</u>	SHEET	<u>6</u>	OF	<u>26</u>		
NOTES	<u>CANTERBURY</u>	DATE	<u>6/3/11</u>	ROUTE	<u>SR 18</u>			
H.C.	<u>HUSS</u>	WEATHER	<u>PTLY.CLOUDY</u>	COUNTY	<u>WOOD</u>			
R.C.	<u>HARBAUGH</u>	TEMP.	<u>60°</u>	TOWNSHIP	<u>JACKSON</u>			
				SECTION	<u>25</u>			
				T	<u>3</u>	R	<u>9</u>	E

TYPE MONUMENT P.K./WASHER
ON SURFACE - ~~BELOW~~ ON
~~LEFT~~ - CL PAV'T - RIGHT 1.2'
8.2' TO RT EDGE PAVEMENT
S.L.M. 369+80.32
Grid: Northing: 554940.273 Easting: 1617640.961

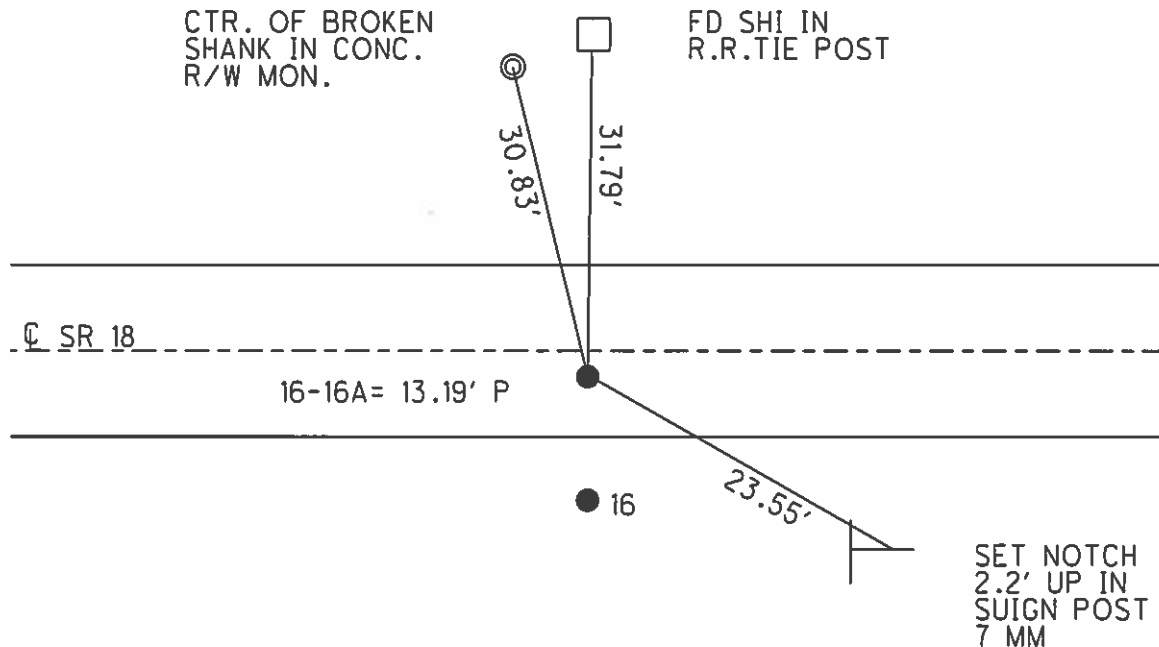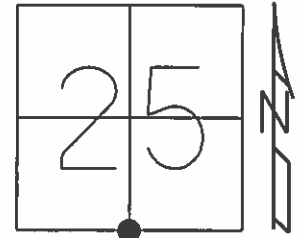

RECORD: 3/19/91
FD SMALL CONC. NAIL 1.2' RT OF CL
PAV'T. SET 11/21/83 BY HOFFMAN
AND CREW ON RECONSTRUCTED SURVEY
LINE OF 1927.

SET P.K./WASHER
ON OLD SURVEY LINE, 1927.
4/17/91, MB

FD P.K./WASHER
GPS, REFB16
SET MAG/WASHER
9/1/11, SAH

O.D.O.T. DISTRICT 2 SURVEY OFFICE

PERSONNEL

REFERENCE NO. 16

SHEET OF

NOTES BAERNHISEL

H.C. LOCHAKE

R.G. HOFFMAN

DATE 3-19-91

WEATHER CLOUDY, WINDY

TEMP. +45°

ROUTE 18

COUNTY WOOD

TOWNSHIP JACKSON

SECTION 25

T 3 N R 9 E

TYPE MONUMENT 3/4" IRON PIN PT "B"

ON SURFACE - BELOW 1'


LEFT - & PAV'T. - RIGHT 14.2

5.5 ^{RT OF} TO RT EDGE PAVEMENT

S.L.M. 370+94

PT "A" = 16

PT "B" = 16A

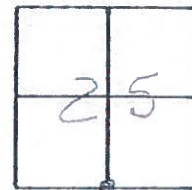

P.K. & Washee

370+94

1.4 RT OF &


8.1 TO RT Edge Pavt

Set P.K. / Washee

4-17-91

PT "B" mB

ON old survey line
OF 1927

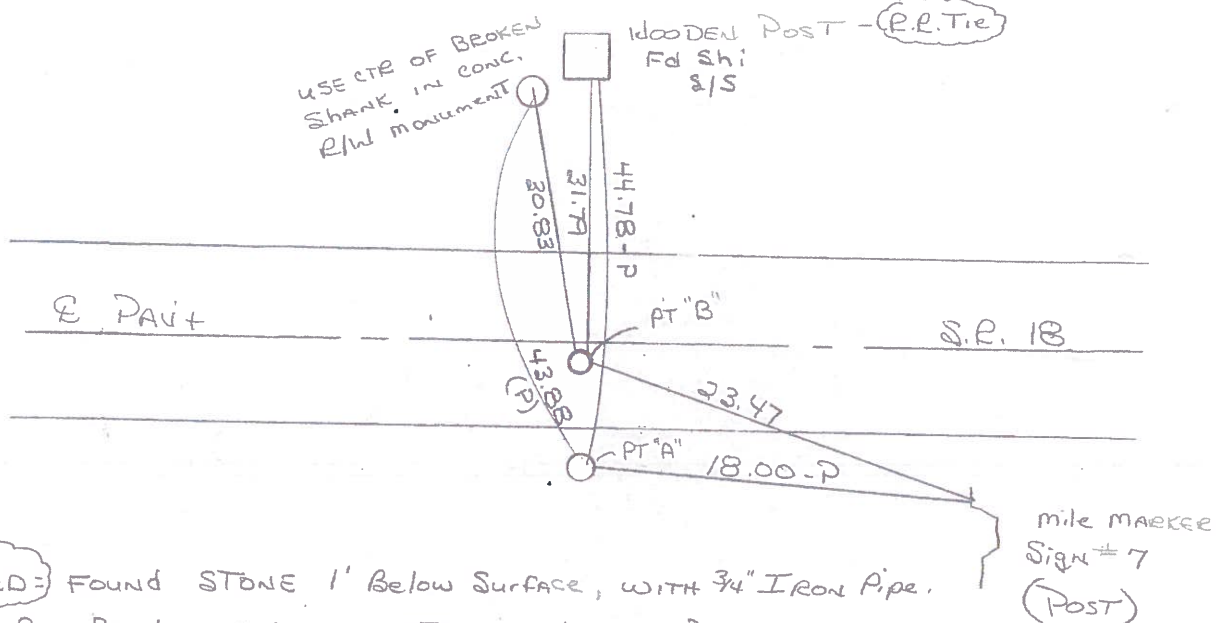

RECORD: FOUND STONE 1' Below Surface, with 3/4" IRON Pipe. IRON Pipe Bent OVER TOP OF STONE, ADJUSTED PIPE SO THE END OF THE PIPE IS OVER THE HIGH POINT OF STONE

RECORD: PT "B" Fd SMALL CONIC. NAIL 1.2 RT OF & Pavt / SET 11-21-83 by HOFFMAN & CREW ON RECONSTRUCTED SURVEY LINE OF 1927

O.D.O.T. DISTRICT 2 SURVEY OFFICE

PERSONNEL

REFERENCE NO. #16

SHEET 1 OF

NOTES HOFFMAN

H.C. LOEHKE

R.C. BARNHISEL

SOCKMAN

DATE 6-16-87

WEATHER Clear

TEMP. 85°

ROUTE SR 18

COUNTY Wood

TOWNSHIP Jackson

SECTION 25

T3 N R 9 E

TYPE MONUMENT I. PIPE OVER STONE

ON SURFACE - BELOW 1'

LEFT- & PAW'T. - RIGHT 14.2'


5.5 TO RT EDGE PAVEMENT

S.L.M. 370+74


Set P.K. WASHER
Point "B"
7.27.87
SOCK

PT "A" = 16

PT "B" = 16A

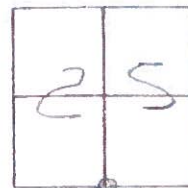

Found stone 1' below surface, with $\frac{3}{4}$ " I.D. I. PIPE Bent over top of stone. ADJUSTED pipe so the end of the pipe is over the high point of stone. Put field tile pieces over stone.

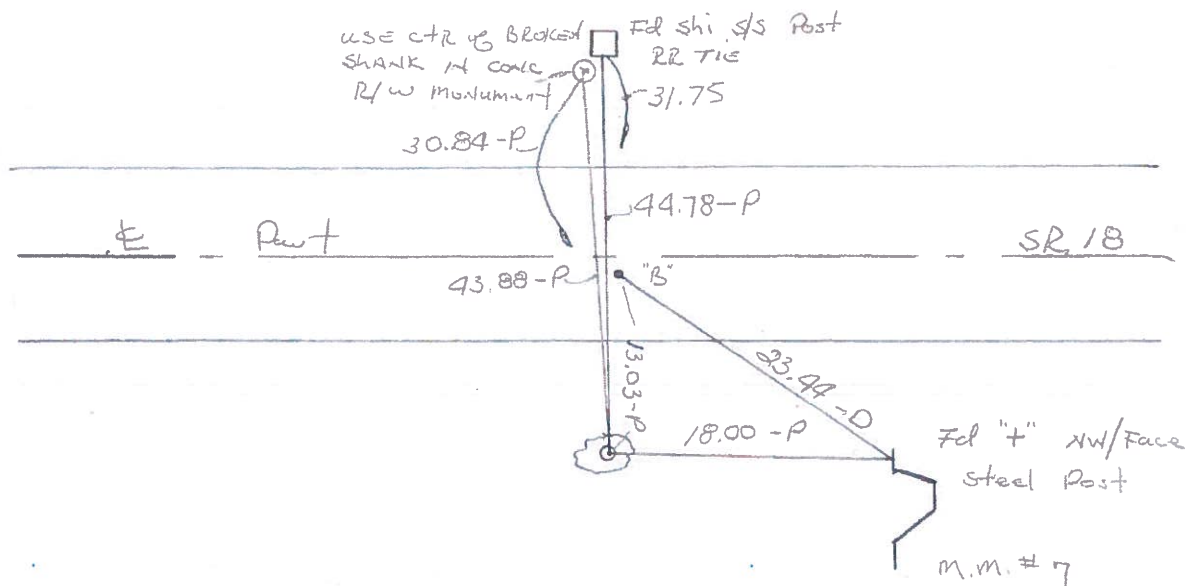

"B" Fd SMALL CONC Nail 1.2' Rt of & Pawt Set 11-21-83 By HOFFMAN ON Re constructed survey line of 1927

Q.D.O.T. DISTRICT 2 SURVEY OFFICE

SHEET _____ OF _____

County WOOD S.R. 18

Date 11-21-83

Township JACKSON

Weather clear

Section 25

Temp. +40°


T3N, R9E

Personnel HOFFMAN

LOEHKE

HOYSEHOLDEN

BARNHISEL

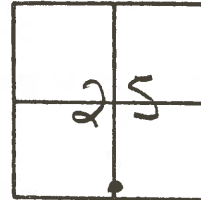

Set small CONC. nail ; 1.2' RT. of PAUT ON & survey of 1927
16A

