

O.D.O.T. DISTRICT 2 SURVEY OFFICE (USE ONLY)

PERSONNEL

REFERENCE NO. 16 B

SHEET 5 OF 52

NOTES ASTON

DATE 5/22/24

ROUTE SR 18

H.C. NIESE

WEATHER WINDY

COUNTY WOOD

R.C. PRESTON-COLVIN

TEMP. 78°F

TOWNSHIP JACKSON

DWG BY BARRIERE

PID 101290

SECTION 25

T 3 N R 9 E

TYPE MONUMENT MAGNAIL/WASHER

ON SURFACE - BELOW ON

OFFSET CL PAVEMENT LT : RT

 TO EDGE PAVEMENT

STATION: 382+91

HORIZ.DATUM: WOOD LDP


GEOID: 18

GRID: NORTHING: 554940.188

EASTING: 1617641.073

LDP: NORTHING: 376332.059

EASTING: 131018.368

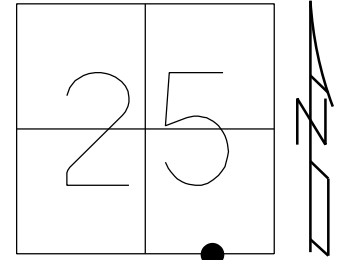

RECORD:

SET P.K.NAIL

11/21/83

FD P.K.NAIL

6/16/87

SET P.K.NAIL

7/7/87, CL

FD P.K./WASHER

6/3/11, SAH

SET MAG/WASHER

9/1/11, MC

FD MAG/WASHER

REFB16

6/15/20, JFO

4/30/21, JFO


1/21/22, TDN

8-10-23, TDN

REF16B

5/22/24, TDN

10/5/24, TDN

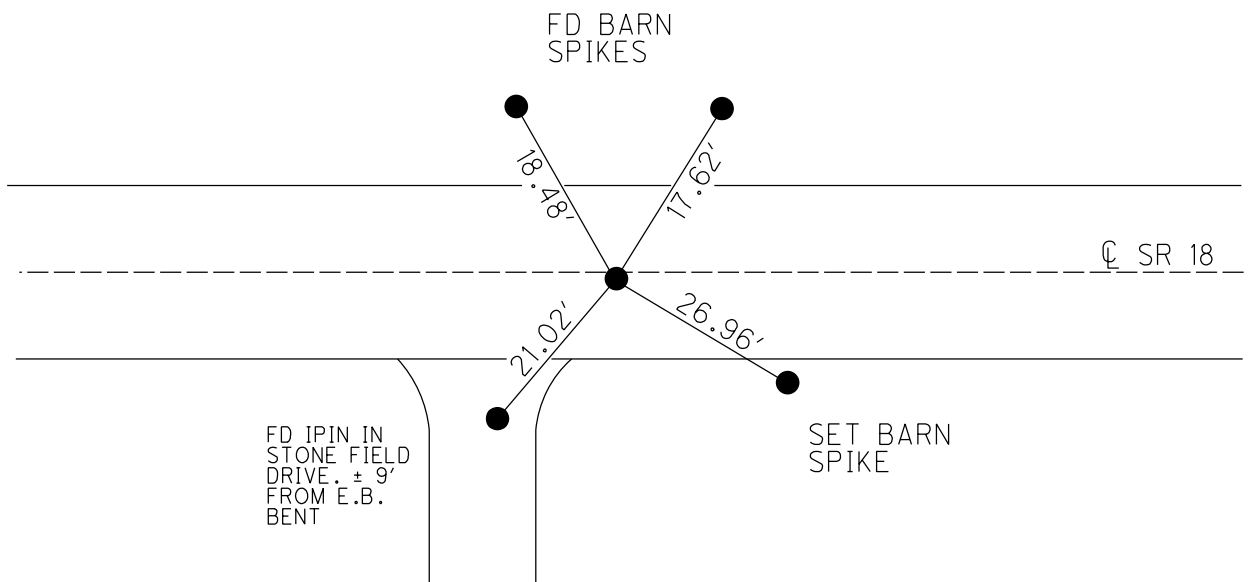

O.D.O.T. DISTRICT 2 SURVEY OFFICE (USE ONLY)

PERSONNEL

REFERENCE NO. 16 B

SHEET 7 OF 52

NOTES AUBLE

DATE 5-23-23

ROUTE SR 18

H.C. NIESE

WEATHER CALM

COUNTY WOOD

R.C. AUBLE

TEMP. 79°

TOWNSHIP JACKSON

SECTION 25

DWG BY NIESE

PID PAVETRAIN

T 3 N R 9 E

TYPE MONUMENT MAG/WASHER

ON SURFACE - ~~BELOW~~ ON

OFFSET CL PAVEMENT 0.5' ~~LT~~ : RT

8.7' TO RT EDGE PAVEMENT


STATION: 382+91

HORIZ.DATUM: NAD83(2011)

GEOID: NAVD88 2021A

GRID: NORTHING: 554930.506

EASTING: 1618950.838

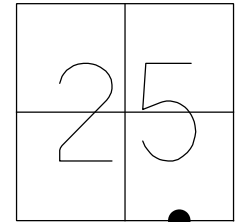

RECORD:

SET P.K.NAIL

11/21/83

FD P.K.NAIL

6/16/87

SET P.K.NAIL

7/7/87, CL

FD P.K./WASHER

6/3/11, SAH

SET MAG/WASHER

9/1/11, MC

FD MAG/WASHER


REFB16

6/15/20, JFO

4/30/21, JFO

1/21/22, TDN

8-10-23, TDN

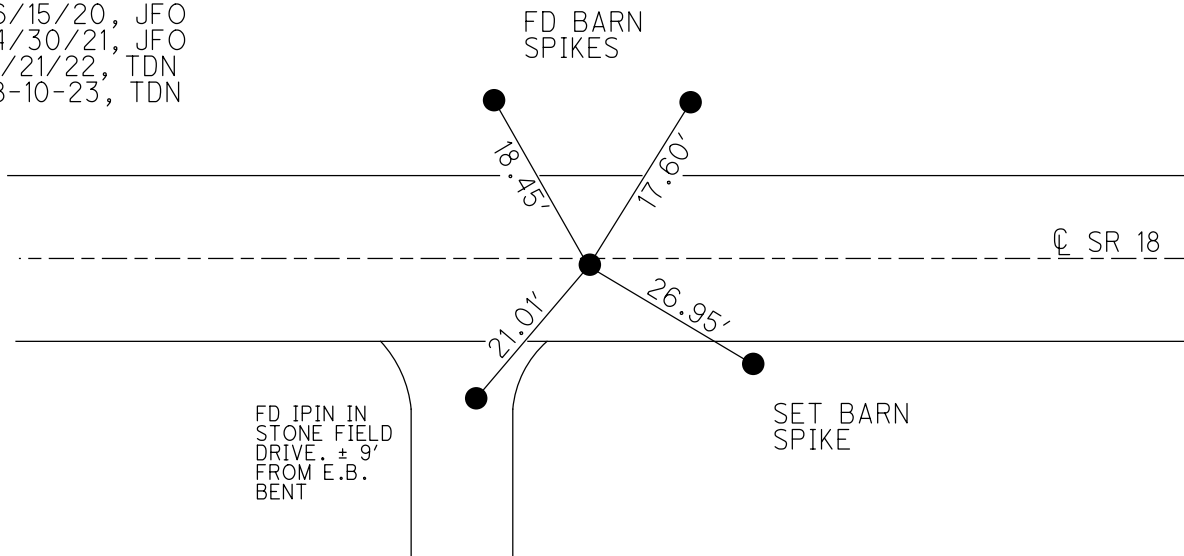

O.D.O.T. DISTRICT 2 SURVEY OFFICE (USE ONLY)

PERSONNEL

REFERENCE NO. 16 B

SHEET 7 OF 52

NOTES RHOADES

DATE 4/30/21

ROUTE SR 18

H.C. O'DONNELL

WEATHER PTLY. CLOUDY

COUNTY WOOD

R.C. RHOADES

TEMP. 48°

TOWNSHIP JACKSON

SECTION 25

DWG BY NIESE

PID PAVETRAIN

T 3 N R 9 E

TYPE MONUMENT MAG/WASHER

ON SURFACE - ~~BELOW~~ ON

OFFSET CL PAVEMENT 0.5' ~~LT~~ : RT

8.7' TO RT EDGE PAVEMENT


STATION: 369+80.32

HORZ.DATUM: NAD83(2011)

GEOID: NAVD88 2021A

GRID: NORTHING: 554930.506

EASTING: 1618950.838

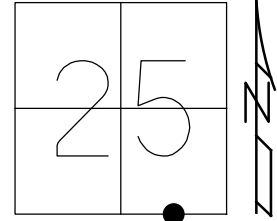

RECORD:

SET P.K.NAIL

11/21/83

FD P.K.NAIL

6/16/87

SET P.K.NAIL

7/7/87, CL

FD P.K./WASHER

6/3/11, SAH

SET MAG/WASHER

9/1/11, MC

FD MAG/WASHER


REFB16

6/15/20, JFO

4/30/21, JFO

1/21/22, TDN

SET BARN
SPIKES

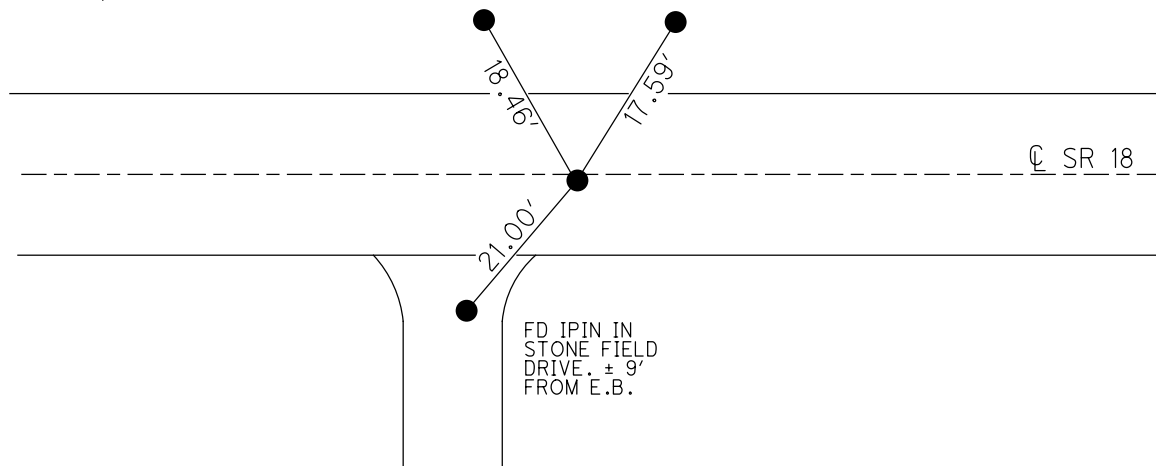

O.D.O.T. DISTRICT 2 SURVEY OFFICE (USE ONLY)

PERSONNEL

REFERENCE NO.

16 B

SHEET

7

OF

51

NOTES CANTERBURY

DATE 6/3/11

ROUTE SR 18

H.C. HUSS

WEATHER PT.CLOUDY

COUNTY WOOD

R.C. HARBAUGH

TEMP. 60°

TOWNSHIP JACKSON

SECTION 25

DWG BY O'DONNELL

PID PAVETRAIN

T 3 N R 9 E

TYPE MONUMENT P.K./WASHER

ON SURFACE - ~~BELOW~~ ON

~~LEFT~~ - CL PAV'T - RIGHT 0.5'

8.7' TO RT EDGE PAVEMENT


STATION: 382+90.15

HORZ.DATUM: NAD83 (2011)

GEOID: NAVD88-2012A

GRID: NORTHING: 554930.506

EASTING: 1618950.838

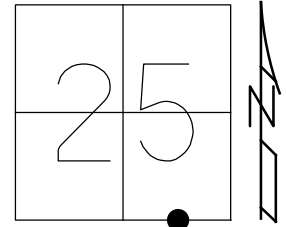

RECORD:

6/16/87 FD P.K.NAIL ON SURFACE, 0.5' RT CL.

11/21/83 SET P.K.NAIL 0.5' RT OF CL PAV'T

ON RECONSTRUCTED 1927 SURVEY LINE.

SET P.K.NAIL

7/7/87, CL

FD P.K./WASHER

GPS, REFC16


SET MAG/WASHER

9/1/11, MC

FD MAG/WASHER

REFB16


6/15/20, JFO

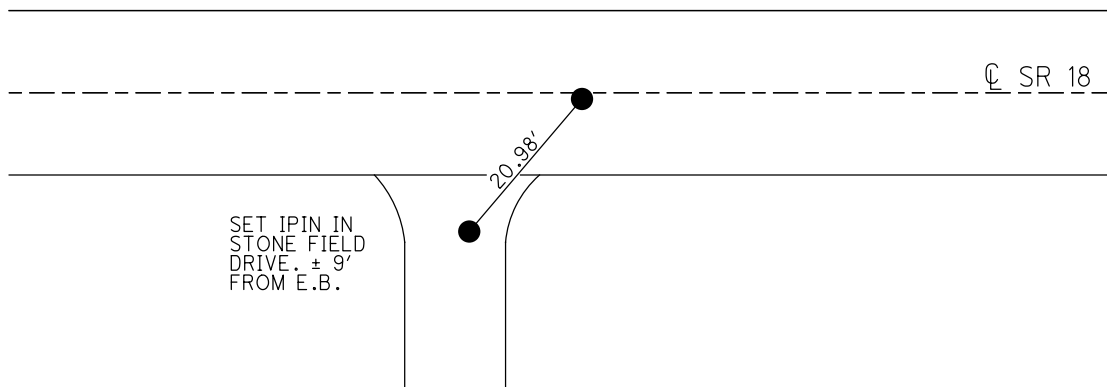

O.D.O.T. DISTRICT 2 SURVEY OFFICE (USE ONLY)

PERSONNEL _____ REFERENCE NO. 16 B SHEET 7 OF 26
NOTES CANTERBURY DATE 6/3/11 ROUTE SR 18
H.C. HUSS WEATHER PT.CLOUDY COUNTY WOOD
R.C. HARBAUGH TEMP. 60° TOWNSHIP JACKSON
SECTION 25
T 3 N R 9 E

TYPE MONUMENT P.K./WASHER
ON SURFACE - ~~BELOW~~ ON
~~LEFT~~ - CL PAV'T - RIGHT 0.5'
8.7' TO RT EDGE PAVEMENT
S.L.M. 382+90.15

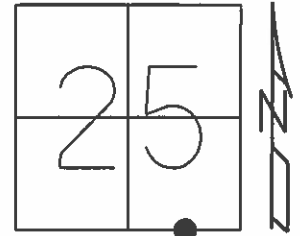


Grid: Northing: 554930.596 Easting: 1618950.755

RECORD:
6/16/87 FD P.K.NAIL ON SURFACE, 0.5' RT CL.
11/21/83 SET P.K.NAIL 0.5' RT OF CL PAV'T
ON RECONSTRUCTED 1927 SURVEY LINE.

SET P.K.NAIL
7/7/87, CL

FD P.K./WASHER
GPS, REFC16
SET MAG/WASHER
9/1/11, MC

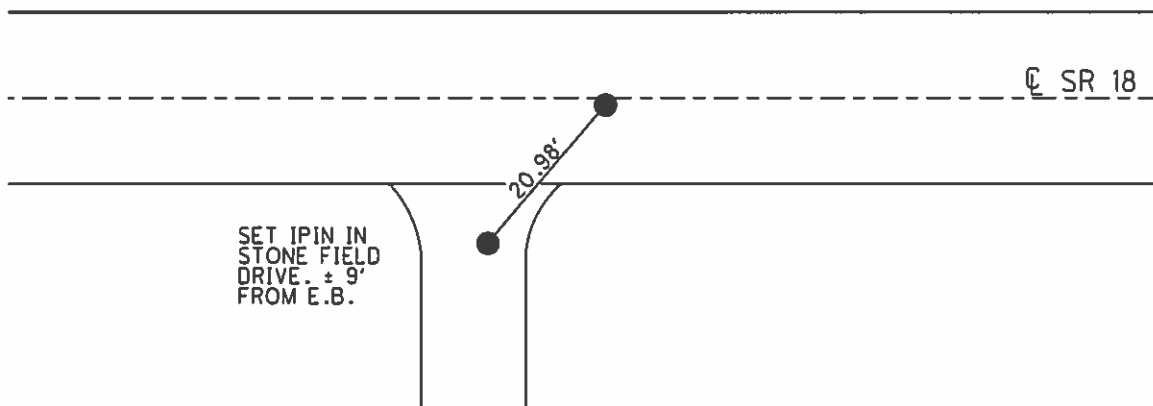

O.D.O.T. DISTRICT 2 SURVEY OFFICE

PERSONNEL

REFERENCE NO. 16B

SHEET 2 OF

NOTES HOFFMAN

H.C. LOEHRIKE

R.C. BARNHISEL

SOCKMAN

DATE 6-16-87

WEATHER CHER

TEMP. 85°

ROUTE SR 18

COUNTY WOOD

TOWNSHIP JACKSON

SECTION 25

T3 N R9 E


TYPE MONUMENT P.K. Nail

ON SURFACE - ~~BELOW~~ YES

~~LEFT - &~~ PAV'T. - RIGHT 0.5


7.7 TO RT EDGE PAVEMENT

S.L.M. 383 +84

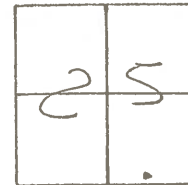

11-21-83 - HOFFMAN -
Set P.K. 0.5' Rt of & Pavt
on Re-constructed 1927 Survey Line

RESET PK
7-7-87
GL

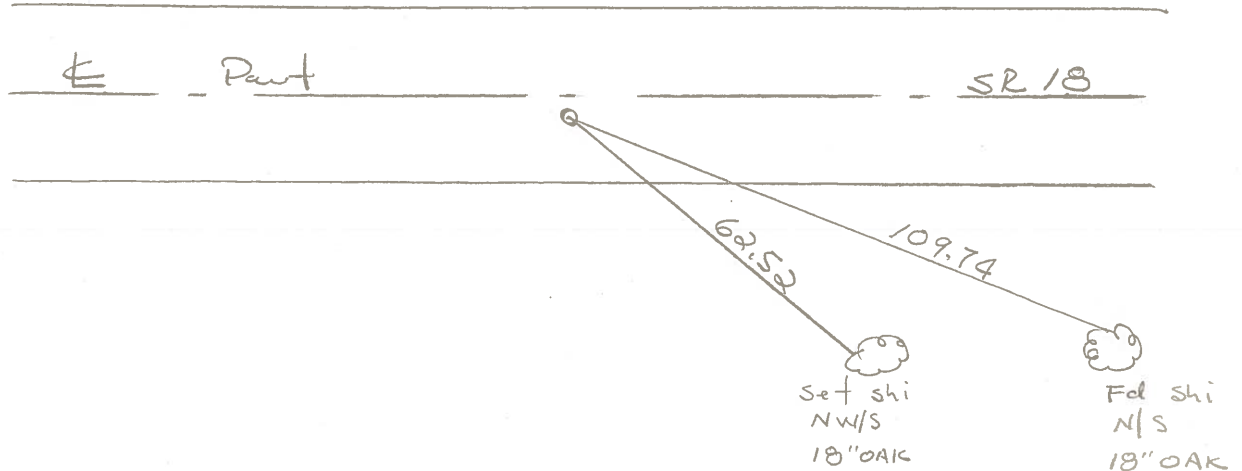

Q.D.O.T. DISTRICT 2 SURVEY OFFICE

SHEET _____ OF _____

County WOOD S.R. 18

Date 11-21-83

Township JACKSON

Weather clear

Section 25

Temp. +40°

T3N, R9E


Personnel HOFFMAN

LOEHRKE

HOUSEHOLDER

BARNHISEL

16B

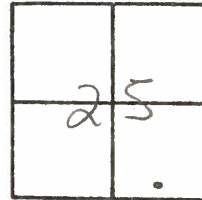

Set P.K. Nail ; 0.5' RT. of & PAUT SR 18 on & survey of 1927

