

O.D.O.T. DISTRICT 2 SURVEY OFFICE (USE ONLY)

PERSONNEL

REFERENCE NO. 16 C

SHEET 5 OF 52

NOTES ASTON

DATE 5/22/24

ROUTE SR 18

H.C. NIESE

WEATHER WINDY

COUNTY WOOD

R.C. PRESTON-COLVIN

TEMP. 78°F

TOWNSHIP JACKSON

SECTION 25

DWG BY BARRIERE

PID 101290

T 3 N R 9 E

TYPE MONUMENT MAGNAIL / WASHER

ON SURFACE - BELOW ON

OFFSET CL PAVEMENT LT : RT

TO EDGE PAVEMENT

STATION: 391+26.96

HORIZ.DATUM: WOOD LDP


GEOID: 18

GRID: NORTHING: 554922.364

EASTING: 1619787.621

LDP: NORTHING: 376334.906

EASTING: 131855.237

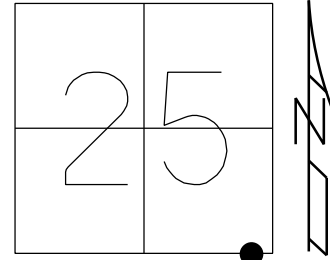

RECORD:

FD SM.P.K.NAIL

SET BY OTHERS

6/16/87

SET P.K./WASHER

7/7/87, CL

FD P.K.NAIL

6/16/10, BG

FD P.K./WASHER

7/28/11, MC

SET MAG/WASHER

9/1/11, MC

FD MAG/WASHER

REFC16

6/15/20, JFO

4/30/21, JFO

1/21/21, TDN


5-23-23, TDN

8-10-23, TDN

REF16C

5/22/24, TDN

10/25/24, TDN

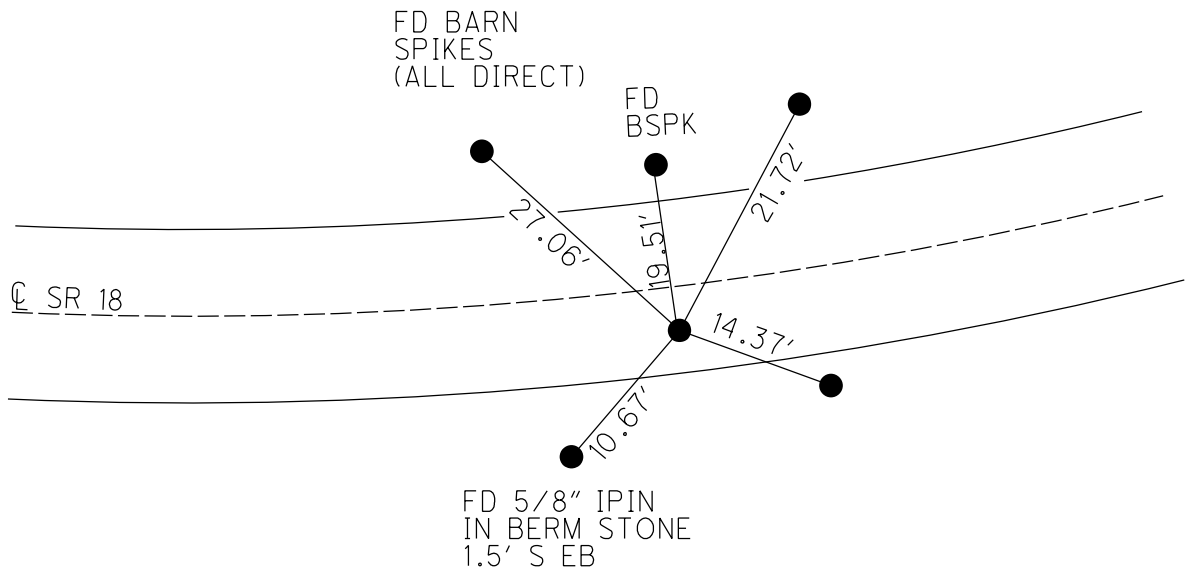

O.D.O.T. DISTRICT 2 SURVEY OFFICE (USE ONLY)

PERSONNEL

REFERENCE NO. 16 C

SHEET 8 OF 52

NOTES RHOADES

DATE 4/30/21

ROUTE SR 18

H.C. O'DONNELL

WEATHER PTLY. CLOUDY

COUNTY WOOD

R.C. RHOADES

TEMP. 75°

TOWNSHIP JACKSON

SECTION 25

DWG BY NIESE PID PAVETRAIN

T 3 N R 9 E

TYPE MONUMENT MAG/WASHER

ON SURFACE - ~~BELOW~~ ON

OFFSET CL PAVEMENT 5.5' ~~LT~~ : RT

4.0' TO RT EDGE PAVEMENT


STATION: 391+26.96

HORZ.DATUM: NAD83(2011)


GEOID: NAVD88 2012A

GRID: NORTHING: 554922.364

EASTING: 1619787.621

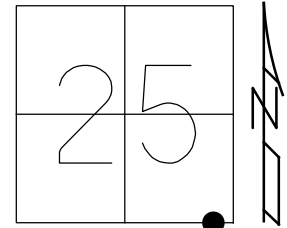

RECORD:
FD SM.P.K.NAIL
SET BY OTHERS
6/16/87
SET P.K./WASHER
7/7/87, CL
FD P.K.NAIL
6/16/10, BG
FD P.K./WASHER
7/28/11, MC
SET MAG/WASHER
9/1/11, MC
FD MAG/WASHER
REFC16
6/15/20, JFO
4/30/21, JFO
1/21/21, TDN
5-23-23, TDN
8-10-23, TDN

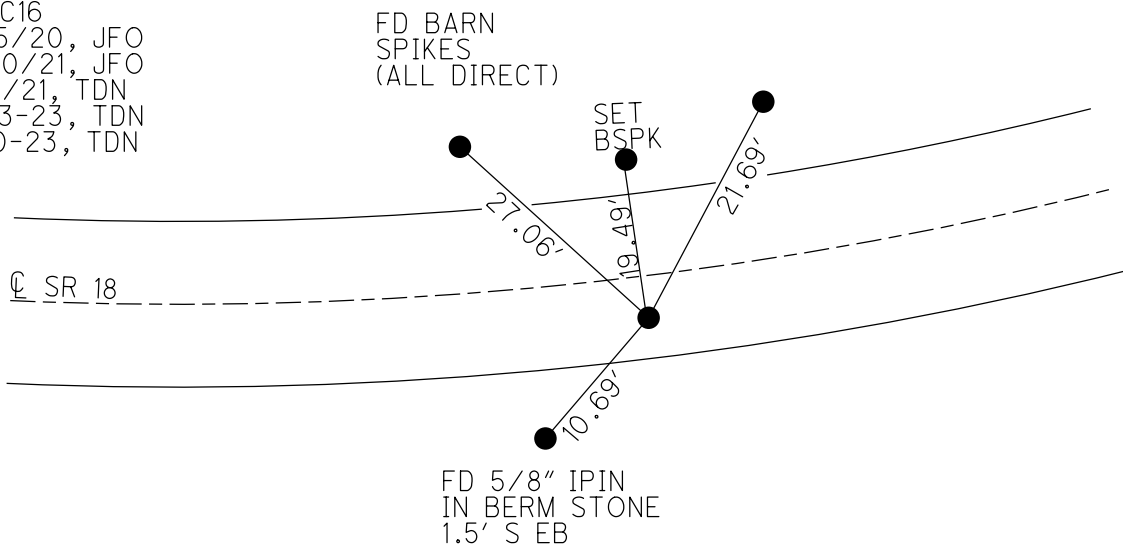

O.D.O.T. DISTRICT 2 SURVEY OFFICE (USE ONLY)

PERSONNEL

REFERENCE NO. 16 C

SHEET 8 OF 52

NOTES RHOADES

DATE 4/30/21

ROUTE SR 18

H.C. O'DONNELL

WEATHER PTLY. CLOUDY

COUNTY WOOD

R.C. RHOADES

TEMP. 75°

TOWNSHIP JACKSON

SECTION 25

DWG BY NIESE

PID PAVETRAIN

T 3 N R 9 E

TYPE MONUMENT MAG/WASHER

ON SURFACE - ~~BELOW~~ ON

OFFSET CL PAVEMENT 5.5' ~~LT~~ : RT

4.0' TO RT EDGE PAVEMENT


STATION: 391+26.96

HORIZ.DATUM: NAD83(2011)

GEOID: NAVD88 2012A

GRID: NORTHING: 554922.364

EASTING: 1619787.621

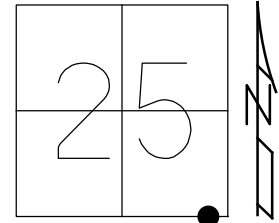

RECORD:

FD SM.P.K.NAIL

SET BY OTHERS

6/16/87

SET P.K./WASHER

7/7/87, CL

FD P.K.NAIL

6/16/10, BG

FD P.K./WASHER

7/28/11, MC

SET MAG/WASHER

9/1/11, MC


FD MAG/WASHER

REFC16

6/15/20, JFO

4/30/21, JFO

1/21/21, TDN

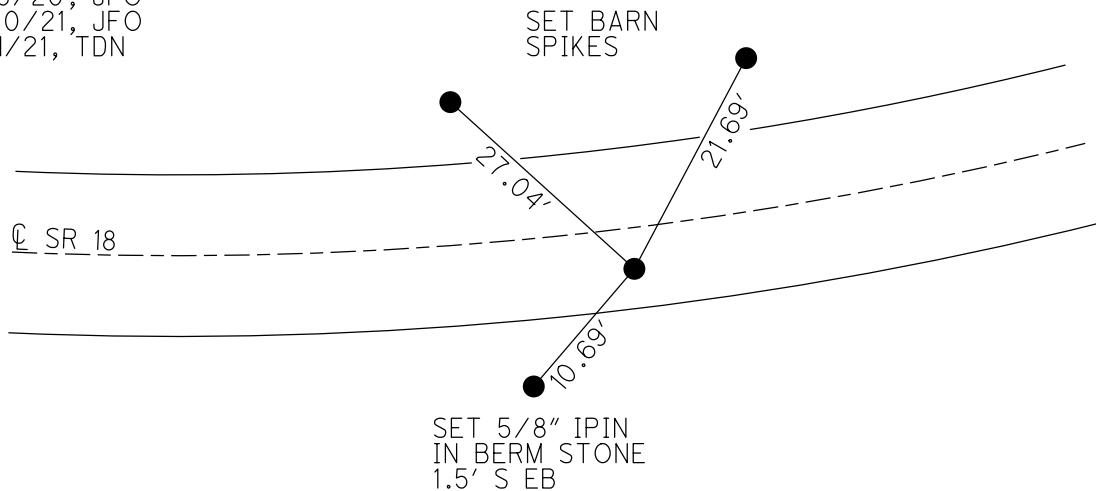


O.D.O.T. DISTRICT 2 SURVEY OFFICE (USE ONLY)

PERSONNEL	REFERENCE NO. <u>16 C</u>	SHEET <u>8</u> OF <u>26</u>
NOTES <u>CANTERBURY</u>	DATE <u>7/28/11</u>	ROUTE <u>SR 18</u>
H.C. <u>HUSS</u>	WEATHER <u>PT.CLOUDY</u>	COUNTY <u>WOOD</u>
R.C. <u>HARBAUGH</u>	TEMP. <u>75°</u>	TOWNSHIP <u>JACKSON</u>
		SECTION <u>25</u>
		T <u>3</u> N R <u>9</u> E

TYPE MONUMENT P.K./WASHER
 ON SURFACE - ~~BELOW~~ ON
~~LEFT~~ - CL PAV'T - RIGHT 5.5'
4.0' TO RT EDGE PAVEMENT
 S.L.M. 391+26.96


Grid: Northing: 554922.432 Easting: 1619787.519

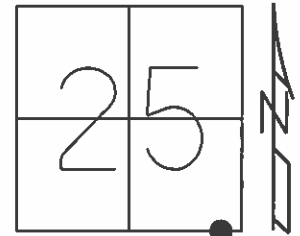

FD SM.P.K.NAIL
 SET BY OTHERS
 FOR BRIDGE SURVEY
 6/16/87
 SET P.K./WASHER
 7/7/87, CL

FD P.K.NAIL
 6/15/10
 GPS, SVD16
 6/16/10, BG

SET MAG/WASHER
 9/1/11, MC

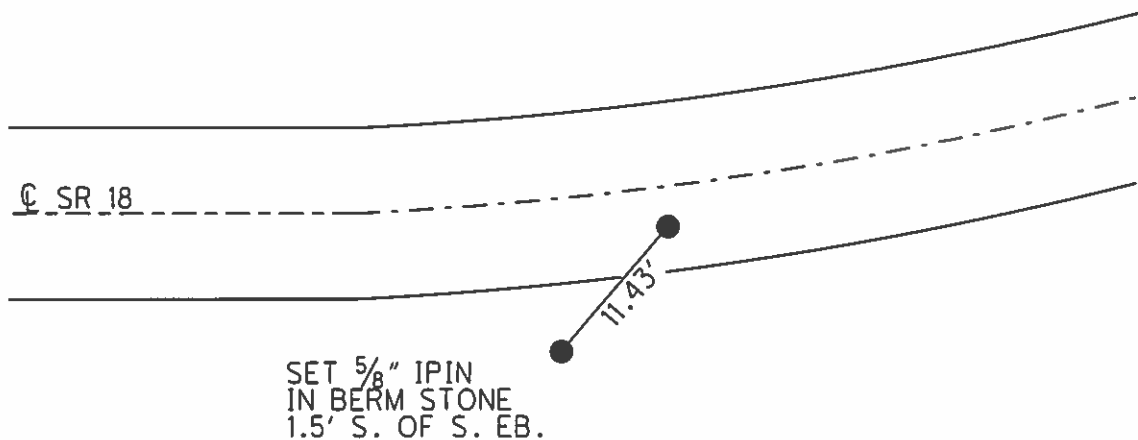

O.D.O.T. DISTRICT 2 SURVEY OFFICE

PERSONNEL

REFERENCE NO. 16C

SHEET 2A OF

NOTES HOFFMAN

H.C. LOEHKE

R.C. BARNHISE

SOCKMAN

DATE 6-16-87

WEATHER CLEAR

TEMP. 85°

ROUTE SR 18

COUNTY WOOD

TOWNSHIP JACKSON

SECTION 25

T 3 N R 9 E


TYPE MONUMENT SMALL P.K. Nail - BY OTHERS

ON SURFACE - BELOW yes

LEFT- & PAW'T. - RIGHT 5.4'

3.9' TO RT EDGE PAVEMENT

S.L.M. 392+21

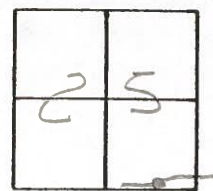


For small P.K. FOR P.I. FOR BRIDGE SURVEY - BY OTHERS -

SET P.K./WASHER

7-7-87

C.L.

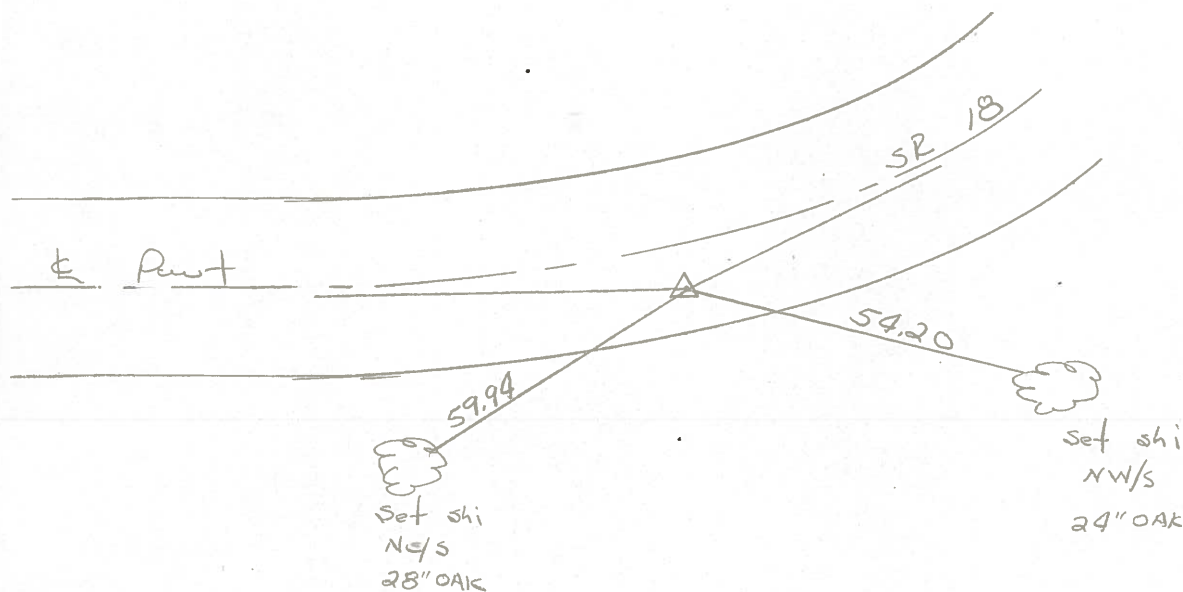

O.D.O.T. DISTRICT 2 SURVEY OFFICE (USE ONLY)

PERSONNEL _____ REFERENCE NO. 16 C SHEET 8 OF 51
NOTES CANTERBURY DATE 7/28/11 ROUTE SR 18
H.C. HUSS WEATHER PT.CLOUDY COUNTY WOOD
R.C. HARBAUGH TEMP. 75° TOWNSHIP JACKSON
SECTION 25
DWG BY O'DONNELL PID PAVETRAIN T 3 N R 9 E

TYPE MONUMENT P.K./WASHER

ON SURFACE - ~~BELOW~~ ON

~~LEFT~~ - CL PAV'T - RIGHT 5.5'

4.0' TO RT EDGE PAVEMENT


STATION: 391+26.96

HORZ.DATUM: NAD83 (2011)

GEOID: NAVD88-2012A

GRID: NORTHING: 554922.364

EASTING: 1619787.621

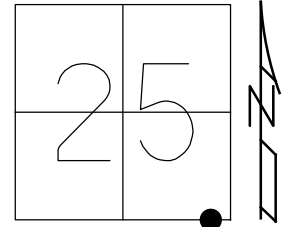

FD SM.P.K.NAIL
SET BY OTHERS
FOR BRIDGE SURVEY
6/16/87
SET P.K./WASHER
7/7/87, CL

FD P.K.NAIL
6/15/10
GPS, SVD16
6/16/10, BG

SET MAG/WASHER
9/1/11, MC
FD MAG/WASHER
REFC16
6/15/20, JFO

