

O.D.O.T. DISTRICT 2 SURVEY OFFICE (USE ONLY)

PERSONNEL

REFERENCE NO. 16 D

SHEET 5 OF 52

NOTES ASTON

DATE 5/22/24

ROUTE SR 18

H.C. NIESE

WEATHER WINDY

COUNTY WOOD

R.C. PRESTON-COLVIN

TEMP. 78°F

TOWNSHIP JACKSON

DWG BY BARRIERE

PID 101290

SECTION 25

T 3 N R 9 E

TYPE MONUMENT MAGNAIL/WASHER

ON SURFACE - BELOW ON

OFFSET $\varnothing$ PAVEMENT _____ LT : RT

_____ TO _____ EDGE PAVEMENT

STATION: 394+24.51

HORZ.DATUM: WOOD LDP


GEOID: 18

GRID: NORTHING: 554955.024


EASTING: 1620083.350

LDP: NORTHING: 376371.444

EASTING: 132150.538

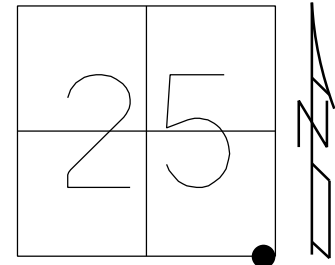

RECORD:
 FD SM.P.K.NAIL
 SET BY OTHERS
 6/16/87
 FD P.K. NAIL
 6/16/10, BG
 SET MAG/WASHER
 9/1/11, MC
 FD MAG/WASHER
 REF16
 6/15/20, JFO
 4/30/21, JFO
 1/21/22, TDN
 8-10-23, TDN
 REF16D
 5/22/24, TDN
 10/25/24, TDN

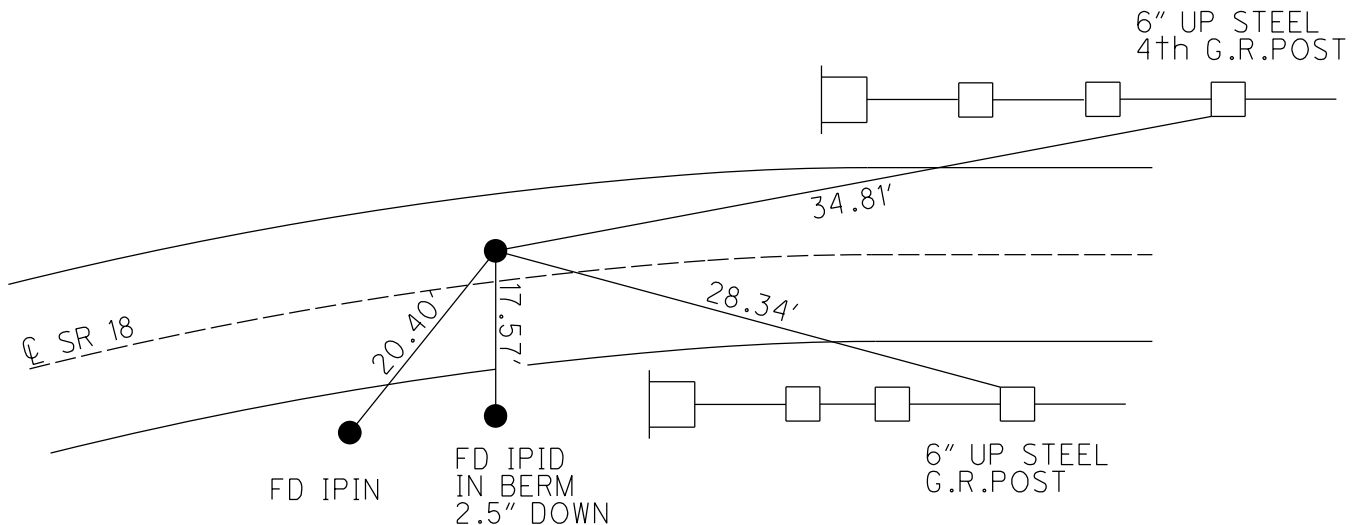

O.D.O.T. DISTRICT 2 SURVEY OFFICE (USE ONLY)

PERSONNEL

REFERENCE NO. 16 D

SHEET 9 OF 52

NOTES AUBLE

DATE 5-23-23

ROUTE SR 18

H.C. NIESE

WEATHER CALM

COUNTY WOOD

R.C. AUBLE

TEMP. 79°

TOWNSHIP JACKSON

SECTION 25

DWG BY NIESE

PID PAVETRAIN

T 3 N R 9 E

TYPE MONUMENT MAG/WASHER

ON SURFACE - ~~BELOW~~ ON

OFFSET Q PAVEMENT 3.4' LT : ~~RT~~

5.7' TO LT EDGE PAVEMENT


STATION: 394+24.51

HORZ.DATUM: NAD83(2011)


GEOID: NAVD88 2012A

GRID: NORTHING: 554955.024

EASTING: 1620083.350

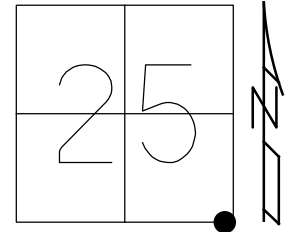

RECORD:
FD SM.P.K.NAIL
SET BY OTHERS
6/16/87
FD P.K. NAIL
6/16/10, BG
SET MAG/WASHER
9/1/11, MC
FD MAG/WASHER
REFD16
6/15/20, JFO
4/30/21, JFO
1/21/22, TDN
8-10-23, TDN

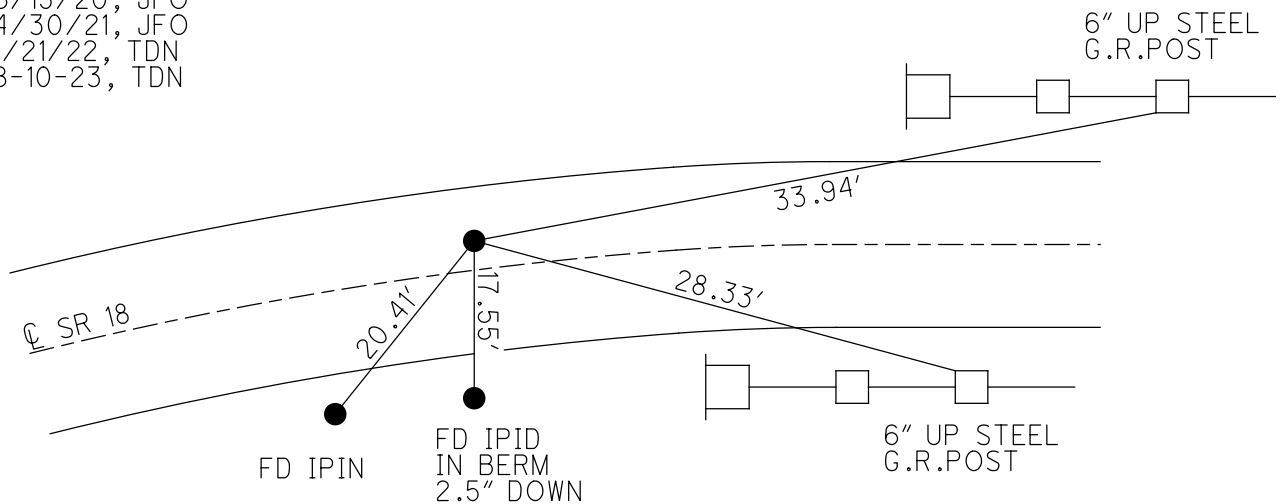

O.D.O.T. DISTRICT 2 SURVEY OFFICE (USE ONLY)

PERSONNEL

REFERENCE NO. 16 D

SHEET 9 OF 52

NOTES RHOADES

DATE 4/30/21

ROUTE SR 18

H.C. O'DONNELL

WEATHER CLOUDY

COUNTY WOOD

R.C. RHOADES

TEMP. 48°

TOWNSHIP JACKSON

SECTION 25

DWG BY NIESE

PID PAVETRAIN

T 3 N R 9 E

TYPE MONUMENT MAG/WASHER

ON SURFACE - ~~BELOW~~ ON

OFFSET CL PAVEMENT 3.4' LT : ~~RT~~

5.7' TO LT EDGE PAVEMENT


STATION: 394+24.51

HORZ.DATUM: NAD83(2011)


GEOID: NAVD88 2012A

GRID: NORTHING: 554955.024

EASTING: 1620083.350

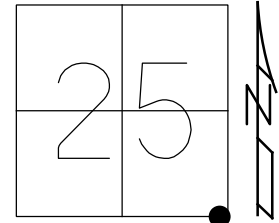

RECORD:
FD SM.P.K.NAIL
SET BY OTHERS
6/16/87
FD P.K. NAIL
6/16/10, BG
SET MAG/WASHER
9/1/11, MC
FD MAG/WASHER
REFD16
6/15/20, JFO
4/30/21, JFO
1/21/22, TDN

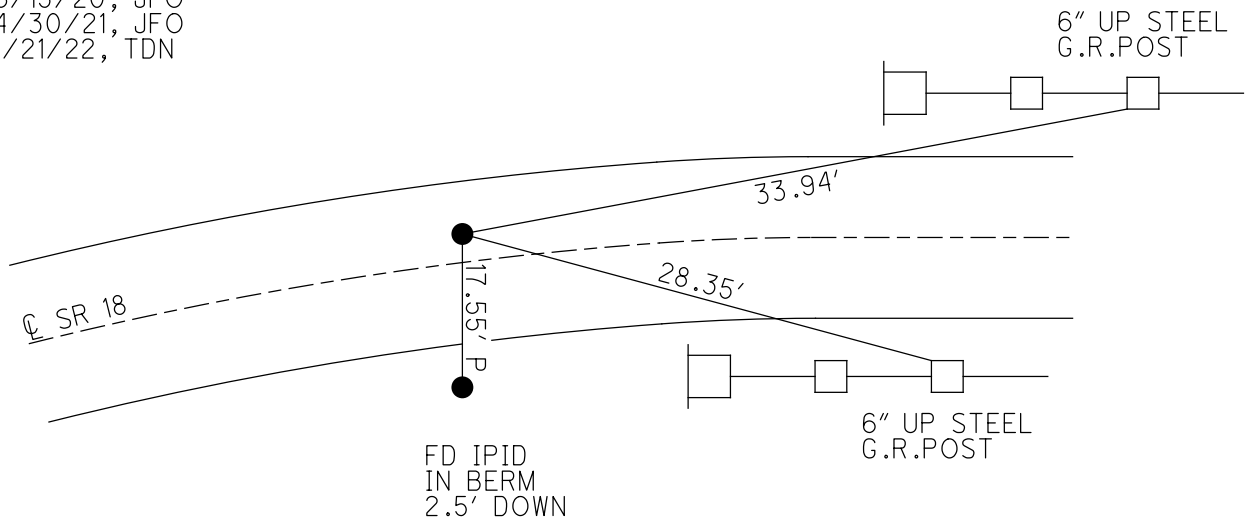

O.D.O.T. DISTRICT 2 SURVEY OFFICE (USE ONLY)

PERSONNEL _____ REFERENCE NO. 16 D SHEET 9 OF 51

NOTES CANTERBURY DATE 7/28/11 ROUTE SR 18
H.C. HUSS WEATHER CLOUDY COUNTY WOOD
R.C. HARBAUGH TEMP. 78° TOWNSHIP JACKSON
SECTION 25

DWG BY O'DONNELL PID PAVETRAIN

T 3 N R 9 E

TYPE MONUMENT P.K./WASHER

ON SURFACE - ~~BELOW~~ ON

LEFT - ℄ PAV'T - ~~RIGHT~~ 3.4'

5.7' TO LT EDGE PAVEMENT


STATION: 394+24.51

HORIZ.DATUM: NAD83 (2011)

GEOID: NAVD88-2012A

GRID: NORTHING: 554955.024

EASTING: 1620083.350

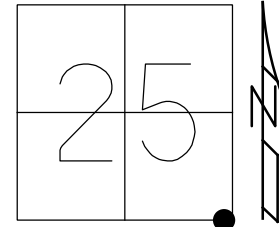


FD SM.P.K.NAIL FOR P.I.
SET BY OTHERS
FOR BRIDGE SURVEY
6/16/87

FD P.K.NAIL
6/15/10
GPS, SVE16
6/16/10, BG

SET MAG/WASHER
9/1/11, MC
FD MAG/WASHER
REFD16
6/15/20, JFO

183.79' TO ℄ OF
RANGE LINE RD

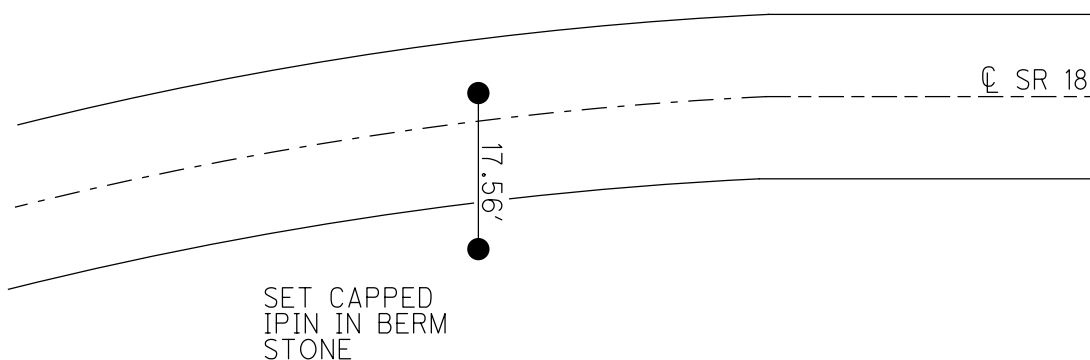

O.D.O.T. DISTRICT 2 SURVEY OFFICE (USE ONLY)

PERSONNEL _____ REFERENCE NO. 16 D SHEET 9 OF 26

NOTES CANTERBURY DATE 7/28/11 ROUTE SR 18

H.C. HUSS WEATHER CLOUDY COUNTY WOOD

R.C. HARBAUGH TEMP. 78° TOWNSHIP JACKSON

SECTION 25

T 3 N R 9 E


TYPE MONUMENT P.K./WASHER

ON SURFACE - ~~BELOW~~ ON

LEFT - ℄ PAV'T - ~~RIGHT~~ 3.4'

5.7' TO LT EDGE PAVEMENT

S.L.M. 394+24.51

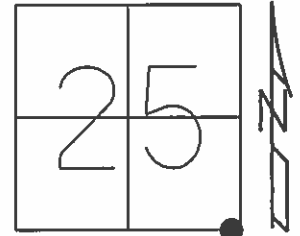


Grid: Northing: 554955.073 Easting: 1620083.277

FD SM.P.K.NAIL FOR P.I.
SET BY OTHERS
FOR BRIDGE SURVEY
6/16/87

FD P.K.NAIL
6/15/10
GPS, SVE16
6/16/10, BG

SET MAG/WASHER
9/1/11, MC

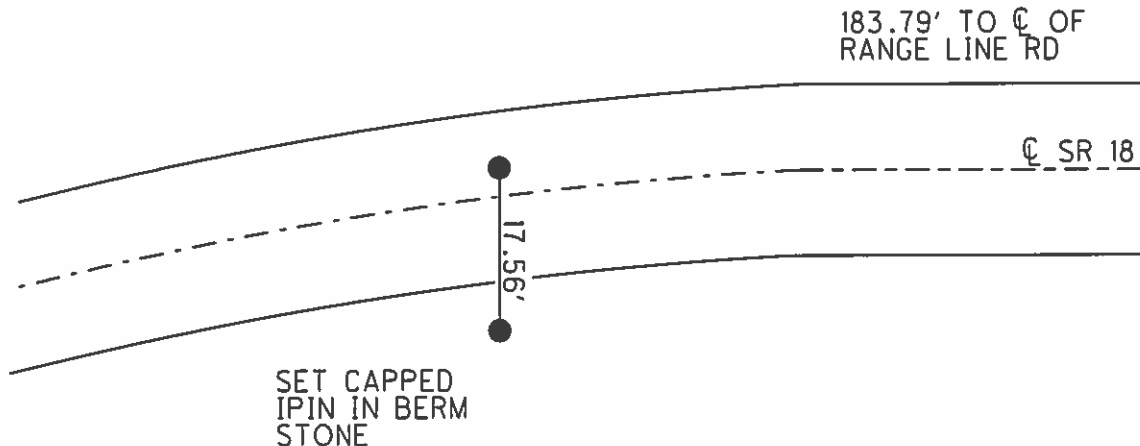

O.D.O.T. DISTRICT 2 SURVEY OFFICE

PERSONNEL

REFERENCE NO. 16D

SHEET 2B OF

NOTES HOFFMAN

H.C. LOEHRKE

DATE 6-16-87

ROUTE SR 18

R.C. BARNHISEL

WEATHER CLEAR

COUNTY WOOD

SOCKMAN

TEMP. 85°

TOWNSHIP JACKSON

SECTION 25

T. 3 N. R. 9 E.

TYPE MONUMENT SMALL P.K. Nail - By OTHERS


ON SURFACE - BELOW YES

LEFT-~~E~~ PAV'T. - RIGHT 3.6'

4.6 TO LT EDGE PAVEMENT

S.L.M. 395 + 17

Set PK/washer
7-7-87
C.L.

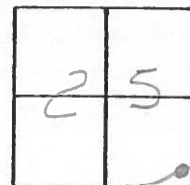

FD SMALL P.K. FOR P.I. FOR BRIDGE SURVEY - By OTHERS -

