

O.D.O.T. DISTRICT 2 SURVEY OFFICE (USE ONLY)

PERSONNEL

REFERENCE NO. 17 B

SHEET 5 OF 52

NOTES ASTON DATE 5/22/24
H.C. NIESE WEATHER WINDY
R.C. PRESTON-COLVIN TEMP. 80°F

ROUTE SR 18
COUNTY WOOD
TOWNSHIP JACKSON
SECTION 25

DWG BY BARRIERE PID 101290

T 3 N R 9 E

TYPE MONUMENT MONBOX W/ 1" IPIN

ON SURFACE - BELOW ON

OFFSET $\angle$ PAVEMENT _____ LT : RT

_____ TO _____ EDGE PAVEMENT

STATION: 396+08.5

HORIZ.DATUM: WOOD LDP


GEOID: 18

GRID: NORTHING: 554909.411


EASTING: 1620266.932

LDP: NORTHING: 376328.284

EASTING: 132334.680

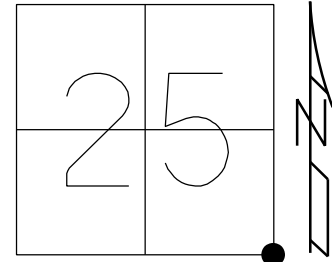

RECORD:
FD 1" IPIN
6/16/87, CL
FD MONBOX
6/16/10, BG
7/28/11, MC
FD MONBOX
W/1" IPIN
REFB17
6/15/20, JFO
4/30/21, JFO
1/21/22, TDN
FD MONBOX
W/1" IPIN
REF17B
5/23/24, TDN

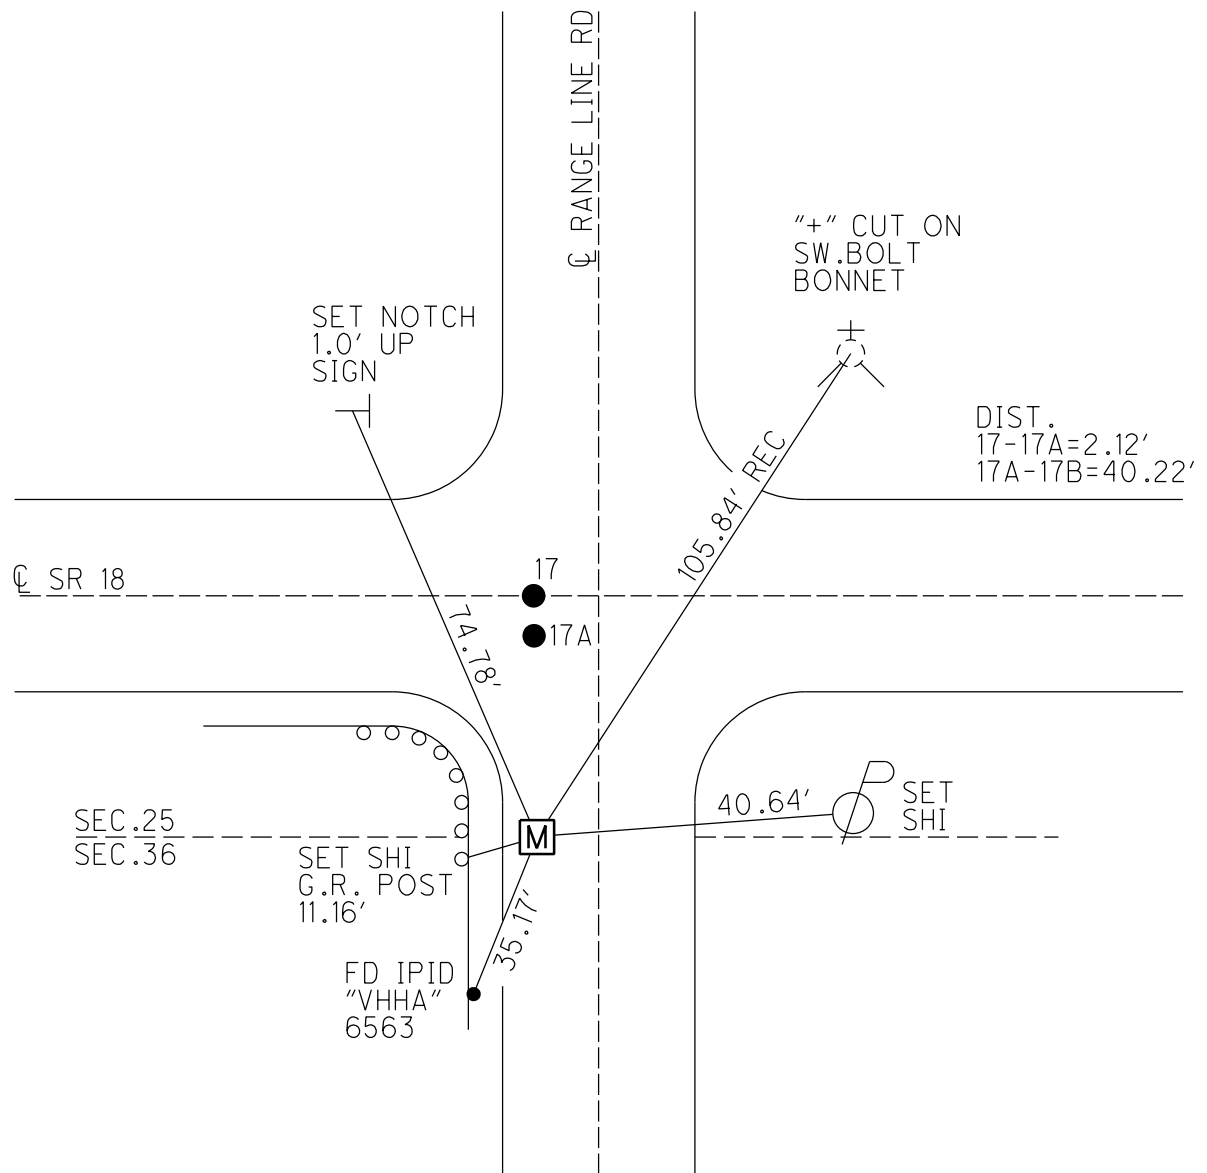

O.D.O.T. DISTRICT 2 SURVEY OFFICE (USE ONLY)

PERSONNEL

REFERENCE NO. 17 B

SHEET 12 OF 52

NOTES RHOADES

DATE 4/30/21

ROUTE SR 18

H.C. O'DONNELL

WEATHER CLOUDY

COUNTY WOOD

R.C. RHOADES

TEMP. 48°

TOWNSHIP JACKSON

DWG BY NIESE

PID PAVETRAIN

SECTION 25

T 3 N R 9 E

TYPE MONUMENT MONBOX W/1" IPIN

ON SURFACE - ~~BELOW~~ ON

OFFSET Q PAVEMENT 42.95' ~~LT~~ : RT

- TO - EDGE PAVEMENT 12.0' W OF CO.RD. SOUTH


STATION: 396+08.50

HORZ.DATUM: NAD83(2011)


GEOID: NAVD88 2012A

GRID: NORTHING: 554909.411

EASTING: 1620266.932

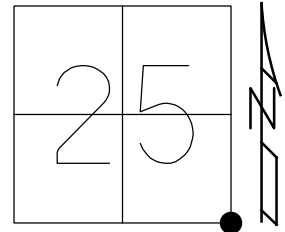

RECORD:
FD 1" IPIN
6/16/87, CL
FD MONBOX
6/16/10, BG
7/28/11, MC
FD MONBOX
W/1" IPIN
REFB17
6/15/20, JFO
4/30/21, JFO
1/21/22, TDN

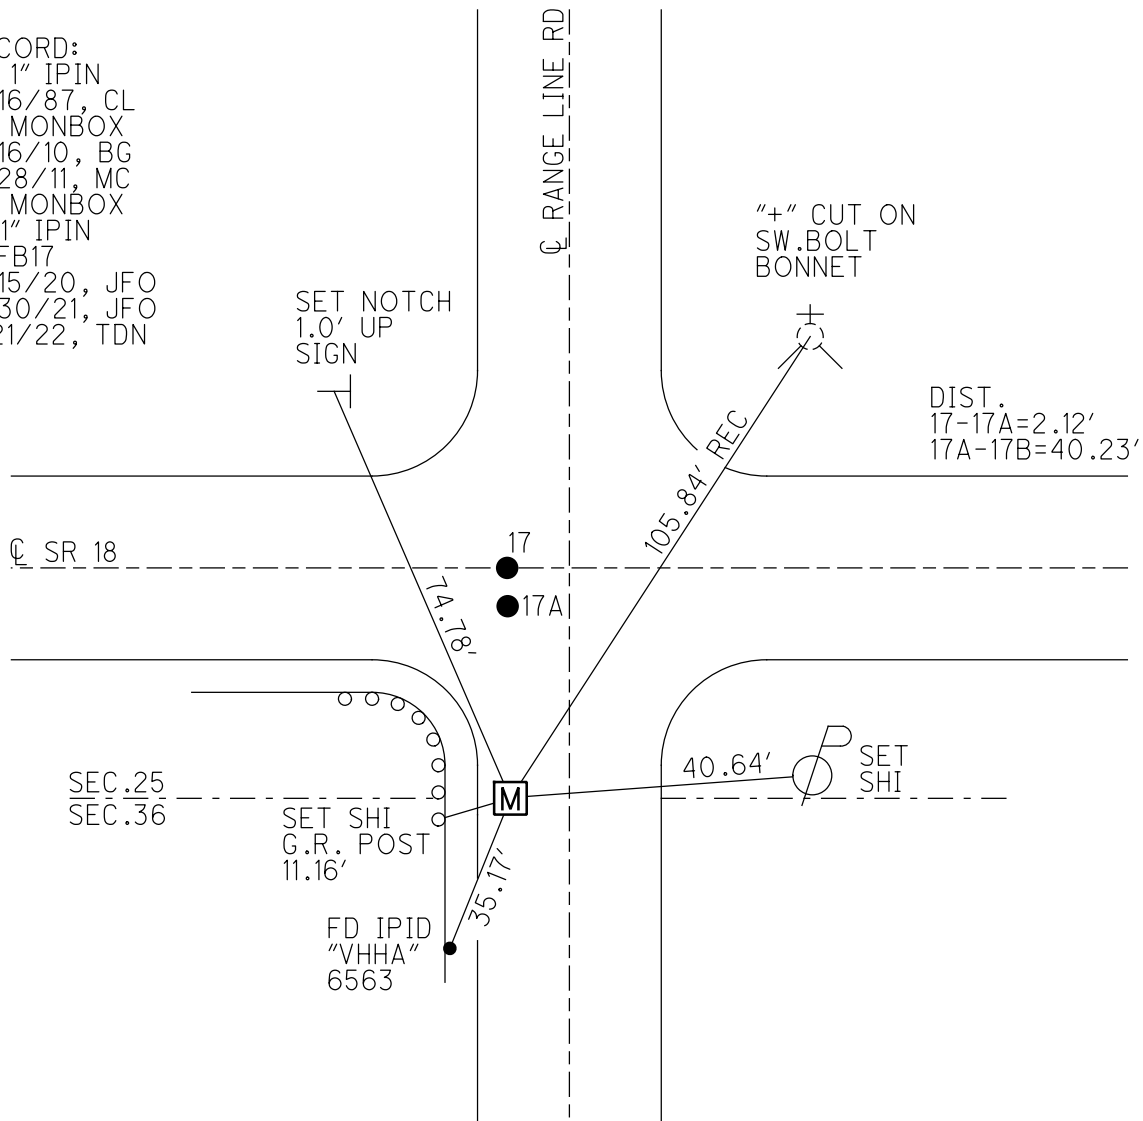

O.D.O.T. DISTRICT 2 SURVEY OFFICE (USE ONLY)

PERSONNEL _____ REFERENCE NO. 17 B SHEET 12 OF 26

NOTES CANTERBURY DATE 7/28/11 ROUTE SR 18

H.C. CANTERBURY WEATHER OVERCAST COUNTY WOOD

R.C. HARBAUGH TEMP. 83° TOWNSHIP JACKSON

SECTION 25

T 3 N R 9 E

TYPE MONUMENT MON.BOX


ON SURFACE - ~~BELOW~~ ON _____

~~LEFT~~ - CL PAV'T - RIGHT 42.95', 12.0' W. OF
CO.RD. SOUTH

TO EDGE PAVEMENT


S.L.M. 396+08.5

Grid: Northing: 554909.488 Easting: 1620266.865

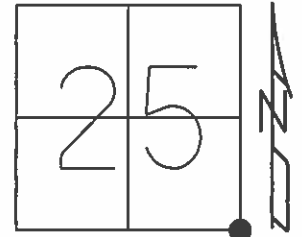

RECORD:
 FD 1" IPIN
 6/16/87, CL

FD MON.BOX
 6/15/10
 GPS, SVA17
 6/16/10, BG

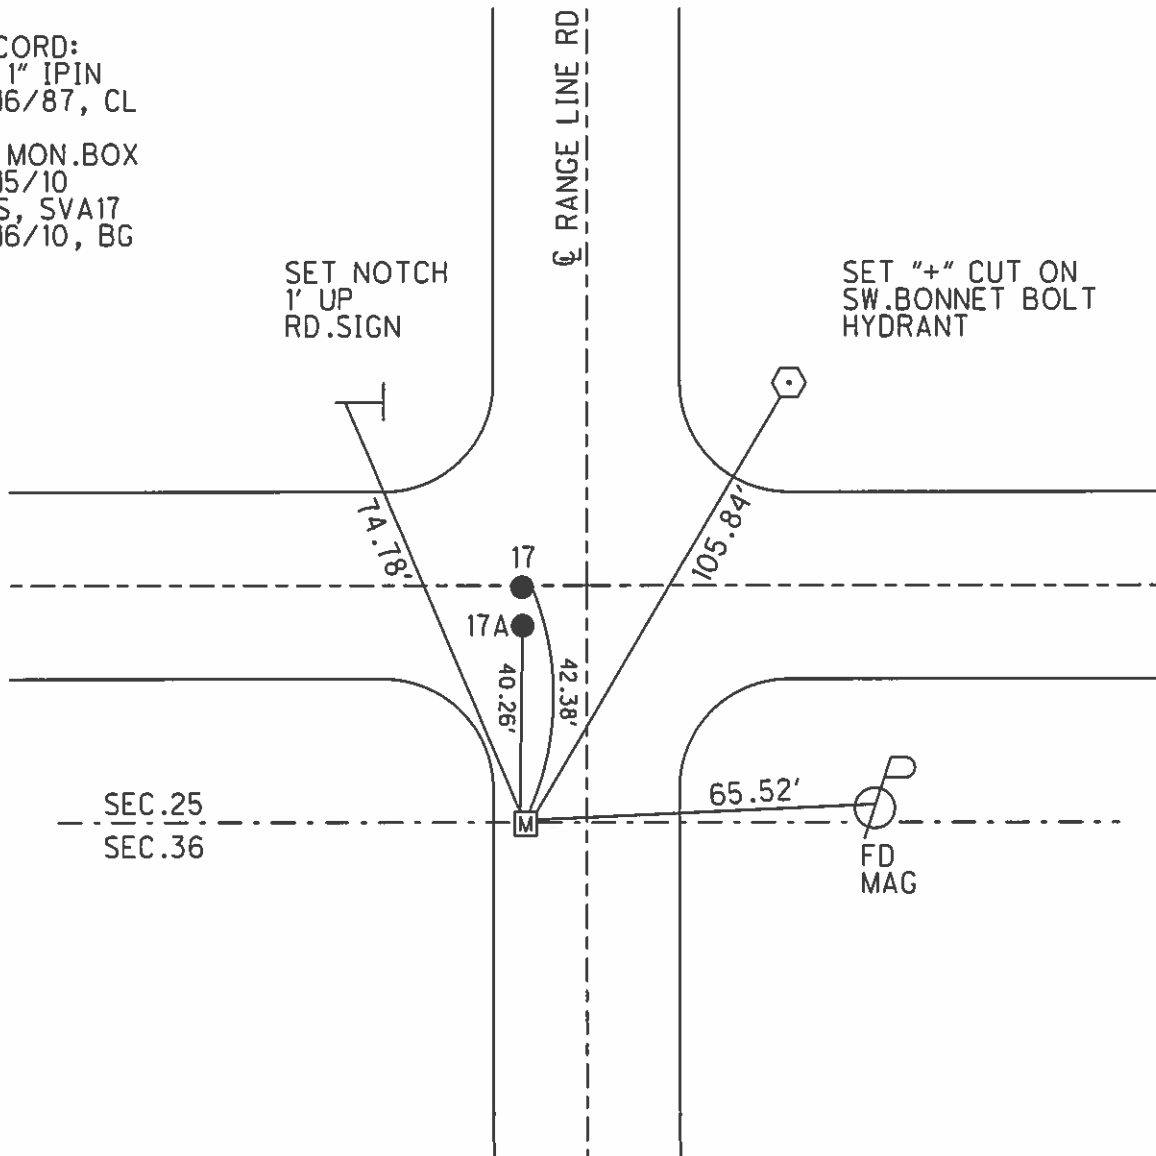

O.D.O.T. DISTRICT 2 SURVEY OFFICE

PERSONNEL

REFERENCE NO. 17

SHEET 3 OF

NOTES HOFFMAN

H.C. LOEHRKE

R.C. BARNHISEL

SOCKMAN

DATE 6-16-87

WEATHER CLEAR

TEMP. 85°

ROUTE SR 18

COUNTY WOOD

TOWNSHIP JACKSON

SECTION 25

T3 N R 9 E


TYPE MONUMENT 1" □ IRON PIN

ON SURFACE - BELOW 6"

LEFT - & PAW'T. - RIGHT 12.0' Co. Rd South


2.5' TO West EDGE PAVEMENT of Co. Rd South

S.L.M. 397 + 01

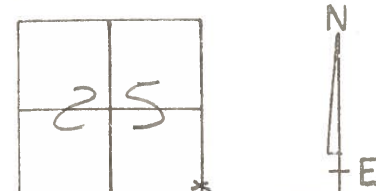


RESET P.K. & WASHERS
FOR PTS B & C 7-7-87
C.L.

- A = 1" □ I. Pin - Fd.
- B = small P.K. set by OTHERS
at section CORNER - APPARENTLY -
- C = small P.K. set on & SURVEY
FOR BRIDGE - APPARENTLY -
set by OTHERS

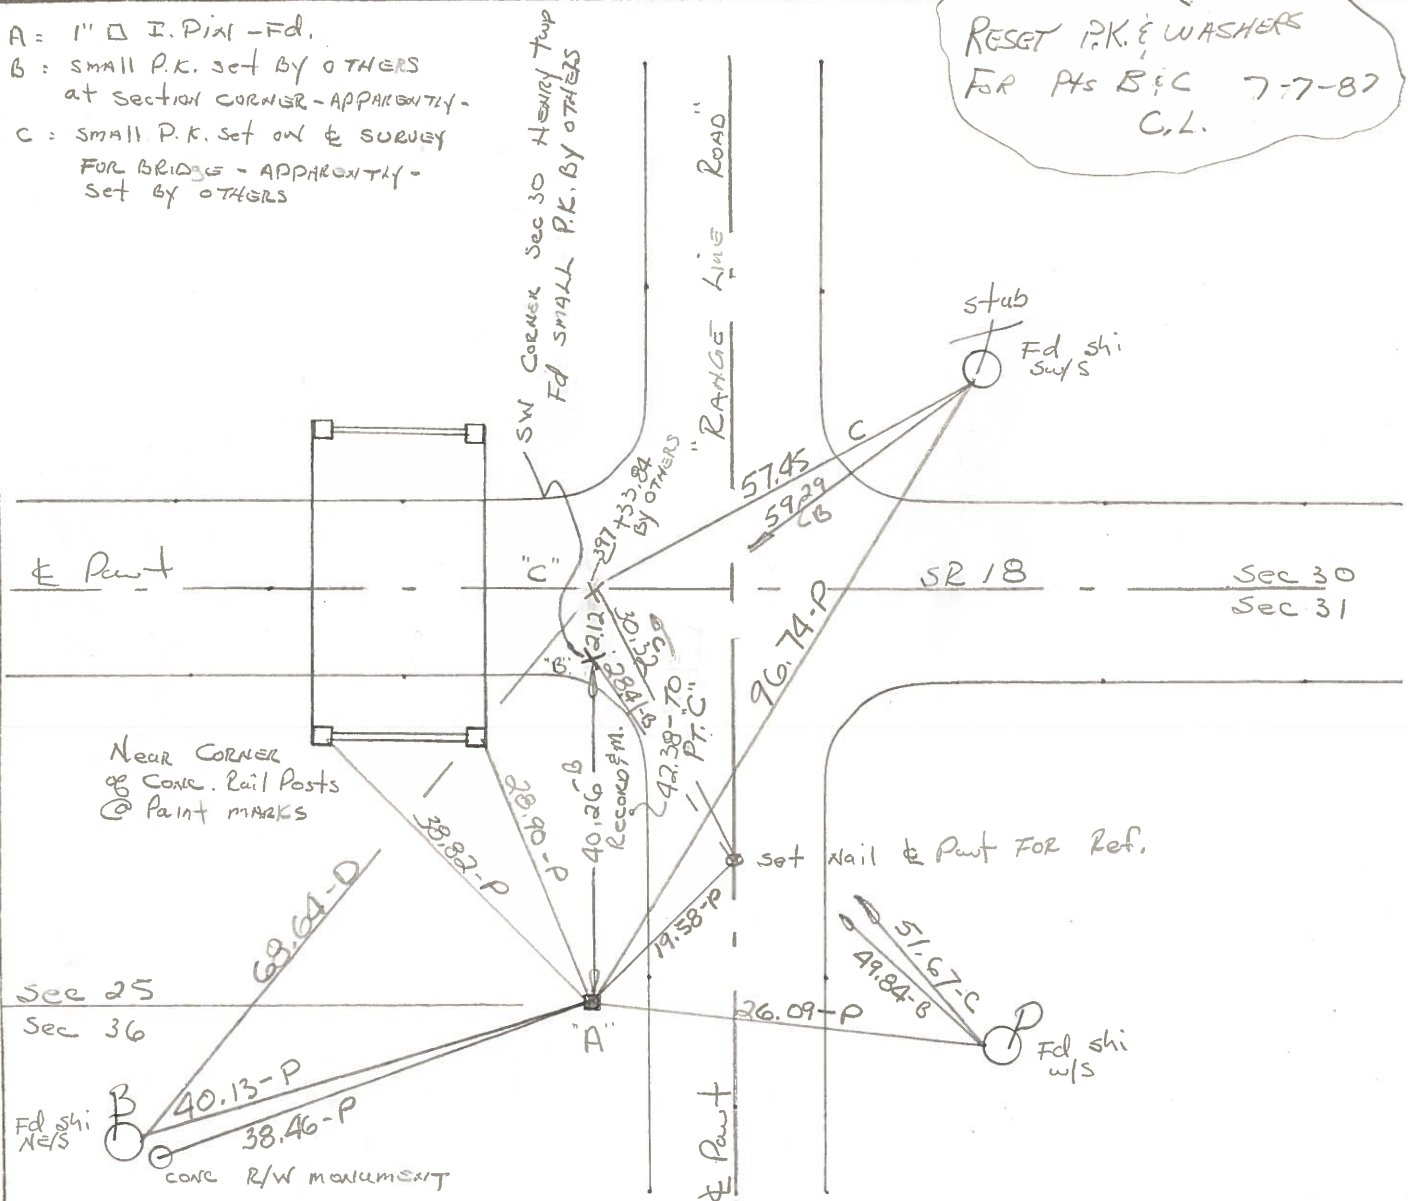


County Wood S.R. 18Township JacksonSection 25T 3 N, R 9 EPersonnel HoffmanHouseholderLoehrke

#17 - #18

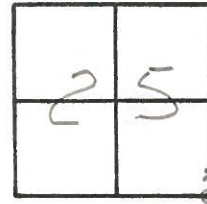Date 7-13-82Weather clearTemp. +70°Fd 1" $\square$ IRON PIN, 6" Below surface12.0' W of $\perp$ Pavt Co. Rd.

2.5' W of W.E.P. Co. Rd

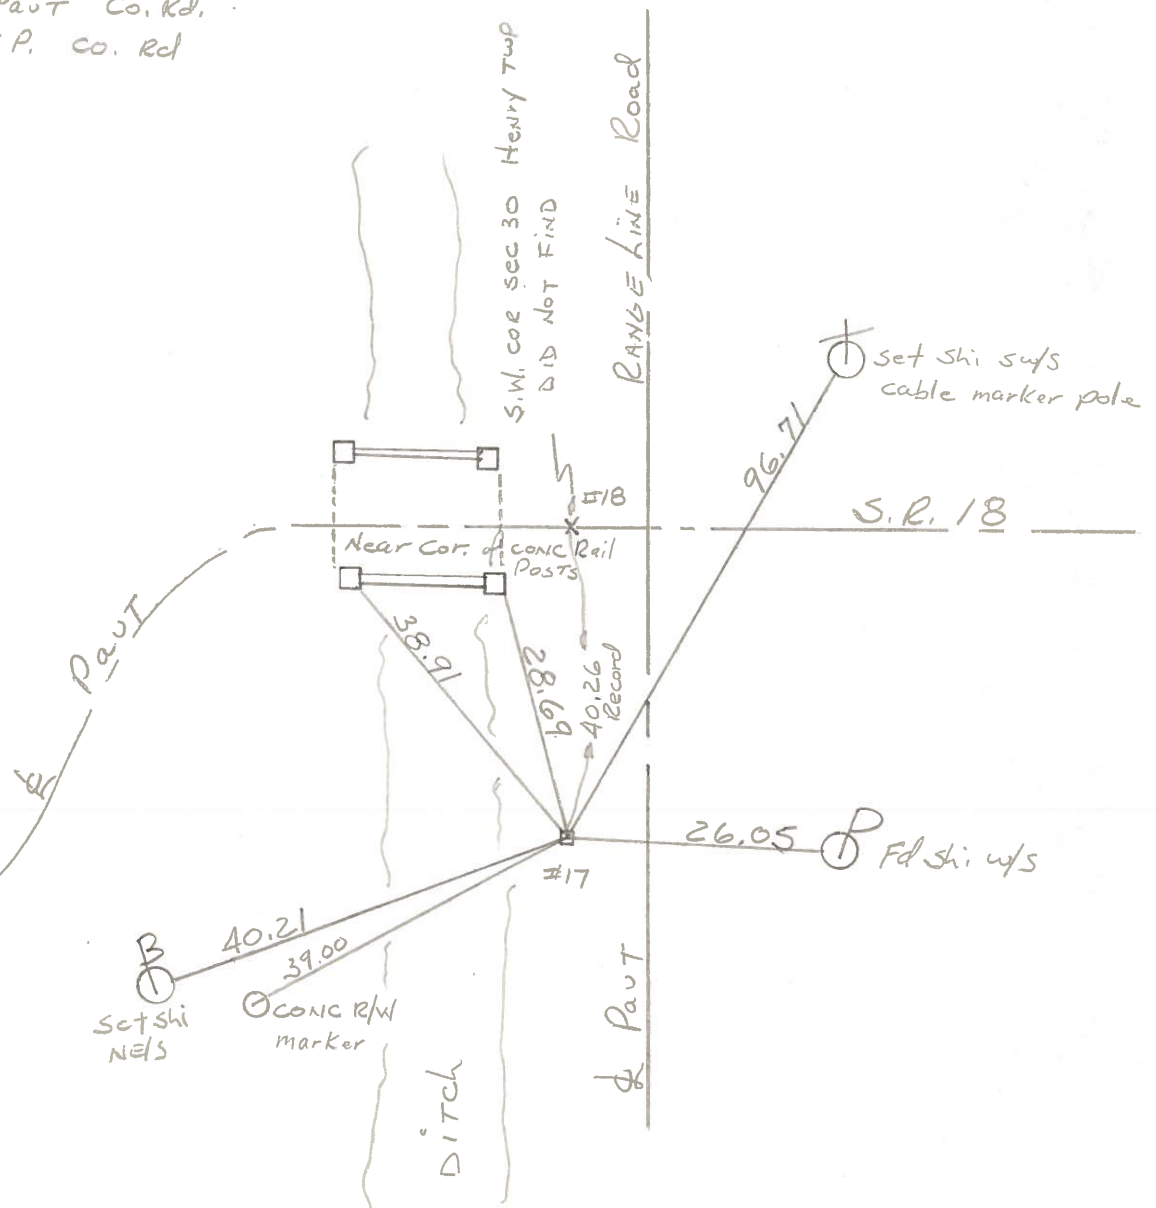


County WOOD S.R. 18Date 6-18-71Township JACKSON - HENRY

Weather _____

Section 25

Temp. _____

T3N, R9E

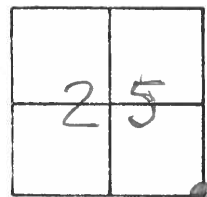Personnel BURNSIDESMITHBOWERSHOLCOMBEROCCHINI

17 - #18

