

O.D.O.T. DISTRICT 2 SURVEY OFFICE (USE ONLY)

PERSONNEL

REFERENCE NO. 18

SHEET 5 OF 52

NOTES ASTON

DATE 5/23/24

ROUTE SR 18

H.C. NIESE

WEATHER WINDY

COUNTY WOOD

R.C. PRESTON-COLVIN

TEMP. 80°F

TOWNSHIP HENRY

SECTION 30

DWG BY BARRIERE PID 101290

T 3 N R 10 E

TYPE MONUMENT MAG/WASHER

ON SURFACE - BELOW ON

OFFSET $\varnothing$ PAVEMENT LT : RT

 TO EDGE PAVEMENT

STATION: 422+75.33

HORZ.DATUM: WOOD LDP


GEOID: 18

GRID: NORTHING: 554903.637


EASTING: 1622933.535

LDP: NORTHING: 376357.677

EASTING: 135001.421

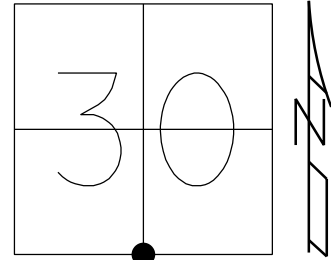

RECORD:
 SET P.K./WASHER
 7/7/87, CL
 FD P.K.NAIL
 6/16/10, BG
 7/28/11, MC
 SET MAG/WASHER
 1/25/12, SAH
 FD MAG/WASHER
 REF18
 6/15/20, JFO
 4/30/21, JFO
 1/21/22, TDN
 8-10-23, TDN
 REF18
 5/22/24, TDN
 10/25/24, TDN

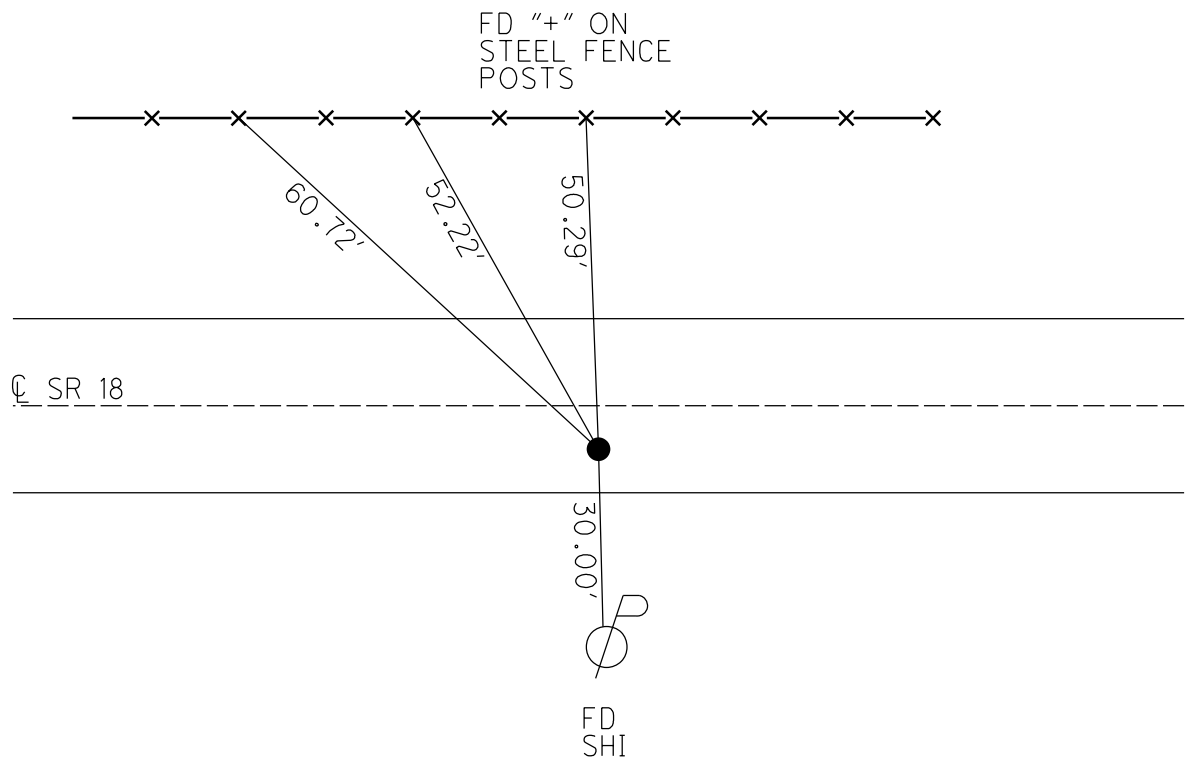

O.D.O.T. DISTRICT 2 SURVEY OFFICE (USE ONLY)

PERSONNEL

REFERENCE NO. 18

SHEET 13 OF 52

NOTES RHOADES

DATE 4/30/21

ROUTE SR 18

H.C. O'DONNELL

WEATHER CLOUDY

COUNTY WOOD

R.C. RHOADES

TEMP. 48°

TOWNSHIP HENRY

SECTION 30

DWG BY NIESE

PID PAVETRAIN

T 3 N R 10 E

TYPE MONUMENT MAG/WASHER

ON SURFACE - ~~BELOW~~ ON

OFFSET CL PAVEMENT 6.4' ~~LT~~ : RT

3.2' TO RT EDGE PAVEMENT


STATION: 422+75.33

HORZ.DATUM: NAD83(2011)

GEOID: NAVD88 2012A

GRID: NORTHING: 554903.637

EASTING: 1622933.535

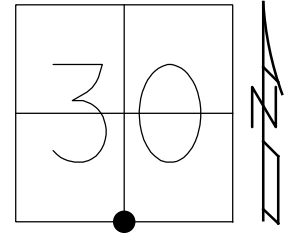

RECORD:

SET P.K./WASHER

7/7/87, CL

FD P.K.NAIL

6/16/10, BG

7/28/11, MC

SET MAG/WASHER

1/25/12, SAH

FD MAG/WASHER

REF18


6/15/20, JFO

4/30/21, JFO

1/21/22, TDN

8-10-23, TDN

FD "+" ON
STEEL FENCE
POSTS

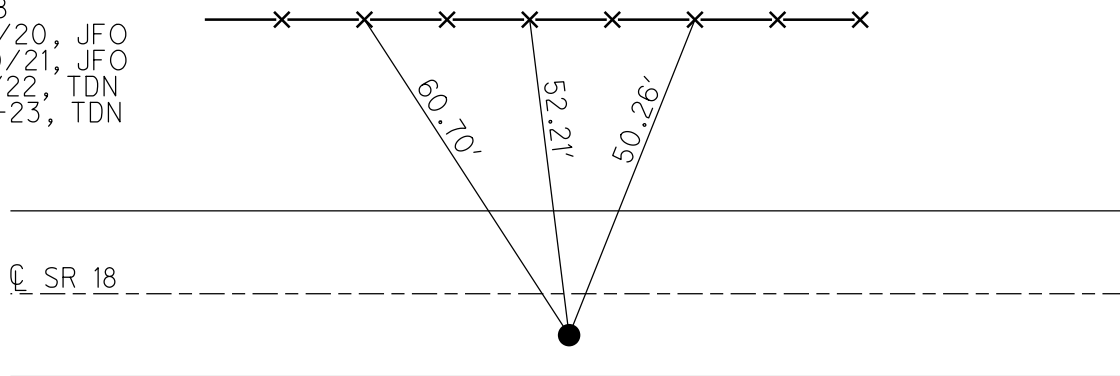

O.D.O.T. DISTRICT 2 SURVEY OFFICE (USE ONLY)

PERSONNEL

REFERENCE NO. 18

SHEET 13 OF 52

NOTES RHOADES

DATE 4/30/21

ROUTE SR 18

H.C. O'DONNELL

WEATHER CLOUDY

COUNTY WOOD

R.C. RHOADES

TEMP. 48°

TOWNSHIP HENRY

SECTION 30

DWG BY NIESE PID PAVETRAIN

T 3 N R 10 E

TYPE MONUMENT MAG/WASHER

ON SURFACE - ~~BELOW~~ ON

OFFSET CL PAVEMENT 6.4' ~~LT~~ : RT

3.2' TO RT EDGE PAVEMENT


STATION: 422+75.33

HORIZ.DATUM: NAD83(2011)


GEOID: NAVD88 2012A

GRID: NORTHING: 554903.637

EASTING: 1622933.535

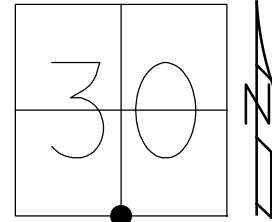

RECORD:
SET P.K./WASHER
7/7/87, CL
FD P.K.NAIL
6/16/10, BG
7/28/11, MC
SET MAG/WASHER
1/25/12, SAH
FD MAG/WASHER
REF18
6/15/20, JFO
4/30/21, JFO
1/21/22, TDN


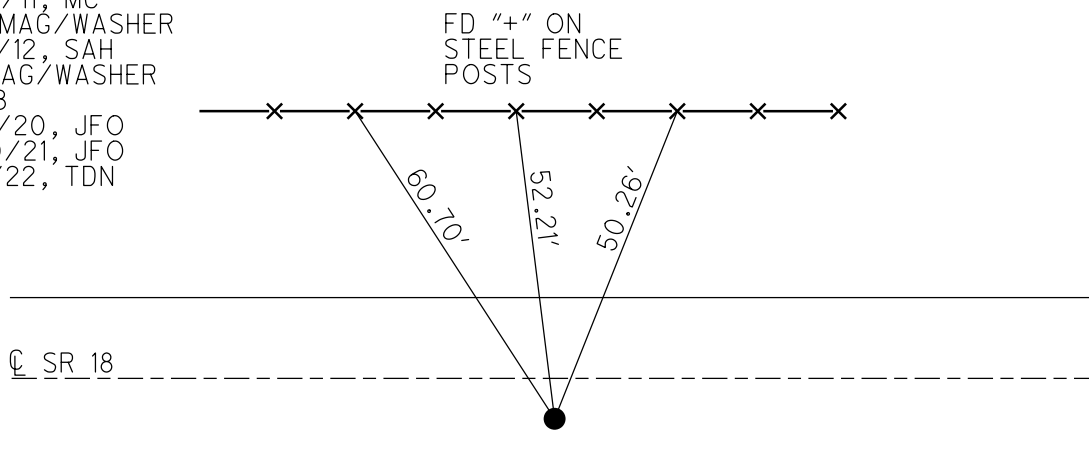


O.D.O.T. DISTRICT 2 SURVEY OFFICE (USE ONLY)

PERSONNEL _____ REFERENCE NO. 18 SHEET 13 OF 26
 NOTES CANTERBURY DATE 7/28/11 ROUTE SR 18
 H.C. CANTERBURY WEATHER CLEAR COUNTY WOOD
 R.C. HARBAUGH TEMP. 85° TOWNSHIP HENRY
 _____ SECTION 30
 _____ T 3 N R 10 E

TYPE MONUMENT P.K./NAIL
 ON SURFACE - ~~BELOW~~ ON
~~LEFT~~ - CL PAV'T - RIGHT 6.4'
3.2' TO RT EDGE PAVEMENT
 S.L.M. 422+75.33

Grid: Northing: 554903.725 Easting: 1622933.635

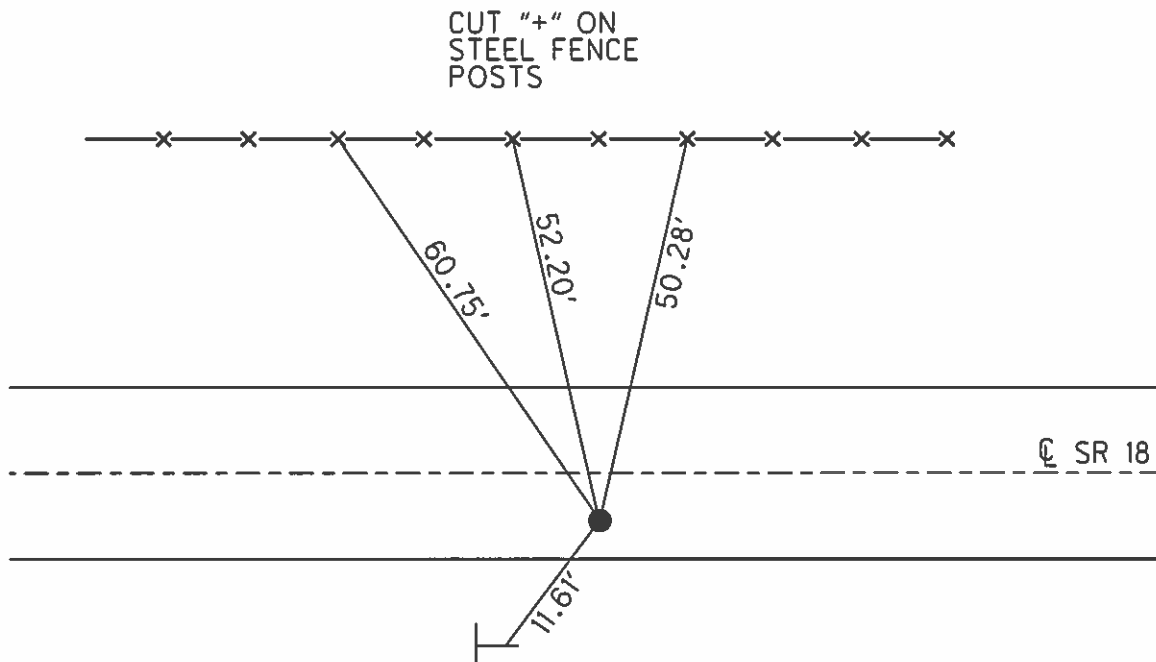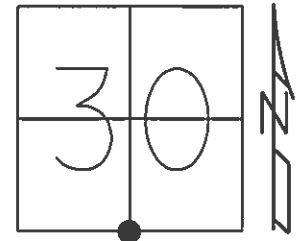

ORIGIN UNKNOWN
 APPARENT 1/4 COR.

SET P.K./WASHER
 7/7/87, CL

FD P.K.NAIL
 6/15/10
 GPS, SV18
 6/16/10, BG

SET MAG/WASHER
 1/25/12, SAH

CUT NOTCH
 2.5' UP
 SIGN POST
 8 MM

O.D.O.T. DISTRICT 2 SURVEY OFFICE

PERSONNEL

REFERENCE NO. 18

SHEET 4 OF

NOTES HOFFMAN

H.C. LOSHRKE

R.C. BARANISCH

Sackman

DATE 6-17-87

WEATHER Clear

TEMP. 80°

ROUTE SR 18

COUNTY Wood

TOWNSHIP HENRY

SECTION 30

T. 3 N. R 10 E


TYPE MONUMENT P.K. Nail

ON SURFACE - ~~BELOW~~ YES

LEFT - ~~C~~ PAV'T. - RIGHT S.G.

3A TO RT EDGE PAVEMENT

S.L.M. 423 + 68

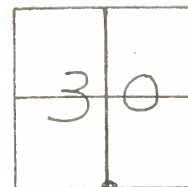

ORIGINAL UNKNOWN ON P.K.
APPARENT $\frac{1}{4}$ CORNER

STA 424 + 01.06 BY OTHERS FOR BRIDGE SURVEY

SET P.K. / WASHER

7-7-87 C.L.

