

O.D.O.T. DISTRICT 2 SURVEY OFFICE (USE ONLY)

PERSONNEL

REFERENCE NO. 20

SHEET 5 OF 52

NOTES ASTON DATE 5/23/24
H.C. NIESE WEATHER WINDY
R.C. PRESTON-COLVIN TEMP. 80°F

ROUTE SR 18
COUNTY WOOD
TOWNSHIP HENRY
SECTION 30
T 3 N R 10 E

DWG BY BARRIERE PID 101290

TYPE MONUMENT MAG/WASHER

ON SURFACE - BELOW ON

OFFSET $\varnothing$ PAVEMENT LT : RT

 TO EDGE PAVEMENT

STATION: 449+14.34

HORIZ.DATUM: WOOD LDP


GEOID: 18

GRID: NORTHING: 554858.899


EASTING: 1625572.341

LDP: NORTHING: 376347.720

EASTING: 137640.799

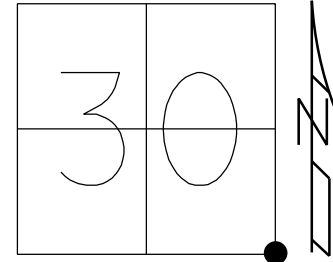

RECORD:
SET P.K./WASHER
7/7/87, CL
FD P.K. SHANK
6/16/10, BG
FD SM.R.R.SPIKE
0.2' DOWN
7/28/11, MC
SET MAG/WASHER
1/25/12, SAH
FD MAG/WASHER
REF20
6/15/20, JFO
4/30/21, JFO
1/21/22, TDN
8-10-23, TDN
REF20
5/22/24, TDN
10/25/24, TDN

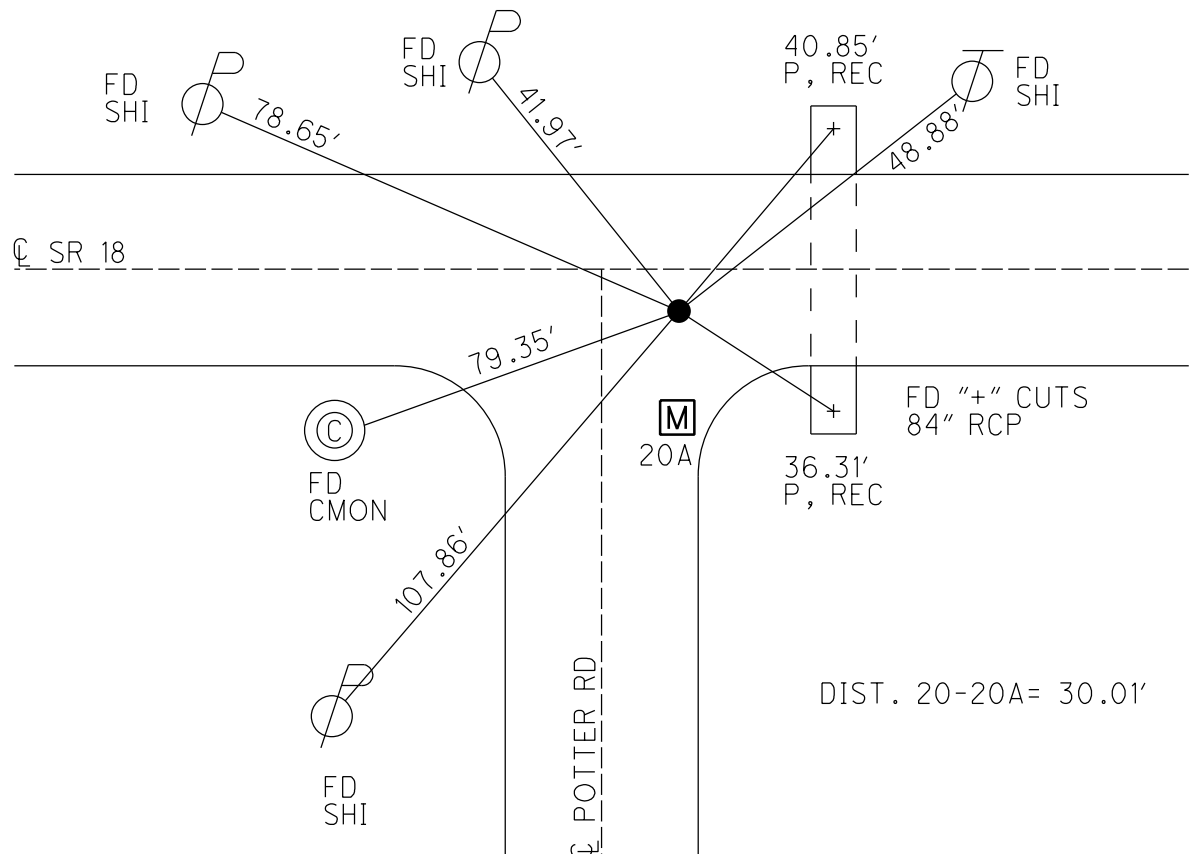

O.D.O.T. DISTRICT 2 SURVEY OFFICE (USE ONLY)

PERSONNEL

REFERENCE NO. 20

SHEET 14 OF 52

NOTES RHOADES

DATE 4/30/21

ROUTE SR 18

H.C. O'DONNELL

WEATHER CLOUDY

COUNTY WOOD

R.C. RHOADES

TEMP. 48°

TOWNSHIP HENRY

SECTION 30

DWG BY NIESE PID PAVETRAIN

T 3 N R 10 E

TYPE MONUMENT MAG/WASHER

ON SURFACE - ~~BELOW~~ ON

OFFSET CL PAVEMENT 4.2' ~~LT~~ : RT

- TO - EDGE PAVEMENT



STATION: 449+14.34

HORIZ.DATUM: NAD83(2011)

GEOID: NAVD88 2012A

GRID: NORTHING: 554858.899

EASTING: 1625572.341

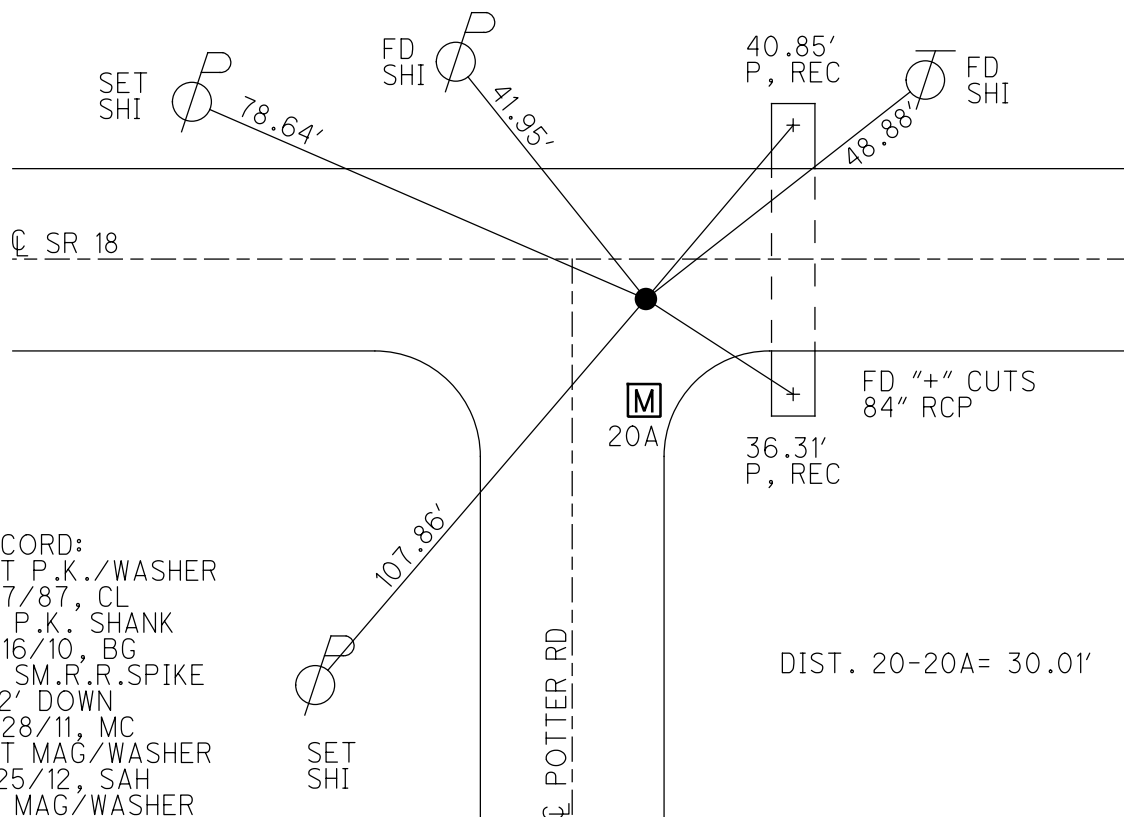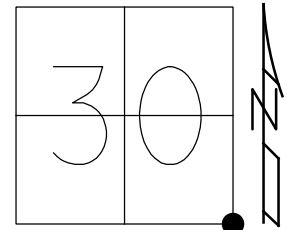

RECORD:
SET P.K./WASHER
7/7/87, CL
FD P.K. SHANK
6/16/10, BG
FD SM.R.R.SPIKE
0.2' DOWN
7/28/11, MC
SET MAG/WASHER
1/25/12, SAH
FD MAG/WASHER
REF20
6/15/20, JFO
4/30/21, JFO
1/21/22, TDN
8-10-23, TDN

DIST. 20-20A= 30.01'

O.D.O.T. DISTRICT 2 SURVEY OFFICE (USE ONLY)

PERSONNEL

REFERENCE NO. 20

SHEET 14 OF 52

NOTES RHOADES

DATE 4/30/21

ROUTE SR 18

H.C. O'DONNELL

WEATHER CLOUDY

COUNTY WOOD

R.C. RHOADES

TEMP. 48°

TOWNSHIP HENRY

SECTION 30

DWG BY NIESE

PID PAVETRAIN

T 3 N R 10 E

TYPE MONUMENT MAG/WASHER

ON SURFACE - ~~BELOW~~ ON

OFFSET CL PAVEMENT 4.2' ~~LT~~ : RT

- TO - EDGE PAVEMENT



STATION: 449+14.34

HORZ.DATUM: NAD83(2011)

GEOID: NAVD88 2012A

GRID: NORTHING: 554858.899

EASTING: 1625572.341

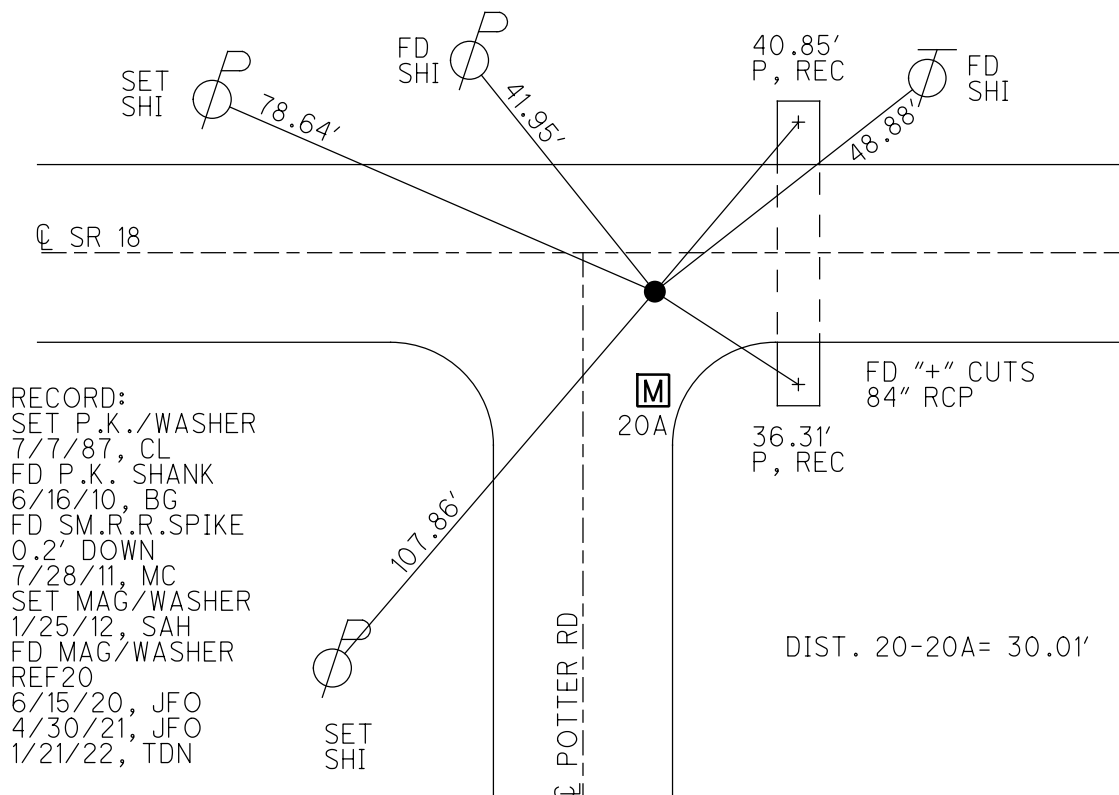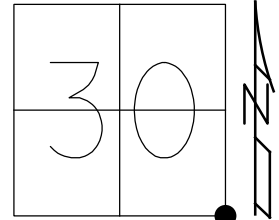

O.D.O.T. DISTRICT 2 SURVEY OFFICE (USE ONLY)

PERSONNEL _____ REFERENCE NO. 20 SHEET 14 OF 26

NOTES CANTERBURY DATE 7/28/11 ROUTE SR 18

H.C. CANTERBURY WEATHER CLEAR COUNTY WOOD

R.C. HARBAUGH TEMP. 85° TOWNSHIP HENRY

SECTION 30

T 3 N R 10 E

TYPE MONUMENT SM.R.R.SPIKE


~~ON SURFACE~~ - BELOW 0.2'

~~LEFT~~ - CL PAV'T - RIGHT 4.2'

- TO - EDGE PAVEMENT

S.L.M. 449+14.34


Grid: Northing: 554858.936 Easting: 1625572.263

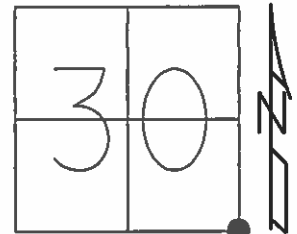

SET P.K./WASHER
7/7/87, CL

FD P.K.SHANK
6/15/10
GPS, SV20
6/16/10, BG

SET MAG/WASHER
1/25/12, SAH

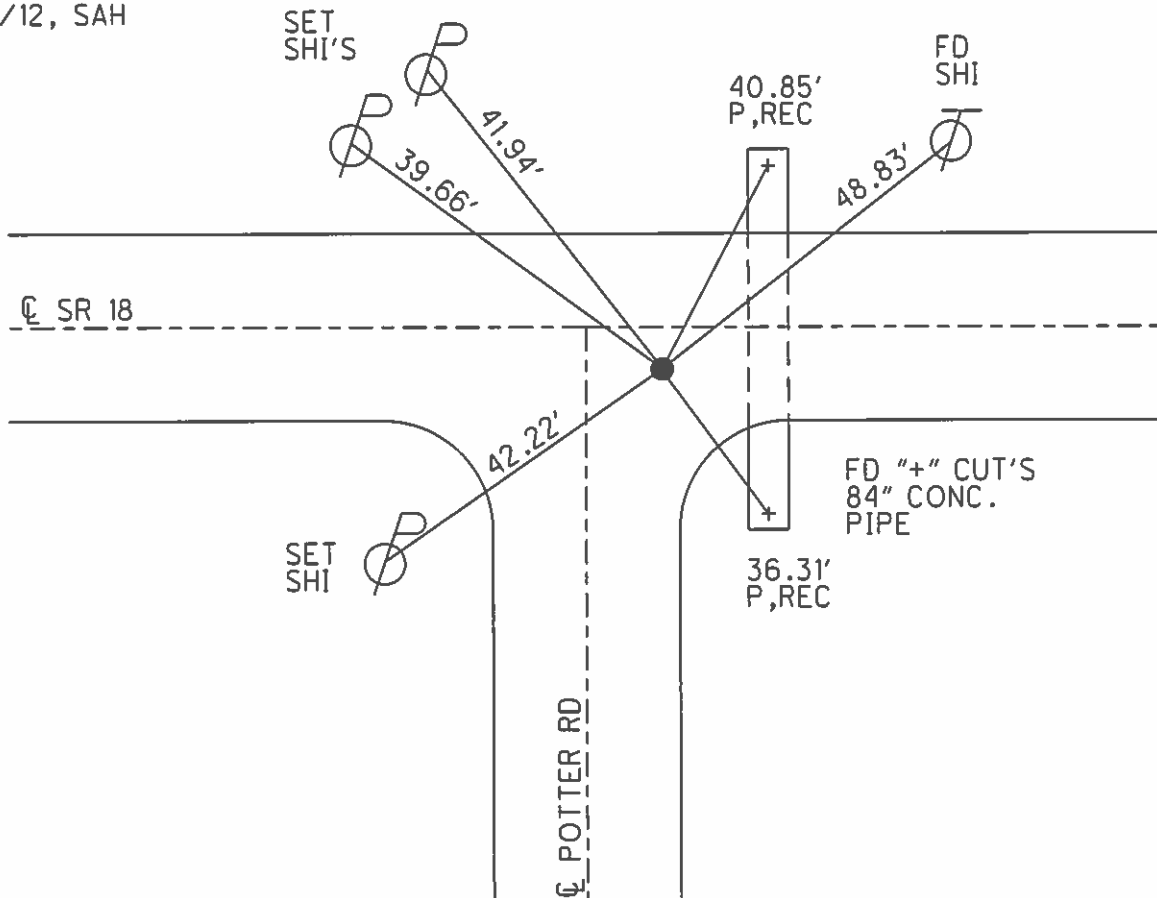

O.D.O.T. DISTRICT 2 SURVEY OFFICE

PERSONNEL

REFERENCE NO. 20

SHEET 5 OF

NOTES HOFFMAN

H.C. LOSHRKE

R.C. BARNHISEL

SOCKMAN

DATE 6-17-87

WEATHER Clear

TEMP. 80°

ROUTE SR 18

COUNTY Wood

TOWNSHIP Henry

SECTION 31

T3 N R 10 E


TYPE MONUMENT SMALL RR SPIKE

ON SURFACE - BELOW YES


LEFT - C. PAV'T. - RIGHT 4.0'

TO EDGE PAVEMENT 7' EAST of Pavt South

S.L.M. 450+07

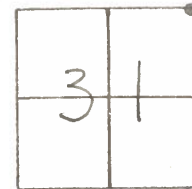

SET P.K. / WASHER
 7-7-87
 C.L.

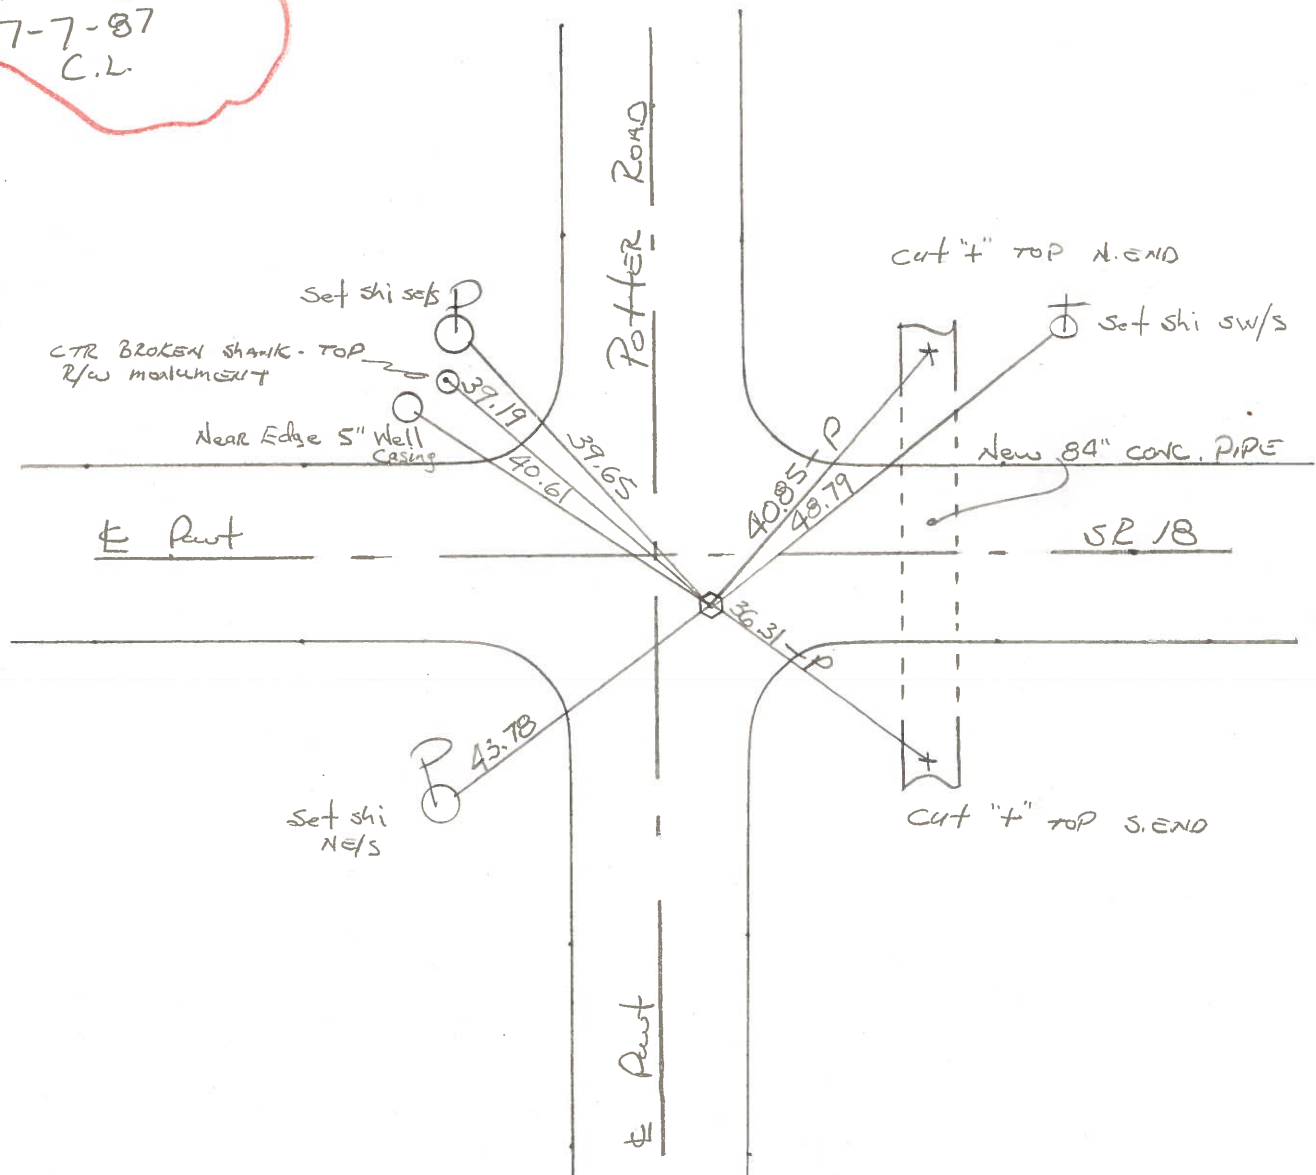

O.D.O.T. DISTRICT 2 SURVEY OFFICE

Sht. 1 of 22
S.R. 18

County Wood

Township HENRY

Section 31

T3N, R10E

Personnel BURNSIDE

SMITH

BOWERS


KNAPE

MEAD

Date 6-15-78


Weather CLEARING

Temp. +63°

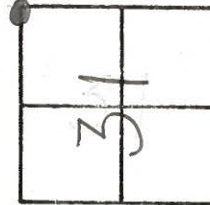

20

N.E. COR. SEC. 31.
 HENRY TWP
 T-3-N R. 10-E
 WOOD CO.

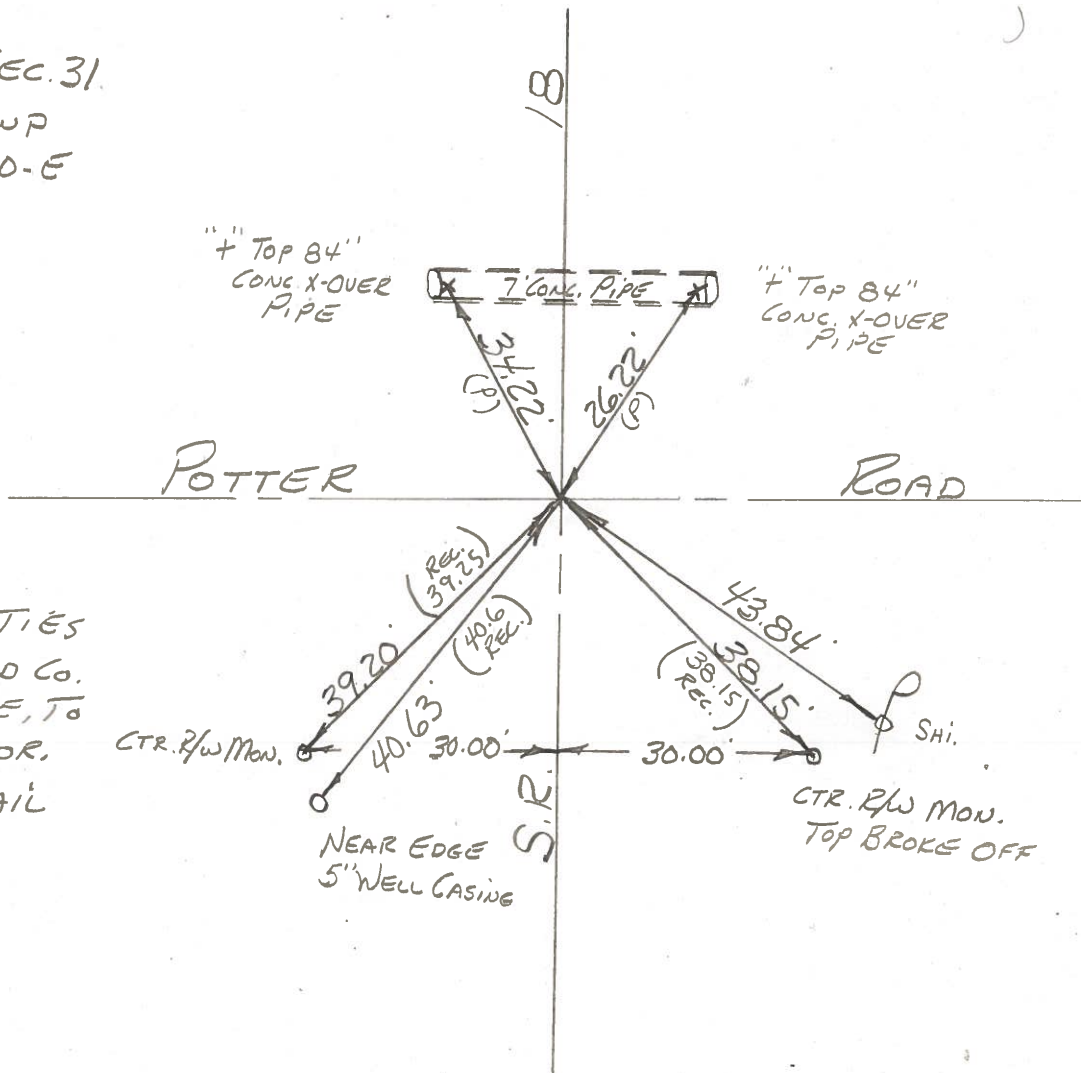

USED REC. TIES
 FD. IN WOOD CO.
 COURT HOUSE, TO
 EST. SEC. COR.
 SET P.K. NAIL

CTR. R/W MON.

NEAR EDGE
 5' WELL CASING

CTR. R/W MON.
 TOP BROKE OFF

SHI.