

O.D.O.T. DISTRICT 2 SURVEY OFFICE (USE ONLY)

PERSONNEL

REFERENCE NO. 21

SHEET 5 OF 52

NOTES ASTON DATE 5/23/24
H.C. NIESE WEATHER WINDY
R.C. PRESTON-COLVIN TEMP. 80°F

ROUTE SR 18
COUNTY WOOD
TOWNSHIP HENRY
SECTION 29
T 3 N R 10 E

DWG BY BARRIERE PID 101290

TYPE MONUMENT MAG NAIL/WASHER

ON SURFACE - BELOW ON

OFFSET Q PAVEMENT LT : RT

TO EDGE PAVEMENT

STATION: 474+27.68

HORIZ.DATUM: WOOD LDP


GEOID: 18

GRID: NORTHING: 554816.369


EASTING: 1628085.260

LDP: NORTHING: 376338.314

EASTING: 140154.3

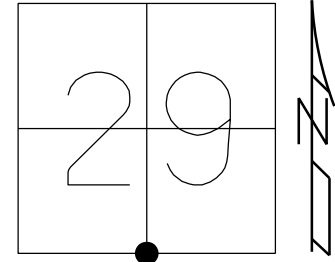

RECORD:
SET P.K./WASHER
7/7/87, CL
FD P.K. SHANK
6/16/10, BG
7/28/11, MC
SET MAG/WASHER
1/25/12, SAH
FD MAG/WASHER
REF21
6/15/20, JFO
5/5/21, JFO
1/21/22, TDN
SET MAG/WASHER
8-10-23, TDN
FD MAG/WASHER
REF21
5/23/24, TDN
10/25/24, TDN

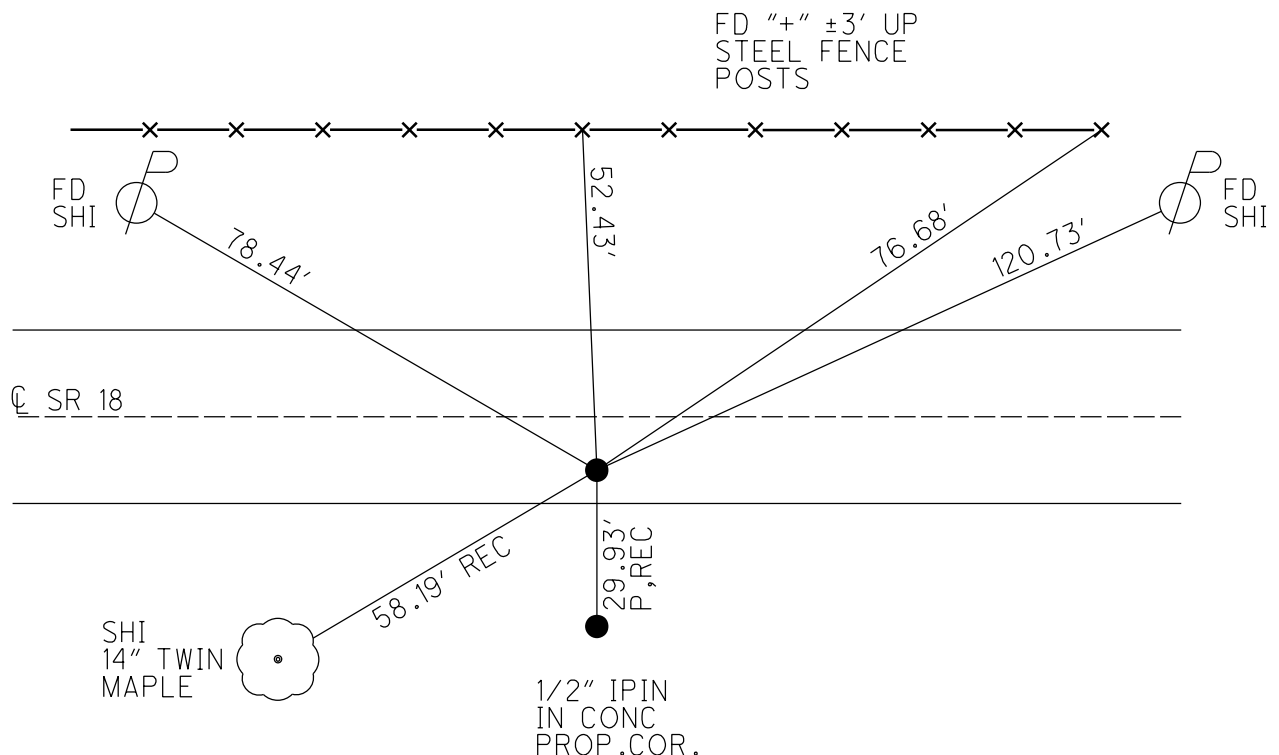

O.D.O.T. DISTRICT 2 SURVEY OFFICE (USE ONLY)

PERSONNEL

REFERENCE NO. 21

SHEET 16 OF 52

NOTES AUBLE

DATE 5/5/21

ROUTE SR 18

H.C. NIESE

WEATHER CLOUDY

COUNTY WOOD

R.C. O'DONNELL

TEMP. 46°

TOWNSHIP HENRY

SECTION 29

DWG BY NIESE PID PAVETRAIN

T 3 N R 10 E

TYPE MONUMENT MAG/WASHER

ON SURFACE - ~~BELOW~~ ON

OFFSET CL PAVEMENT 7.5' ~~LT~~ : RT

2.0' TO RT EDGE PAVEMENT


STATION: 474+27.68

HORZ.DATUM: NAD83(2011)

GEOID: NAVD88 2012A

GRID: NORTHING: 554816.369

EASTING: 1628085.260

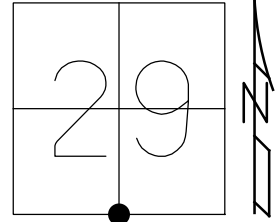

RECORD:

SET P.K./WASHER

7/7/87, CL

FD P.K. SHANK

6/16/10, BG

7/28/11, MC

SET MAG/WASHER

1/25/12, SAH


FD MAG/WASHER

REF21

6/15/20, JFO

5/5/21, JFO

1/21/22, TDN

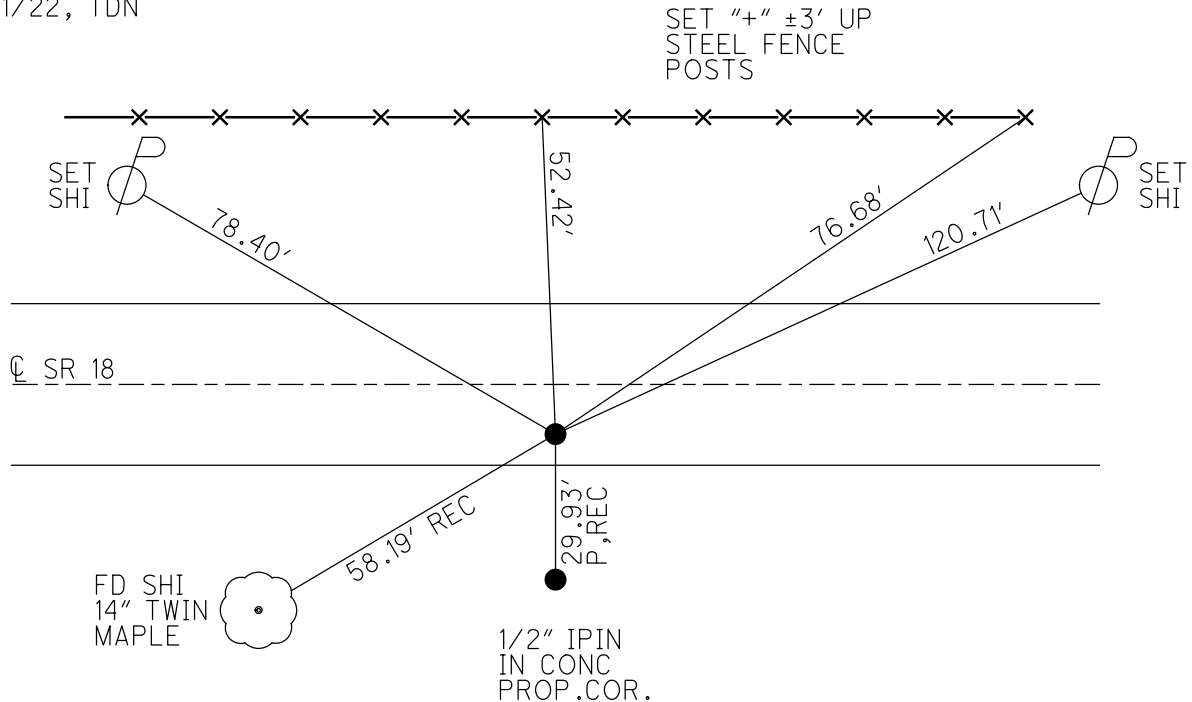

O.D.O.T. DISTRICT 2 SURVEY OFFICE (USE ONLY)

PERSONNEL	REFERENCE NO. <u>21</u>	SHEET <u>15</u> OF <u>26</u>
NOTES <u>CANTERBURY</u>	DATE <u>7/28/11</u>	ROUTE <u>SR 18</u>
H.C. <u>CANTERBURY</u>	WEATHER <u>CLEAR</u>	COUNTY <u>WOOD</u>
R.C. <u>HARBAUGH</u>	TEMP. <u>85°</u>	TOWNSHIP <u>HENRY</u>
		SECTION <u>32</u>
		T <u>3</u> N R <u>10</u> E

TYPE MONUMENT P.K.SHANK


~~ON SURFACE~~ - BELOW 0.25'

~~LEFT~~ - CL PAV'T - RIGHT 7.5'

2.0' TO RT EDGE PAVEMENT

S.L.M. 474+27.68

Grid: Northing: 554816.301 Easting: 1628085.245

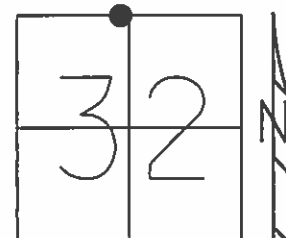


SET P.K./WASHER
7/7/87, CL

FD P.K.SHANK
6/15/10
GPS, SV21
6/16/10, BG

SET MAG/WASHER
1/25/12, SAH

SET "+" ±3' UP
STEEL FENCE
POSTS

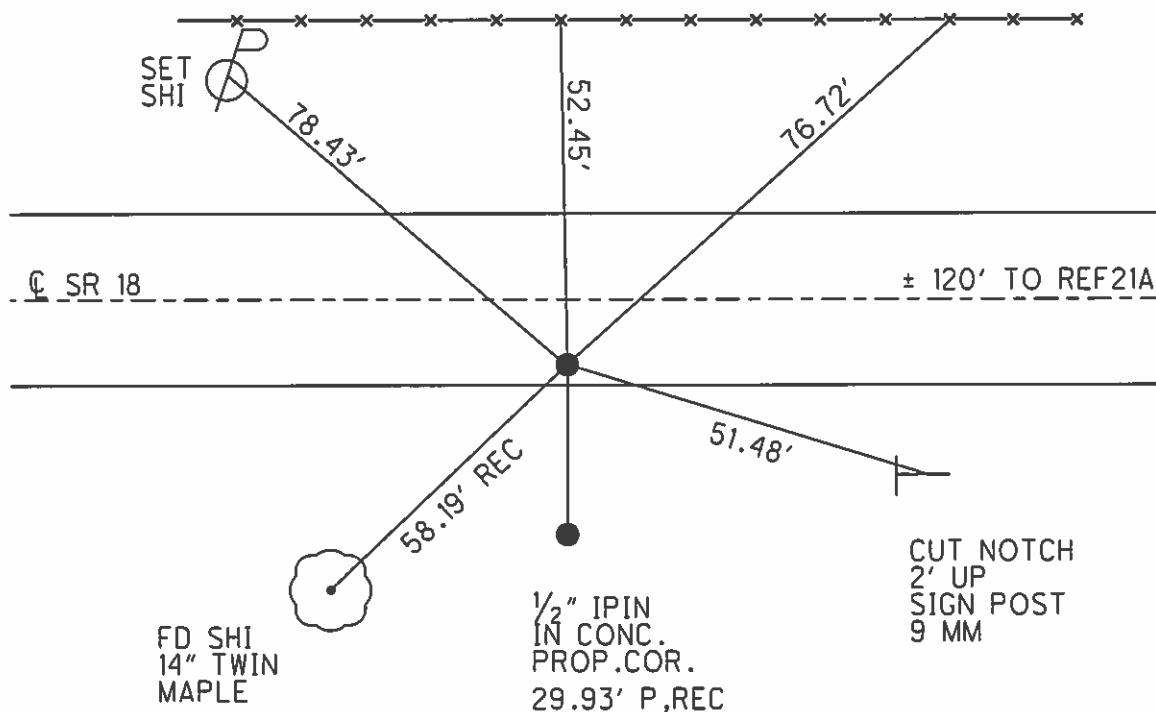

O.D.O.T. DISTRICT 2 SURVEY OFFICE

PERSONNEL

REFERENCE NO. 21

SHEET 6 OF

NOTES HOFFMAN

H.C. LOEHRKE

R.C. BARNHISCH

SOCKMAN

DATE 6-17-87

WEATHER CLEAR

TEMP. 80°

ROUTE SR 18

COUNTY WOOD

TOWNSHIP HENRY

SECTION 32

T3 NR 10 E


TYPE MONUMENT PK Nail

ON SURFACE -BELOW YES

LEFT - C PAV'T. - RIGHT 6.8

1.7 TO RT EDGE PAVEMENT

S.L.M. 475 + 19

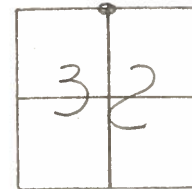

ORIGINAL of PK UNKNOWN
APPARENT N $\frac{1}{4}$ CORNER
Section 32

Set PK/WASHER
7-7-87
C.L.

E. Part

SR 18

