

O.D.O.T. DISTRICT 2 SURVEY OFFICE (USE ONLY)

PERSONNEL

REFERENCE NO. 21 A

SHEET 5 OF 52

NOTES ASTON

DATE 5/23/24

ROUTE SR 18

H.C. NIESE

WEATHER WINDY

COUNTY WOOD

R.C. PRESTON-COLVIN

TEMP. 80°F

TOWNSHIP HENRY

SECTION 29

DWG BY BARRIERE

PID 101290

T 3 N R 10 E

TYPE MONUMENT MAG NAIL/WASHER

ON SURFACE - BELOW ON

OFFSET $\varnothing$ PAVEMENT _____ LT : RT

_____ TO _____ EDGE PAVEMENT

STATION: 475+27

HORZ.DATUM: WOOD LDP


GEOID: 18

GRID: NORTHING: 554816.442


EASTING: 1628204.518

LDP: NORTHING: 376339.923

EASTING: 140273.537

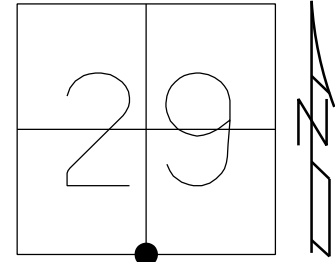

RECORD:
 SET MAG NAIL
 7/7/87, MB
 FD MAG NAIL
 7/28/11, MC
 SET MAG/WASHER
 1/31/12, SAH
 FD MAG/WASHER
 REFA21
 6/15/20, JFO
 5/5/21, JFO
 1/21/21, TDN
 8-10-23, TDN
 REF21A
 5/23/24, TDN
 10/25/24, TDN

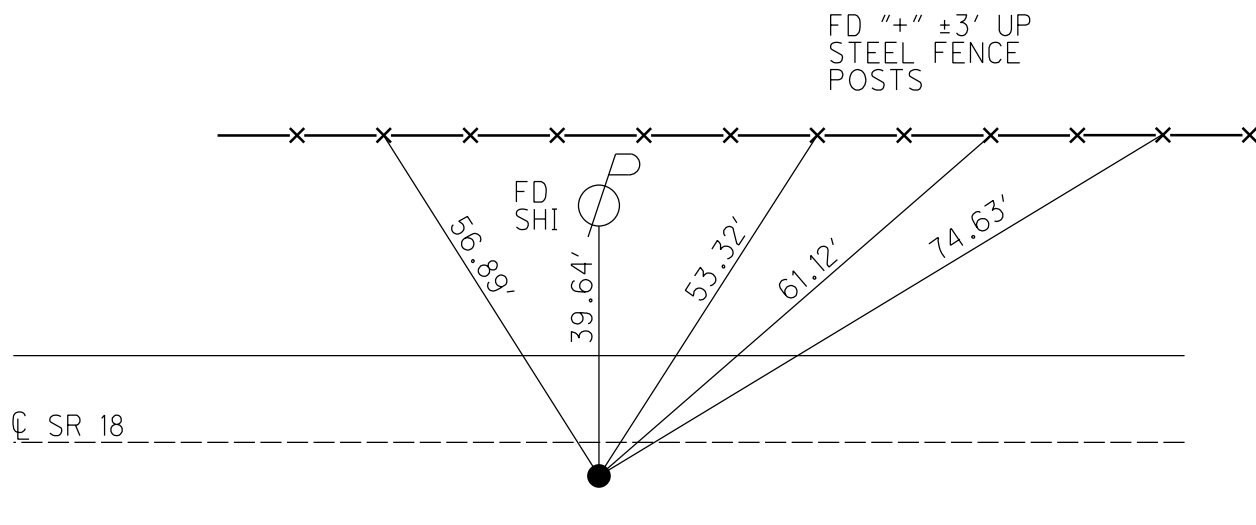

O.D.O.T. DISTRICT 2 SURVEY OFFICE (USE ONLY)

PERSONNEL

REFERENCE NO. 21 A

SHEET 17 OF 52

NOTES AUBLE

DATE 5/5/21

ROUTE SR 18

H.C. NIESE

WEATHER CLOUDY

COUNTY WOOD

R.C. O'DONNELL

TEMP. 46°

TOWNSHIP HENRY

SECTION 29

DWG BY NIESE PID PAVETRAIN

T 3 N R 10 E

TYPE MONUMENT MAG/WASHER

ON SURFACE - ~~BELOW~~ ON

OFFSET CL PAVEMENT 5.6' LT : RT

3.5' TO RT EDGE PAVEMENT


STATION: 475+27

HORZ.DATUM: NAD83(2011)

GEOID: NAVD88 2012A


GRID: NORTHING: 554816.442

EASTING: 1628204.518

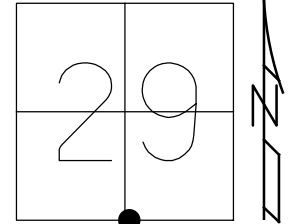

RECORD:
SET MAG NAIL
7/7/87, MB
FD MAG NAIL
7/28/11, MC
SET MAG/WASHER
1/31/12, SAH
FD MAG/WASHER
REFA21
6/15/20, JFO
5/5/21, JFO
1/21/21, TDN
8-10-23, TDN

FD "+" ±3' UP
STEEL FENCE
POSTS

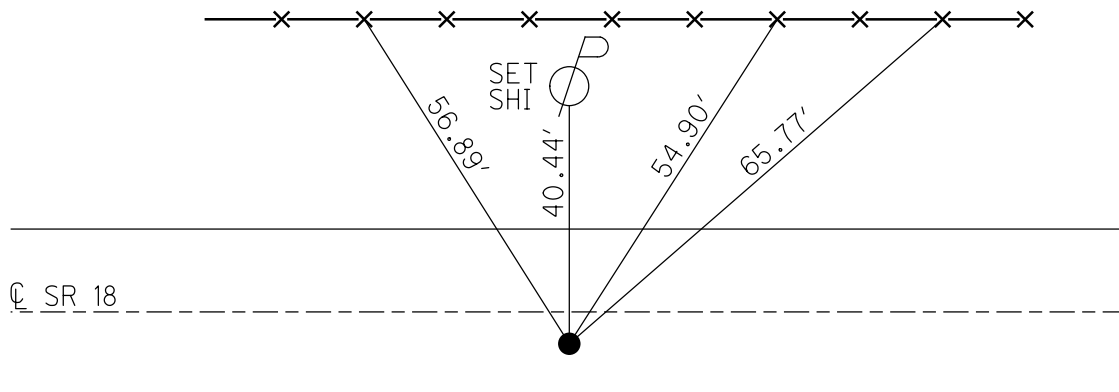

O.D.O.T. DISTRICT 2 SURVEY OFFICE (USE ONLY)

PERSONNEL

REFERENCE NO. 21 A

SHEET 17 OF 52

NOTES AUBLE

DATE 5/5/21

ROUTE SR 18

H.C. NIESE

WEATHER CLOUDY

COUNTY WOOD

R.C. O'DONNELL

TEMP. 46°

TOWNSHIP HENRY

SECTION 29

DWG BY NIESE PID PAVETRAIN

T 3 N R 10 E

TYPE MONUMENT MAG/WASHER

ON SURFACE - ~~BELOW~~ ON

OFFSET CL PAVEMENT 5.6' ~~LT~~ : RT

3.5' TO RT EDGE PAVEMENT


STATION: 475+27

HORZ.DATUM: NAD83(2011)

GEOID: NAVD88 2012A


GRID: NORTHING: 554816.442

EASTING: 1628204.518

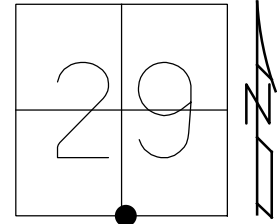

RECORD:
SET MAG NAIL
7/7/87, MB
FD MAG NAIL
7/28/11, MC
SET MAG/WASHER
1/31/12, SAH
FD MAG/WASHER
REFA21
6/15/20, JFO
5/5/21, JFO
1/21/21, TDN

FD "+" ±3' UP
STEEL FENCE
POSTS


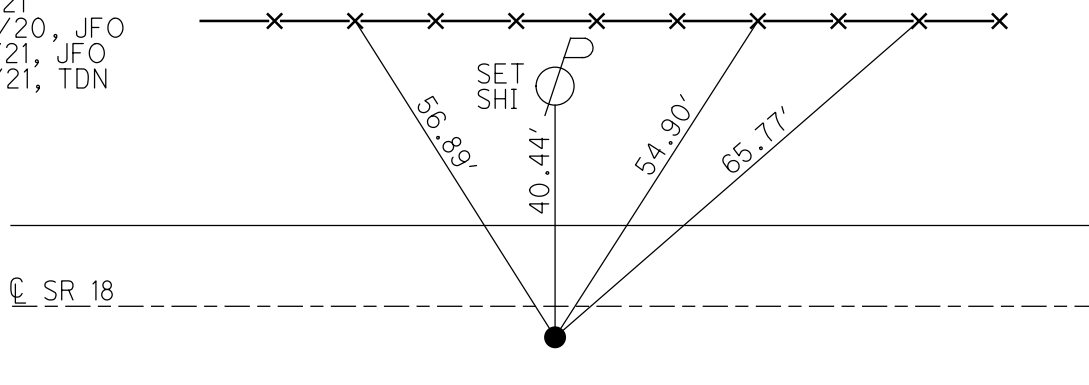


O.D.O.T. DISTRICT 2 SURVEY OFFICE (USE ONLY)

PERSONNEL _____ REFERENCE NO. 21 A SHEET 16 OF 26
 NOTES CANTERBURY DATE 7/28/11 ROUTE SR 18
 H.C. CANTERBURY WEATHER SUNNY COUNTY WOOD
 R.C. HARBAUGH TEMP. 85° TOWNSHIP HENRY
 _____ SECTION 32
 _____ T 3 N R 10 E

TYPE MONUMENT MAG NAIL
 ON SURFACE - ~~BELOW~~ ON
~~LEFT~~ - CL PAV'T - RIGHT 5.6'
3.5' TO RT EDGE PAVEMENT
 S.L.M. 475+27

Grid: Northing: 554816.416 Easting: 1628204.499

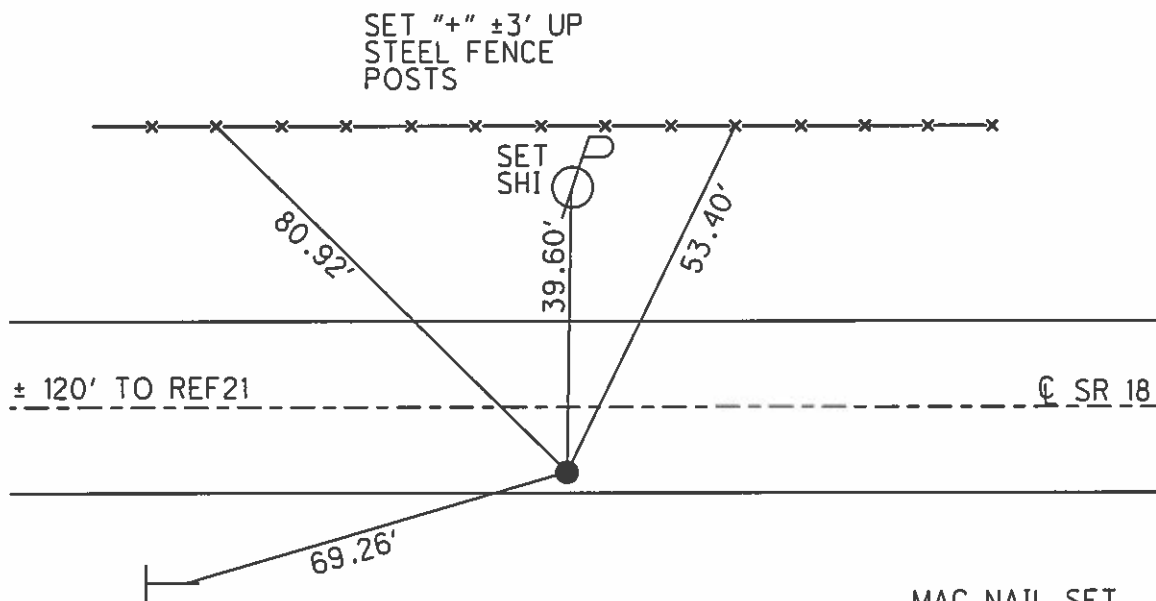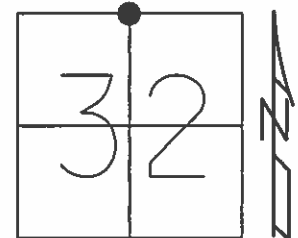

CUT NOTCH
 2' UP
 SIGN POST
 9 MM

MAG NAIL SET
 7/7/87, MB

FD MAG NAIL
 AT SURFACE
 GPS, SVA21
 7/28/11, MC

SET MAG/WASHER
 1/30/12
 GPS, REFA21
 1/31/12, SAH