

O.D.O.T. DISTRICT 2 SURVEY OFFICE (USE ONLY)

PERSONNEL

REFERENCE NO. 22

SHEET 5 OF 52

NOTES ASTON DATE 5/23/24
H.C. NIESE WEATHER SUNNY
R.C. PRESTON-COLVIN TEMP. 80°F

ROUTE SR 18
COUNTY WOOD
TOWNSHIP HENRY
SECTION 29
T 3 N R 10 E

DWG BY BARRIERE PID 101290

TYPE MONUMENT MAG NAIL/WASHER

ON SURFACE - BELOW ON

OFFSET $\odot$ PAVEMENT LT : RT


 TO EDGE PAVEMENT

STATION: 501+87.7


HORIZ.DATUM: WOOD LDP GEOID: 18

GRID: NORTHING: 554808.585 EASTING: 1630845.172

LDP: NORTHING: 376366.932 EASTING: 142914.349

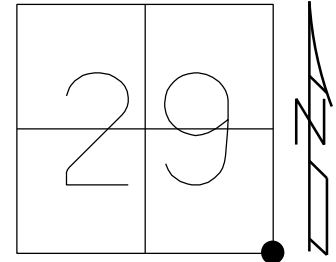

RECORD:
SET P.K./WASHER
7/7/87, CL
FD MAG NAIL
6/3/11, MC
SET MAG/WASHER
1/31/12, SAH
FD MAG/WASHER
REF22
6/15/20, JFO
SET MAG/WASHER
5/5/21, JFO
FD MAG/WASHER
1/21/21, TDN
8-10-23, TDN
REF22
5/23/24, TDN
10/25/24, TDN

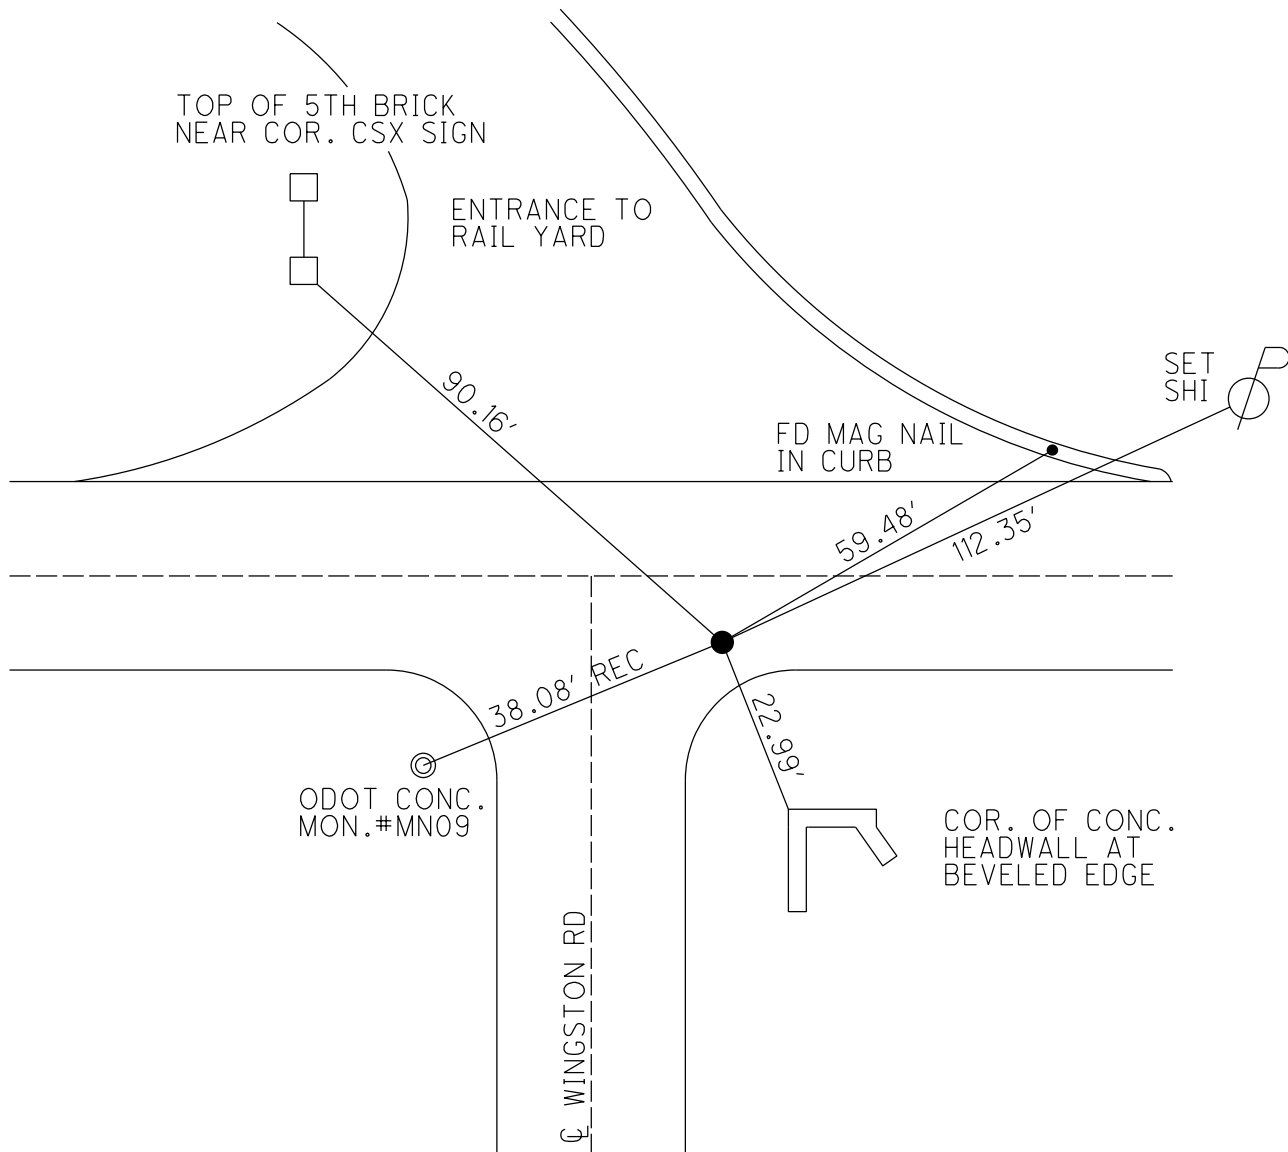

O.D.O.T. DISTRICT 2 SURVEY OFFICE (USE ONLY)

PERSONNEL

REFERENCE NO. 22

SHEET 18 OF 52

NOTES AUBLE

DATE 5/5/21

ROUTE SR 18

H.C. NIESE

WEATHER CLOUDY

COUNTY WOOD

R.C. O'DONNELL

TEMP. 46°

TOWNSHIP HENRY

SECTION 32

DWG BY NIESE PID PAVETRAIN

T 3 N R 10 E

TYPE MONUMENT MAG/WASHER

ON SURFACE - ~~BELOW~~ ON

OFFSET CL PAVEMENT 7.0' ~~LT~~ : RT

2.5' TO RT EDGE PAVEMENT 9.0' E. OF CL SOUTH


STATION: 501+87.70

HORIZ.DATUM: NAD83(2011)

GEOID: NAVD88 2012A

GRID: NORTHING: 554808.585

EASTING: 1630845.172

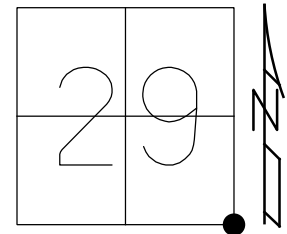

TOP OF 5TH BRICK
NEAR COR. CSX SIGN

ENTRANCE TO
RAIL YARD

90.11'

FD MAG NAIL
IN CURB

SET
SHI

59.43'

112.31'

38.08' REC

23.02'

RECORD:
SET P.K./WASHER
7/7/87, CL
FD MAG NAIL
6/3/11, MC
SET MAG/WASHER
1/31/12, SAH
FD MAG/WASHER
REF22
6/15/20, JFO
SET MAG/WASHER
5/5/21, JFO
FD MAG/WASHER
1/21/21, TDN
8-10-23, TDN

ODOT CONC.
MON.#MN09

CL WINGSTON RD

COR. OF CONC.
HEADWALL AT
BEVELED EDGE

O.D.O.T. DISTRICT 2 SURVEY OFFICE (USE ONLY)

PERSONNEL

REFERENCE NO. 22

SHEET 18 OF 52

NOTES AUBLE

DATE 5/5/21

ROUTE SR 18

H.C. NIESE

WEATHER CLOUDY

COUNTY WOOD

R.C. O'DONNELL

TEMP. 46°

TOWNSHIP HENRY

SECTION 32

DWG BY NIESE PID PAVETRAIN

T 3 N R 10 E

TYPE MONUMENT MAG/WASHER

ON SURFACE - ~~BELOW~~ ON

OFFSET CL PAVEMENT 7.0' ~~LT~~ : RT

2.5' TO RT EDGE PAVEMENT 9.0' E. OF CL SOUTH


STATION: 501+87.70

HORIZ.DATUM: NAD83(2011)

GEOID: NAVD88 2012A

GRID: NORTHING: 554808.585

EASTING: 1630845.172

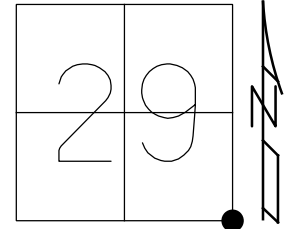

TOP OF 5TH BRICK
NEAR COR. CSX SIGN

ENTRANCE TO
RAIL YARD

SET
SHI


FD MAG NAIL
IN CURB

RECORD:
SET P.K./WASHER
7/7/87, CL
FD MAG NAIL
6/3/11, MC
SET MAG/WASHER
1/31/12, SAH
FD MAG/WASHER
REF22
6/15/20, JFO
SET MAG/WASHER
5/5/21, JFO
FD MAG/WASHER
1/21/21, TDN

ODOT CONC.
MON.#MN09

COR. OF CONC.
HEADWALL AT
BEVELED EDGE

CL WINGSTON RD

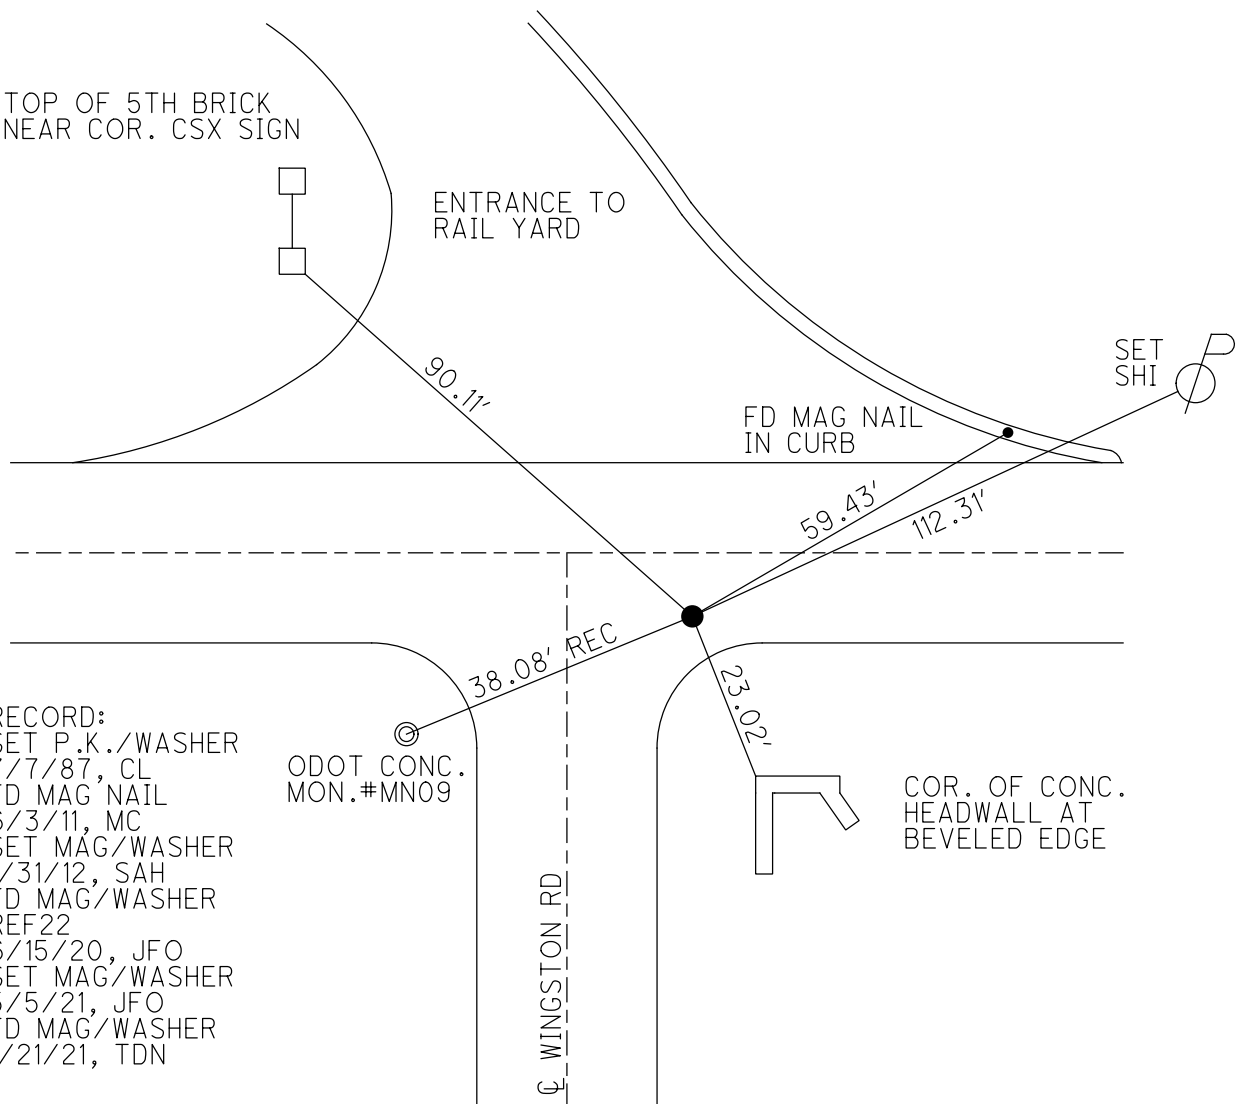

O.D.O.T. DISTRICT 2 SURVEY OFFICE (USE ONLY)

PERSONNEL _____ REFERENCE NO. 22 SHEET 17 OF 26
 NOTES CANTERBURY DATE 6/3/11 ROUTE SR 18
 H.C. HUSS WEATHER FAIR COUNTY WOOD
 R.C. HARBAUGH TEMP. 65° TOWNSHIP HENRY
 _____ SECTION 32
 _____ T 3 N R 10 E


TYPE MONUMENT MAG NAIL

ON SURFACE - ~~BELOW~~ ON _____

~~LEFT~~ - CL PAV'T - RIGHT 7.0', 9' E. OF CL SOUTH
2.5' TO RT EDGE PAVEMENT

S.L.M. 501+87.7

Grid: Northing: 554808.586 Easting: 1630845.152

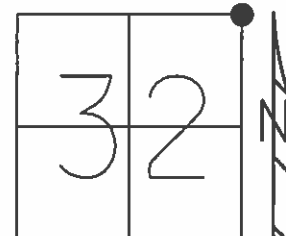

TOP OF 5TH BRICK
NEAR COR. CSX SIGN

ENTRANCE TO
RAIL YARD

CUT "+" ON
TOP CONC. CURB

90.11'

69.16'

CL SR 18

ODOT CONC.
MON. #MN09

38.08'

23.02'


SET P.K./WASHER
7/7/87, CL

FD MAG NAIL
AT SURFACE
GPS, SV22
6/3/10, MC

SET MAG/WASHER
1/30/12
GPS, REF22
1/31/12, SAH

CL WINGSTON RD

COR. OF CONC.
HEADWALL AT
BEVELED EDGE

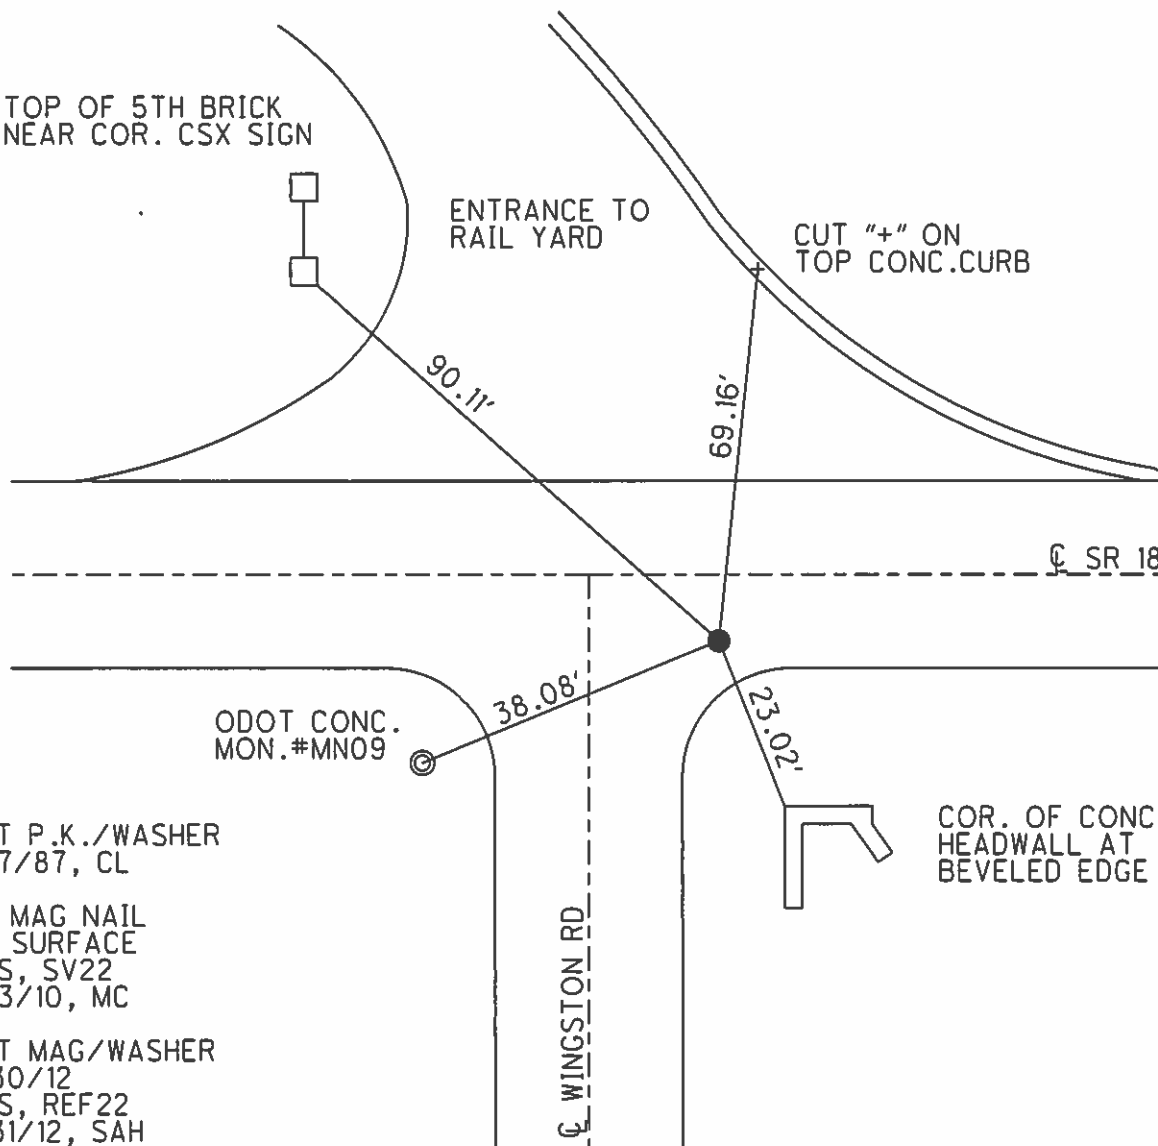

O.D.O.T. DISTRICT 2 SURVEY OFFICE

PERSONNEL

REFERENCE NO. 22

SHEET 7 OF

NOTES HOFFMAN

H.C. LOOHRKE

R.C. BARNHISEN

SOCKMAN

DATE 6-17-87

WEATHER CLEAR

TEMP. 80°

ROUTE SR 18

COUNTY WOOD

TOWNSHIP HENRY

SECTION 29

T.3 N R 10 E


TYPE MONUMENT SMALL RR SPIKE

ON SURFACE - ~~BELOW~~ YES


~~LEFT~~ & PAV'T. - RIGHT 6.8

TO EDGE PAVEMENT 9' EAST of & Pavt South

S.L.M. 502+79

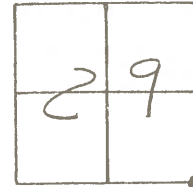

SET P.K./WASHER
7-7-87
C.L.

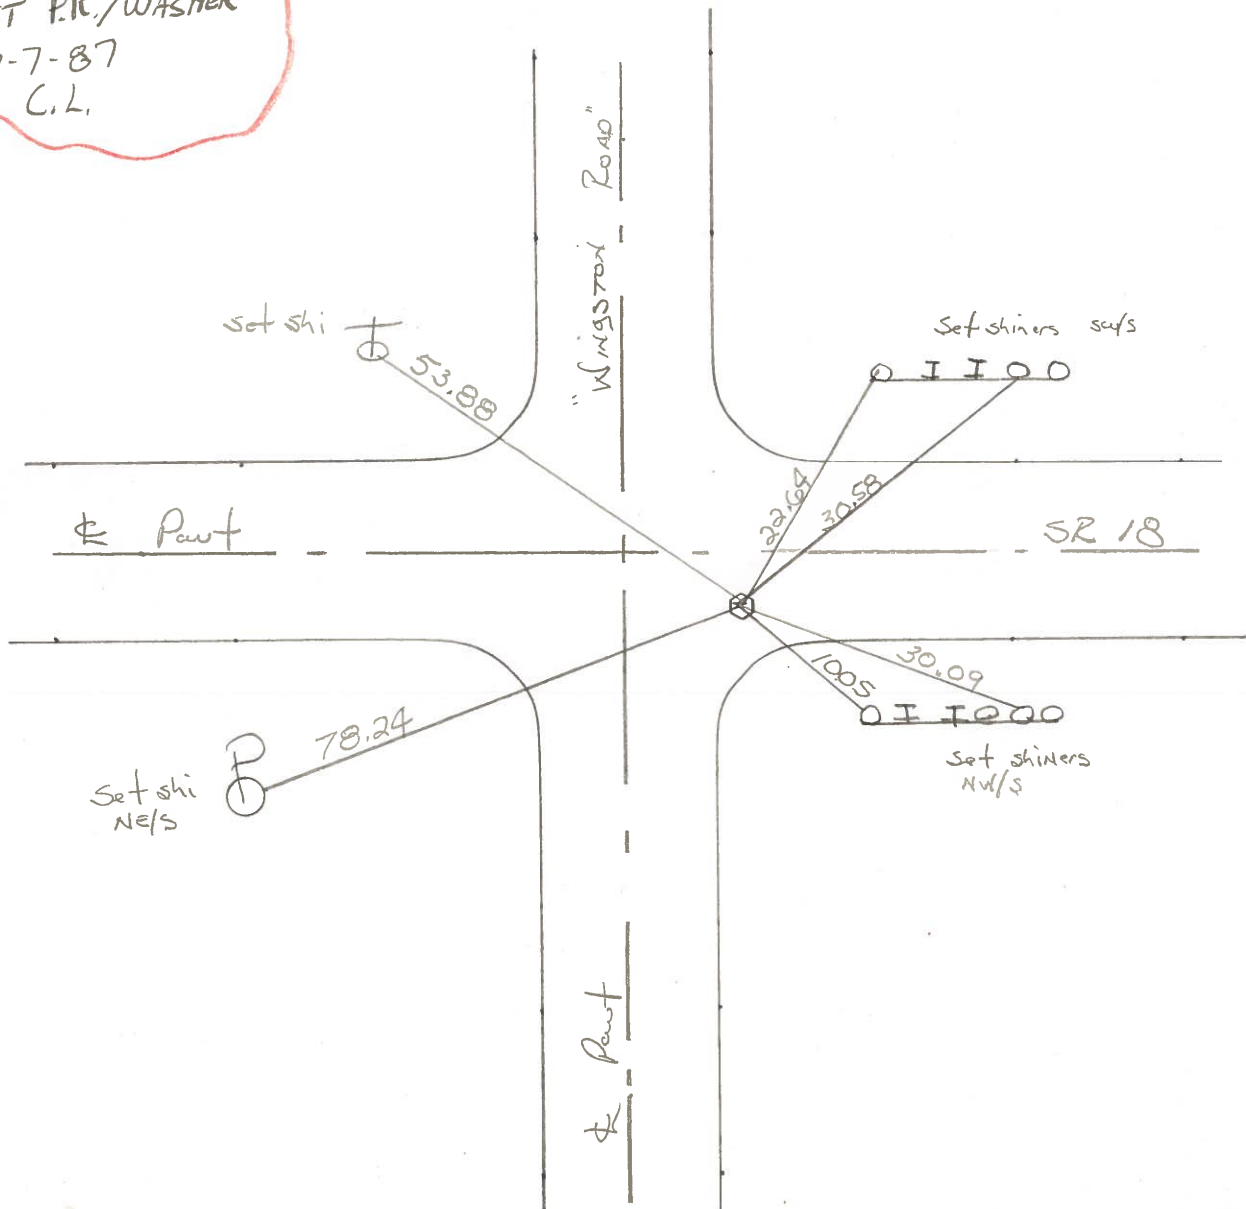

O.D.O.T. DISTRICT 2 SURVEY OFFICE

Sht. 2 of 22
S.R. 18

County WOOD

Date 6-15-78

Township HENRY



Weather PT CLOUDY

Section S.E. COR. SEC. 29


Temp. +60°

T3N, R1E

Personnel BURNSIDE
SMITH
BOWERS
KNAPE
MEAD

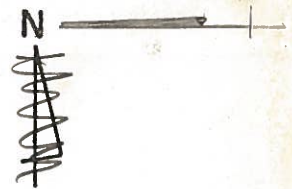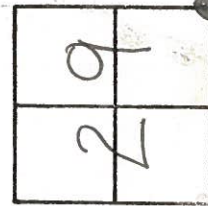

#22

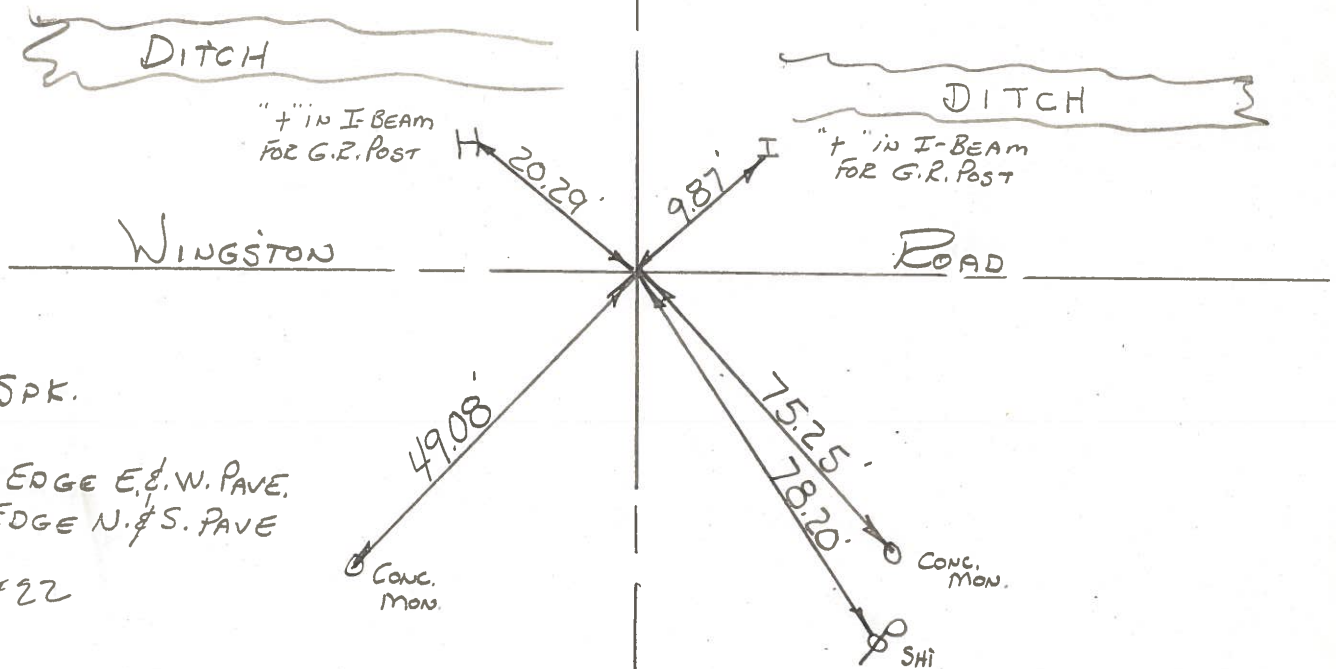


FD. R.R. SPK.

1' N. OF S. EDGE E. & W. PAVE.
 & ON E. EDGE N. & S. PAVE

#22

PERSONNEL	TITLE	PERSONNEL	TITLE	COUNTY	DATE
BURNSIDE		ROCCITINI		WOOD	6-21-71
SMITH				S. R. 18	WEATHER P. CLOUDY
BOWERS				SEC. 29 - WINSTON ED.	TEMP. +75°
HOLCOMBE					

DESCRIPTION _____			JOB NO. _____
	LEFT	CENTER LINE	RIGHT

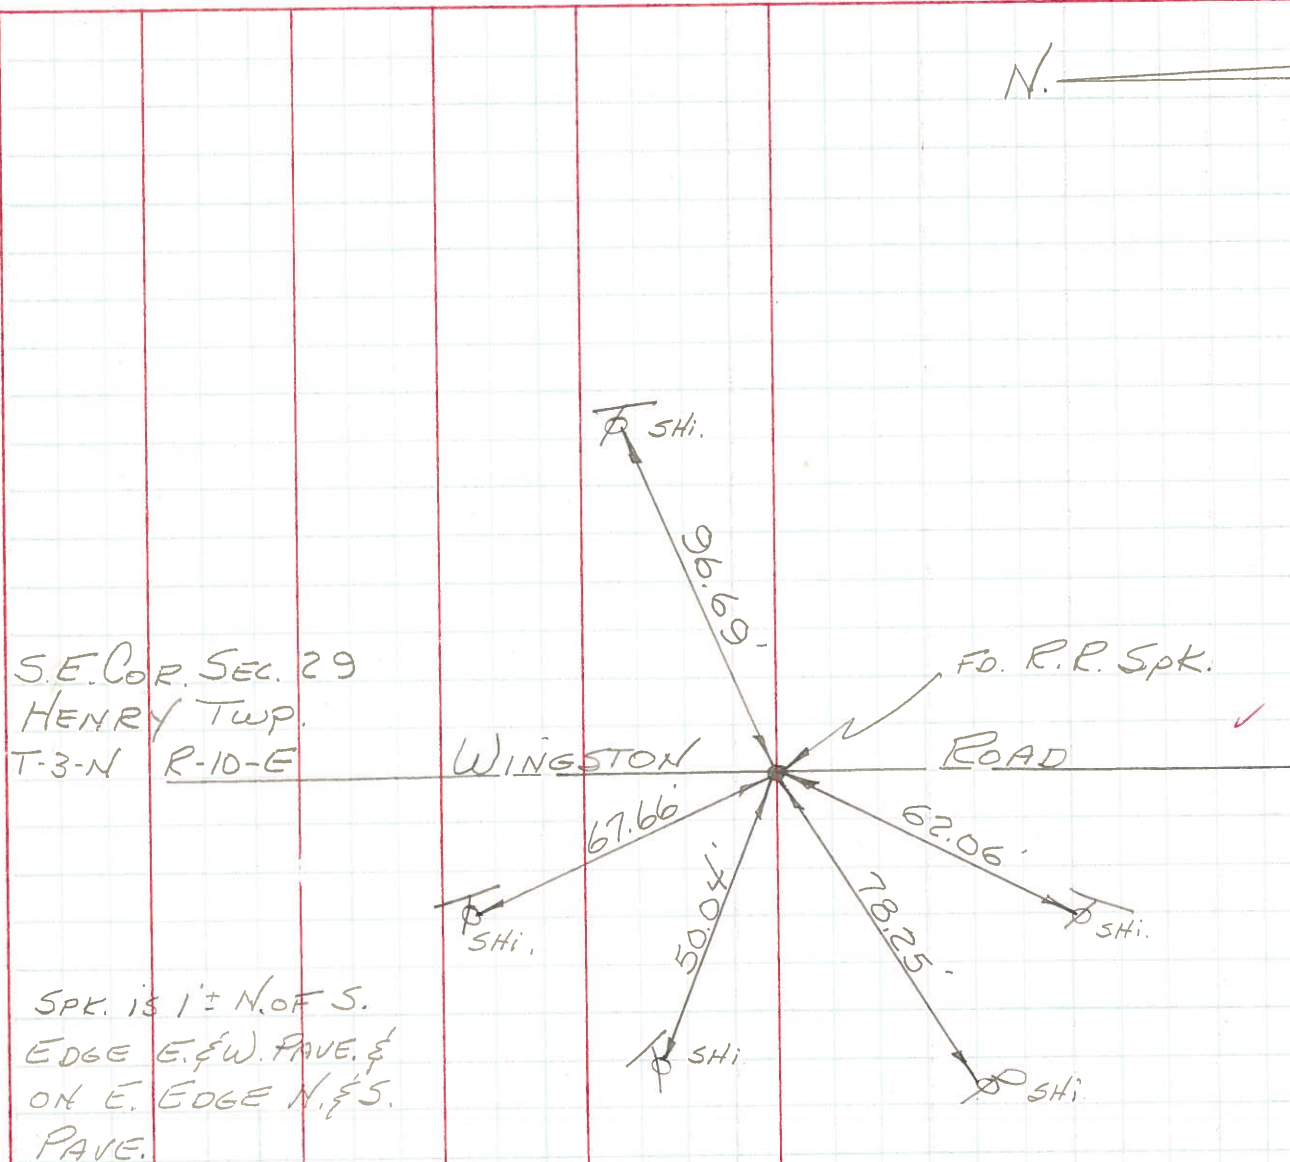

#22