

O.D.O.T. DISTRICT 2 SURVEY OFFICE (USE ONLY)

PERSONNEL

REFERENCE NO. 23

SHEET 5 OF 52

NOTES ASTON

DATE 5/23/24

ROUTE SR 18

H.C. NIESE

WEATHER SUNNY

COUNTY WOOD

R.C. PRESTON-COLVIN

TEMP. 80°F

TOWNSHIP HENRY

SECTION 33

DWG BY BARRIERE

PID 101290

T 3 N R 10 E

TYPE MONUMENT MAG NAIL/WASHER

ON SURFACE - BELOW ON

OFFSET $\varnothing$ PAVEMENT LT : RT

 TO EDGE PAVEMENT

STATION: 528+45.11

HORIZ.DATUM: WOOD LDP


GEOID: 18

GRID: NORTHING: 554776.971


EASTING: 1633502.541

LDP: NORTHING: 376370.347

EASTING: 145572.051

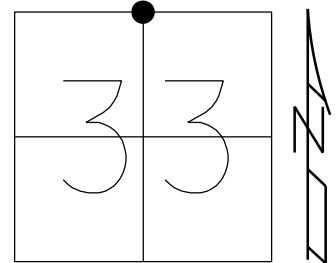

FD SM.R.R.SPIKE
AT SURFACE
6/17/87, CL
SET P.K./WASHER
7/21/87, CL
FD SM.R.R.SPIKE
0.2' BELOW
6/15/10
GPS, SV23
6/17/10, MC
SET MAG/WASHER
GPS, REF3
1/31/12, SAH
D.N.F.
5-30-23, JMR
SET MAG/WASHER
REF23
8-10-23, TDN
FD MAG/WASHER
REF23
5/23/24, TDN
10/25/24, TDN

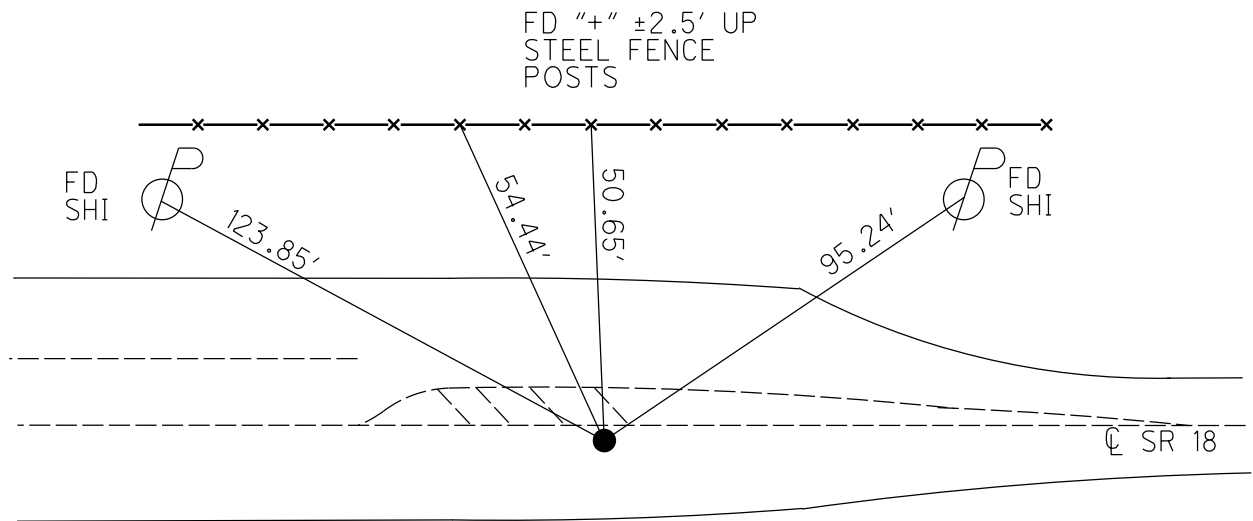

O.D.O.T. DISTRICT 2 SURVEY OFFICE (USE ONLY)

PERSONNEL

REFERENCE NO. 23

SHEET 21 OF 52

NOTES AUBLE

DATE 8-10-23

ROUTE SR 18

H.C. NIESE

WEATHER BREEZY

COUNTY WOOD

R.C. ASTON

TEMP. 78°

TOWNSHIP HENRY

SECTION 33

DWG BY ASTON

PID PAVETRAIN

T 3 N R 10 E

TYPE MONUMENT MAG/WASHER

ON SURFACE - ~~BELOW~~ ON

OFFSET CL PAVEMENT 4.2' LT : RT

6.1' TO RT EDGE PAVEMENT



STATION: 528+45.11

HORZ.DATUM: NAD83(2011)

GEOID: NAVD88 2018

GRID: NORTHING: 554776.971

EASTING: 1633502.541

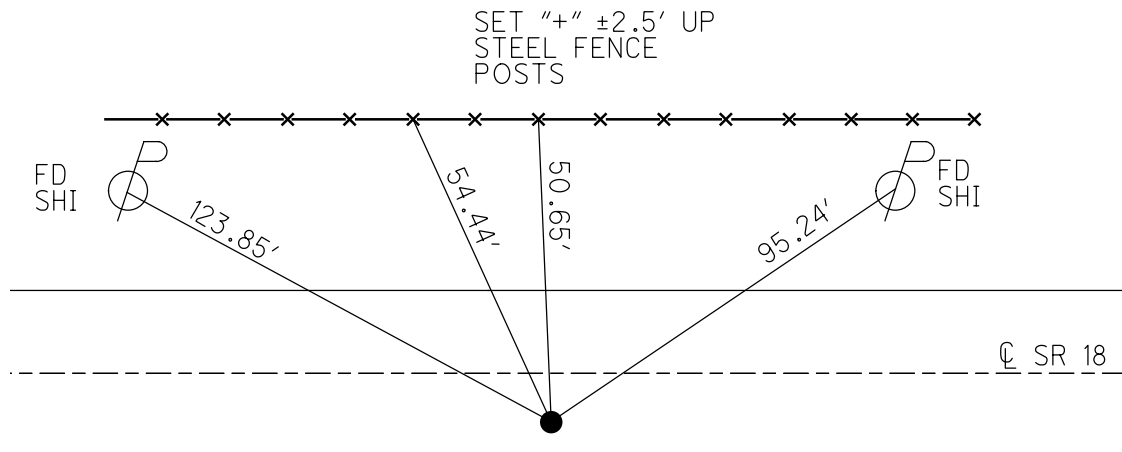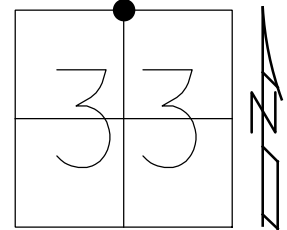

FD SM.R.R.SPIKE
AT SURFACE
6/17/87, CL
SET P.K./WASHER
7/21/87, CL
FD SM.R.R.SPIKE
0.2' BELOW
6/15/10
GPS, SV23
6/17/10, MC
SET MAG/WASHER
GPS, REF3
1/31/12, SAH
D.N.F.
5-30-23, JMR
SET MAG/WASHER
REF23
8-10-23, TDN

O.D.O.T. DISTRICT 2 SURVEY OFFICE (USE ONLY)

PERSONNEL _____ REFERENCE NO. 23 SHEET 20 OF 26
 NOTES CANTERBURY DATE 6/3/11 ROUTE SR 18
 H.C. HUSS WEATHER FAIR COUNTY WOOD
 R.C. HARBAUGH TEMP. 66° TOWNSHIP HENRY
 SECTION 33
 T 3 N R 10 E

TYPE MONUMENT SM.R.R.SPIKE



~~ON SURFACE~~ - BELOW 0.15'

~~LEFT~~ - CL PAV'T - RIGHT 4.2'

6.1' TO RT EDGE PAVEMENT

S.L.M. 528+45.11

Grid: Northing: 554777.023 Easting: 1633502.485

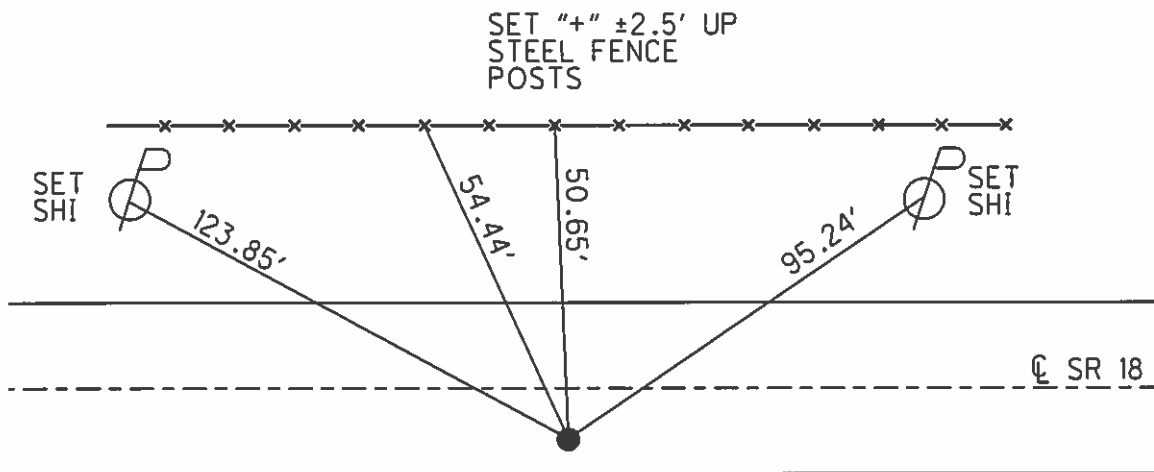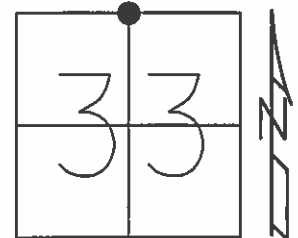

FD SM.R.R.SPIKE
 AT SURFACE
 6/17/87, CL

SET P.K./WASHER
 7/21/87, CL

FD SM.R.R.SPIKE
 0.2' BELOW
 6/15/10
 GPS, SV23
 6/17/10, MC

SET MAG/WASHER
 GPS, REF3
 1/31/12, SAH

O.D.O.T. DISTRICT 2 SURVEY OFFICE

PERSONNEL

REFERENCE NO. 23

SHEET 8 OF

NOTES HOFFMAN

H.C. LOSHREE

R.C. BARNHISEL

SOCKMAN

DATE 6-17-87

WEATHER Clear

TEMP. 80°

ROUTE SR 18

COUNTY Wood

TOWNSHIP HENRY

SECTION 28

T3 N R 10 E


TYPE MONUMENT SMALL R.R. SPIKE

ON SURFACE - ~~BELOW~~ YES

~~LEFT~~ & PAV'T. - RIGHT 3.9'


S.O TO RT EDGE PAVEMENT

S.L.M. 529 + 36

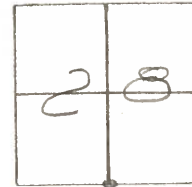

SET P.K. / WASHER
7-21-87
C.L.

E Part SR 18

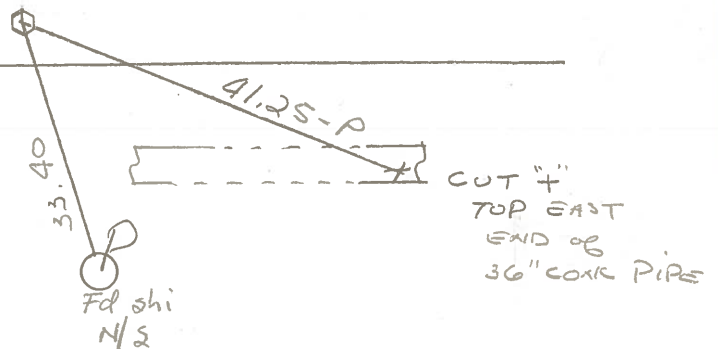

ODOT DISTRICT 2 SURVEY OFFICE

Sht. 3 of 22
S.R. 18

County WOOD

Date 6-15-78

Township HENRY

Weather CLEARING

Section S. 1/4 POST SEC. 28

Temp. +63°

T3N, R10E


Personnel BURNSIDE

SMITH


BOWERS

KNAPE

MEAD

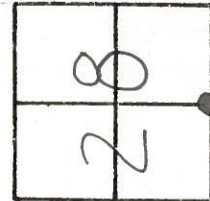

#23

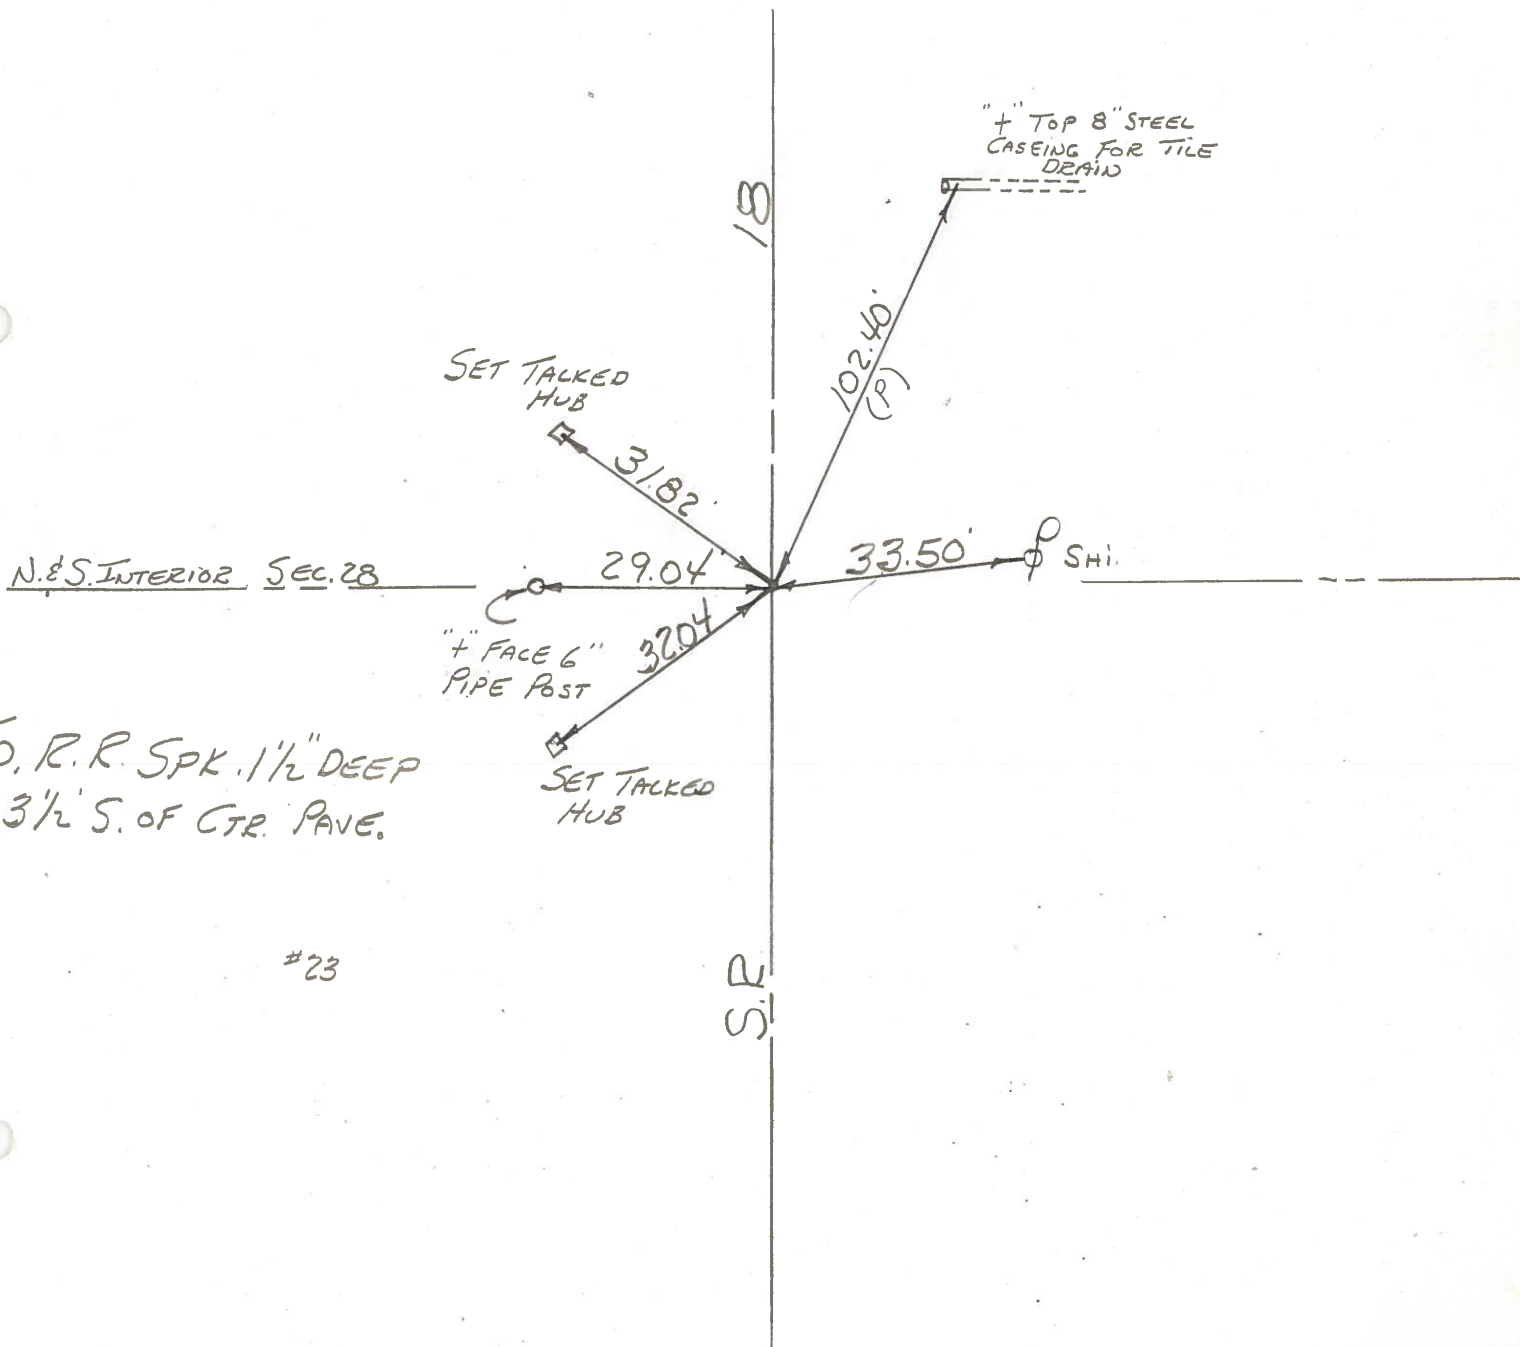

PERSONNEL	TITLE	PERSONNEL	TITLE	COUNTY	DATE	WEATHER	TEMP.
BURNSIDE		ROCCHINI		WOOD	6-21-71	PT. CLOUDY	+75°
SMITH				S. R. 18			
BOWERS				SEC. 28			
HOLCOMBE							

DESCRIPTION	LEFT	CENTER LINE	RIGHT	JOB NO.
-------------	------	-------------	-------	---------

