

O.D.O.T. DISTRICT 2 SURVEY OFFICE (USE ONLY)

PERSONNEL

REFERENCE NO. 24

SHEET 5 OF 52

NOTES ASTON DATE 5/23/24
H.C. NIESE WEATHER SUNNY
R.C. PRESTON-COLVIN TEMP. 80°F

ROUTE SR 18
COUNTY WOOD
TOWNSHIP HENRY
SECTION 33

DWG BY BARRIERE PID 101290

T 3 N R 10 E

TYPE MONUMENT MONBOX W/ 1" IPIN

ON SURFACE - BELOW ON

OFFSET $\varnothing$ PAVEMENT _____ LT : RT

_____ TO _____ EDGE PAVEMENT

STATION: 540+50.70

HORZ.DATUM: WOOD LDP


GEOID: 18

GRID: NORTHING: 554768.301


EASTING: 1634615.622

LDP: NORTHING: 376376.325

EASTING: 146685.263

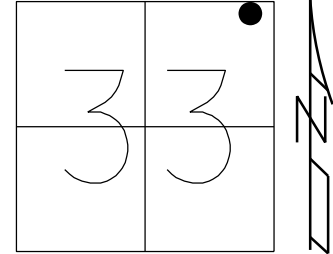

RECORD: S.C.
STA. 540+50.70
FD MONBOX
W/1" IPIN
REF24
6-15-20, JFO
FD MONBOX
W/1" IPIN
REF24
5/23/24, TDN

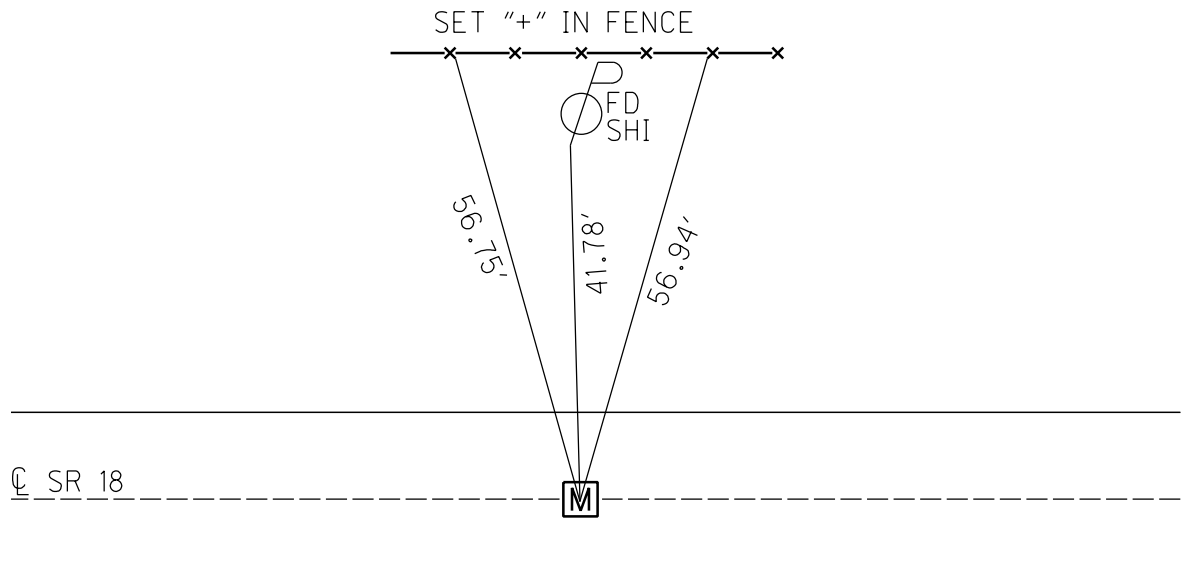

O.D.O.T. DISTRICT 2 SURVEY OFFICE (USE ONLY)

PERSONNEL

REFERENCE NO. 24

SHEET 22 OF 51

NOTES RHOADES

DATE 6-15-20

ROUTE SR 18

H.C. O'DONNELL

WEATHER SUNNY

COUNTY WOOD

R.C. MAHLER

TEMP. 75°F

TOWNSHIP HENRY

SECTION 33

DWG BY MAHLER

PID PAVETRAIN

T 3 N R 10 E

TYPE MONUMENT MONBOX W/1" IPIN

ON SURFACE - ~~BELOW~~ ON

OFFSET ℄ PAVEMENT LT : RT

- TO - EDGE PAVEMENT


STATION: 540+50.70

HORZ.DATUM: NAD83 (2011)

GEOID: NAVD88-2012A

GRID: NORTHING: 554768.301

EASTING: 1634615.622

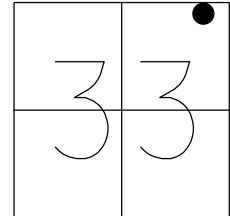

RECORD: S.C.
STA. 540+50.70
FD MONBOX
W/1" IPIN
REF24
6-15-20, JFO

℄ SR 18

