

O.D.O.T. DISTRICT 2 SURVEY OFFICE (USE ONLY)

PERSONNEL

REFERENCE NO. 24

SHEET 5 OF 52

NOTES ASTON

DATE 5/23/24

ROUTE SR 18

H.C. NIESE

WEATHER SUNNY

COUNTY WOOD

R.C. PRESTON-COLVIN

TEMP. 80°F

TOWNSHIP HENRY

DWG BY BARRIERE

PID 101290

SECTION 33

T 3 N R 10 E

TYPE MONUMENT MONBOX W/ 1" IPIN

ON SURFACE - BELOW ON

OFFSET CL PAVEMENT LT : RT

 TO EDGE PAVEMENT

STATION: 540+50.70

HORZ.DATUM: WOOD LDP


GEOID: 18

GRID: NORTHING: 554768.301


EASTING: 1634615.622

LDP: NORTHING: 376376.325

EASTING: 146685.263

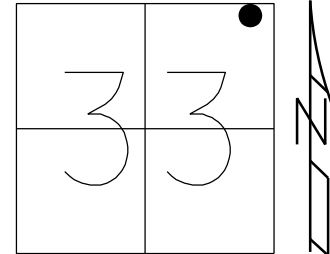

RECORD: S.C.
STA. 540+50.70
FD MONBOX
W/1" IPIN
REF24
6-15-20, JFO
FD MONBOX
W/1" IPIN
REF24
5/23/24, TDN

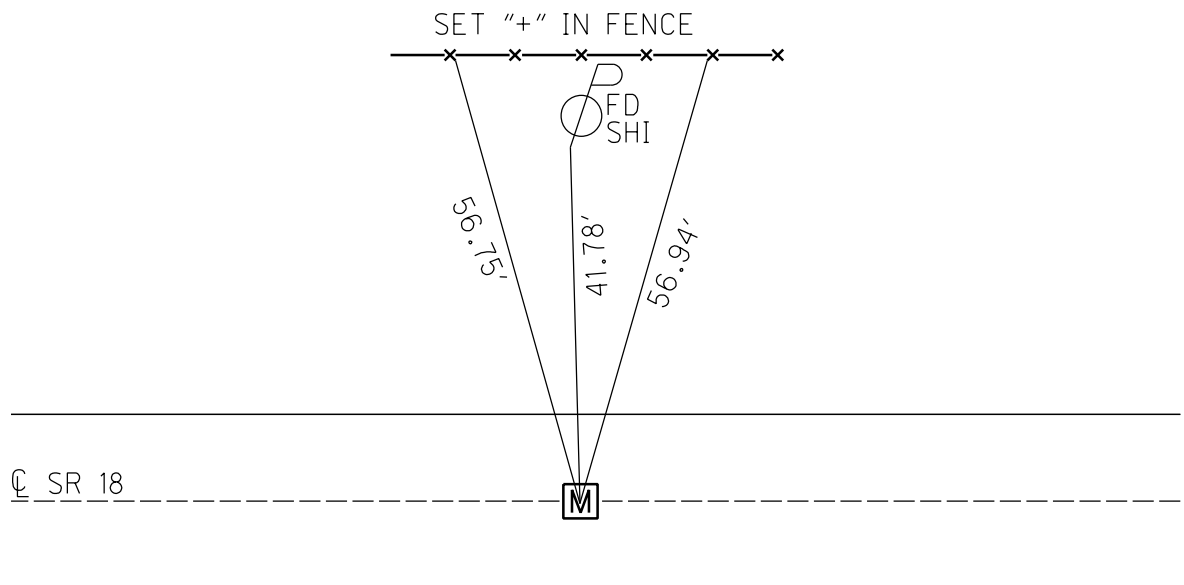

O.D.O.T. DISTRICT 2 SURVEY OFFICE (USE ONLY)

PERSONNEL _____ REFERENCE NO. 24 SHEET 22 OF 26
NOTES HOFFMAN DATE 6/17/87 ROUTE SR 18
H.C. LOEHRKE WEATHER CLEAR COUNTY WOOD
R.C. BARNHISEL TEMP. 80° TOWNSHIP HENRY
SOCKMAN SECTION 33
T 3 N R 10 E

TYPE MONUMENT SM.R.R.SPIKE


ON SURFACE - ~~BELOW~~ ON _____

~~LEFT~~ - CL PAV'T - RIGHT 2.8', 5' E. OF PAV'T SOUTH

- TO - EDGE PAVEMENT

S.L.M. 555+07.50

Grid: Northing: 554763.684 Easting: 1636164.845

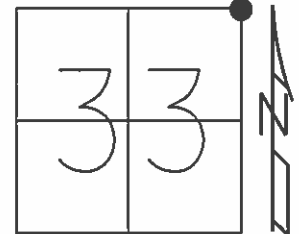

FD SM.R.R.SPIKE
AT SURFACE
6/17/87, CL

SET P.K./WASHER
7/21/87, CL

FD SM.R.R.SPIKE
6/16/10
GPS, SV24
6/17/10, MC
FINAL GPS, REF24
1/31/12, SAH

CL OLD SR 18

ALL TIES DESTROYED
BY CONSTRUCTION

CL LIBERTY HIGH OVERPASS

O.D.O.T. DISTRICT 2 SURVEY OFFICE

PERSONNEL

REFERENCE NO. 24

SHEET 10 OF

NOTES HOFFMAN

H.C. LOSHREE

R.C. BARNHISEL

SOCKMAN

DATE 6-17-87

WEATHER CLEAR

TEMP. 80°

ROUTE SR 18

COUNTY WOOD

TOWNSHIP HENRY

SECTION 28

T.3 N R 10 E


TYPE MONUMENT SMALL RR SPIKE

ON SURFACE - ~~BELOW~~ YES


~~LEFT~~ - & PAV'T. - RIGHT 2.8'

TO EDGE PAVEMENT 5' EAST of & Part South

S.L.M. 555+99

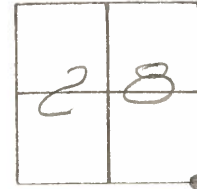

SET PK/WASHER
7-21-87 C.L.

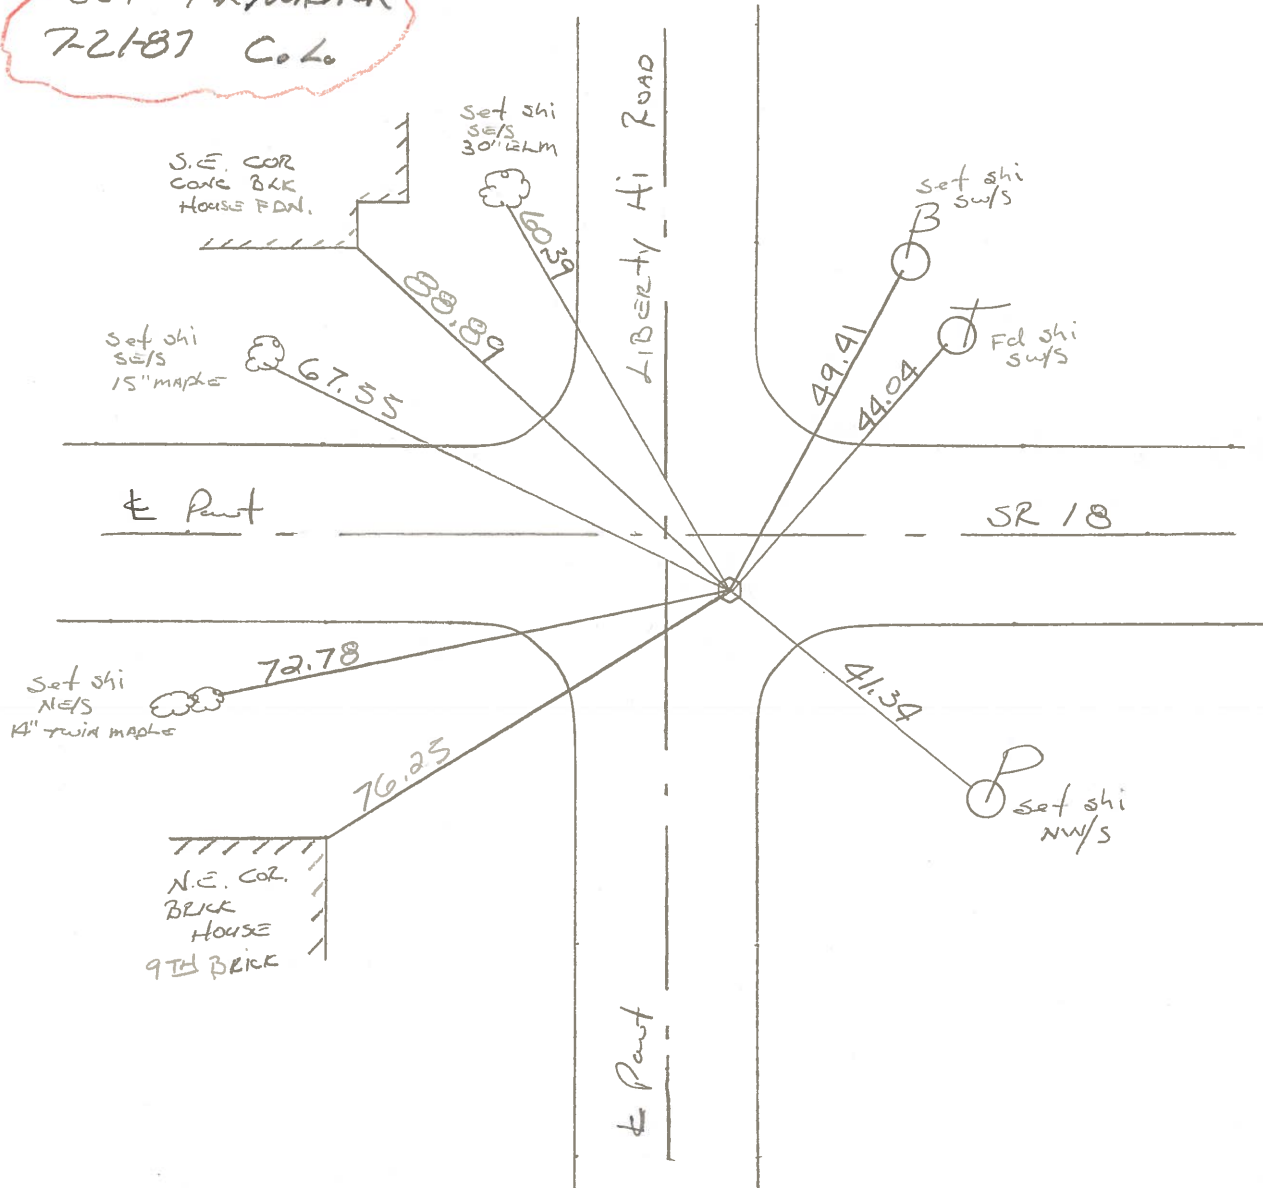

O.D.O.T. DISTRICT 2 SURVEY OFFICE

Sht. 4 of 22
S-R-18

County WOOD

Township HENRY

Section S.E. COR. SEC. 28

T3N, R10E

Personnel BURNSIDE

SMITH

BOWERS




KNAPE

MEAD

Date 6-15-78

Weather PT. CLOUDY

Temp. +63°

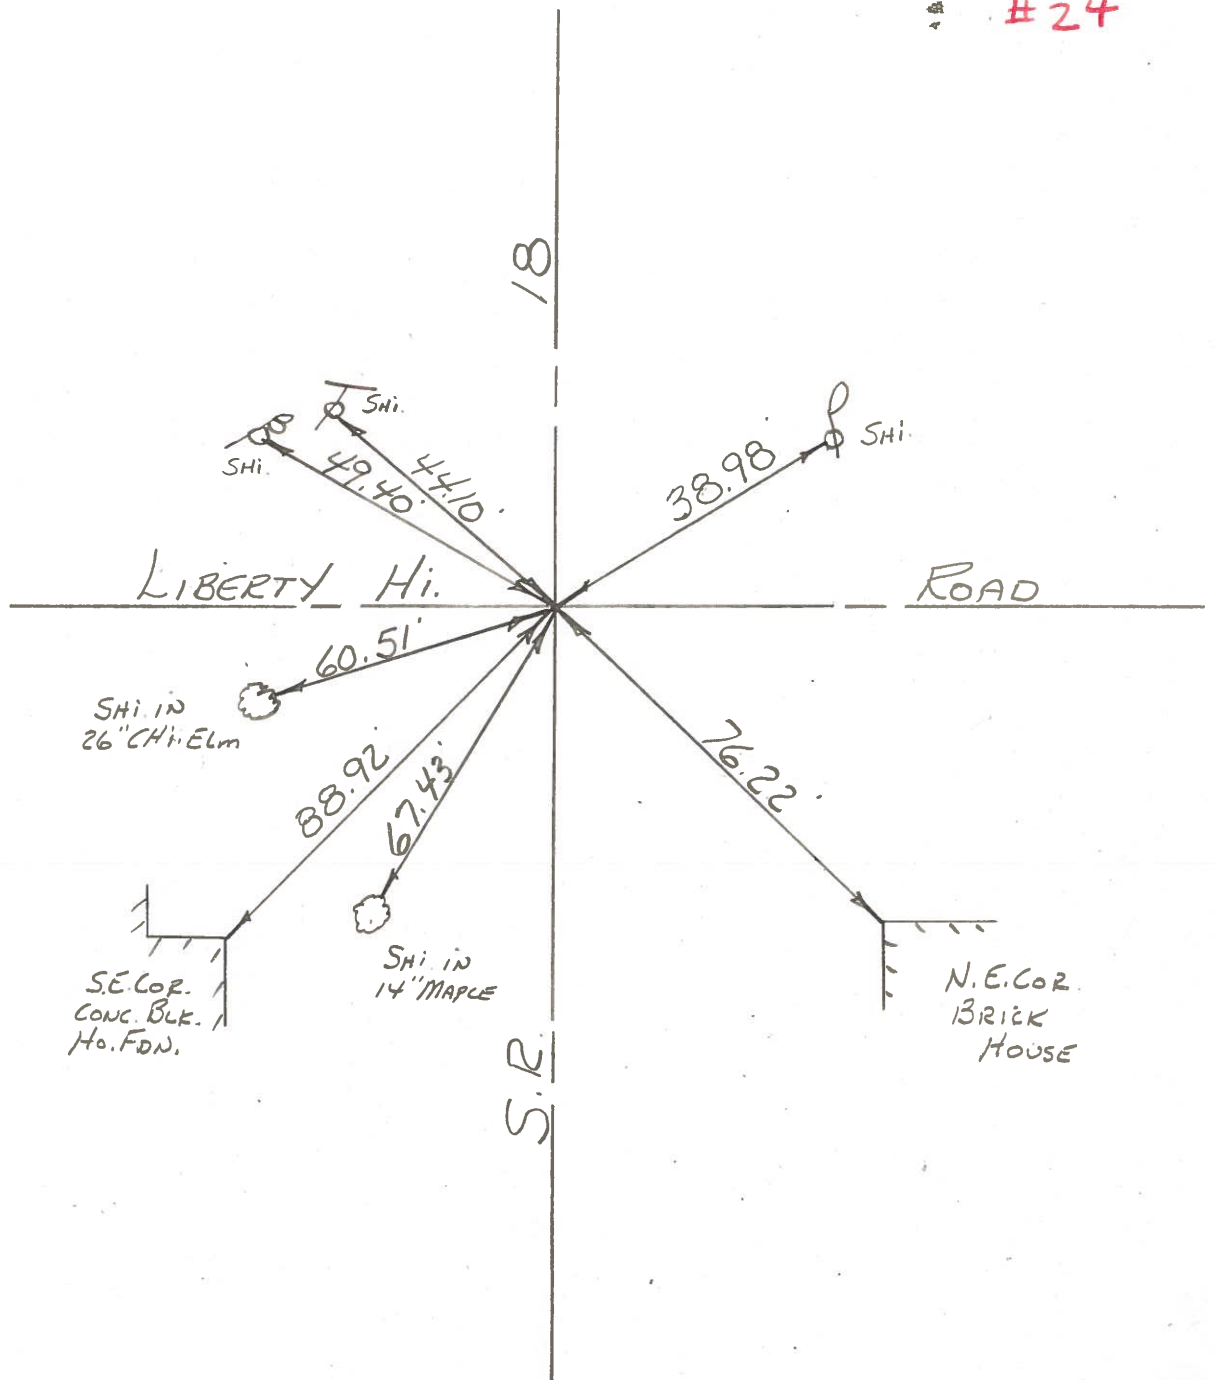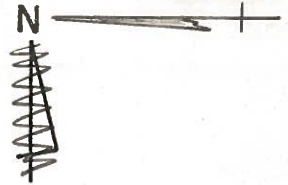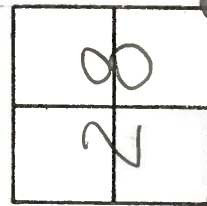

FD. R.R. SPK.
 1" DEEP

#24

S.R.

PERSONNEL	TITLE	PERSONNEL	TITLE	COUNTY	DATE	WEATHER	TEMP.
BURNSIDE		ROCCHINI		Wood	6-21-71	PT. Cloudy	+75°
SMITH				S. R. 18			
BOWERS				SEC. 28			
HOLCOMBE							

DESCRIPTION	LEFT	CENTER LINE	RIGHT	JOB NO.
-------------	------	-------------	-------	---------

