

O.D.O.T. DISTRICT 2 SURVEY OFFICE (USE ONLY)

PERSONNEL

REFERENCE NO. 33 D

SHEET 8 OF 35

NOTES NIESE
H.C. NIESE
R.C.

DATE 7/16/24
WEATHER SUNNY
TEMP. 80°

ROUTE SR 18
COUNTY WOOD
TOWNSHIP BLOOM
SECTION 31

DWG BY BARRIERE PID 93417

T 3 N R 11 E

TYPE MONUMENT MAG NAIL/WASHER

ON SURFACE - BELOW ON

OFFSET $\oslash$ PAVEMENT 0.4' LT

TO EDGE PAVEMENT

STATION: 775+30.97

HORZ. DATUM: NAD83 (2011)


GEOID: 18

GRID: NORTHING: 550775.634


EASTING: 1654907.567

LDP: NORTHING: 372651.192

EASTING: 167029.867

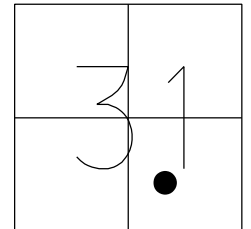

RECORD:
FD FR/OLD SURVEY
OBSERVED
 $\Delta=02^{\circ}47'56''$ RT
8-30-88
FD P.K. NAIL
6/9/99, MB
SET P.K./WASHER
7/20/99, MB
FD P.K. NAIL
REFD33
8/25/14, DCH
SET MAG/WASHER
11/05/14, DCH
FD MAG/WASHER
REF33D
7/16/24, TDN

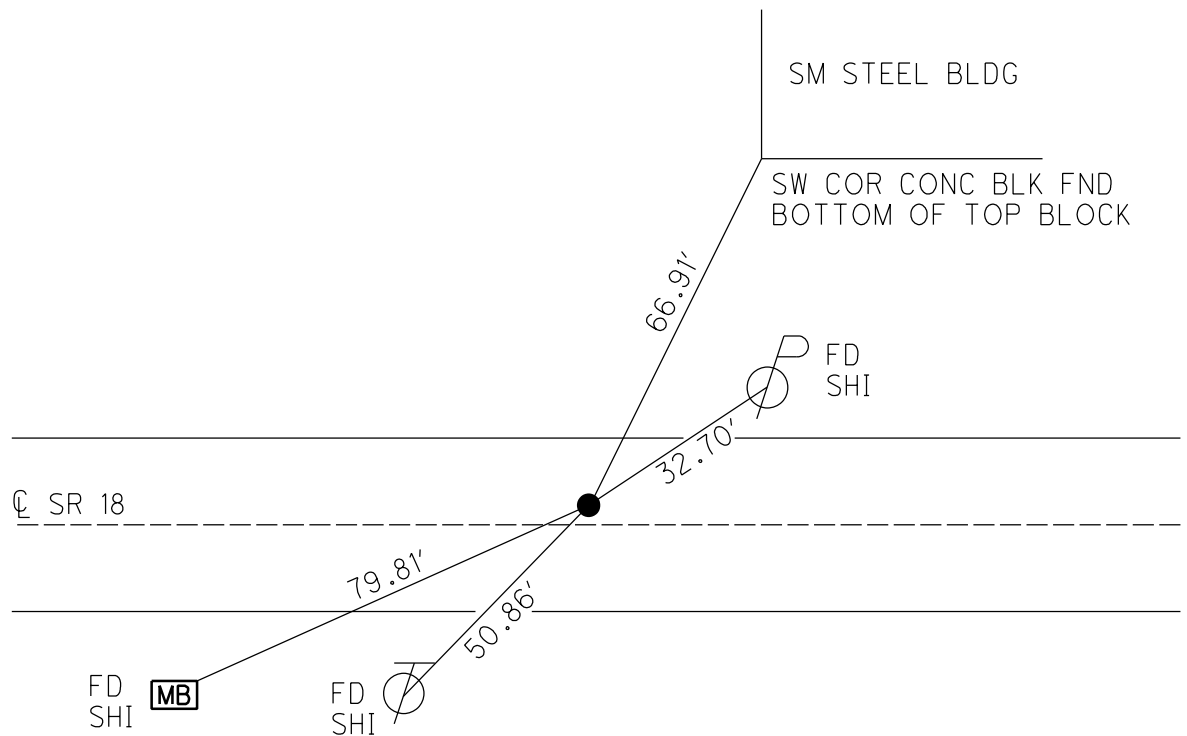

O.D.O.T. DISTRICT 2 SURVEY OFFICE

PERSONNEL _____

REFERENCE NO. _____

SHEET 3 OF 29

NOTES Barbise / RC

H.C. Roller (DRAWN)

R.C. _____

DATE 6-9-99

WEATHER hot

TEMP. 85°

ROUTE 18

COUNTY WOOD

TOWNSHIP Bloom

SECTION 31

T3 N R 11 E


TYPE MONUMENT P.K. nail

ON SURFACE - BELOW 3"

LEFT - 1 PAV'T. - RIGHT 0.4'


8.7 TO 1 EDGE PAVEMENT

S.L.M. 275+71

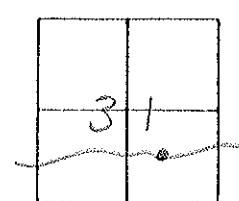

Point Found From old survey
OBSERVED $\Delta = 02^\circ 49' 56''$ R+ 8-30-88

RESET PK/WASHER
7-20-99
MB

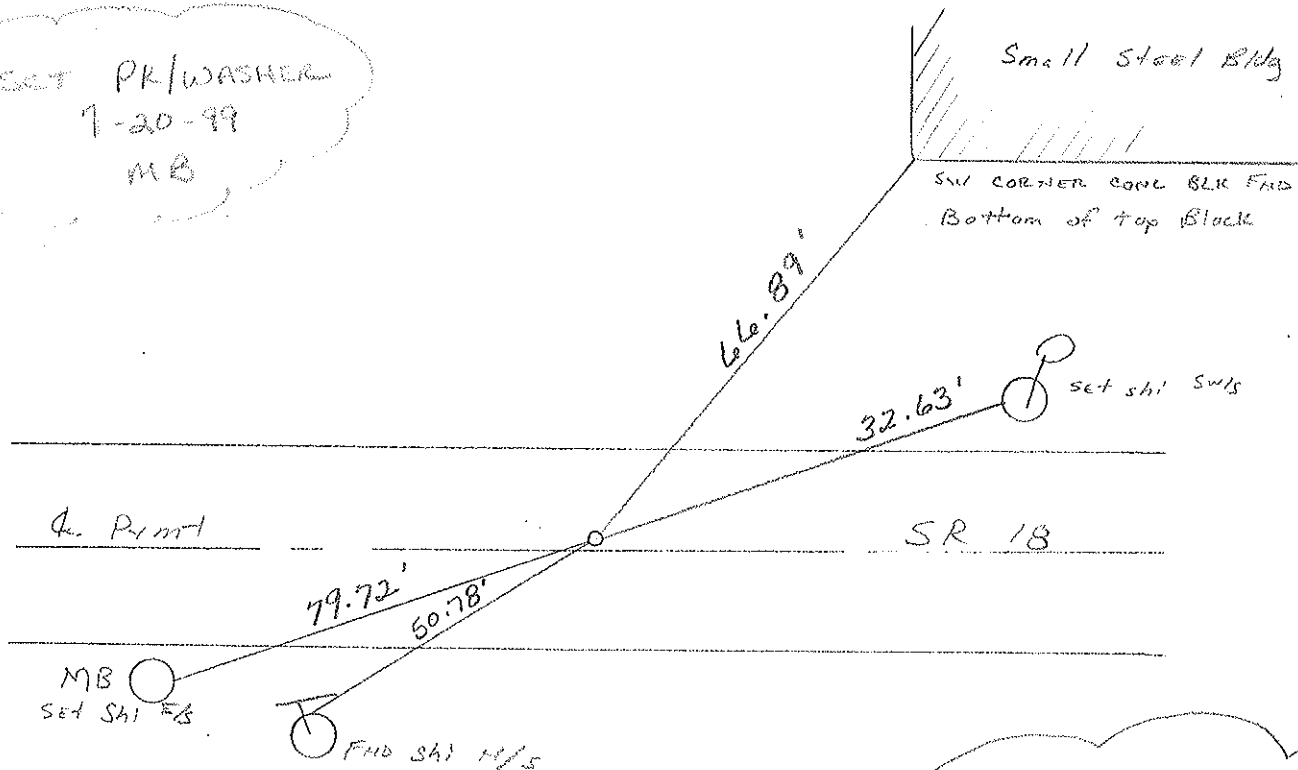

PK SET By SSOE
For BRIDGE SURVEY
0.02
0.53
PK SET By
ASKIN MERCER

O.D.O.T. DISTRICT 2 SURVEY OFFICE

PERSONNEL

REFERENCE NO. 31 B

SHEET ____ OF ____

NOTES HOFFMAN

H.C. LOSHRICE

R.C. BARNHISEL

DATE 9-30-88

WEATHER CLEAR

TEMP. 74°

ROUTE SR 18

COUNTY WOOD

TOWNSHIP Bloom

SECTION 31

T. 3 N. R. 11 E


TYPE MONUMENT P.K. Nail

ON SURFACE - BELOW 3"

LEFT- & PAW'T. - RIGHT 0.4

8.7 TO LT EDGE PAVEMENT

S.L.M. _____

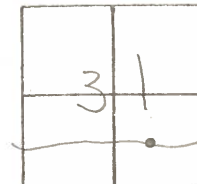

Point Found From old survey

OBSERVED $\Delta = 02^{\circ} - 47' - 56''$ Rt.

