

O.D.O.T. DISTRICT 2 SURVEY OFFICE (USE ONLY)

PERSONNEL

REFERENCE NO. 33 E

SHEET 9 OF 35

NOTES NIESE
H.C. NIESE
R.C.

DATE 7/16/24
WEATHER SUNNY
TEMP. 80°

ROUTE SR 18
COUNTY WOOD
TOWNSHIP BLOOM
SECTION 31

DWG BY BARRIERE PID NO PID

T 3 N R 11 E

TYPE MONUMENT MAG SHANK

ON SURFACE - BELOW ON

OFFSET CL PAVEMENT ON LT : RT

9.3' TO RT EDGE PAVEMENT

STATION: 787+62.68

HORZ.DATUM: NAD83 (2011)


GEOID: 18

GRID: NORTHING: 550493.862

EASTING: 1656106.624

LDP: NORTHING:


EASTING:

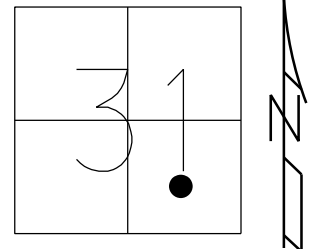

RECORD:
FD FR/OLD SURVEY
OBSERVED
 $\Delta=04^{\circ}02'43''$ RT
9-26-88
FD R.R. SPIKE
6/9/99, MB
SET P.K./WASHER
7/20/99, MB
FD P.K. NAIL
REFE33
8/25/14, DCH
SET MAG/WASHER
11/05/14, DCH
FD MAG SHANK
REF33E
7/16/24, TDN

$4^{\circ}02'26.1''$
MEASURED WHEN
HOLDING RECRE33F

FD P.K. 2' FR/
END OF 12" CMP

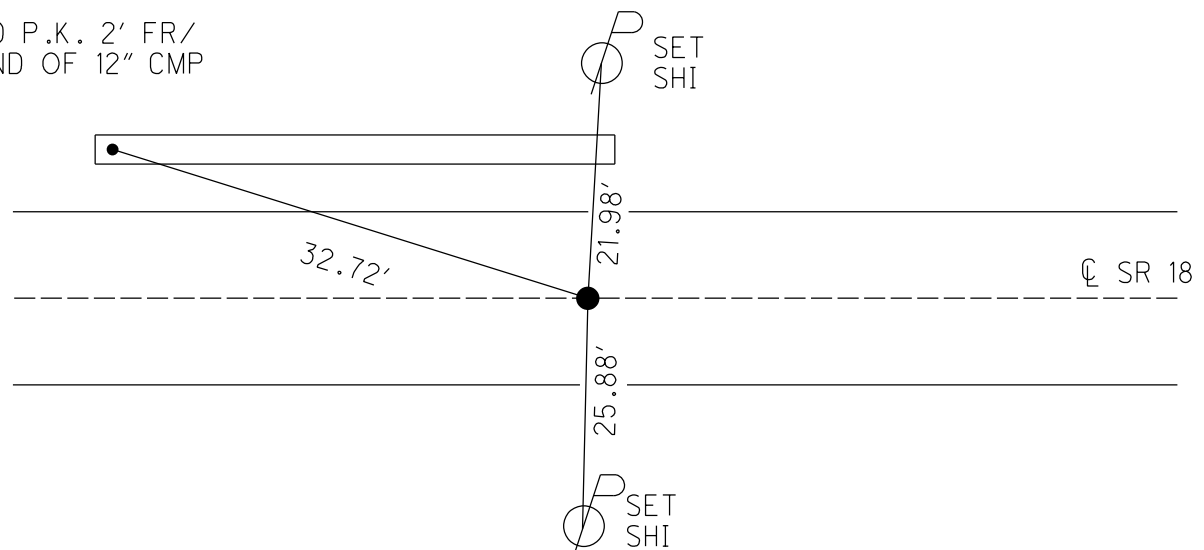

O.D.O.T. DISTRICT 2 SURVEY OFFICE (USE ONLY)

PERSONNEL

REFERENCE NO. 33 E

SHEET 9 OF 35

NOTES HOMAN DATE 8/25/14
H.C. LEU WEATHER SUNNY
R.C. RHOADES TEMP. 80°

ROUTE SR 18
COUNTY WOOD
TOWNSHIP BLOOM
SECTION 31
T 3 N R 11 E

DWG BY MILLER PID 93417

TYPE MONUMENT P.K. NAIL

ON SURFACE - ~~BELOW~~ ON

OFFSET CL PAVEMENT ON LT : ~~RT~~

9.3' TO RT EDGE PAVEMENT


STATION: 787+62.68

HORZ. DATUM: NAD83 (2011)


GEOID: 2012A

GRID: NORTHING: 550493.862

EASTING: 1656106.624

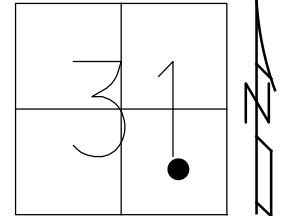

FD P.K. 2' FR/
END OF 12" CMP

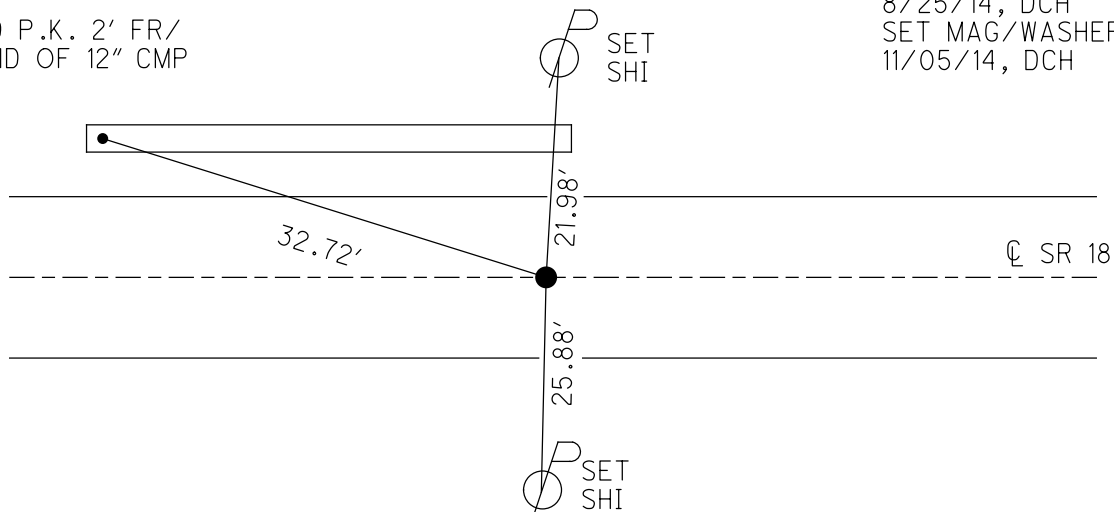

RECORD:
FD FR/OLD SURVEY
OBSERVED
 $\Delta=04^{\circ}02'43''$ RT
9-26-88
FD R.R. SPIKE
6/9/99, MB
SET P.K./WASHER
7/20/99, MB
FD P.K. NAIL
REFE33
8/25/14, DCH
SET MAG/WASHER
11/05/14, DCH

O.D.O.T. DISTRICT 2 SURVEY OFFICE

PERSONNEL _____

REFERENCE NO. _____

SHEET 4 OF 29

NOTES Barnhiser RC

H.C. Roussos (DRAWN)

R.C. _____

DATE 6-9-99

WEATHER Sunny

TEMP. 80°

ROUTE SR 18

COUNTY Wood

TOWNSHIP Bloom

SECTION 31

T. 3 N. R. 11 E


TYPE MONUMENT RR spike

ON SURFACE - BELOW 3"

LEFT-CL PAV'T. - RIGHT YES

9.3 TO R+ EDGE PAVEMENT


S.L.M. 788+03

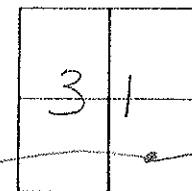

POINT FOUND FROM OLD SURVEY
OBSERVED $\Delta = 04^{\circ} 02' - 43" \text{ LT}$ 9-26-88

SSOE. Plat Sta $\pm 787+64.1$

RESET PK/WASHER
7-20-99
MB

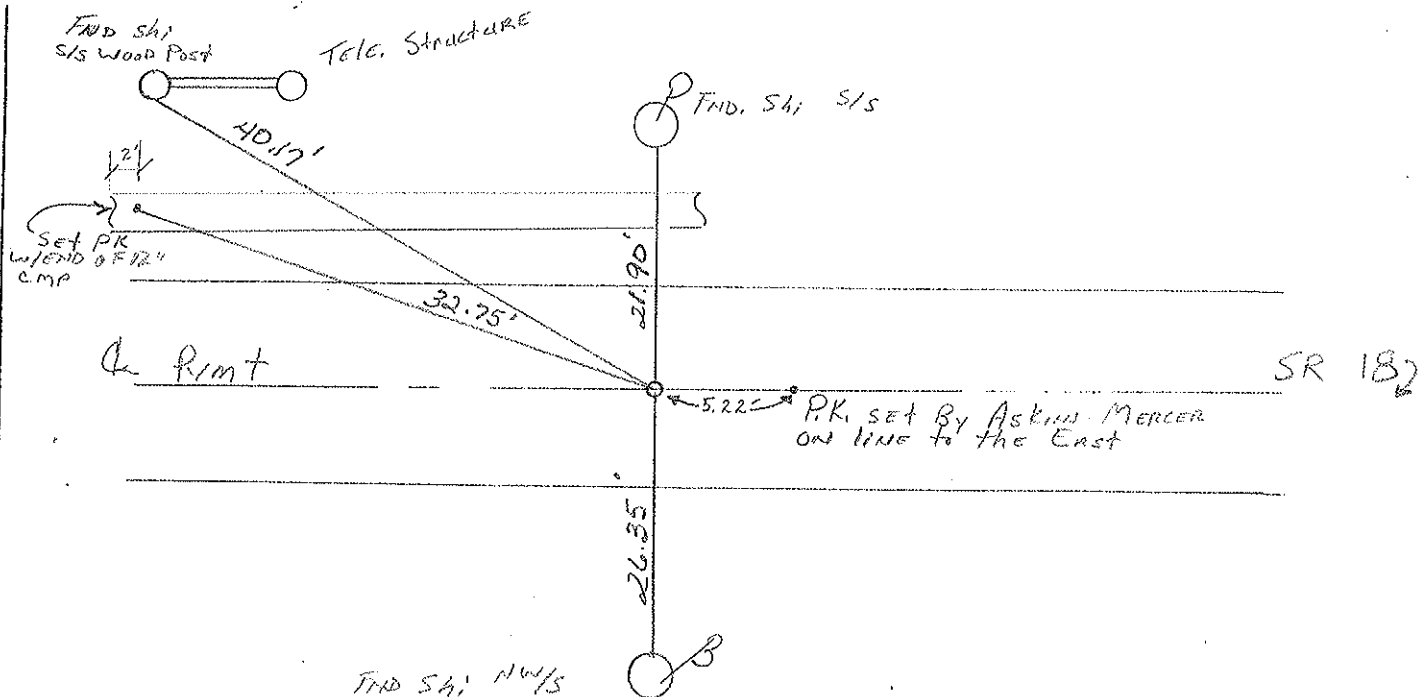

O.D.O.T. DISTRICT 2 SURVEY OFFICE

PERSONNEL

REFERENCE NO. 32

SHEET OF

NOTES HOFFMAN

H.C. LOCHERKE

R.C. BARNHISSE

DATE 4-16-90

WEATHER P. CLEAR

TEMP. 45°

ROUTE SR 18

COUNTY WOOD

TOWNSHIP Bloom

SECTION 31

T 3 N R 11 E


TYPE MONUMENT R.R. SPIKE

ON SURFACE - BELOW 3"

LEFT- & PAV'T. - RIGHT YES

9.6 TO R EDGE PAVEMENT

S.L.M.

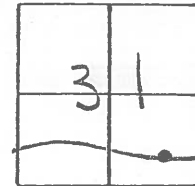

POINT FOUND FROM OLD SURVEY
OBSERVED $\Delta = 04^{\circ} - 02' - 43''$ LT.

SSOE. PLAN Sta $\pm 787+64.1$

