

O.D.O.T. DISTRICT 2 SURVEY OFFICE (USE ONLY)

PERSONNEL

REFERENCE NO. 33 F

SHEET 10 OF 35

NOTES NIESE

DATE 7/24/24

ROUTE SR 18

H.C. NIESE

WEATHER SUNNY

COUNTY WOOD

R.C.

TEMP. 80°

TOWNSHIP BLOOM

DWG BY BARRIERE

PID NO PID

SECTION 31

T 3 N R 11 E

TYPE MONUMENT MAG/WASHER

ON SURFACE - BELOW ON

OFFSET $\varnothing$ PAVEMENT 6.6' ~~LT~~ : RT

3.0 TO RT EDGE PAVEMENT

STATION: 796+23.09

HORZ.DATUM: NAD83 (2011)


GEOID: 18

GRID: NORTHING: 550356.482

EASTING: 1656955.996

LDP: NORTHING: 372259.088

EASTING: 169083.726

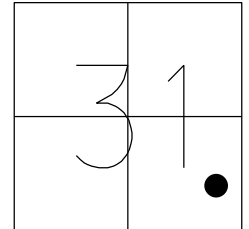

RECORD: P.I.
POINT SET
OBSERVED
 $\Delta=10^{\circ}14'17''$
9-26-88
FD P.K./WASHER
6/9/99, MB
SET P.K./WASHER
7/20/99, MB
FD P.K./WASHER
REF33
8/25/14, DCH
D.N.F.
7/16/24, TDN
SET MAG/WASH
BY GPS COORDS
REF33F
7/24/24, TDN

$\varnothing$ SR 18



O.D.O.T. DISTRICT 2 SURVEY OFFICE (USE ONLY)

PERSONNEL

REFERENCE NO. 33 F

SHEET 10 OF 35

NOTES BARNHISEL

DATE 6/16/99

ROUTE SR 18

H.C. CANTERBURY

WEATHER CLOUDY

COUNTY WOOD

R.C. ROUSOS

TEMP. 65°

TOWNSHIP BLOOM

SECTION 31

DWG BY MILLER

PID 93417

T 3 N R 11 E

TYPE MONUMENT P.K./WASHER

ON SURFACE - ~~BELOW~~ ON

OFFSET CL PAVEMENT 6.6' ~~LT~~ : RT

3.0' TO RT EDGE PAVEMENT


STATION: 796+23.09

HORZ.DATUM: NAD83 (2011)


GEOID: 2012A

GRID: NORTHING: 550356.482

EASTING: 1656955.996

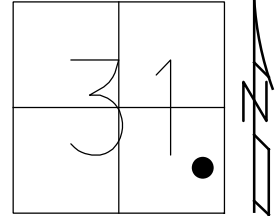

RECORD: P.I.
POINT SET
OBSERVED
 $\Delta=10^{\circ}14'17''$
9-26-88
FD P.K./WASHER
6/9/99, MB
SET P.K./WASHER
7/20/99, MB
FD P.K./WASHER
REFF33
8/25/14, DCH

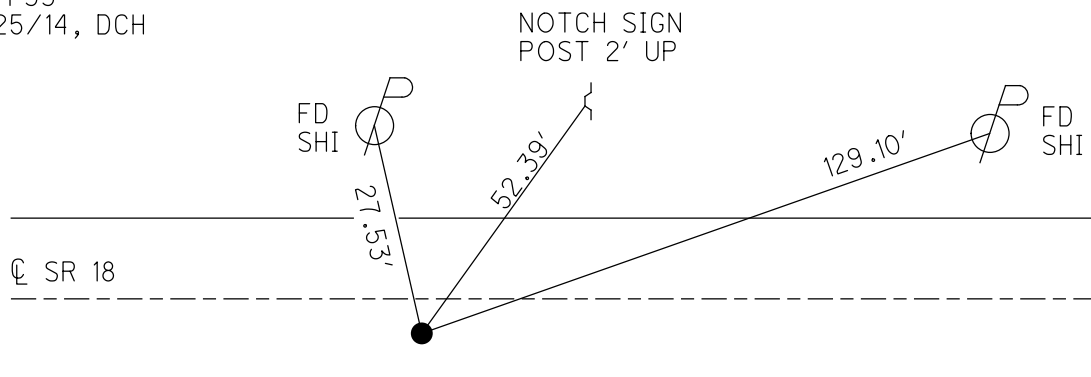

O.D.O.T. DISTRICT 2 SURVEY OFFICE

PERSONNEL _____

REFERENCE NO. _____

SHEET 5 OF 29

NOTES Baruchel

H.C. Canterbury

R.C. Rousar III

DATE 6-16-99

WEATHER Cloudy

TEMP. +65°F

ROUTE SR18

COUNTY Wear

TOWNSHIP Bloom

SECTION 31

T 3 N R 11 E


TYPE MONUMENT PK/WASHER

ON SURFACE - BELOW YES

~~LEFT~~ - Q PAW'T. - RIGHT 60.6'


3.0 TO RT EDGE PAVEMENT

S.L.M. 796.164

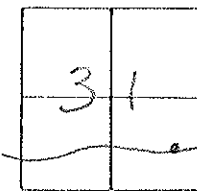

Point Set For P.I.
OBSERVED $\Delta: 10^{\circ} 14' 19''$ 9-26-88

RESET PK/WASHER
7-20-99
MB

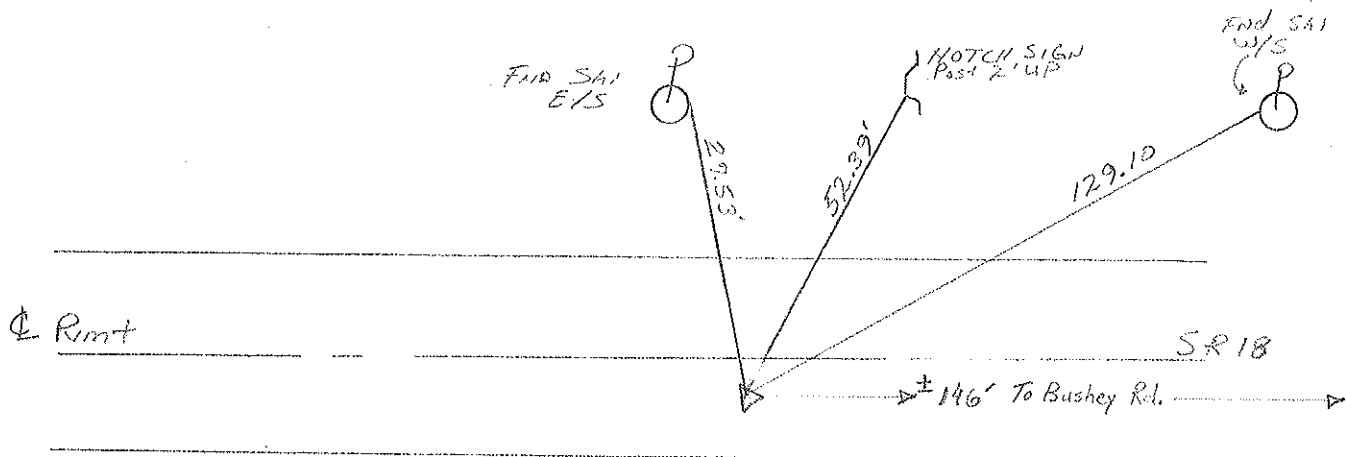

O.D.O.T. DISTRICT 2 SURVEY OFFICE

PERSONNEL

REFERENCE NO. 32A

SHEET OF

NOTES HOFFMAN

H.C. LOSHRKE

R.C. BARNHISEL

DATE 9-26-88

WEATHER CLEAR

TEMP. 72°

ROUTE SR 18

COUNTY WOOD

TOWNSHIP Bloom

SECTION 31

T.3 N R.11 E


TYPE MONUMENT P.K. / WASHER

ON SURFACE - BELOW YES

LEFT- & PAV'T. - RIGHT 6.6'

3.0 TO RT EDGE PAVEMENT

S.L.M.

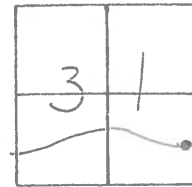

POINT SET FOR P.I.

OBSERVED $\Delta = 10^\circ - 14' - 17''$

