

O.D.O.T. DISTRICT 2 SURVEY OFFICE (USE ONLY)

PERSONNEL

REFERENCE NO. 33 G

SHEET 11 OF 35

NOTES NIESE

DATE 7/16/24

ROUTE SR 18

H.C. NIESE

WEATHER SUNNY

COUNTY WOOD

R.C.

TEMP. 80°

TOWNSHIP BLOOM

SECTION 31

DWG BY BARRIERE

PID NO PID

T 3 N R 11 E

TYPE MONUMENT MAG SHANK

ON SURFACE - BELOW ON

OFFSET $\varnothing$ PAVEMENT 0.2' ~~LT~~ : RT

9.3' TO RT EDGE PAVEMENT

STATION: 797+65.27

HORIZ.DATUM: NAD83 (2011)


GEOID: 18

GRID: NORTHING: 550359.150

EASTING: 1657098.142

LDP: NORTHING: 372263.682

EASTING: 169225.904

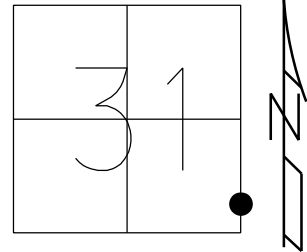

RECORD:

FD P.K. SHANK

6/16/99, MB

SET P.K./WASHER

7/20/99, MB

FD P.K./WASHER

REFG33

8/25/14, DCH


SET MAG/WASHER

11/05/14, DCH

FD MAG SHANK

REF33G

7/16/24, TDN

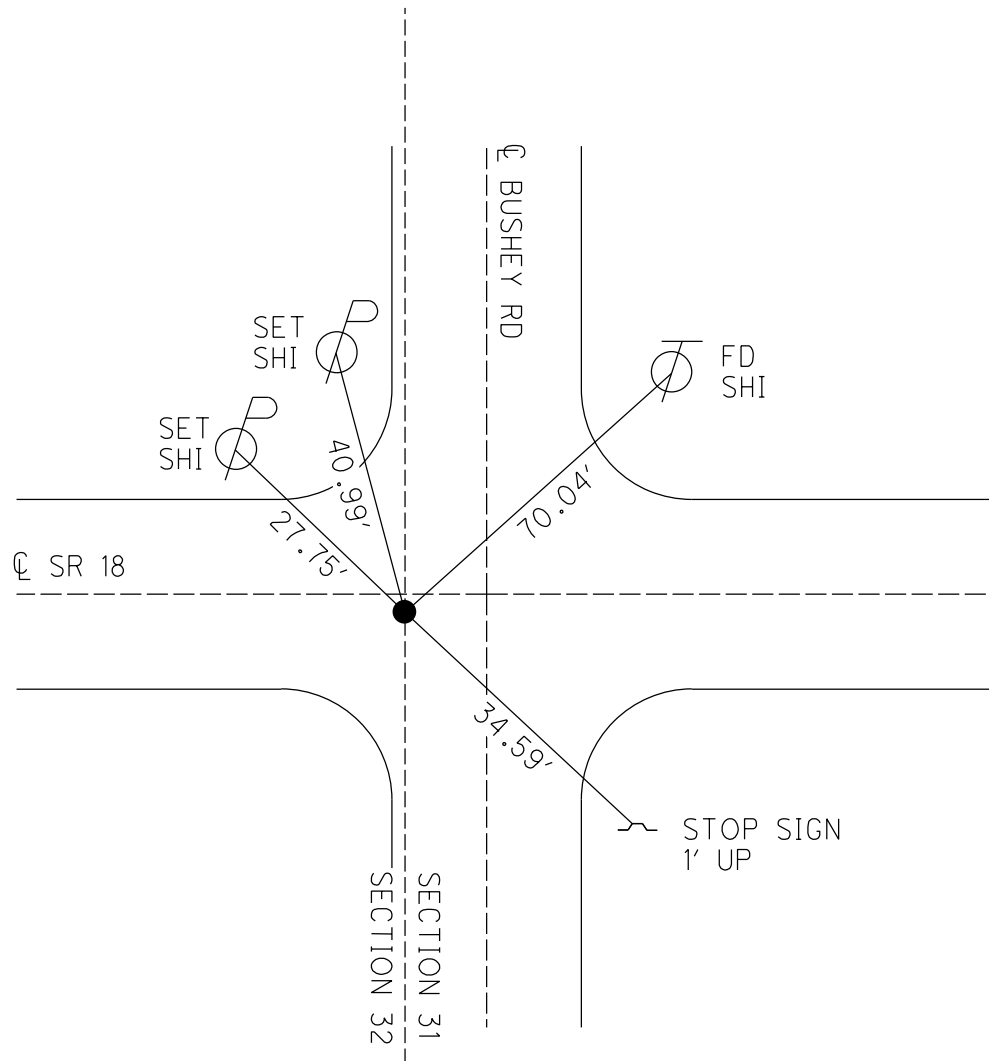

O.D.O.T. DISTRICT 2 SURVEY OFFICE (USE ONLY)

PERSONNEL

REFERENCE NO. 33 G

SHEET 11 OF 35

NOTES HOMAN

DATE 8/25/14

ROUTE SR 18

H.C. LEU

WEATHER SUNNY

COUNTY WOOD

R.C. RHOADES

TEMP. 80°

TOWNSHIP BLOOM

DWG BY MILLER

PID 93417

SECTION 31

T 3 N R 11 E

TYPE MONUMENT P.K.

ON SURFACE - ~~BELOW~~ ON

OFFSET CL PAVEMENT 0.2' LT : RT

TO EDGE PAVEMENT 5.2' FROM CL OF BUSHEY RD.


STATION: 797+65.27

HORZ.DATUM: NAD83 (2011)

GEOID: 2012A


GRID: NORTHING: 550359.150

EASTING: 1657098.142

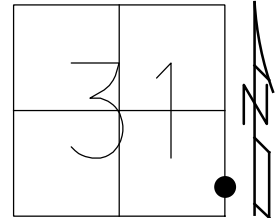

RECORD:

FD P.K. SHANK
6/16/99, MB
SET P.K./WASHER
7/20/99, MB
FD P.K./WASHER
REFG33
8/25/14, DCH
SET MAG/WASHER
11/05/14, DCH

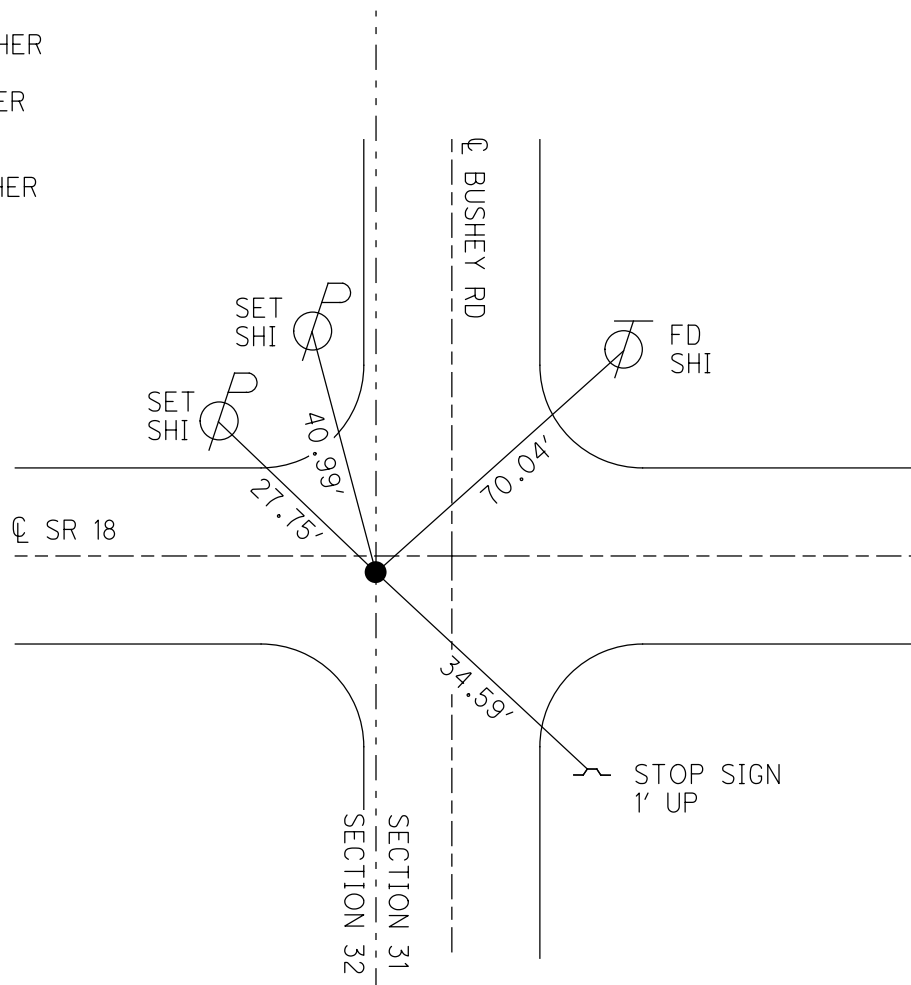

O.D.O.T. DISTRICT 2 SURVEY OFFICE

PERSONNEL

REFERENCE NO. _____

SHEET 6 OF 29

NOTES BARNHISEL

H.C. CANTERBURY

R.C. ROUSOS III

DATE 6-16-99

WEATHER CLOUDY

TEMP. +65°

ROUTE SR 18

COUNTY WOOD

TOWNSHIP Bloom

SECTION 31-32

T 3 N R 11 E


TYPE MONUMENT P.K. SHANK

ON SURFACE - BELOW 1" BELOW

LEFT - & PAV'T. - RIGHT 0.2' RT


TO EDGE PAVEMENT

S.L.M. 798 + 06

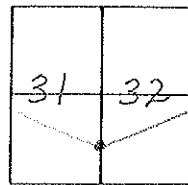

Point set By ASKINS-MERCER
ON Section Line & ON
LINE BETWEEN P.I.'s

RESET P.K. / WACHEN
7-20-99
M.B.

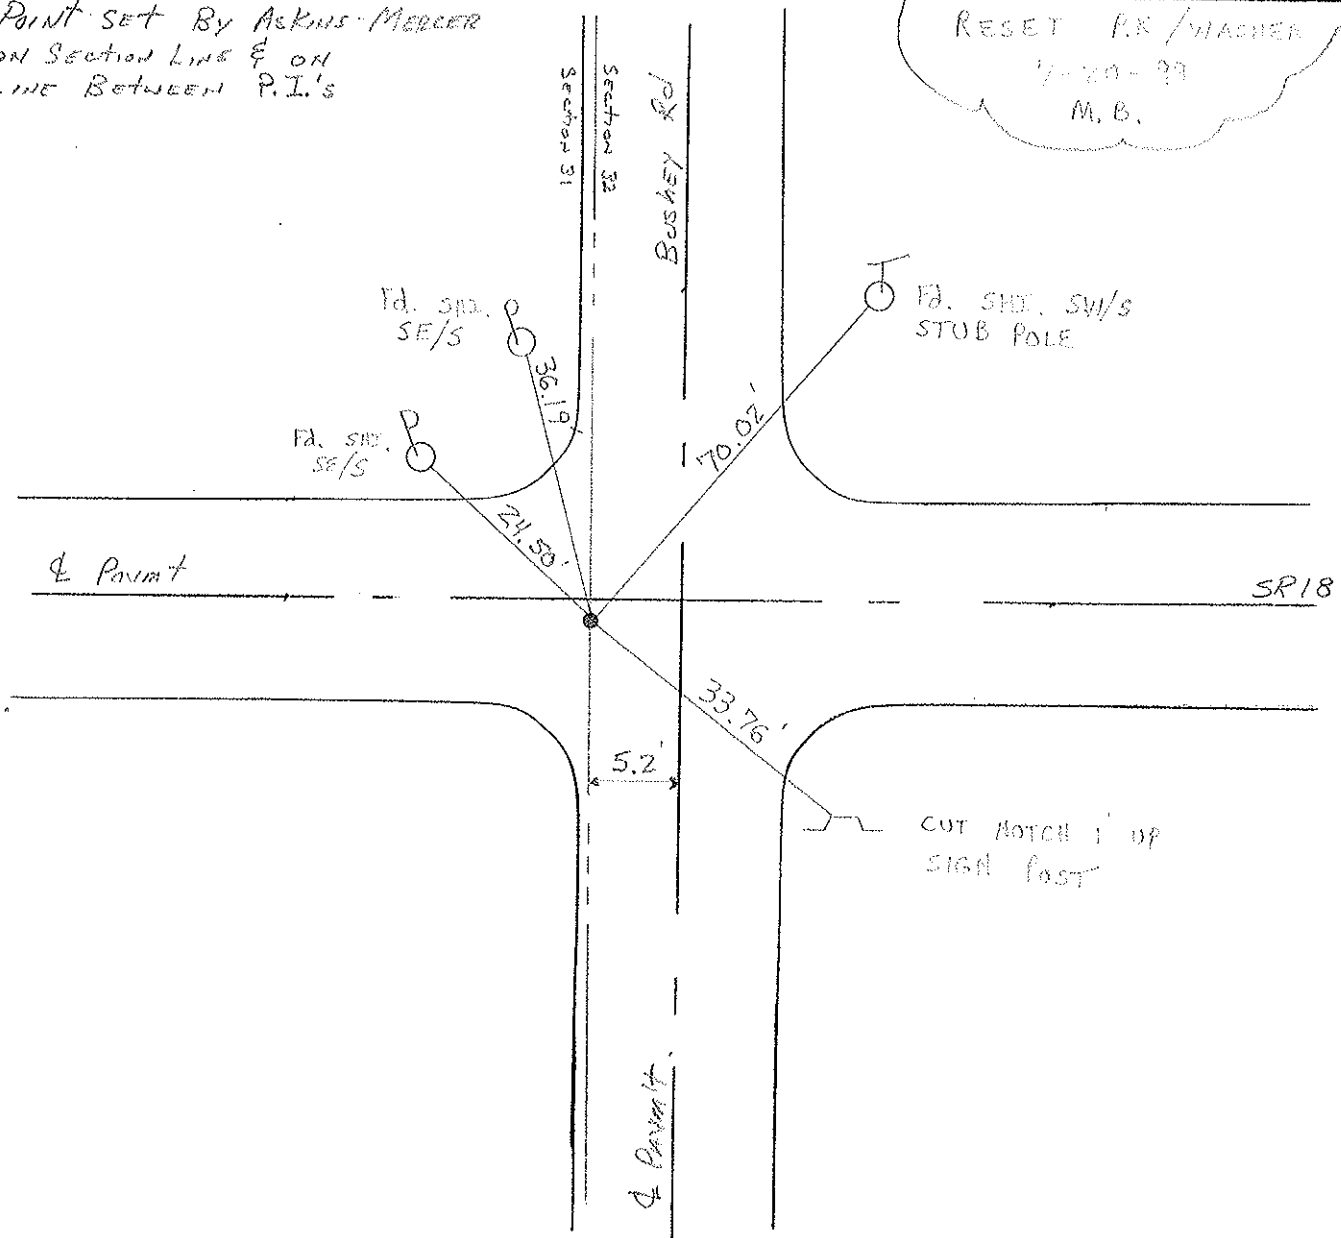

O.D.O.T. DISTRICT 2 SURVEY OFFICE

PERSONNEL

REFERENCE NO. 33

SHEET OF

NOTES HOFFMAN

H.C. LOEHKE

R.C. BARNHISEL

DATE 9-30-88

WEATHER CLEAR

TEMP. 74°

ROUTE SR 18

COUNTY WOOD

TOWNSHIP Bloom

SECTION 31-32

T.3 N R.11 E


TYPE MONUMENT P.K. Nail

ON SURFACE - BELOW YES

~~LEFT~~ & PAV'T. - RIGHT 0.2

TO EDGE PAVEMENT

S.L.M.

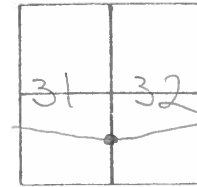

POINT SET BY ASKINS-MERCER
ON SECTION LINE & ON
LINE BETWEEN P.I.'S

