

RECORDED VOL 13, PG 27

9-8-67

WOOD COUNTY REC. OFFICE W00 20-3.00

FED. RD. DIVISION	STATE	PROJECT
2	OHIO	


43
491
7**CENTER LINE SURVEY PLAT**

MAUMEE AND WESTERN RESERVE ROAD

WOOD U.S. 20 SEC. 3.00

PERRYSBURG TOWNSHIP, WOOD COUNTY, OHIO

U.S.R. T 4 SECTION 9 & 10

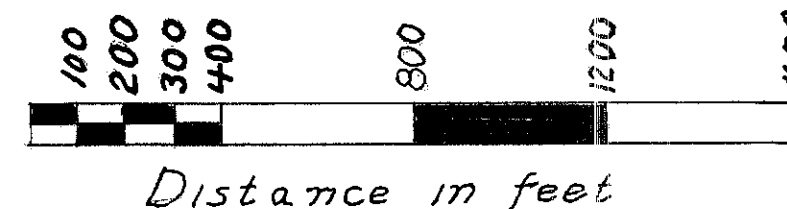

Monuments will be set in accordance with the construction plans at the following Stations

STATION	LOCATION	604	REMARKS
		Standard Monument Box EACH	
10+79.55	Survey	1	US 20
135+73.75	Survey	1	US 20
0+69.85	Survey	1	Simmons Rd
151+00.00	Survey	1	U.S. 20

Signed
Date 5-5-67

Raymond H. Rice
 Raymond H. Rice
 Division Deputy Director
 Professional Engineer
 Registration Number 666 E

I-75 SURVEY & CURVE DATA

P.I. Sta. 164+09.65
 Δ 8° 57' 19"
 D 0° 28'
 R 12,277.67
 T 961.45
 L 1,918.99

Begin Project 108+51.50
 End Project 156+00.00

Begin Work 108+51.50
 End Work 169+43.00

I, hereby certify that this is a true delineation of a survey made by the Ohio Department of Highways in 1966.

May 3, 1967
 Date


Robert J. Smith
 Surveyor
 Registration # 4063

Scale 300' = 1"

FED. RD. DIVISION	STATE	PROJECT	
2	OHIO		

Woo 20 3.00

44
49

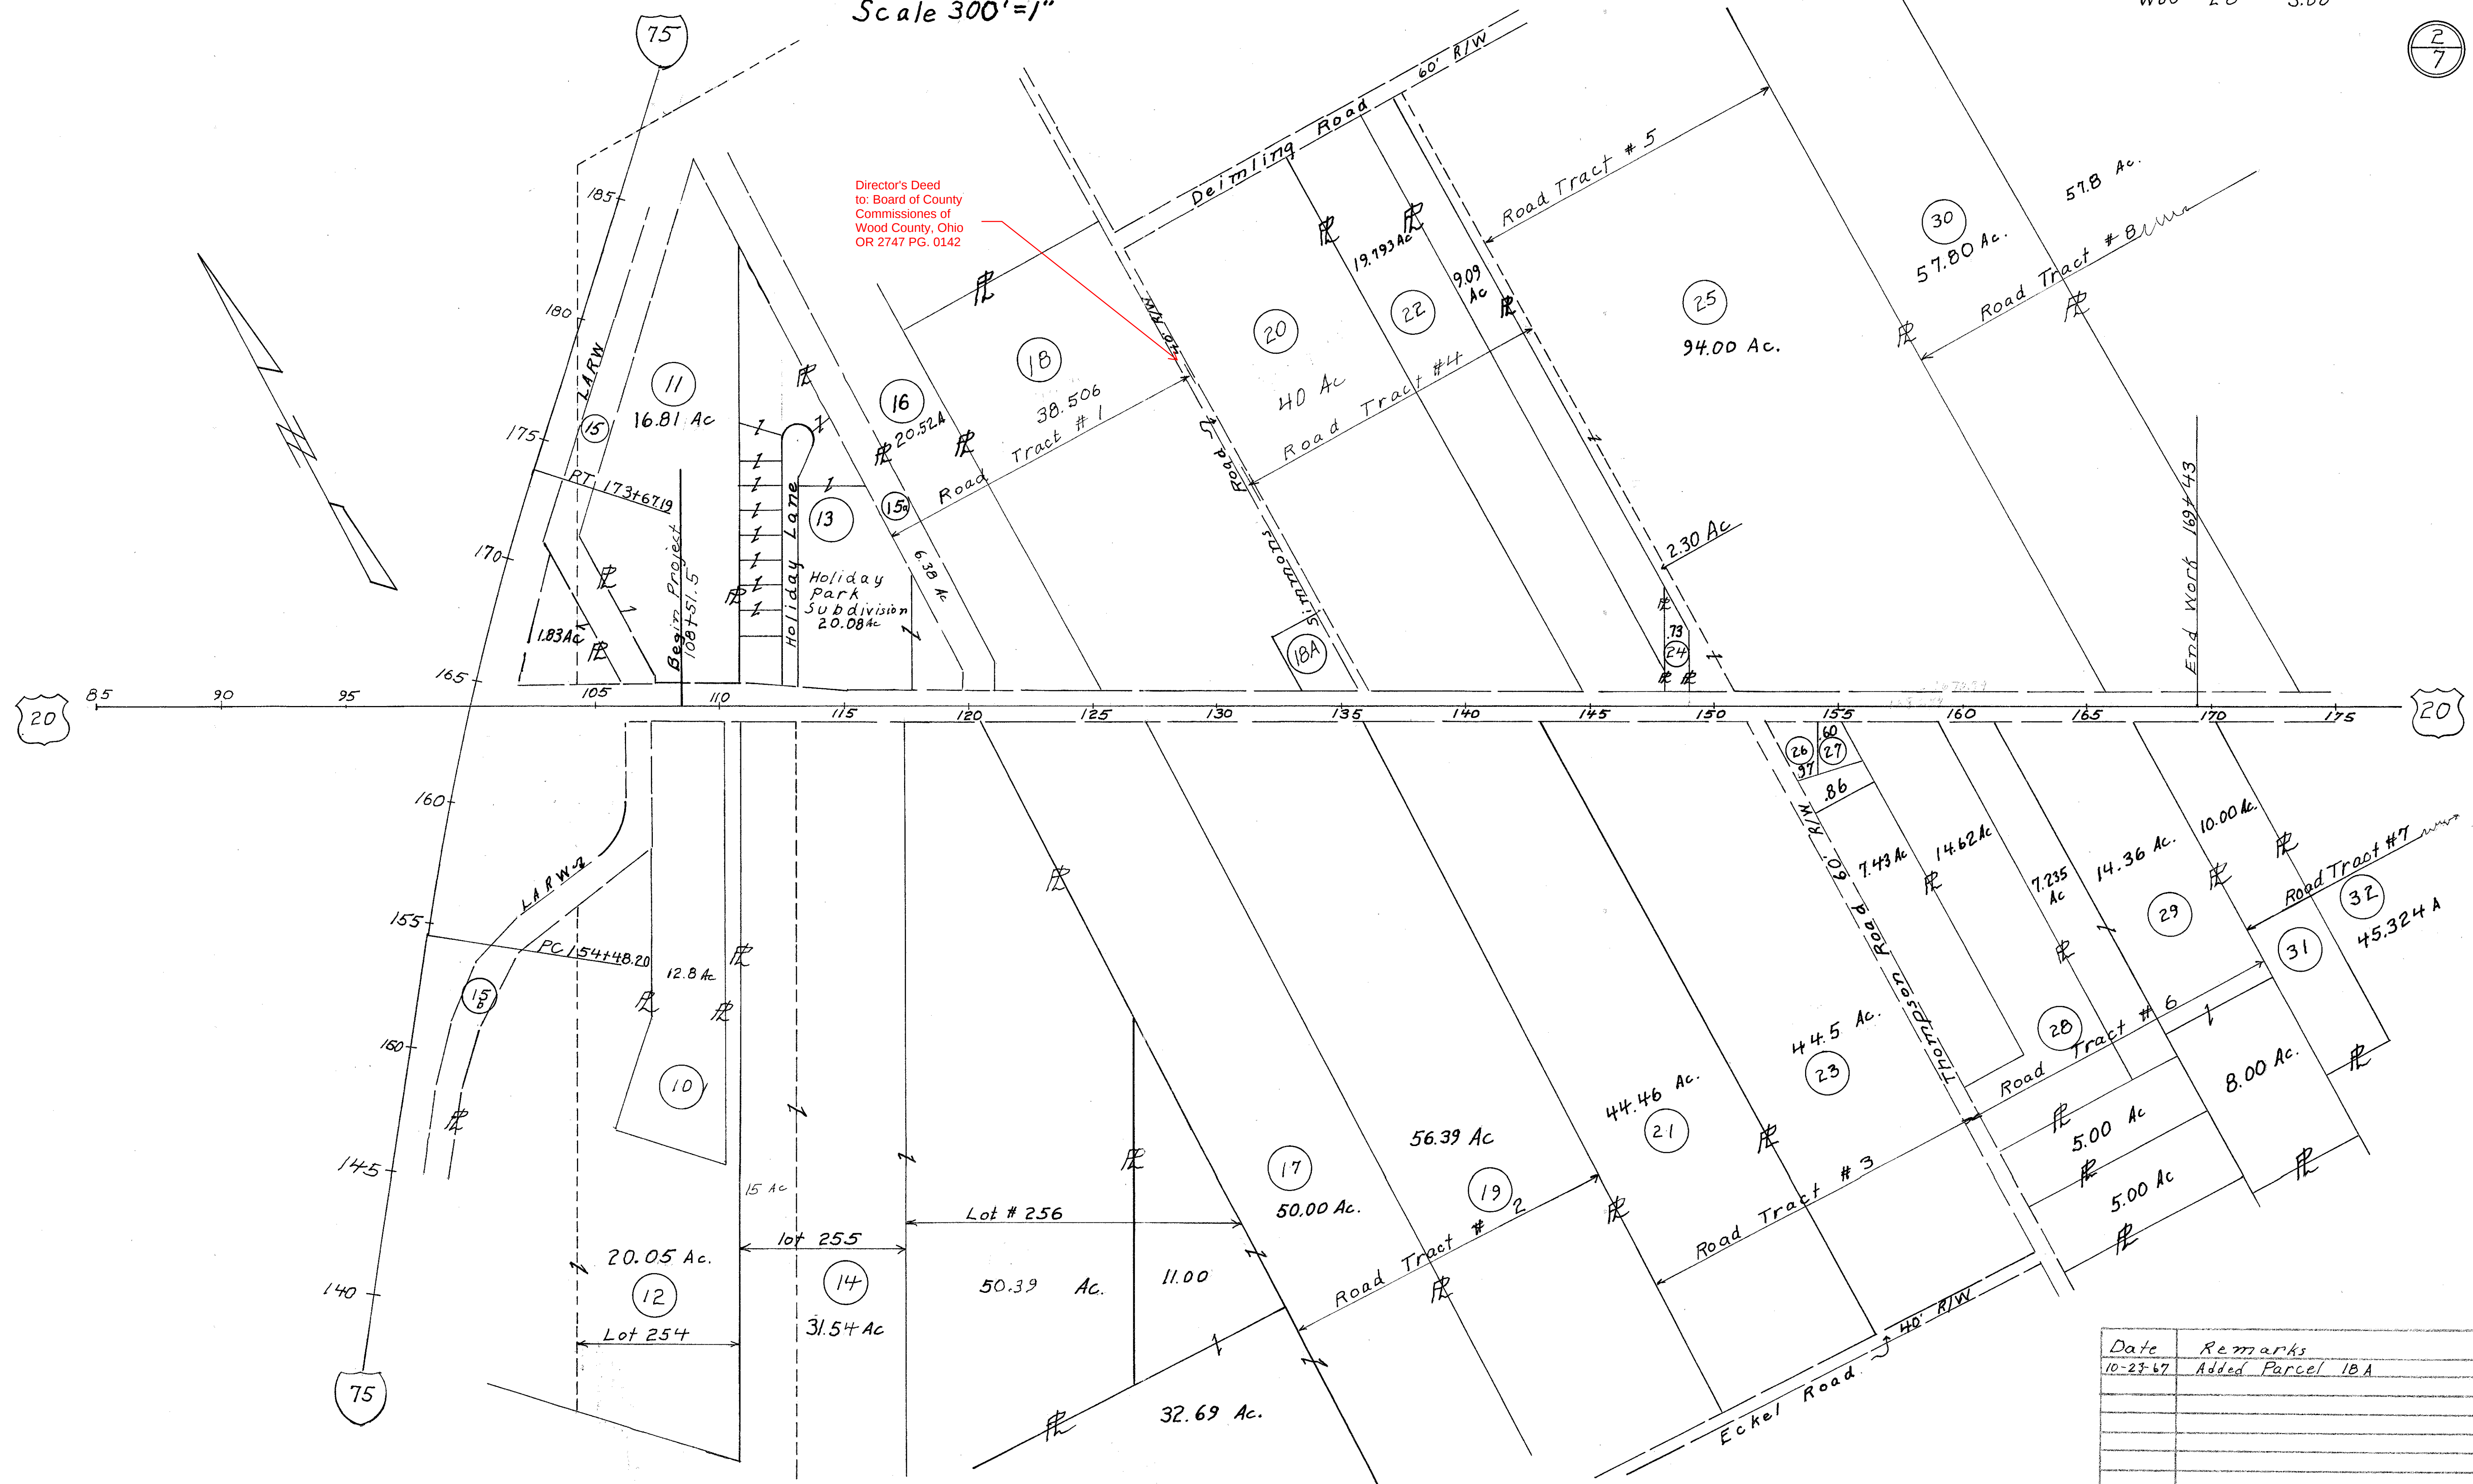[illegible]

Property Map

SUMMARY OF ADDITIONAL RIGHT-OF-WAY REQUIRED

PARCEL NO.	OWNER	DEED RECORD		DEED AREA		TO BE ACQUIRED				PRO IN TAKE		BLDGS	RESIDUE				SHEET NO.	REMARKS
		BOOK	PAGE	ACRES	SQ FT	GROSS TAKE		NET TAKE		Acres	Sq Ft		LEFT		RIGHT			
						Acres	Sq Ft	Acres	Sq Ft				Acres	Sq Ft	Acres	Sq Ft		
10	Sun Oil Company	439	779	12.8														
11	Herbert E & Helen G Roether	320	629	16.81														
12	Dorothy E Shirk	417	433	20.05														
13	Sylvania Development Corp.	442	502	20.08		0.353	15,374	0.302	13,173	0.051	2,201	—	17.655		0.00		Area Corrected Total PRO=1.7	
13 WA																		
13A-WA																		
14	Mary Lober Miller	363	369	96.98		0.00		0.00		0.00							Total PRO 0.00	
14 X						0.043	1857.5	0.043	1857.5	0.00	0.00		0.00		96.937			
15	State of Ohio	424	723	7.10		0.00		0.00										
15a	State of Ohio	424	665	6.38														
15b	State of Ohio			6.62														
16	William L & Wilma Seiling	321	311	20.52		0.194		0.194		0.00		—	20.326		0.00		Total PRO = 0.00	
17SL	Harold H Goeke et al	427	321	93.69		0.077	3369.88	0.077	3369.88	0.00		—					Total PRO = 0.516	
17X						0.010	454.74	0.010	454.70	0.00		—	0.00		93.087			
17T						0.076	3312.45	0.076	3312.45	0.00		—						
18	Alma Cranker	189	219	38.506	—	0.366	—	0.366	—	0.000	—	—	37.317	—	—	—	6 Total PRO=0.823	
18A	Mary E Cranker	451	771	1.494	65,059	0.168	7,336	0.132	5,743	0.036	1593	—	1.199	52,235			6 Area Corrected Total PRO 0.163	
19	Harvey L & Vera M Moser	425	168	56.39		0.00		0.00		0.00		—	0.00		56.053		Total PRO=0.337	
19T		425	166			0.314	13,683.42	0.314	13,683.42	0.00		—						
		405	379															
20	Marie Wentz	464	403	40		0.533		0.463		0.070			38.058		0.00		Total PRO 1.479	
		322	431															
21	Mary A Goeke	421	547	44.46		0.00	0.00	0.00	0.00	0.00			0.00		44.162		Total PRO - 0.298	
21T						0.236	10,272.79	0.236	10,272.79									
22	Par Holding Company	441	911	19.793		0.120		0.120		0.00			19.488		0.00		Total PRO = 0.185	
23	John A Caple	270	427	44.5		0.225	9786.58	0.128	5,582.08	0.097	4,204.5		0.00		42.35		Total PRO = 2.022	
23T						0.318	13,855.03	0.318	13,855.03	0.00								
24	Nora M. Hagemyer	452	845-846	0.73		0.033		0.033		0.00			0.697		0.00		Total PRO = 0.00	
25	Gertrude May Hufford et al	245	604	96.30		0.771		0.771		0.00			94.592		0.00		Total PRO = 0.937	
		246	178															
		247	269															

Date	Remarks
10-23-67	Added Parcel 18A
12-14-67	Owner Change Parcel 24
9-15-69	Par 20 1 owner name deleted

WOOD COUNTY OHIO Number of Owners

FED. RD. DIVISION	STATE	PROJECT
2	OHIO	

WOOD 20 3.00

46
49

4
7

SUMMARY OF ADDITIONAL RIGHT-OF-WAY REQUIRED


PARCEL NO.	OWNER	DEED RECORD		DEED AREA		TO BE ACQUIRED				PRO IN TAKE		BLDGS	RESIDUE				SHEET NO.	REMARKS
		BOOK	PAGE	ACRES	SQ. FT.	GROSS TAKE		NET TAKE		Acres	Sq. Ft.		LEFT		RIGHT			
						Acres	Sq. Ft.	Acres	Sq. Ft.				Acres	Sq. Ft.	Acres	Sq. Ft.		
26	Gene L & Betty J. Clark	432	538	0.97		0.065	2842.16	0.025	1098.6	0.040	1743.6	—			0.712		Total PRO = 0.193 Ac	
26 T						0.019	806.9	0.019	806.9	0.00	0.00	—						
27	Paul W Kemerer	432	679	0.60	25956.77										0.60	25956.77	Total PRO = 0.00	
27 T						0.010	457.24	0.010	457.24	0.00	0.00	—						
28	John E Gabrielson et al	424	732	14.62								—			14.431		Total PRO = 0.189	
28 T		311	241			0.184	8025.75	0.184	8025.75	0.00	0.00	—						
		311	243															
		393	592															
29	Earl J. & Alice C Kerby	(440)	(553)	(7.235)								—						
29 X		440	559	14.36		0.017	741.84	0.017	741.84	0.00	0.00	—			29.578		Total PRO = 0.00	
29 T		440	561	8.00		0.315	13732.56	0.315	13732.56	0.00	0.00	—						
30	Lyle E Eckel et al	227	454	57.80		0.00	0.00	0.00	0.00			—					Total PRO = 0.00	
31	Agnes C. Bayer	399	266	10.00														
31 X						0.028	1208.26	0.028	1208.26			—			9972		PRO = 0.00	
31 T						0.034	1474.85	0.034	1474.85			—						
32	Arthur J. & Jessie L Brinker	399	263	45.324		—	—	—	—			—						
33	John C. Maddy	246	114	97.01		—	—	—	—			—						

FED. RD. DIVISION	STATE	PROJECT
2	OHIO	



W00 20 3.00

47
49


5
7

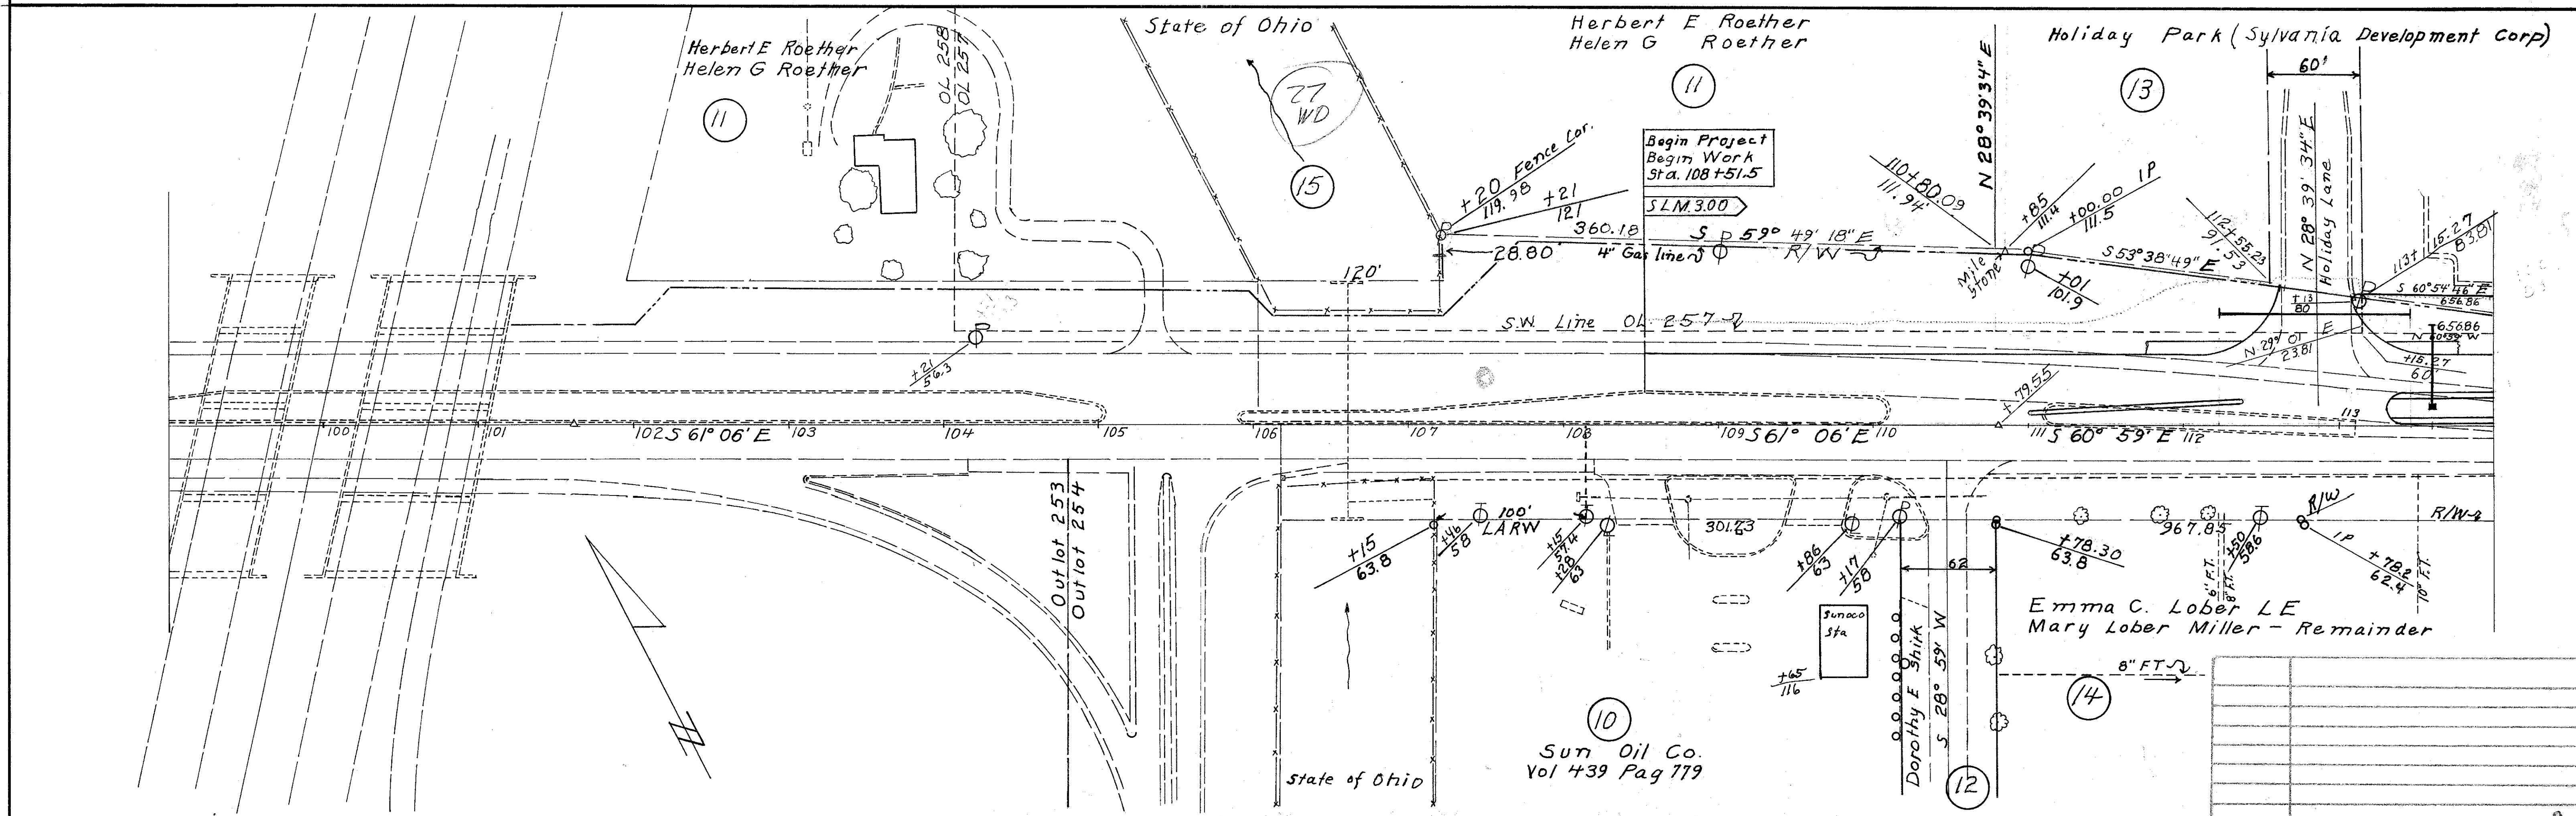

Surveyed July 1977

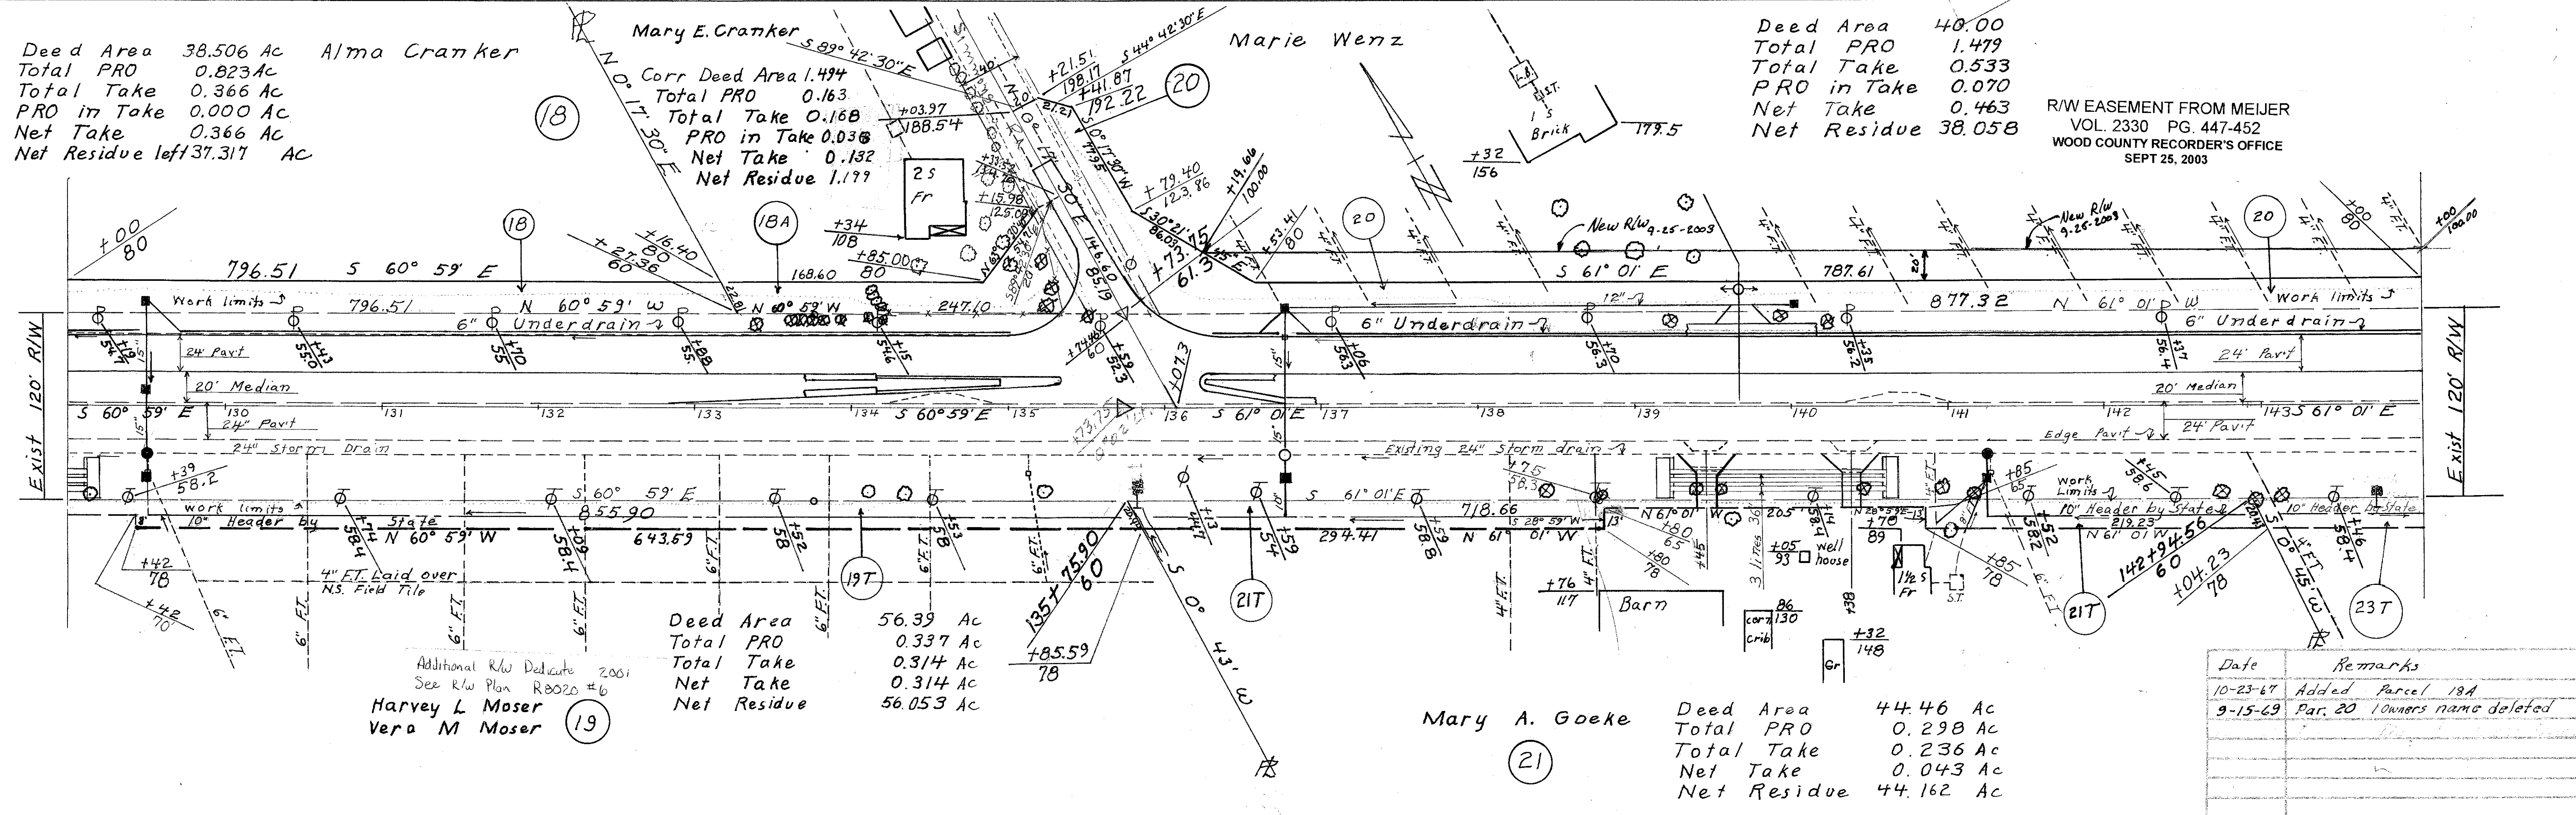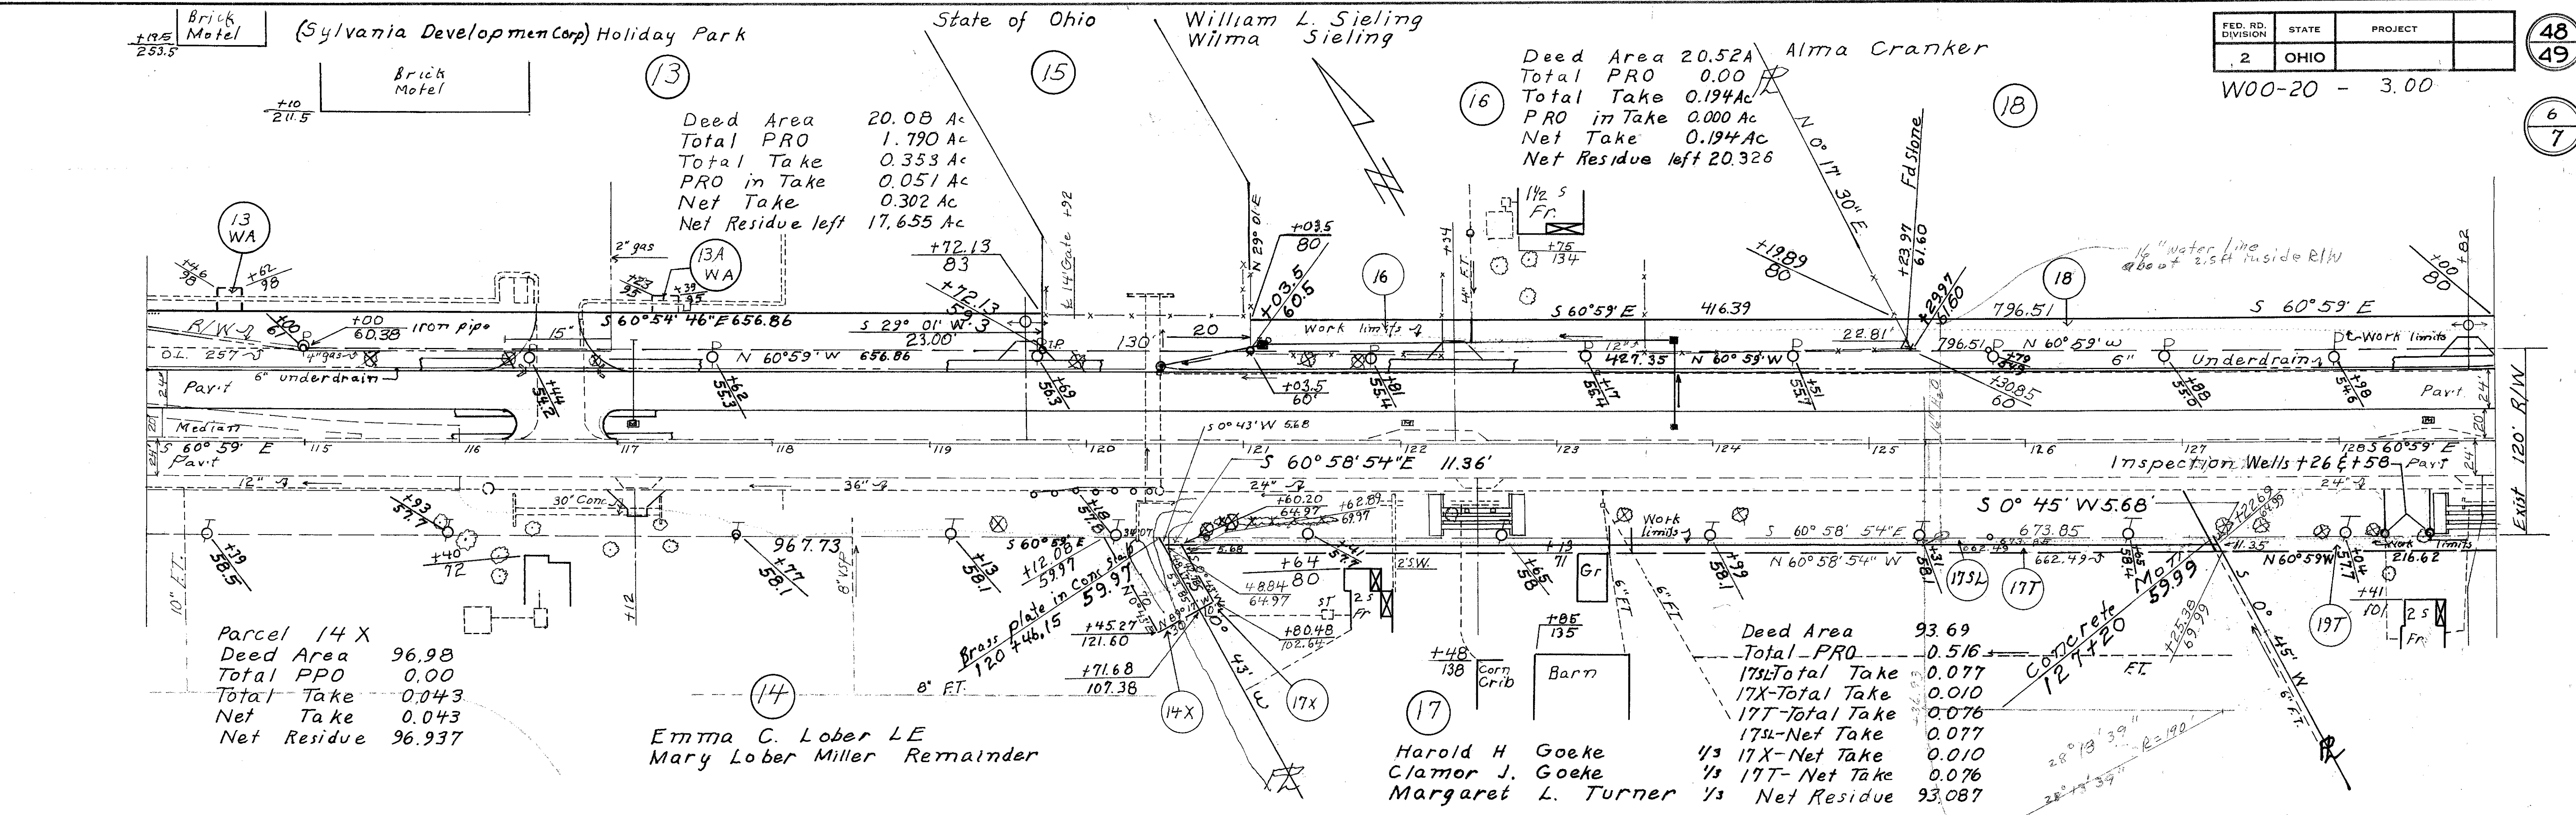

Date	Remarks
10-23-67	Added Parcel 18A
9-15-69	Par. 20 Owners name deleted

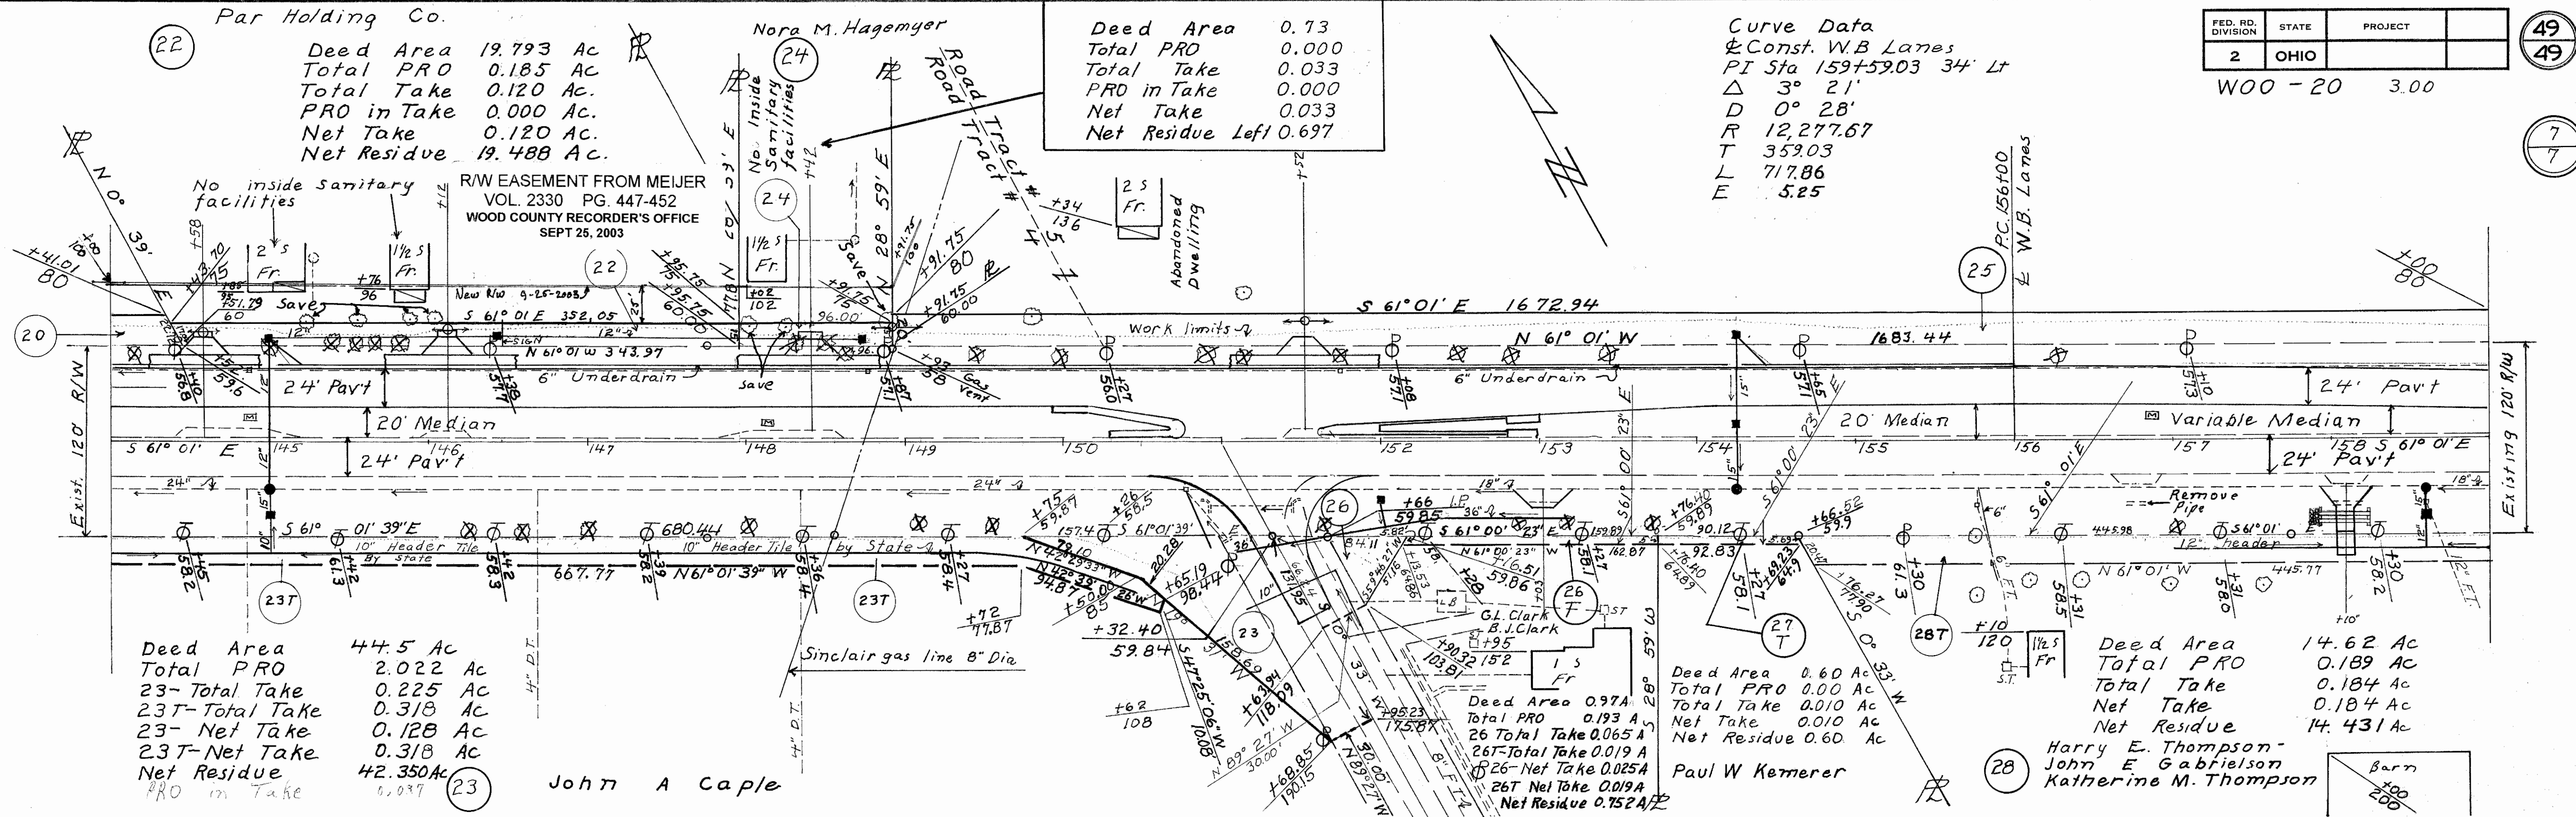

Date	Remarks
12-14-67	Owner Change Par. 24