

O.D.O.T. DISTRICT 2 SURVEY OFFICE (USE ONLY)

PERSONNEL

REFERENCE NO. D0

SHEET OF

NOTES NIESE

DATE 11/16/23

ROUTE SR 25

H.C. AUBLE

WEATHER CLEAR

COUNTY WOOD

R.C. NIESE

TEMP. 65°

TOWNSHIP HENRY

DWG BY BARRIERE

PID 92133

SECTION 1

T 3 N R 10 E

TYPE MONUMENT MONBOX W/ 1" IPIN

ON SURFACE - BELOW ON

OFFSET $\varnothing$ PAVEMENT ON LT : RT


 TO EDGE PAVEMENT

STATION: 16+51.70


HORIZ.DATUM: NAD83(11)/WOOD LDP GEOID: 18

GRID: NORTHING: 576725.210 EASTING: 1651709.299

LDP: NORTHING: 398558.560 EASTING: 163489.343

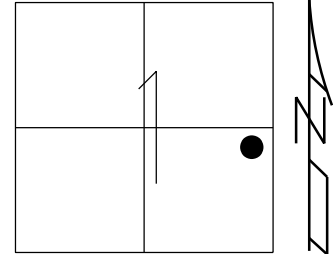

RECORD: P.C.
PLAN STA.16+47.10
FD MONBOX
4/12/01, TMR
FD MONBOX (NO LID)
W/ 3/4" IPIN
REFDO
3/17/22, JFO
FD NEW MONBOX
W/ 1" IPIN
SHOT WITH GPS,
DID NOT PULL TIES
NEWREFDO
11/16/23, TDN

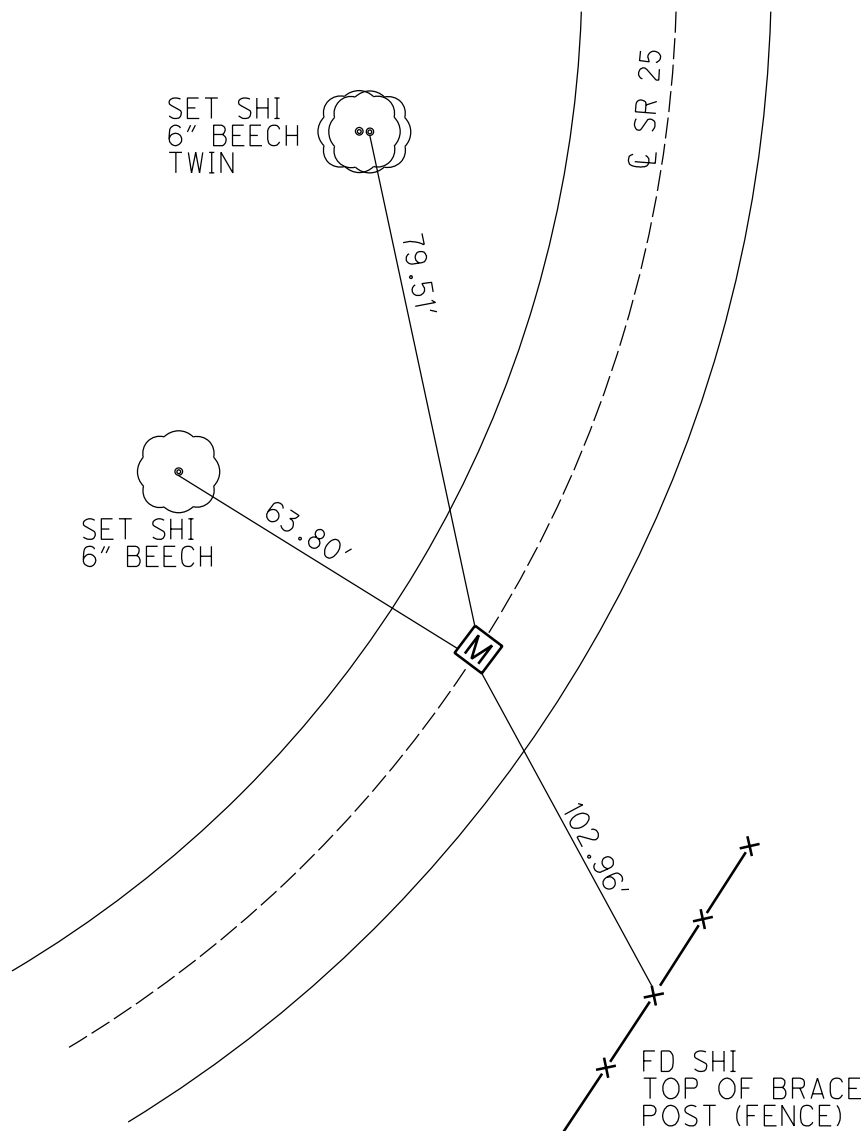

O.D.O.T. DISTRICT 2 SURVEY OFFICE (USE ONLY)

PERSONNEL

REFERENCE NO. D

SHEET 4 OF 36

NOTES HUSS
H.C. ROUSOS
R.C. VAN DUSEN

DATE 4/12/01
WEATHER CLOUDY/WINDY
TEMP. 72°

ROUTE SR 25
COUNTY WOOD
TOWNSHIP HENRY
SECTION 1

DWG BY MILLER PID

T 3 N R 10 E

TYPE MONUMENT MONBOX

ON SURFACE - ~~BELOW~~ ON

OFFSET 11.7' TO RT ~~LT:RT~~ PAVEMENT


STATION: 44+08.80

HORIZ.DATUM:


GEOID:

GRID: NORTHING:

EASTING:

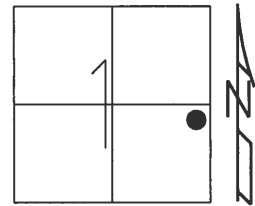

RECORD: P.C.
PLAN STA. 16+47.10
FD MONBOX
4/12/01, TMR

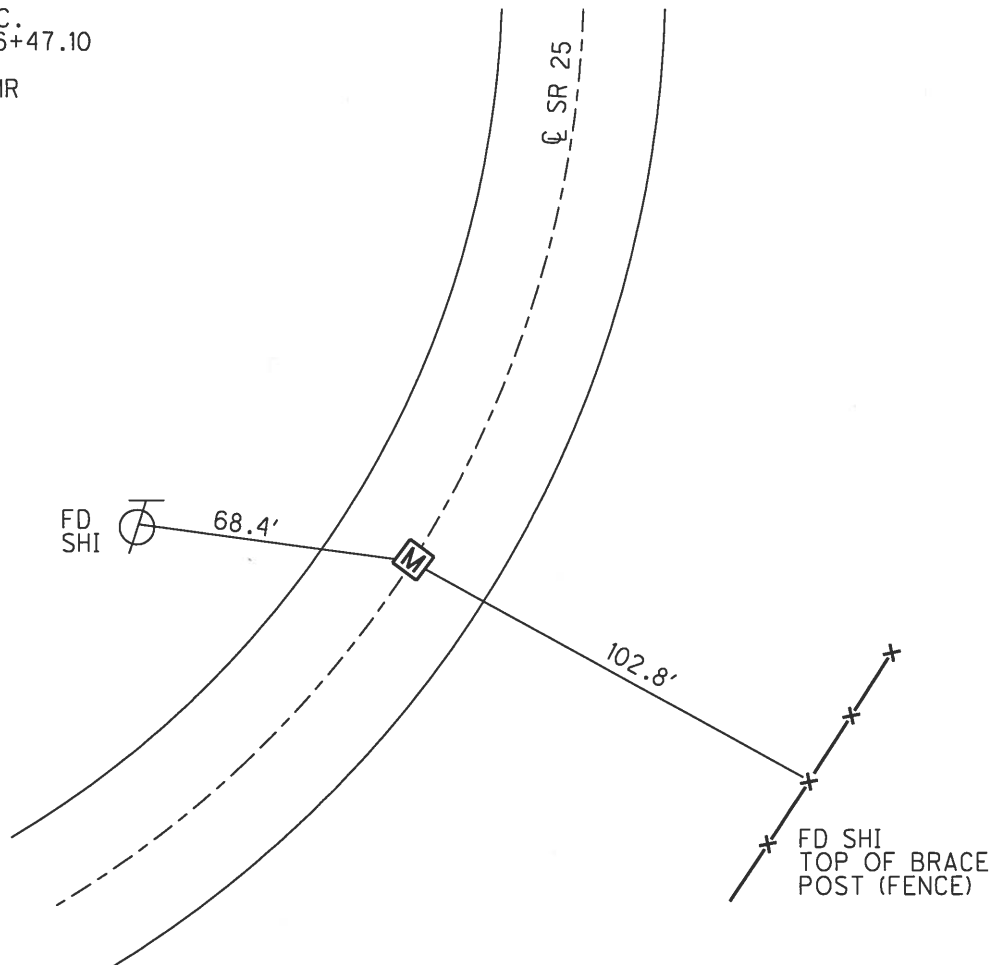

O.D.O.T. DISTRICT 2 SURVEY OFFICE

PERSONNEL

REFERENCE NO. _____

SHEET 2 OF 23

NOTES Huss

H.C. Rousos

R.C. Van Dusen

DATE 4-12-01

WEATHER Pt Cloudy - Windy

TEMP. 72°F

ROUTE SR-25

COUNTY Wood

TOWNSHIP Henry

SECTION 1

T 3 N R 10 E


TYPE MONUMENT Mon Box

ON SURFACE - ~~BELOW~~ Surface

~~LEFT~~ - E PAV'T - ~~RIGHT~~

11.3, 11.7 TO RT EDGE PAVEMENT

S.L.M. (A) 86+48.48 (B) 44+08.80

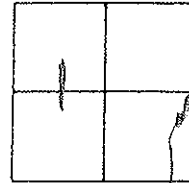

Record:

(A) R.B. Plan Sta: PC
8+92.10 (0.69) SLM

(B) MVB Plan Sta: PT
16+47.10 (0.835) SLM


Fd N/shi
5' up

Fd N/shi

Fd Nail/Shi
Top of N. Brace Post
Fence

Fd N/shi
Top of N. Brace
Post (Fence)

SR-25

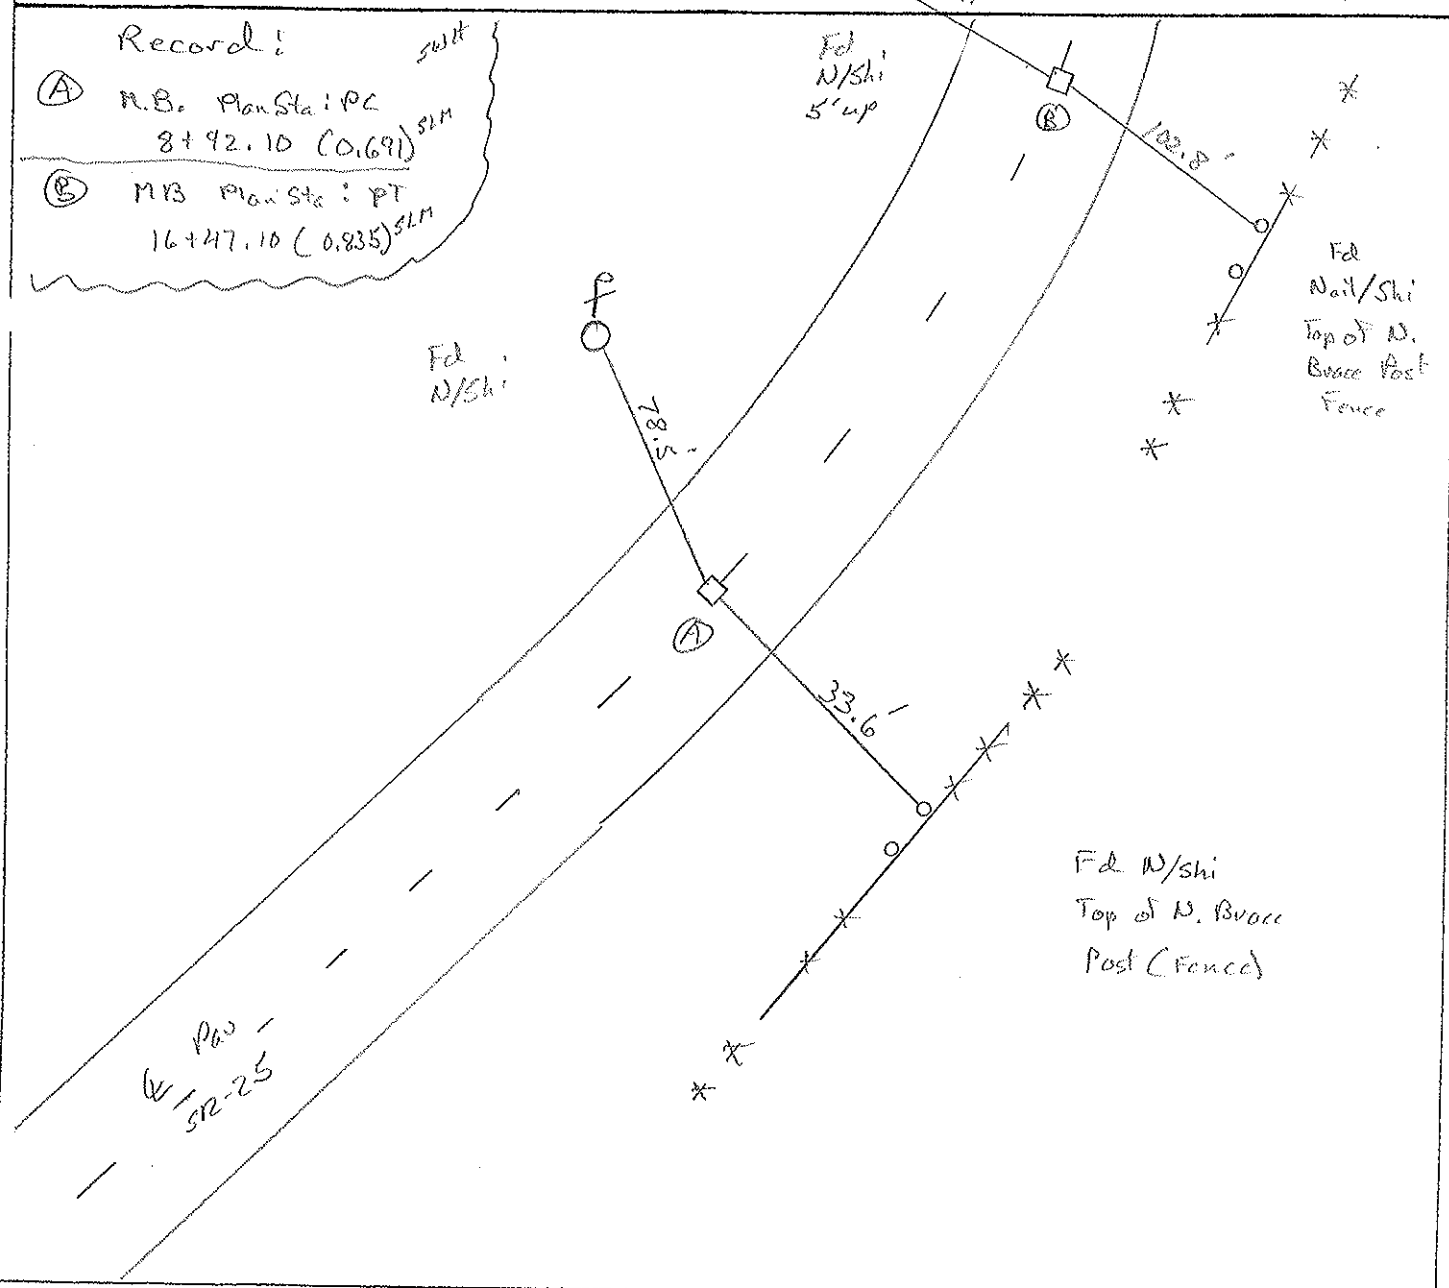

O.D.O.T. DISTRICT 2 SURVEY OFFICE

PERSONNEL

REFERENCE NO. _____

SHEET 2 OF 23

NOTES HOFFMAN

H.C. LOENRKE

R.C. Bazantise

DATE 3-22-91

WEATHER Cloudy

TEMP. 53°

ROUTE SR 25

COUNTY Wood

TOWNSHIP HENRYSECTION 1

T3NR05

TYPE MONUMENT M.O.A. Box

ON SURFACE - BELOW Yes

LEFT - C PAN'T. - RIGHT YES

TO RT EDGE PAVEMENT

S.L.M. 36+48.48 $\frac{1}{2}$ 44+08.80

