

O.D.O.T. DISTRICT 2 SURVEY OFFICE (USE ONLY)

PERSONNEL

REFERENCE NO. E0

SHEET OF

NOTES ASTON

DATE 5/15/24

ROUTE SR 25

H.C. NIESE

WEATHER WINDY

COUNTY WOOD

R.C. PRESTON-COLVIN

TEMP. 65°

TOWNSHIP HENRY

DWG BY BARRIERE

PID 92133

SECTION 1

T 3 N R 10 E

TYPE MONUMENT MONBOX W/ 1" IPIN

ON SURFACE - BELOW 11" BELOW

OFFSET Q PAVEMENT 34' LT : RT


 TO EDGE PAVEMENT

STATION: 27+62.50


HORIZ.DATUM: NAD83(11)/WOOD LDP GEOID: 18

GRID: NORTHING: 577745.261 EASTING: 1652147.685

LDP: NORTHING: 399584.385 EASTING: 163914.276

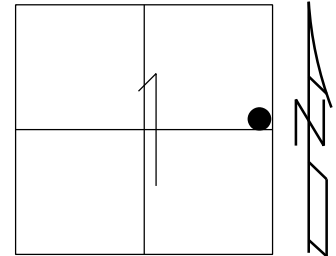

RECORD: P.C.
PLAN STA. 27+57.77
FD MONBOX
4/12/01, TMR
FD MONBOX (NO LID)
W/ 3/4" IPIN
REFE0
3/17/22, JFO
FD NEW MONBOX
W/ 1" IPIN
SHOT WITH GPS,
DID NOT PULL TIES
NEWREFE0
11/16/23, TDN

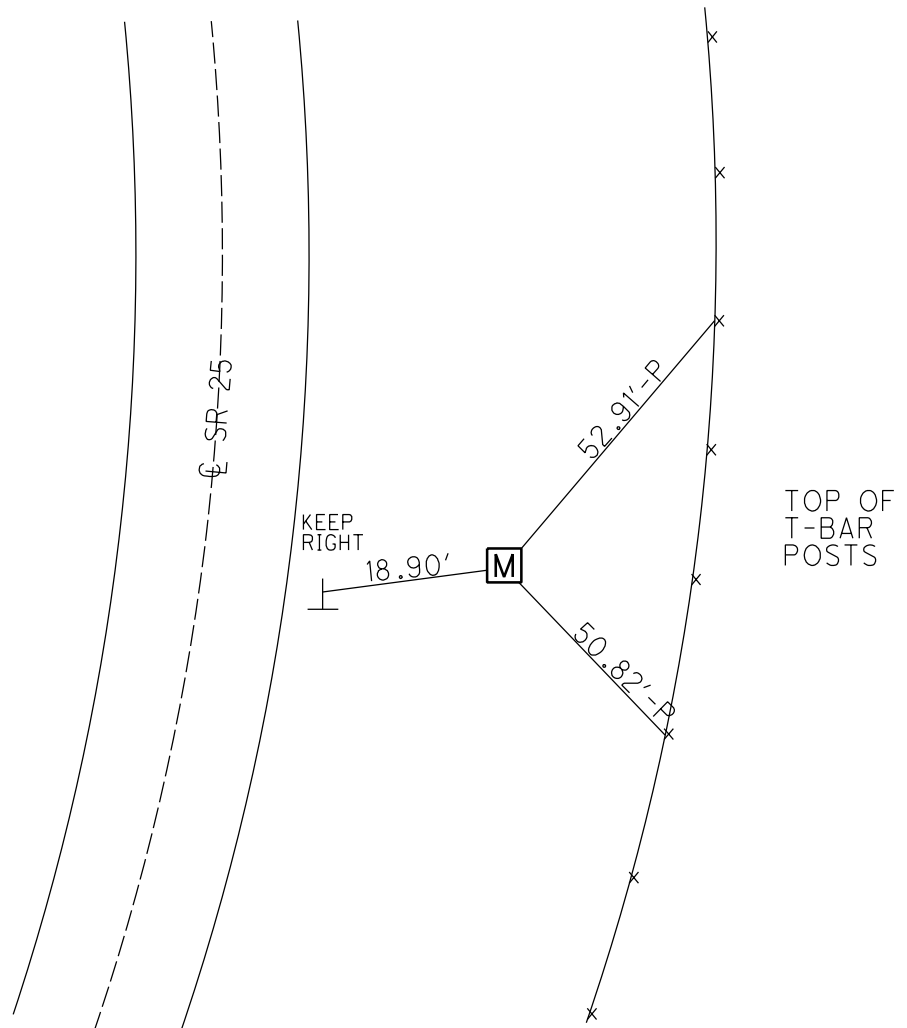

O.D.O.T. DISTRICT 2 SURVEY OFFICE (USE ONLY)

PERSONNEL

REFERENCE NO. E

SHEET 5 OF 36

NOTES HUSS

DATE 4/12/01

ROUTE SR 25

H.C. ROUSOS

WEATHER CLOUDY/WINDY

COUNTY WOOD

R.C. VAN DUSEN

TEMP. 72°

TOWNSHIP HENRY

DWG BY MILLER

PID

SECTION 1

T 3 N R 10 E

TYPE MONUMENT MONBOX

ON SURFACE - ~~BELOW~~ ON


OFFSET Q PAVEMENT ON LT:RT

11' TO RT EDGE PAVEMENT


STATION: 55+12.32

HORZ.DATUM: GEOID:

GRID: NORTHING: EASTING:

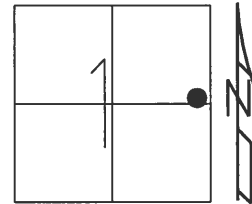

RECORD: P.C.
PLAN STA.27+57.77
FD MONBOX
4/12/01, TMR

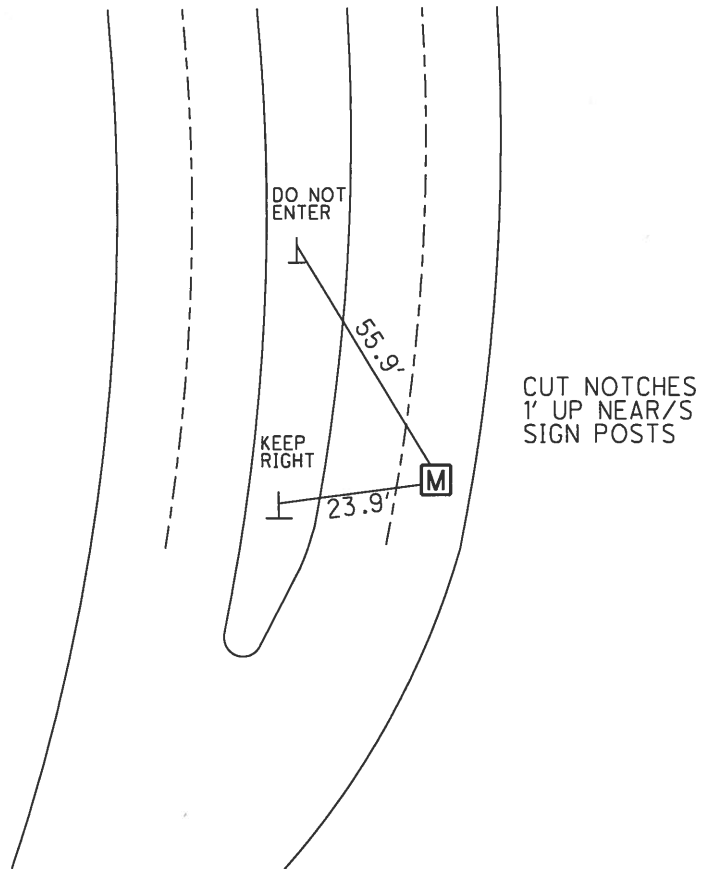

O.D.O.T. DISTRICT 2 SURVEY OFFICE

PERSONNEL

REFERENCE NO. _____

SHEET 3 OF 23

NOTES Huss

H.C. Roussos

R.C. Van Dusen

DATE 4-12-01

WEATHER Pt Cldy-Windy

TEMP. 72°F

ROUTE SR-25

COUNTY Wood

TOWNSHIP Henry

SECTION 1

T 3 N R 10 E


TYPE MONUMENT Mon Box

ON SURFACE - ~~BELOW~~ Surface

~~LEFT~~ - E PAV'T - ~~RIGHT~~ E N.B. Pav

11.0, 11.7 TO RT EDGE PAVEMENT

S.L.M. (A) 55+12.32 (B) 59+61.12

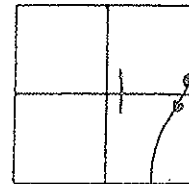


Record:

(A) Mon Box
Plan Sta - PC 27+57.77
SLM - 1.044

(B) Mon Box
Plan Sta - PT 31+97.77
SLM - 1.129 S.W.H.

Fd N/shi
F/S M.B. Post
For Wayne Homes

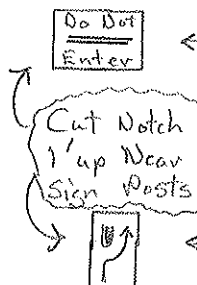

140.1'

(B)

184.1'
(Rec)

55.9'

(A)

23.9'

Fd N/shi
Top of
brace post
For fence



O.D.O.T. DISTRICT 2 SURVEY OFFICE

PERSONNEL

REFERENCE NO. _____

SHEET 3 OF 23

NOTES HOFFMAN

H.C. LOEHRS

R.C. BARNHISEL

DATE 3-22-91

WEATHER Cloudy

TEMP. 55°

ROUTE S.R. 25

COUNTY WOOD

TOWNSHIP HENRY

SECTION 1

T. 3 N R. 10 E

TYPE MONUMENT Mon. Box

ON SURFACE - BELOW yes

LEFT- & PAW'T. - RIGHT yes

11.0' 11.7' TO RT. EDGE PAVEMENT

S.L.M. 55+12.32 & 59+61.12

(E) (F)

