

O.D.O.T. DISTRICT 2 SURVEY OFFICE (USE ONLY)

PERSONNEL

REFERENCE NO. 1

SHEET OF

NOTES ASTON

DATE 5/15/24

ROUTE SR 25

H.C. NIESE

WEATHER BREEZY

COUNTY WOOD

R.C. PRESTON-COLVIN

TEMP. 65°

TOWNSHIP BLOOM

DWG BY BARRIERE

PID 92133

SECTION 6

T 3 N R 11 E

TYPE MONUMENT MONBOX W/ 1" IPIN

ON SURFACE - BELOW ON

OFFSET $\varnothing$ PAVEMENT ON LT : RT


 TO EDGE PAVEMENT

STATION: 54+00.29


HORIZ.DATUM: NAD83(11)/WOOD LDP GEOID: 18

GRID: NORTHING: 580369.977 EASTING: 1652283.680

LDP: NORTHING: 402210.879 EASTING: 164015.659

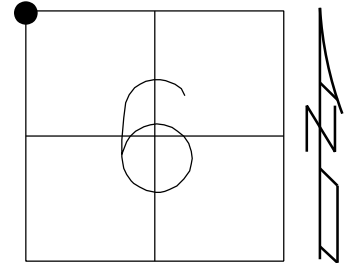

RECORD:
 $\varnothing$ PAVEMENT
 1958
 FD P.K./WASHER
 4/12/01, TMR
 SET PK/WASHER
 10-29-01, SAH
 FD P.K.NAIL
 REF1
 5-30-18
 10-1-18, JFO
 FD MAG NAIL ATOP
 BRASS DISK
 REF1
 3/17/22, JFO
 ORIGIN UNKNOWN
 FD NEW MONBOX
 W/ 1" IPIN
 NEWREF1
 CHECKED WITH GPS
 DID NOT PULL TIES
 11/16/23, TDN
 FD MONBOX
 W/ 1" IPIN
 CKREF1
 5/15/24, TDN

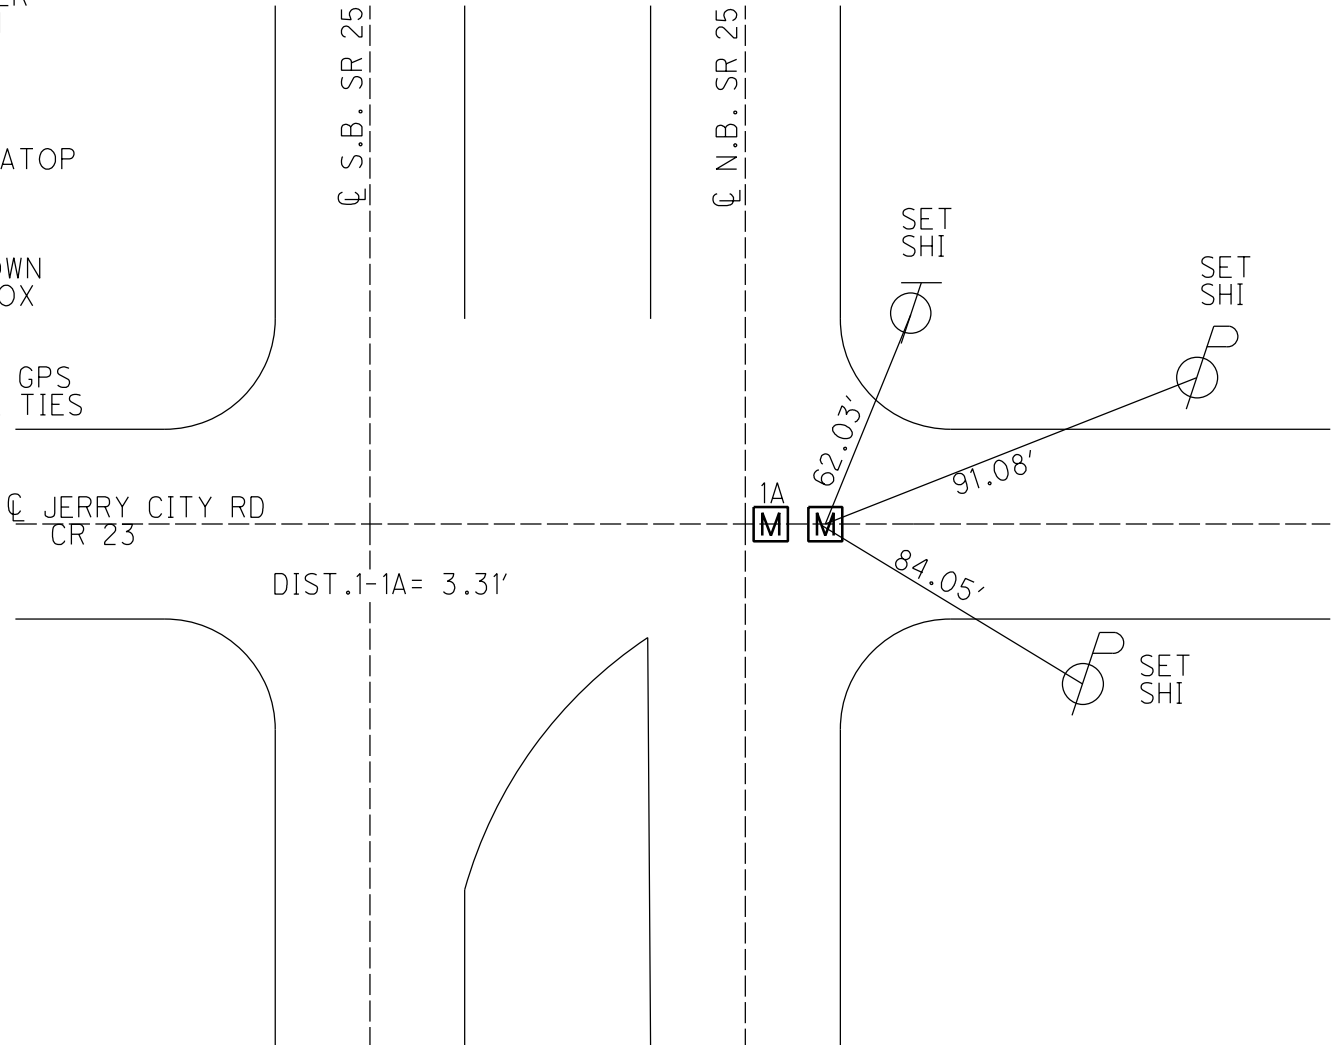

O.D.O.T. DISTRICT 2 SURVEY OFFICE (USE ONLY)

PERSONNEL

REFERENCE NO. 1

SHEET 7 OF 36

NOTES HUSS
H.C. ROUSOS
R.C. VAN DUSEN

DATE 4/12/01
WEATHER CLOUDY/WINDY
TEMP. 72°

ROUTE SR 25
COUNTY WOOD
TOWNSHIP LIBERTY
SECTION 36

DWG BY MILLER PID NO PID

T 4 N R 10 E

TYPE MONUMENT P.K.NAIL

ON SURFACE - ~~BELOW~~ ON

OFFSET CL PAVEMENT ON ~~LT: RT~~

- TO - EDGE PAVEMENT


STATION: 81+57

HORIZ.DATUM: NAD83 2011

GEOID: NAVD88 2012A


GRID: NORTHING: 580369.971

EASTING: 1652283.657

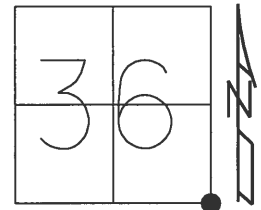

RECORD:
CL PAVEMENT
1958
FD P.K./WASHER
4/12/01, TMR
SET PK/WASHER
10-29-01, SAH
FD P.K.NAIL
REF1
5-30-18
10-1-18, JFO

CL JERRY CITY RD
CR 23

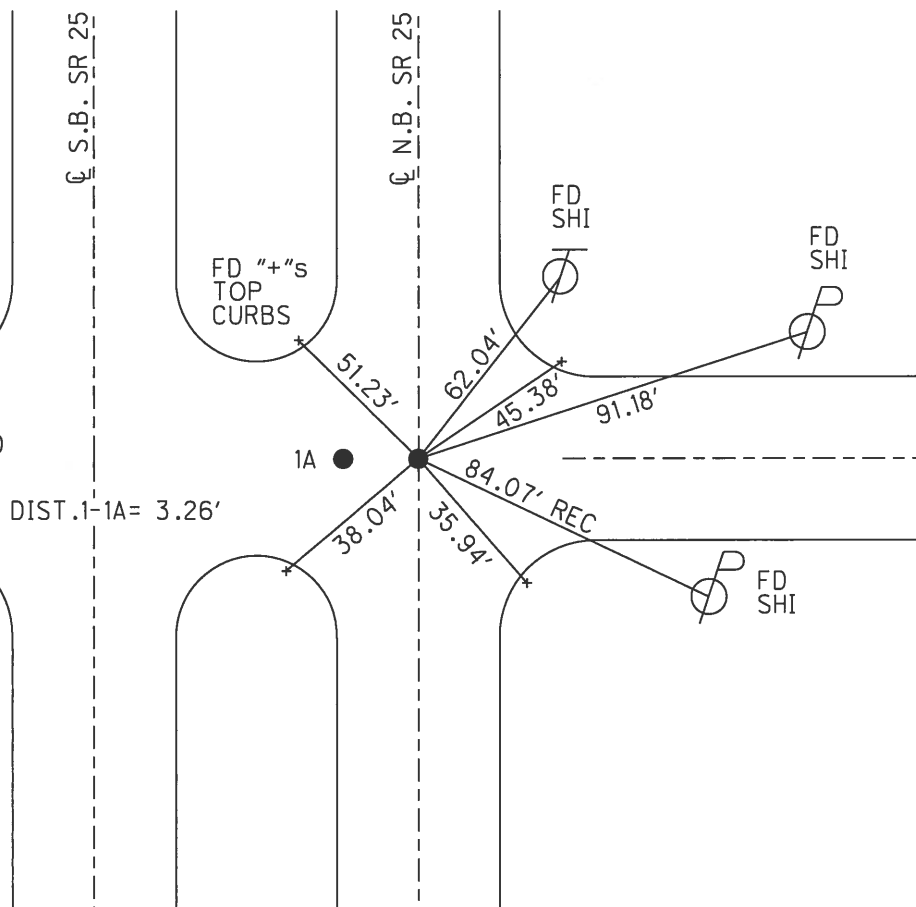

O.D.O.T. DISTRICT 2 SURVEY OFFICE

PERSONNEL

REFERENCE NO. 1

SHEET 4 OF 23

NOTES Huss

H.C. Rousos

R.C. VanDusen

DATE 4-12-01

WEATHER Pt Cloudy - Windy

TEMP. +72°F

ROUTE SR-25

COUNTY Wood

TOWNSHIP Liberty

SECTION 36

T 4 N R 10 E


TYPE MONUMENT PK/W PK/W

ON SURFACE - ~~BELOW~~ Surf

LEFT - E PAV'T. - RIGHT A 3.2' Lt B E Pavt.

6.1' TO Lt. EDGE PAVEMENT

S.L.M. A 81+57 B 81+57

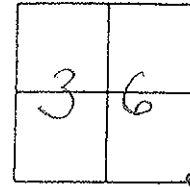


A Section Corner

Set PK/W
10-29-01

E Pavt.
Jerry City Rd.

3.20' Between
Points A - B

SR-25
Pavt.

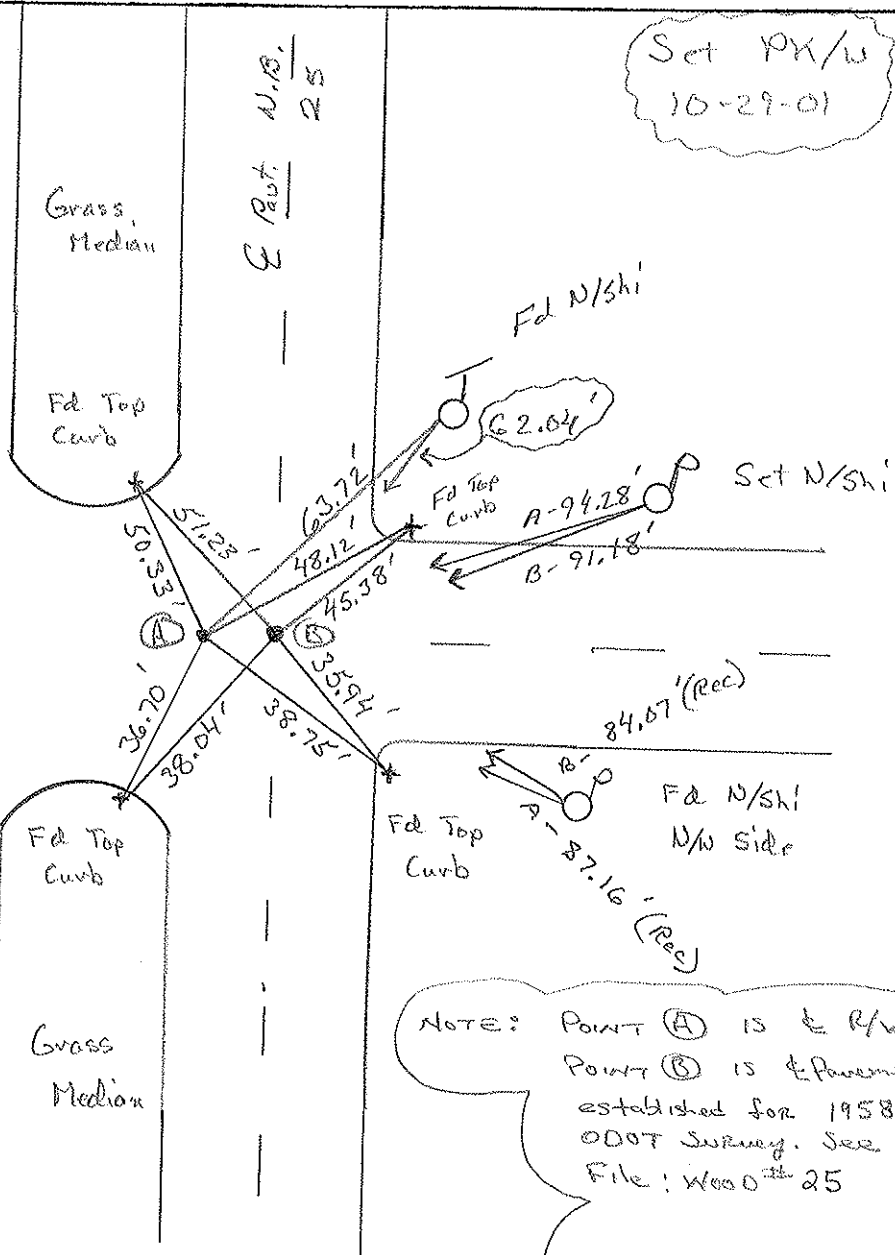

O.D.O.T. DISTRICT 2 SURVEY OFFICE

PERSONNEL

REFERENCE NO. 1

SHEET 4 OF 23

NOTES HOFFMAN

H.C. LOSHRKE

R.C. BARNHISEL

DATE 3-22-91

WEATHER CLOUDY

TEMP. 55°

ROUTE SR 25

COUNTY WOOD

TOWNSHIP LIBERTY


SECTION 36

T. 4 N. R. 10 E

TYPE MONUMENT P.K. / WASHER ^(A) & P.K. ^(B)
ON SURFACE - BELOW yes 2" down
LEFT - & PAV'T. - RIGHT 3.2' LT NBL & NBL

^(A) 6.1 TO LT. EDGE PAVEMENT

S.L.M. ^(A) 81+57

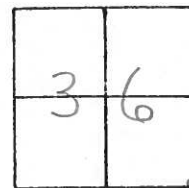

3.26 between points

Set P.K.'s & Washers
5-31-91
MB

NOTE: RECORD
SHOWS POINT "B"
TO BE FD. ON &
OF N.B.L. THE
ORIGIN IS UNKNOWN

& PAVT LERRY CITY Rd.

CUT "t"

Set Shi
SW/S

(A)

(B)

FD "t"

FD Shi
NW/S

SR 25

& PAVT N.B.L.

SR 25

& PAVT S.B.L.

51.23

50.33

36.70

38.04

38.75

35.94

45.38

48.12

63.72


62.04

84.07

87.13

County Wood S.R.-U.S. 25Date 6-9-81 8-25-81Township LIBERTYWeather ClearSection 36Temp. + 75°

T4N, R10E

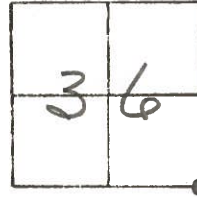Personnel HOFFMAN# 1HouseholderLoehrkePt. "A" Fd. BRASS MON @ SURFACE
3.2' W. of & PAUT


PROJECT STA ± 81+96

Pt. "B" Fd. P.K. @ SURFACE
ON & PAUT

3.24' Btw. Pts "A" & "B"

"+" CUT TOP
of CURB
(4 CORNERS)

Lerry City Rd.

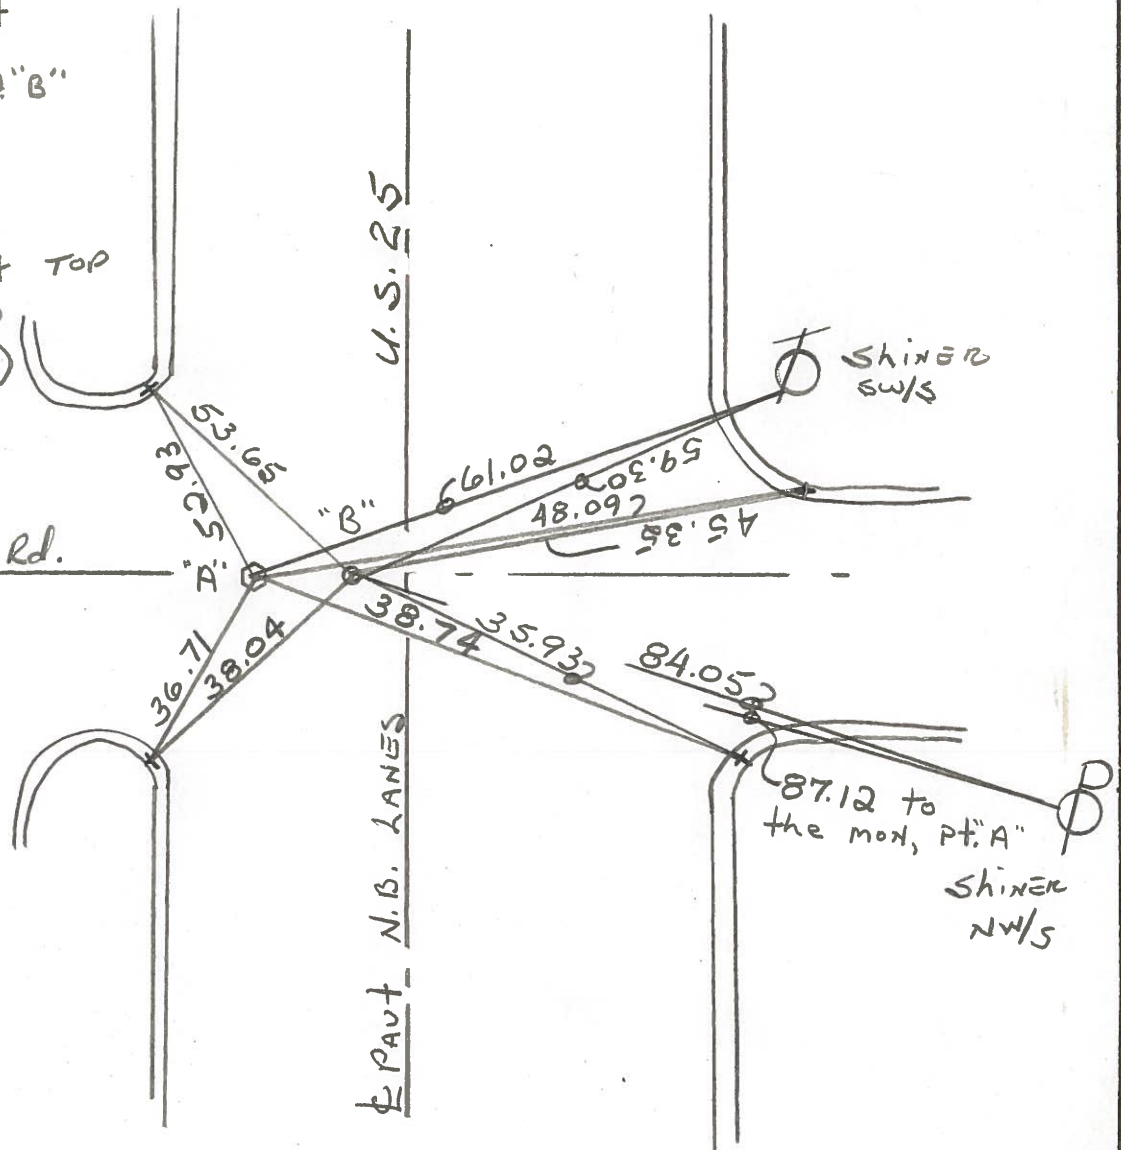SET P.K. NAIL AND
WASHER AT "A"-"B"

ODOT. DISTRICT 2 SURVEY OFFICE

SHEET

OF

County WOOD ^{U.S.} ~~S.R.~~ 25

Township LIBERTY - HENRY

Section 36

T4N, R10E

Personnel BURNSIDE

SMITH


BOWERS

HOLCOMBE


Date 7-2-71

Weather CLEAR

Temp. 72°

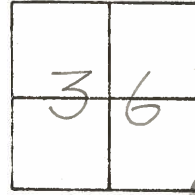

#1

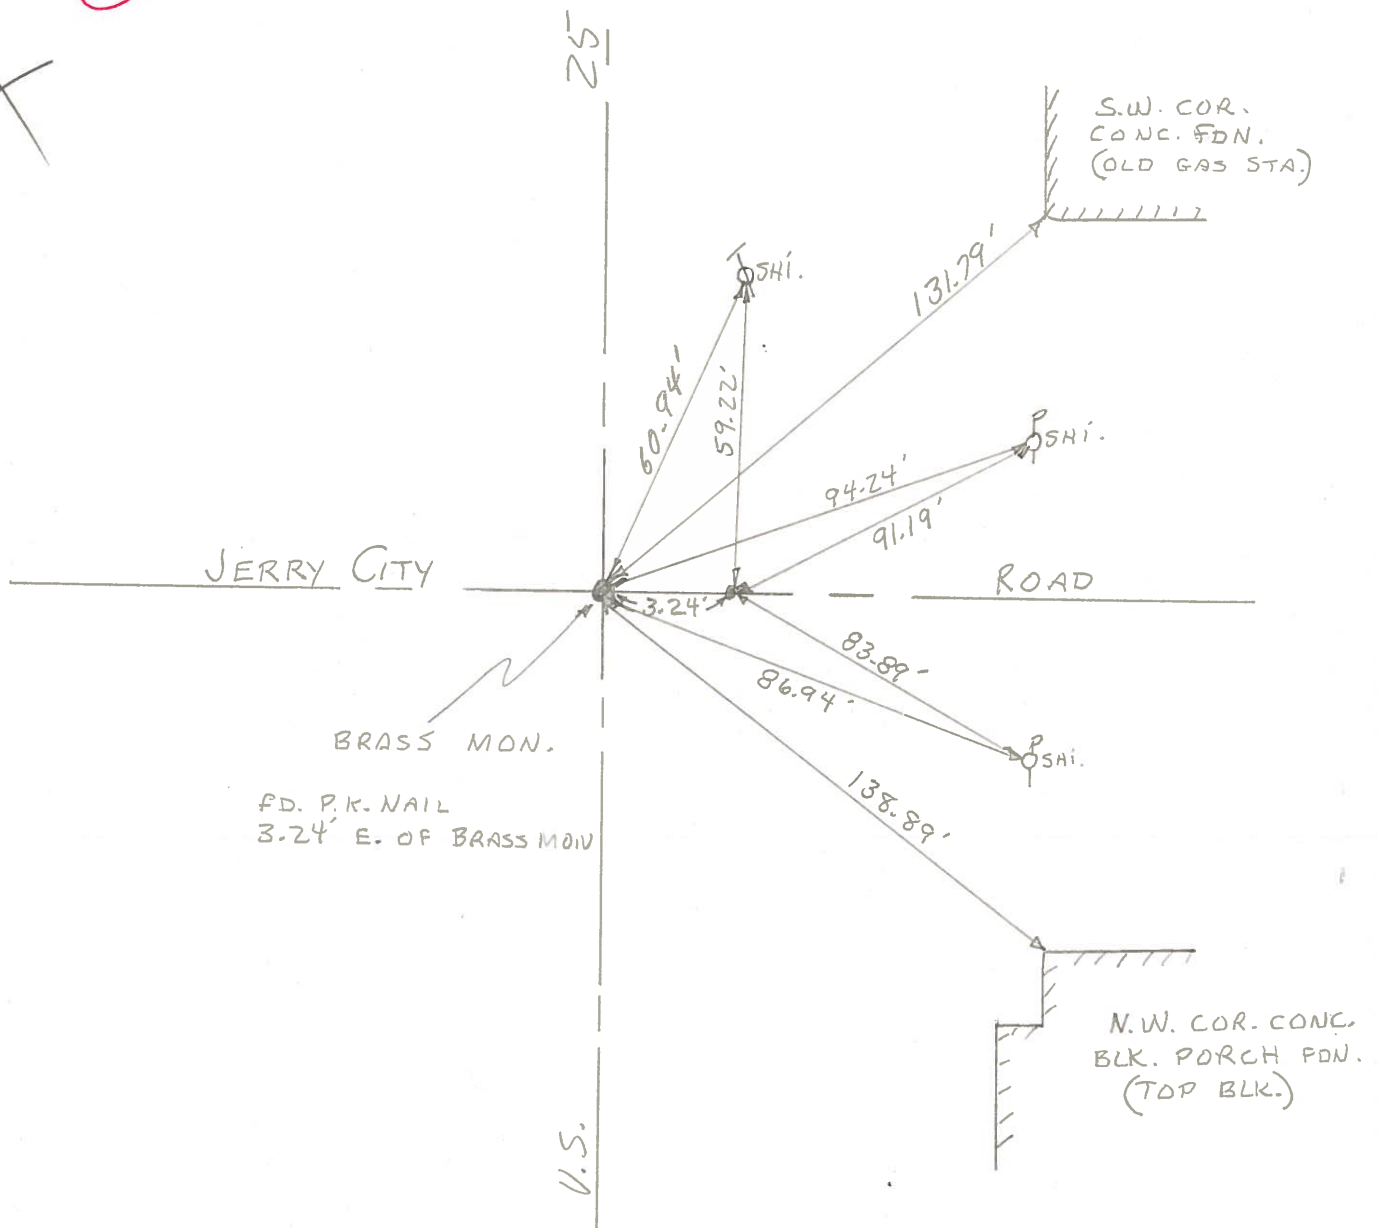

PERSONNEL

TITLE

PERSONNEL

TITLE

COUNTY Wood

DATE OK 1-10-55

S. R. U.S. #25

4-1-60

WEATHER

SEC.

TEMP.

DESCRIPTION

LEFT

CENTER LINE

RIGHT

JOB NO.

#224

Sta. 160+10.3
Henry twp. Cor.
Brass plate
P.K. nail.

N

Shiner in P.P. N.W. 61.92'
Shiner in T.P. W.N.W. 74.50'
Shiner in T.P. W.S.W. 70.50'
Shiner in P.P. S.E. 44.71'

#226

Sta. 173+08.95
Brass plate
P.K. nail

N

Shiner in T.P. N.W. 72.68
Shiner in cor. post W. 43.15
Shiner in T.P. S.W. 77.35
Shiner in P.P. S.E. 77.12

#227

Note: Mon. Raised & Greased 4-1-60
Note: Mopora man. set from here, to B.G.

S.E. cor. 36 Liberty twp
& Henry twp. line
Jerry City Road intersec.
Brass plate mtk. under
lead cap on surface of
Concrete pavement.

S.W. cor. Gas station fdn. N.E. 131.44
Shiner in P.P. E.N.E. 80.71 80.61
Shiner in T.P. N.N.E. 82.49 62.33
N.W. cor. house fdn. 4th block SE. 139.15
N.E. cor. C.B. (outside) S.S.E. 68.84
N.E. cor. to fnd. 3rd blk. above gnd. S.W. 107.82

①

#228

S.E. Shiner Brace Pole 87.29
86.92