

O.D.O.T. DISTRICT 2 SURVEY OFFICE (USE ONLY)

PERSONNEL

REFERENCE NO. 1A

SHEET OF

NOTES NIESE
H.C. NIESE
R.C. AUBLE

DATE 11/16/23
WEATHER BREEZY
TEMP. 65°

ROUTE SR 25
COUNTY WOOD
TOWNSHIP HENRY
SECTION 1
T 3 N R 10 E

DWG BY BARRIERE PID 92133

TYPE MONUMENT MONBOX W/ 1" IPIN

ON SURFACE - BELOW ON

OFFSET $\varnothing$ PAVEMENT ON LT : RT


 TO EDGE PAVEMENT

STATION: 54+00.29

HORIZ.DATUM: NAD83(11)/WOOD LDP GEOID: 18


GRID: NORTHING: 580369.979 EASTING: 1652280.427

LDP: NORTHING: 402210.838 EASTING: 164012.406

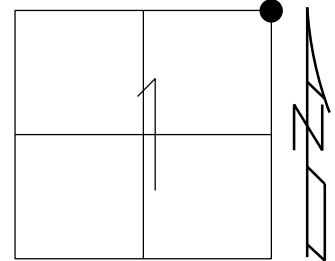

RECORD:

$\varnothing$ R/W,
36 SEC COR
FD P.K./WASHER
4/12/01, TMR
SET PK/WASHER
10-29-01, SAH
FD HOLE
REFA1
5-30-18, JFO
10-1-18, JFO
FD BRASS DISK
3 1/2" DOWN
REFA1
3/17/22, JFO
FD NEW MONBOX
W/ 1" IPIN
NEWREF1
CHECKED WITH GPS
DID NOT PULL TIES
11/16/23, TDN
FD MONBOX
W/ 1" IPIN
CKREFA1
11/16/23, TDN

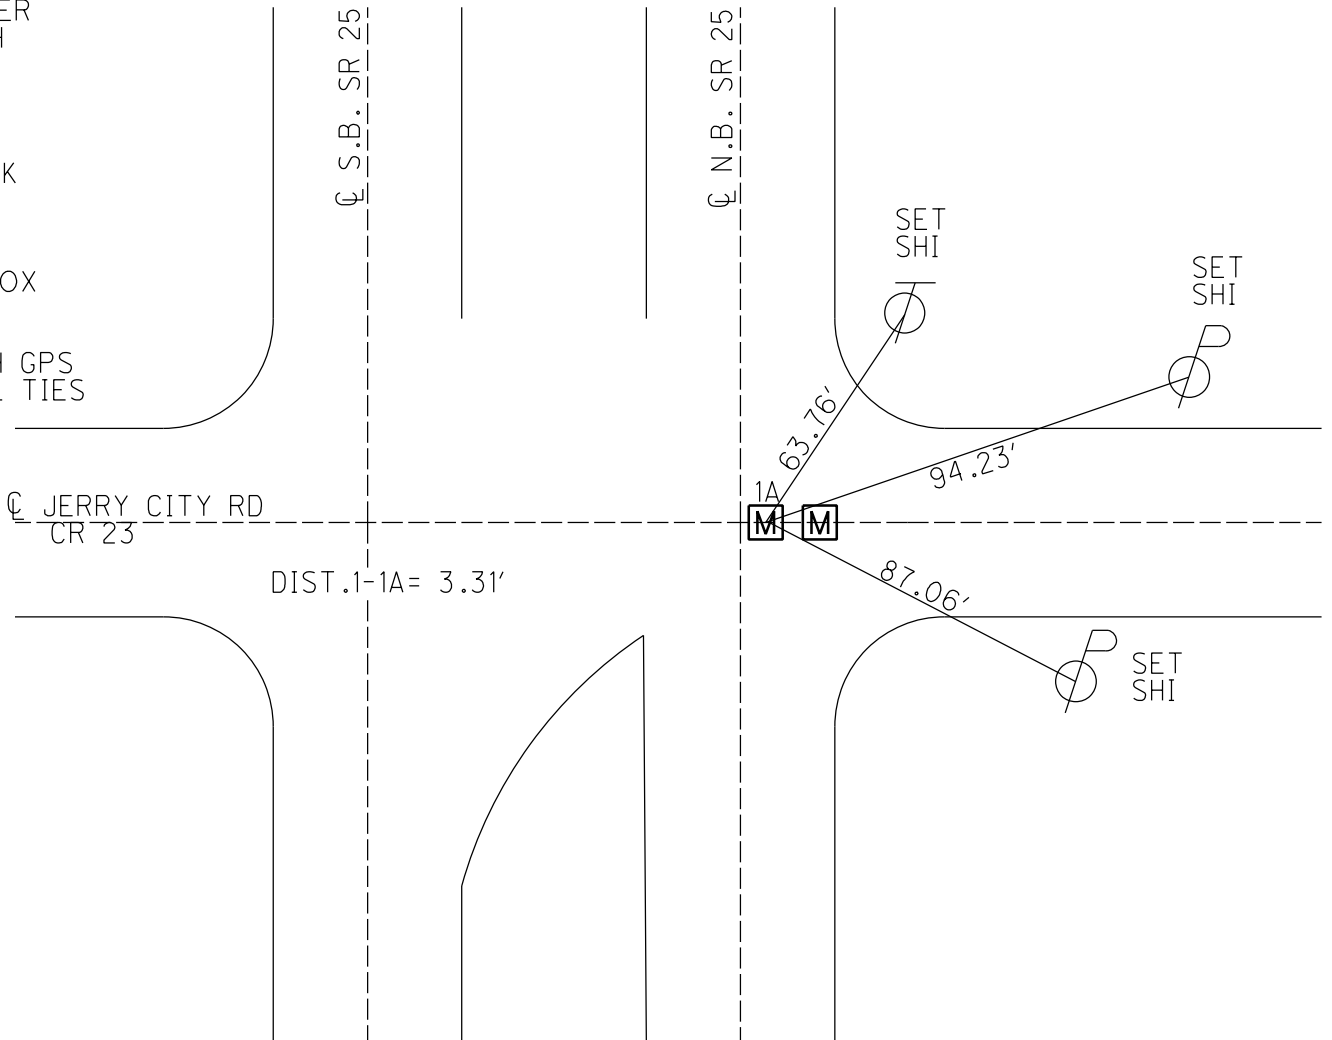

O.D.O.T. DISTRICT 2 SURVEY OFFICE (USE ONLY)

PERSONNEL

REFERENCE NO. 1 A

SHEET 8 OF 36

NOTES HUSS
H.C. ROUSOS
R.C. VAN DUSEN

DATE 4/12/01
WEATHER CLOUDY/WINDY
TEMP. 72°

ROUTE SR 25
COUNTY WOOD
TOWNSHIP LIBERTY
SECTION 36

DWG BY MILLER

PID NO PID

T 4 N R 10 E

TYPE MONUMENT P.K.SHANK

ON SURFACE - ~~BELOW~~ ON

OFFSET Q PAVEMENT 3.2' LT : ~~RT~~

6.1' TO LT EDGE PAVEMENT


STATION: 81+57

HORZ.DATUM: NAD83(2011)

GEOID: NAVD88 2012A

GRID: NORTHING: 580370.019

EASTING: 1652280.395

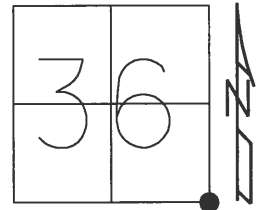

RECORD:

Q R/W,
36 SEC COR
FD P.K./WASHER
4/12/01, TMR
SET PK/WASHER
10-29-01, SAH
FD HOLE
REFA1
5-30-18, JFO

Q JERRY CITY RD
CR 23

DIST. 1-1A = 3.26'

Q S.B. SR 25

Q N.B. SR 25

FD "+"s
TOP
CURBS

FD
SHI

FD
SHI

FD
SHI

50.33'

63.72'


48.12'

94.28'

36.70'

38.75'

87.16'

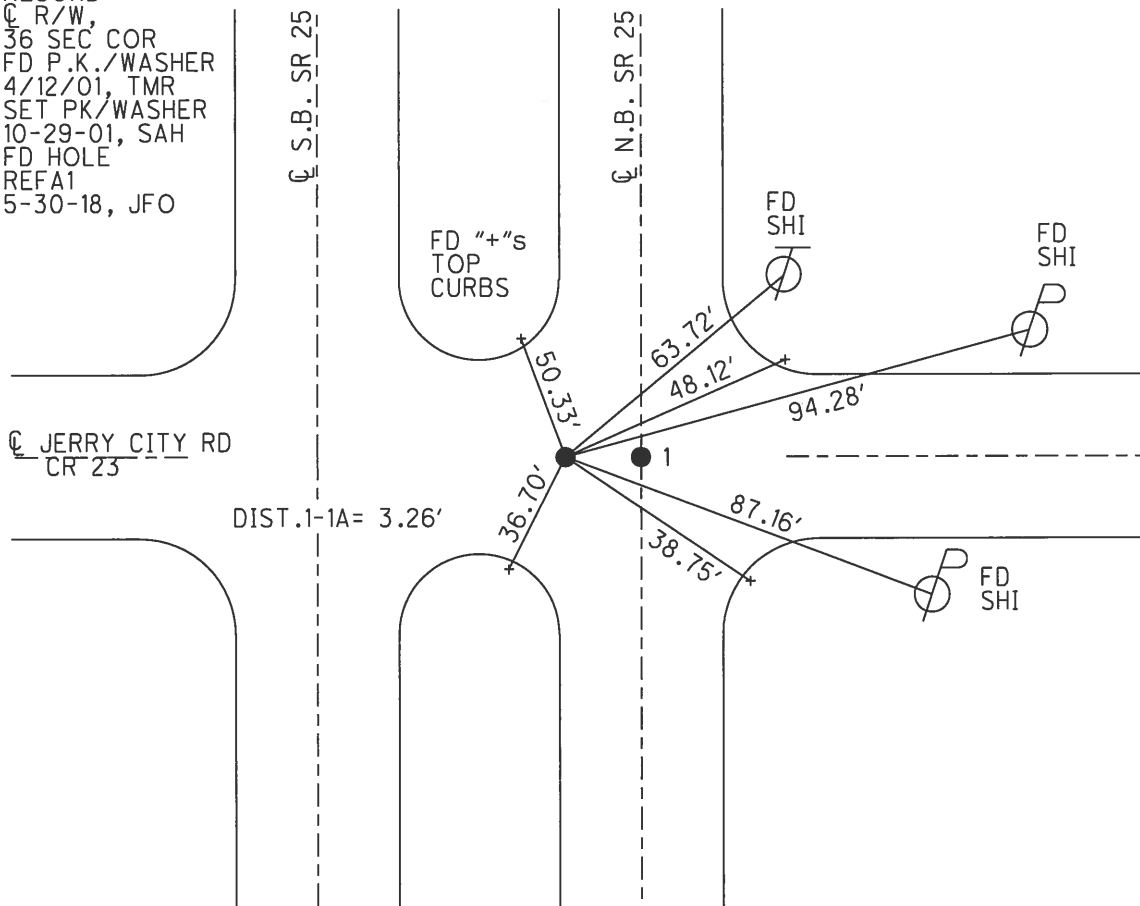

O.D.O.T. DISTRICT 2 SURVEY OFFICE

PERSONNEL

REFERENCE NO. 1

SHEET 4 OF 23

NOTES Huss

H.C. Rousos

R.C. VanDusen

DATE 4-12-01

WEATHER Pt Cloudy - Windy

TEMP. +72°F

ROUTE SR-25

COUNTY Wood

TOWNSHIP Liberty

SECTION 36

T 4 N R 10 E


TYPE MONUMENT PK/W PK/W

ON SURFACE - ~~BELOW~~ Surf

LEFT - E PAV'T. - RIGHT A 3.2' Lt B E Pavt.

6.1' TO Lt. EDGE PAVEMENT

S.L.M. A 81+57 B 81+57

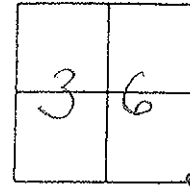


A Section Corner

Set PK/W
10-29-01

E Pavt.
Jerry City Rd.

3.20' Between
Points A - B

E Pavt. SR-25

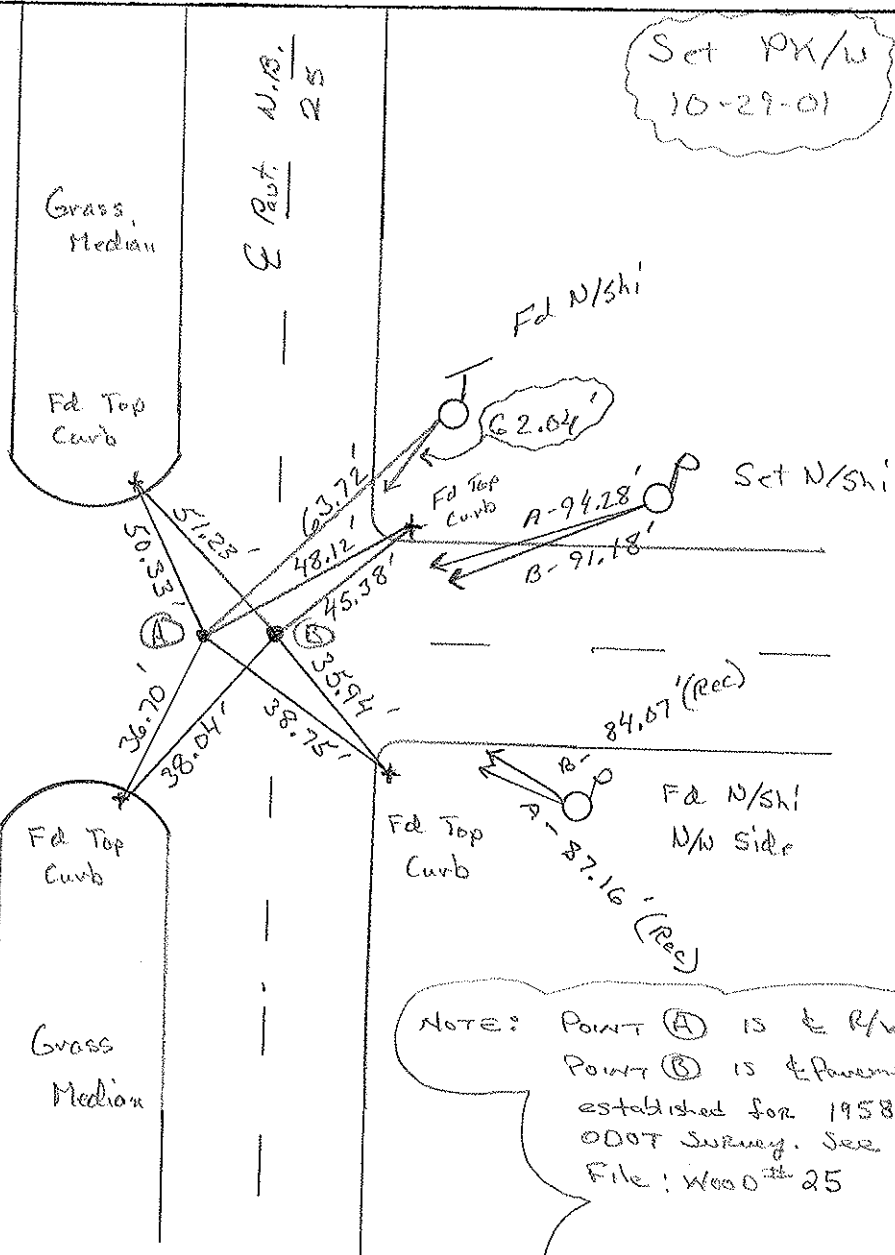

O.D.O.T. DISTRICT 2 SURVEY OFFICE

PERSONNEL

REFERENCE NO. 1

SHEET 4 OF 23

NOTES

H.C. Huss

R.C. Rousos

R.C. Van Dusen

DATE 4-12-01

WEATHER Pt Cloudy Windy

TEMP. +72°F

ROUTE SR-25

COUNTY Wood

TOWNSHIP Liberty

SECTION 36

T 4 N R 10 E


TYPE MONUMENT (A) PK/W (B) PK/W

ON SURFACE - ~~BELOW~~ Surf

LEFT - CL PAV'T. - RIGHT (A) 3.2' Lt g B CL Pavt.

(A) 6.1' TO Lt. EDGE PAVEMENT

S.L.M. (A) 81+57 (B) 81+57

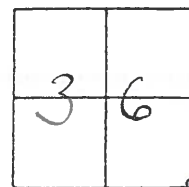


(A) Section Corner

Set PK/W
10-29-01

CL Pavt.
Jerry City Rd.

3.20' Between
POINTS A-B

SB-25
CL Pavt.

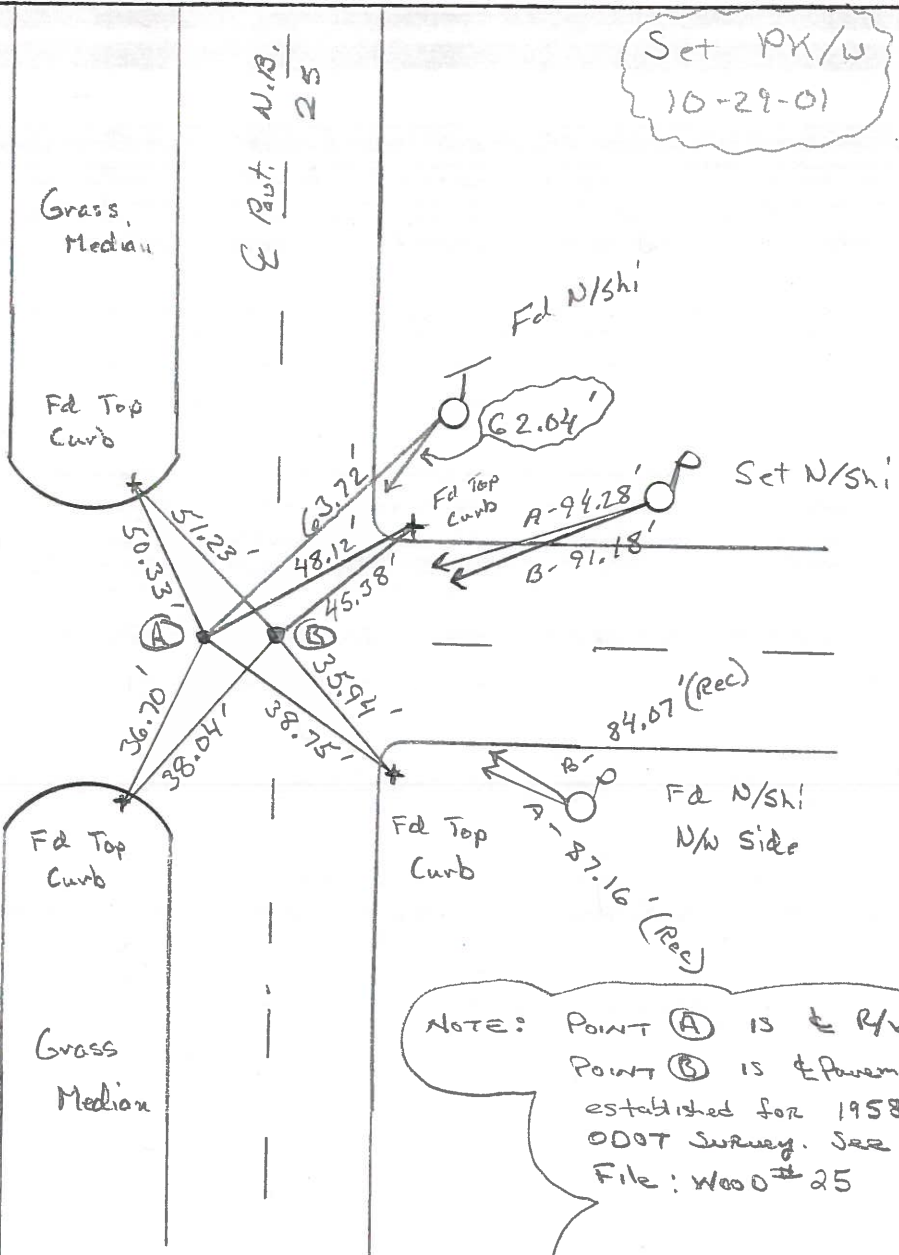

O.D.O.T. DISTRICT 2 SURVEY OFFICE

PERSONNEL

REFERENCE NO. 1

SHEET 4 OF 23

NOTES HOFFMAN

H.C. LOEHRKE

R.C. BARNHISEL

DATE 3-22-91

WEATHER CLOUDY

TEMP. 55°

ROUTE SR 25

COUNTY WOOD

TOWNSHIP LIBERTY

SECTION 36

T 4 N R 10 E


TYPE MONUMENT P.K. / WASHER & P.K.

ON SURFACE - BELOW yes & 2' down

LEFT - & PAV'T. - RIGHT 3.2' LT NR & & NB

TO LT EDGE PAVEMENT

S.L.M. 51+57

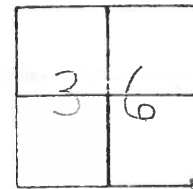

3.26 between points

Set P.K.'s & Washers
5-31-91
MB

& PAVT S.B.L.

SR 25

NOTE: RECORD SHOWS POINT "B" TO BE Fd. ON & of N.B.L. The ORIGINAL IS UNKNOWN

Set Sh. 1
SW/S

CUT "+"

62.04

Fd "+"

& PAVT LERRY CITY Rd.

(A)

(B)

Fd "+"

Fd "+"

P Fd Sh.
NW/S

SR 25

& PAVT N.B.L.

51.23
39.33
36.70
38.04


63.72
48.12
45.38
35.94
33.75

84.07

87.13

County Wood S.R.-U.S. 25Township LIBERTYSection 36

T4N, R10E

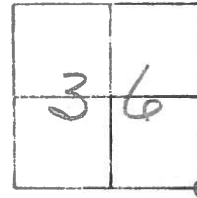Personnel HOFFMANHouseholderLoehrke# 1Date 6-9-81 8-25-81Weather ClearTemp. + 75°Pt. "A" Fd. BRASS MON @ Surface
3.2' W. of & PAUT


PROJECT STA ± 81+96

Pt. "B" Fd. P.K. @ Surface
ON & PAUT

3.24' Btw. Pts "A" & "B"

+ "cut TOP
of curb
(4 CORNERS)

Lerry City Rd.

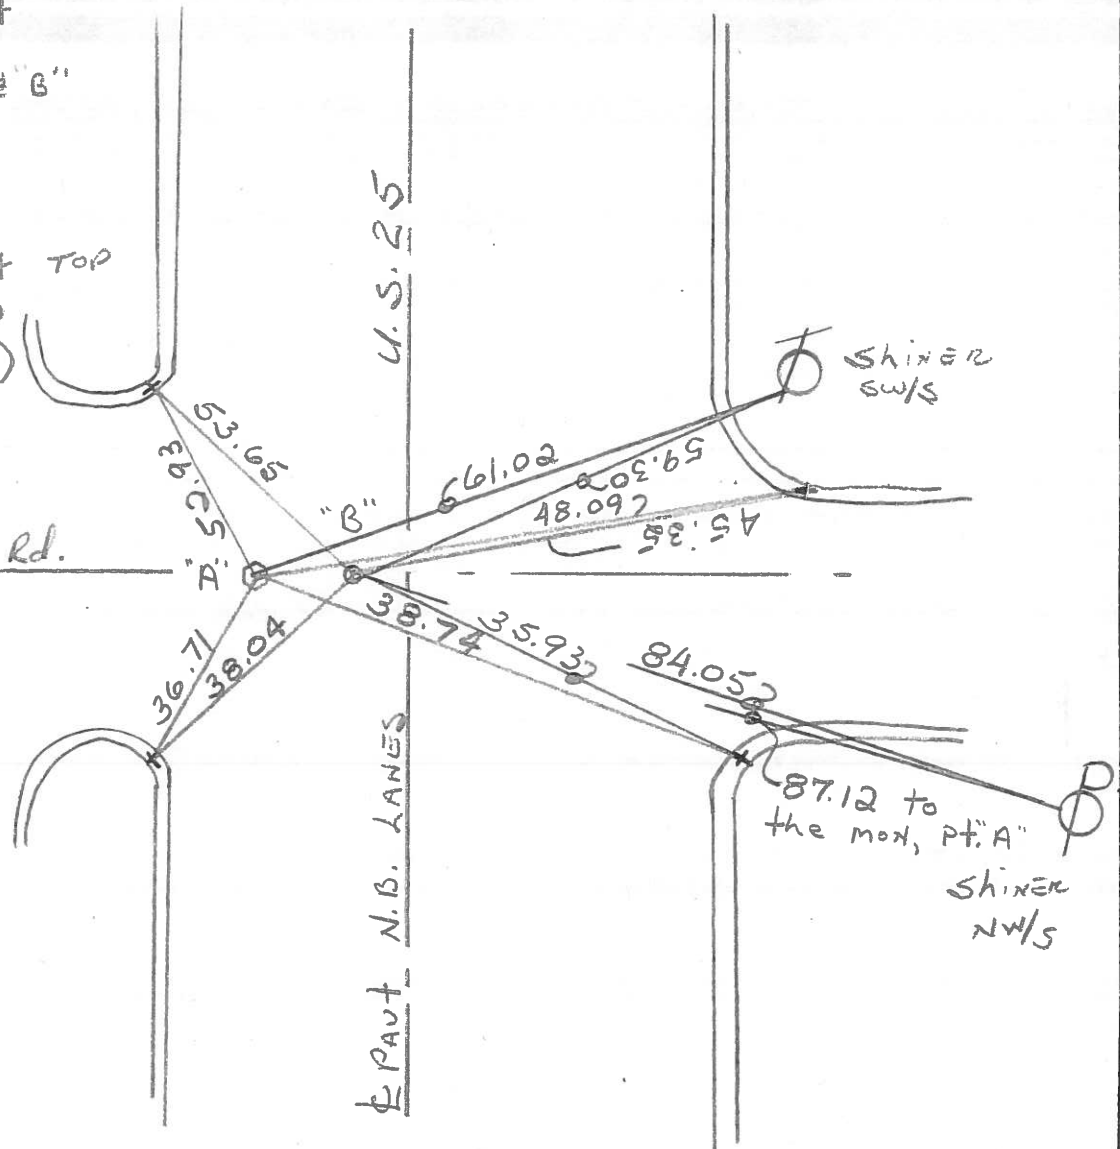SET P.K. NAIL AND
WASHER AT "A"- "B"

ODOT. DISTRICT 2 SURVEY OFFICE

SHEET

OF

County WOOD ^{U.S.} ~~S.R.~~ 25

Township LIBERTY - HENRY

Section 36

T4N, R10E

Personnel BURNSIDE

SMITH


BOWERS

HOLCOMBE

Date 7-2-71

Weather CLEAR

Temp. 72°

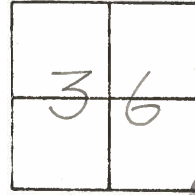

#1

