

O.D.O.T. DISTRICT 2 SURVEY OFFICE (USE ONLY)

PERSONNEL

REFERENCE NO. 2/2A

SHEET _____ OF _____

NOTES NIESE
H.C. NIESE
R.C. AUBLE

DATE 11/16/23
WEATHER CLEAR
TEMP. 65°

ROUTE SR 25
COUNTY WOOD
TOWNSHIP HENRY
SECTION 36

DWG BY BARRIERE PID 92133

T 4 N R 10 E

TYPE MONUMENT MONBOX W/ 1" IPIN

ON SURFACE - BELOW ON

OFFSET $\varnothing$ PAVEMENT 15.5' RT LT : RT


TO EDGE PAVEMENT

STATION: 80+34.92

HORIZ.DATUM: NAD83(11)/WOOD LDP GEOID: 18

GRID: NORTHING: 583004.226 EASTING: 1652316.766

LDP: NORTHING: 404845.547 EASTING: 164014.008

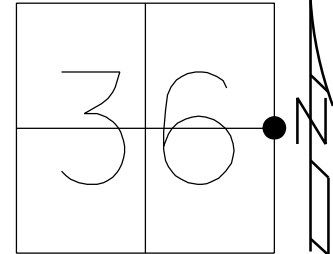

RECORD: P.I.
E 1/4 COR. SEC 36

FD P.K./WASHER
4/12/01, TMR
SET P.K./WASHER
10-29-01, SAH
FD P.K./WASHER
REF2
5-30-18, JFO
10-1-18, JFO
FD P.K. NAIL
REF2
3/17/22, JFO
FD MAG NAIL
REFA2
FD NEW MONBOX W/ 1" IPIN
CHECKED W/ GPS
DID NOT PULL TIES
NEWREF2
11/16/23, TDN
FD NEW MONBOX W/ 1" IPIN
CHECKED W/ GPS
POINT ESTABLISHED PER
PID 92133 PLANS
NEWREF2A
11/16/23, TDN

FD
SHI

$\varnothing$ S.B. SR 25

$\varnothing$ N.B. SR 25

SET MAG NAIL
BY GPS
(ORIGIN UNKNOWN)

DIST. 2-2B= 65.62'

FD MONBOX
W/ 1" IPIN

FD MONBOX
W/ 1" IPIN



O.D.O.T. DISTRICT 2 SURVEY OFFICE (USE ONLY)

PERSONNEL

REFERENCE NO. 2

SHEET 9 OF 36

NOTES HUSS
H.C. ROUSOS
R.C. VAN DUSEN

DATE 4/12/01
WEATHER CLOUDY/WINDY
TEMP. 72°

ROUTE SR 25
COUNTY WOOD
TOWNSHIP LIBERTY
SECTION 36

DWG BY MILLER PID NO PID

T 4 N R 10 E

TYPE MONUMENT P.K./WASHER

ON SURFACE - ~~BELOW~~ ON

OFFSET Q PAVEMENT 19.0' LT : ~~RT~~

8.6' LT TO LT EDGE PAVEMENT


STATION: 107+91

HORZ. DATUM: NAD83(2011)


GEOID: NAVD88 2012A

GRID: NORTHING: 583004.222

EASTING: 1652316.793

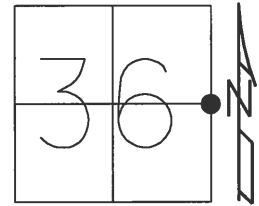

RECORD:
FD P.K./WASHER
4/12/01, TMR
SET P.K./WASHER
10-29-01, SAH
FD P.K./WASHER
REF2
5-30-18, JFO
10-1-18, JFO

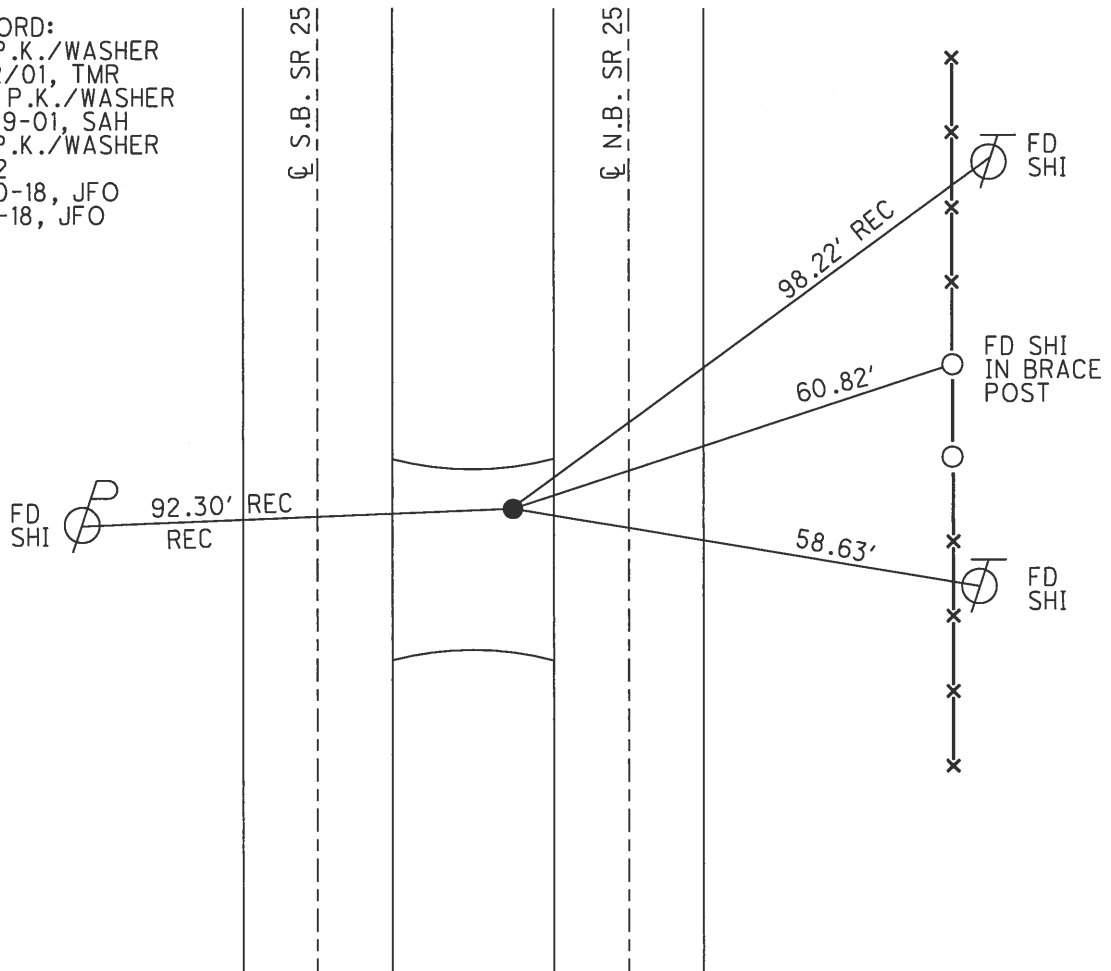

O.D.O.T. DISTRICT 2 SURVEY OFFICE

PERSONNEL

REFERENCE NO. 2

SHEET 5 OF 03

NOTES Huss

H.C. Rousos

R.C. VanDusen

DATE 4-12-01

WEATHER Pt Cldy Windy

TEMP. 72°F

ROUTE SR-25

COUNTY Wood

TOWNSHIP Liberty

SECTION 36

T 4 N R 10 E


TYPE MONUMENT PK/W

ON SURFACE - BELOW Surface

LEFT - & PAV T - RIGHT 19.0' Lt of NBL

7.8' Lt. TO Lt. EDGE PAVEMENT N.B. Lane

S.L.M. 107+91

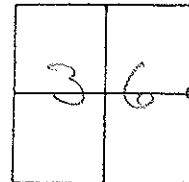

Set PK/washer
10-29-01
SAM

For
N/shi

92.30 (Rec)

8.6' to
North Edge
of Pavt.

Pavt. Turn
around

98.22
(Rec)

60.82

58.63

Set N/shi
in Brace
Post

2-N/shi
use Top N/shi

6 Pavt.
SB - 25

Grass
Median

6 Pavt.
NB - 25

Grass
Median

O.D.O.T. DISTRICT 2 SURVEY OFFICE

PERSONNEL

REFERENCE NO. 2

SHEET 5 OF 23

NOTES HOFFMAN

H.C. LOSHRKE

R.C. BARANISSEL

DATE 3-22-91

WEATHER CLOUDY

TEMP. 55°

ROUTE SR 25

COUNTY WOOD

TOWNSHIP LIBERTY

SECTION 36

T4 N R 10 E


TYPE MONUMENT P.K. / WASHER

ON SURFACE - BELOW YES

LEFT- & PAW'T. - RIGHT 19.0' NBL

7.8 TO LT. EDGE PAVEMENT NBL

S.L.M. 107+91

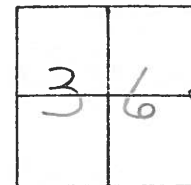

Set P.K. & Washer
5-31-91
MB

Set shi
E/S

92.30

PAWT

SR 25

8.6'

98.22

Set shi
SW/S

54.82

Set shi
W/S
6" mulberry

58.63

Set shi
NW/S

SR 25

PAWT

ODOT DISTRICT 2 SURVEY OFFICE

SHEET 2 OF

County Wood S.R. - U.S. 25

Township LIBERTY

Section 36

T4N, R10E

Personnel Hoffman


Loehrke

Householder

Date 6-9-81 8-25-81

Weather Cloudy

Temp. + 75°

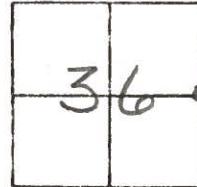


#2

Fd. "+" IN CONC. MEDIAN CROSS OVER - Project Sta. ± 108 + 33

7' w. of w. Edge PAUT, N.B. LANES

19.1' w. of c. of PAUT, N.B. LANES

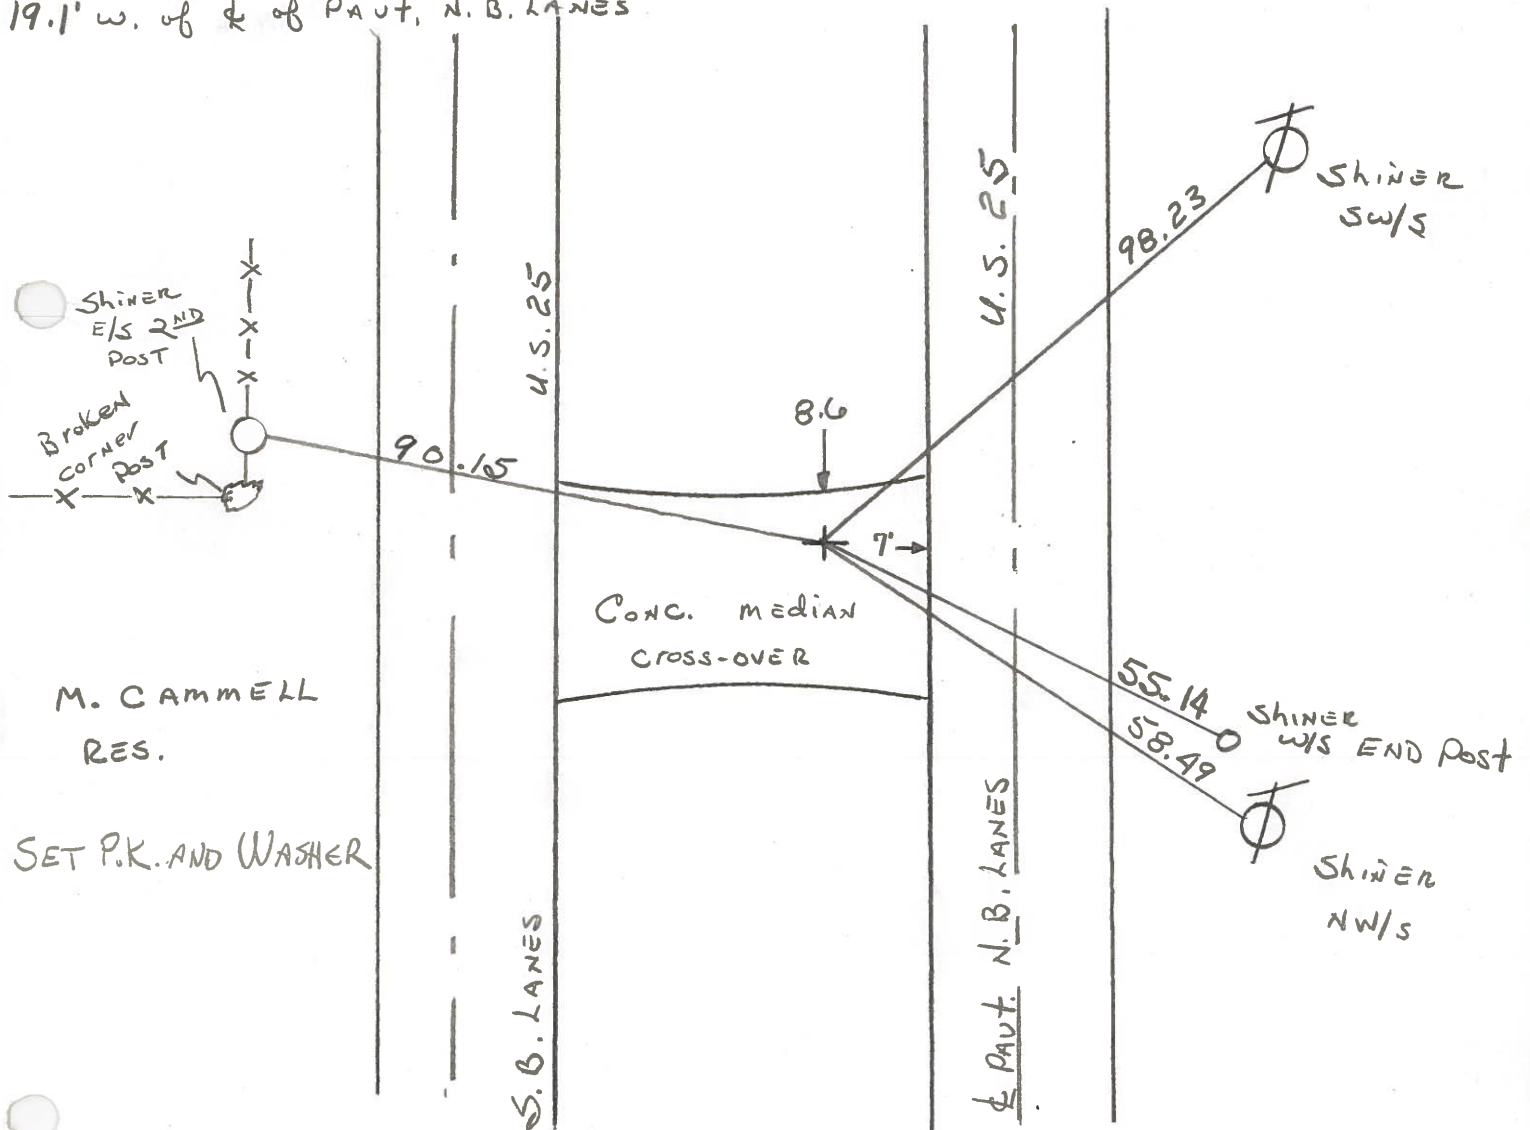

O.D.O.T. DISTRICT 2 SURVEY OFFICE

SHEET

OF

County WOOD S.R. _____

Township LIBERTY _____

Section 36 _____

T4N, R10E

Personnel MORRISON _____

HOLCOMBE _____

BOWERS _____


SMITH _____

HUFFMAN _____

Date AUG 18 - 70

Weather CLEAR

Temp. 92°

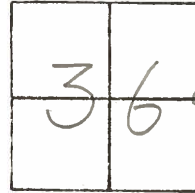

#2

