

O.D.O.T. DISTRICT 2 SURVEY OFFICE (USE ONLY)

PERSONNEL

REFERENCE NO. 3

SHEET OF

NOTES ASTON

DATE 5/21/24

ROUTE SR 25

H.C. NIESE

WEATHER CLEAR

COUNTY WOOD

R.C. PRESTON-COLVIN

TEMP. 85°

TOWNSHIP HENRY

DWG BY BARRIERE

PID 92133

SECTION 36

T 4 N R 10 E

TYPE MONUMENT MONBOX W/ 1" IPIN

ON SURFACE - BELOW ON

OFFSET $\varnothing$ PAVEMENT 15.5' RT LT : RT


 TO EDGE PAVEMENT

STATION: 106+73.29

HORZ.DATUM: NAD83(11)/WOOD LDP GEOID: 18


GRID: NORTHING: 585642.045 EASTING: 1652353.558

LDP: NORTHING: 407483.832 EASTING: 164016.016

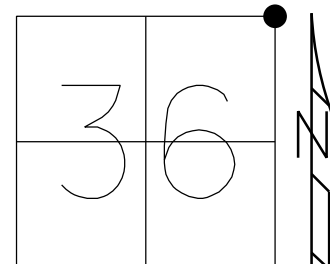

RECORD: P.I.
N.E. COR. SEC 36

FD P.K./WASHER
4/12/01, TMR
SET P.K./WASHER
10-31-01, SAH
FD P.K.NAIL
REF3
5-30-18
10-1-18, JFO
FD BRASS DISK
FD MAG NAIL
REF3
3/17/22, JFO
FD NEW MONBOX
W/ 1" IPIN
CHECKED W/ GPS
DID NOT PULL TIES
NEWREF3
11/16/23, TDN
CHECKED TIES
5/21/24, TDN

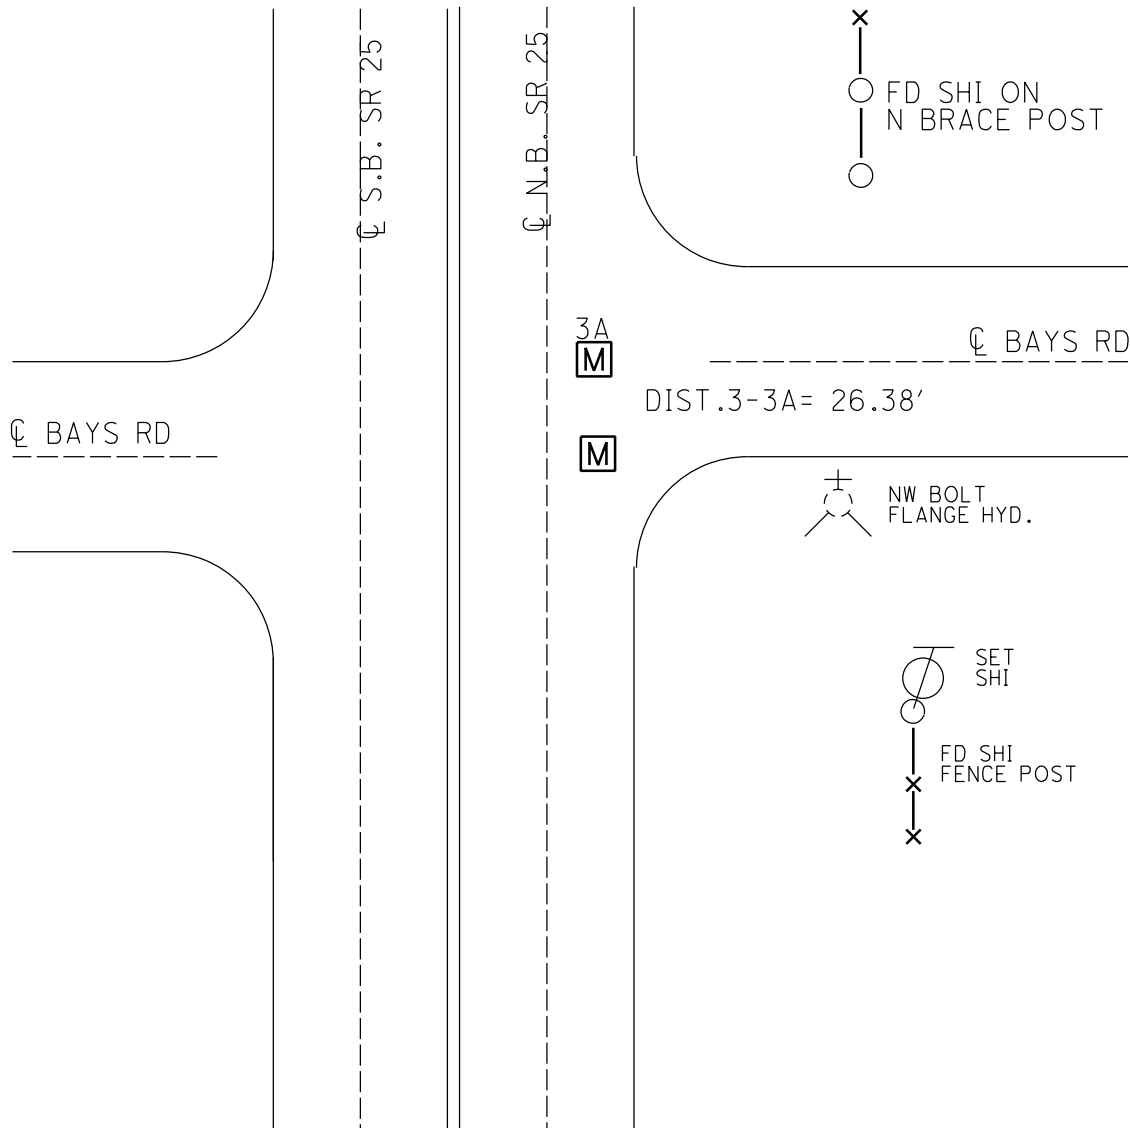

O.D.O.T. DISTRICT 2 SURVEY OFFICE (USE ONLY)

PERSONNEL

REFERENCE NO. 3

SHEET 10 OF 36

NOTES RHOADES
H.C. O'DONNELL
R.C. TRENKA

DATE 5/30/18
WEATHER CLOUDY
TEMP. 77°

ROUTE SR 25
COUNTY WOOD
TOWNSHIP LIBERTY
SECTION 36

DWG BY MILLER PID NO PID

T 4 N R 10 E

TYPE MONUMENT P.K.NAIL

ON SURFACE - ~~BELOW~~ ON

OFFSET 2.6' LT : ~~RT~~

TO EDGE PAVEMENT


STATION: 134+29

HORIZ.DATUM: NAD83(2011)


GEOID: NAVD88 2012A

GRID: NORTHING: 585642.099

EASTING: 1652353.503

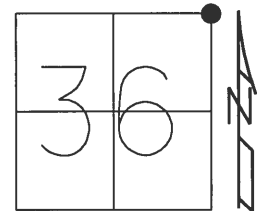

RECORD:
FD P.K./WASHER
4/12/01, TMR
SET P.K./WASHER
10-31-01, SAH
FD P.K.NAIL
REF3
5-30-18
10-1-18, JFO

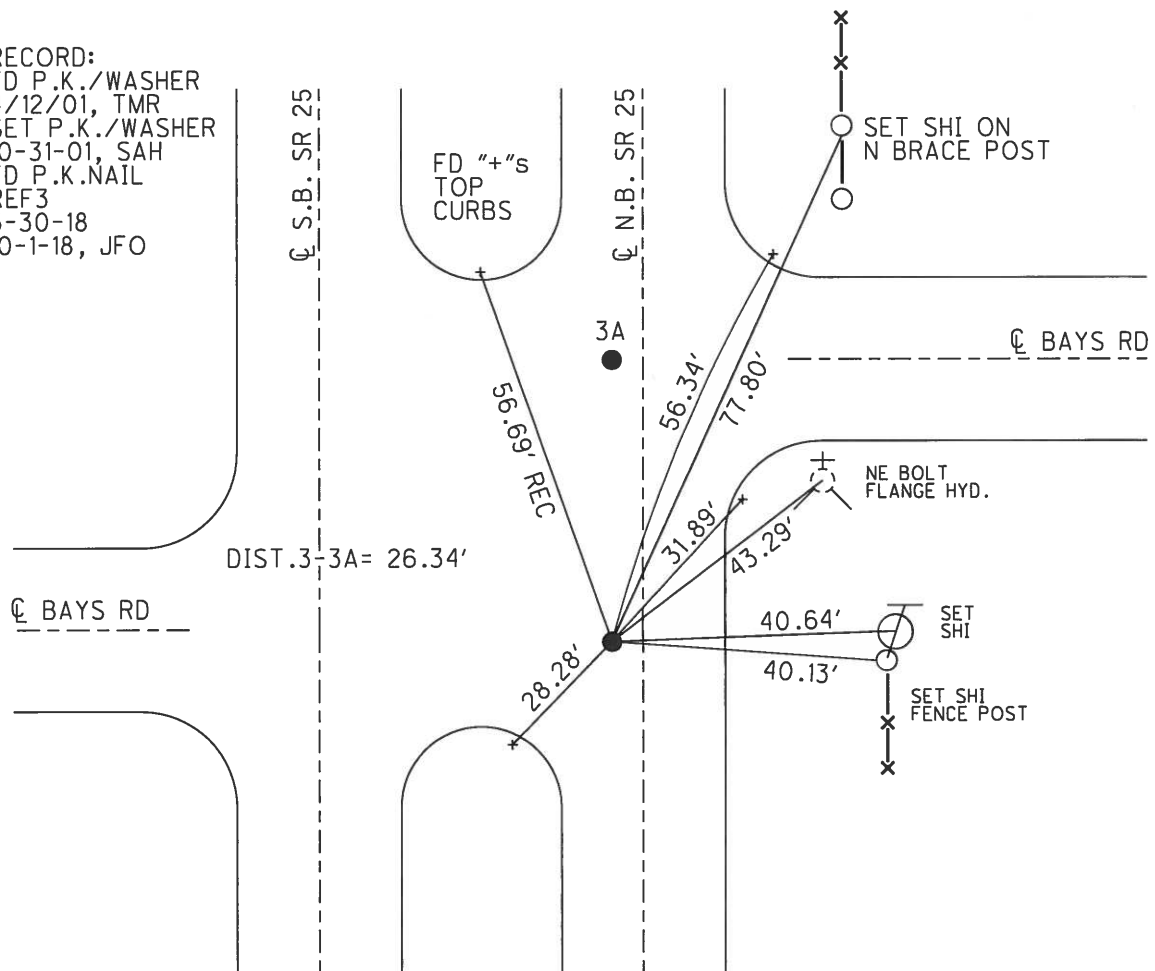

O.D.O.T. DISTRICT 2 SURVEY OFFICE

PERSONNEL

REFERENCE NO. 3

SHEET 6 OF 23

NOTES Husc

H.C. Rousos

R.C. Van Dusen

DATE 4-12-01

WEATHER pt. Cldy - Windy

TEMP. 72°F

ROUTE SR-25

COUNTY Wood

TOWNSHIP Liberty

SECTION 36

T 4 N R 10 E


TYPE MONUMENT (A) PK/W (B) PK/W

ON SURFACE - BELOW Surface

LEFT - E PAV T. - RIGHT (A) 2.6' (B) 2.8'

TO EDGE PAVEMENT

S.L.M. (A) 134+29 (B) 134+55

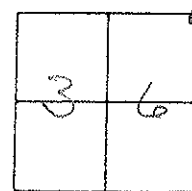

Set PK/W
Both Points
10-31-01
SAH

Set N/shi
N. Brace Post

E Bays Rd


E Bays Rd

Set N/shi
T.P.

x = cross cuts
on top of curb

SR-25

SR-25

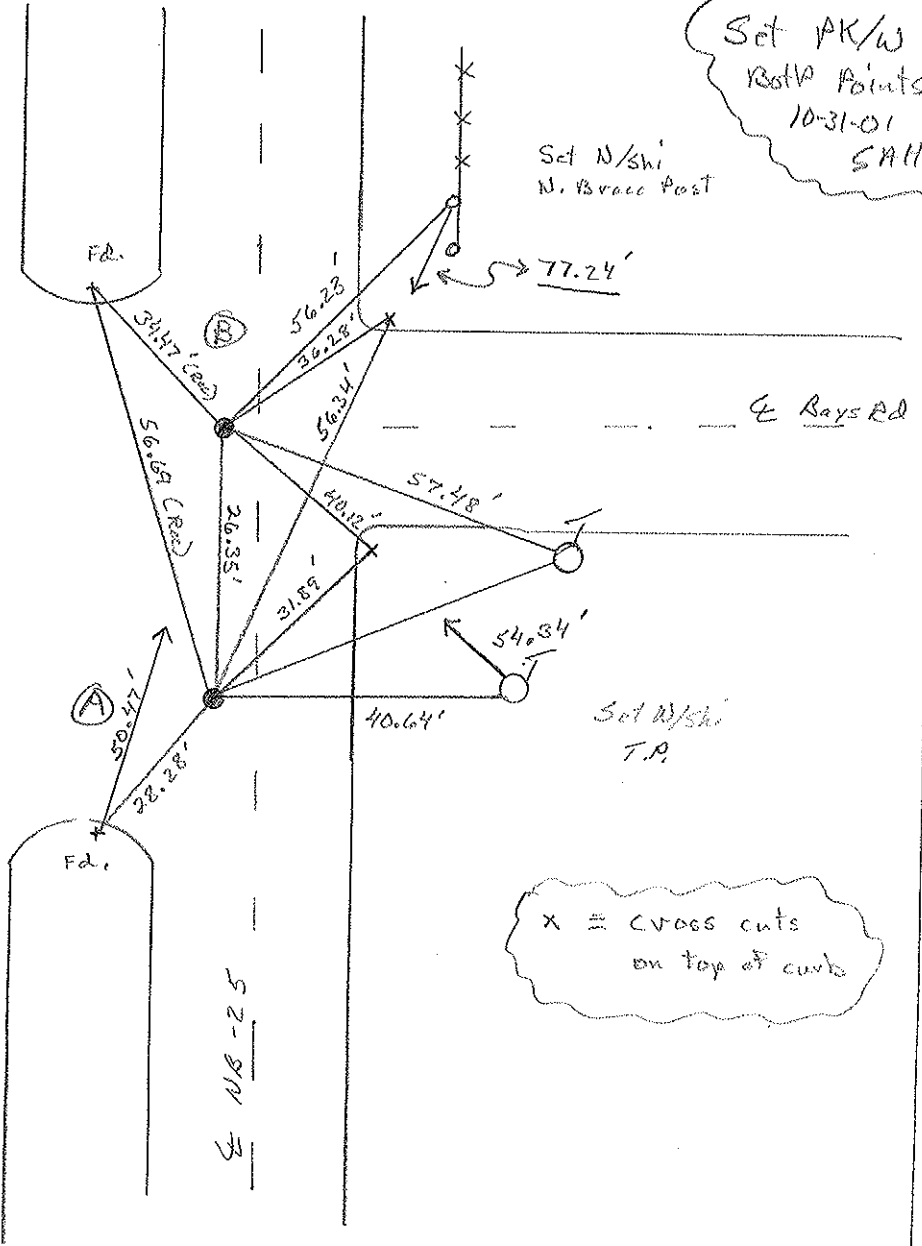

O.D.O.T. DISTRICT 2 SURVEY OFFICE

PERSONNEL

REFERENCE NO. 3

SHEET 6 OF 23

NOTES HOFFMAN

H.C. LOEHRIK

R.C. BARNHISEL

DATE 3-22-91

WEATHER CLOUDY

TEMP. 55°

ROUTE SR 25

COUNTY WOOD

TOWNSHIP LIBERTY


SECTION 36

T4 N R 10 E


TYPE MONUMENT BRASS MONUMENT ^(A) P.K. / ^(B) WASHER
ON SURFACE - BELOW 1 1/2" down surface
LEFT- & PAV'T. - RIGHT 2.6' & 2.8

^(B) 8.7 TO LT. EDGE PAVEMENT

S.L.M. (A) = 134 + 29

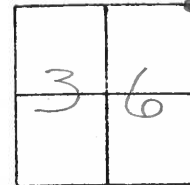

Set P.K.'s & Washers
5-31-91
MB

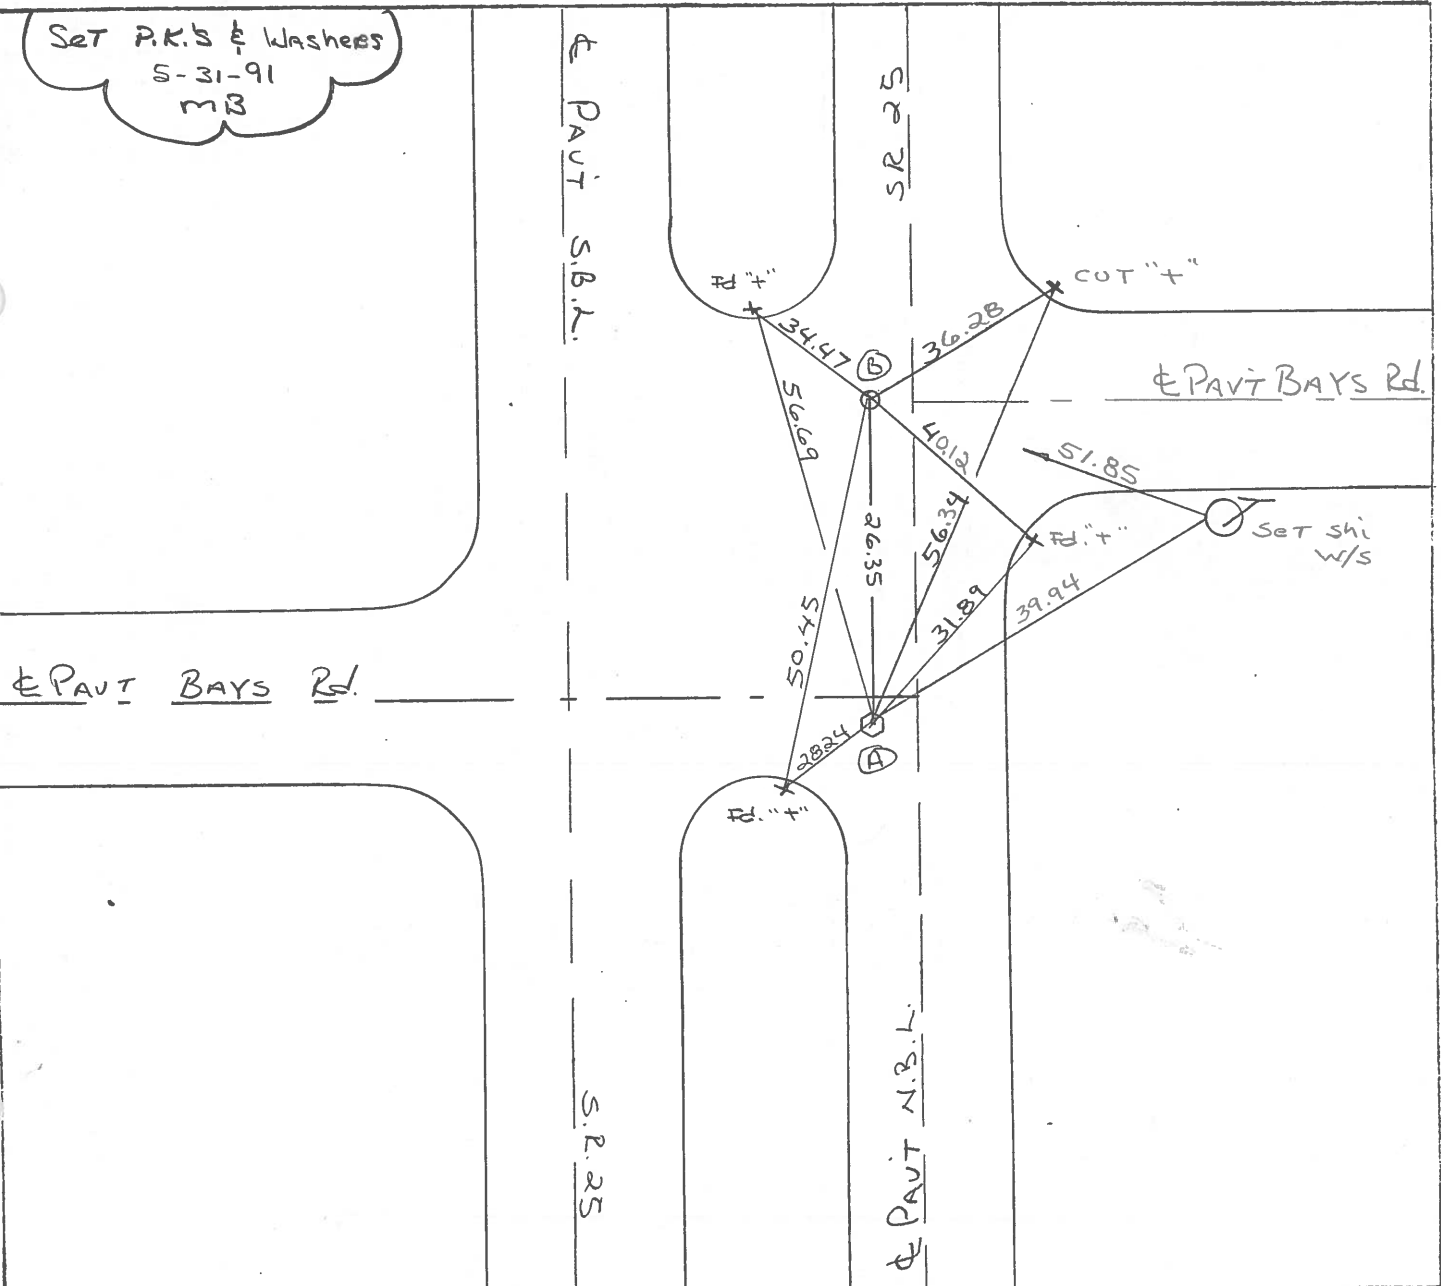


County WOOD S.R. - U.S. 25Township LIBERTYSection 36

T4N, R10E

Personnel HoffmanLochrkeHouseholder


(3)

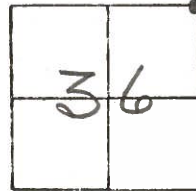Date 6-9-81 8-25-81Weather CLOUDYTemp. + 75°

Pt. "A" Fd. BRASS MON. @ SURFACE
2.5' W. of & PAVT, N.B. LANES

PROJECT STA. ± 134 + 76

Pt. "B" Fd. BRASS MON. @ SURFACE
2.7' W. of & PAVT, N.B. LANES

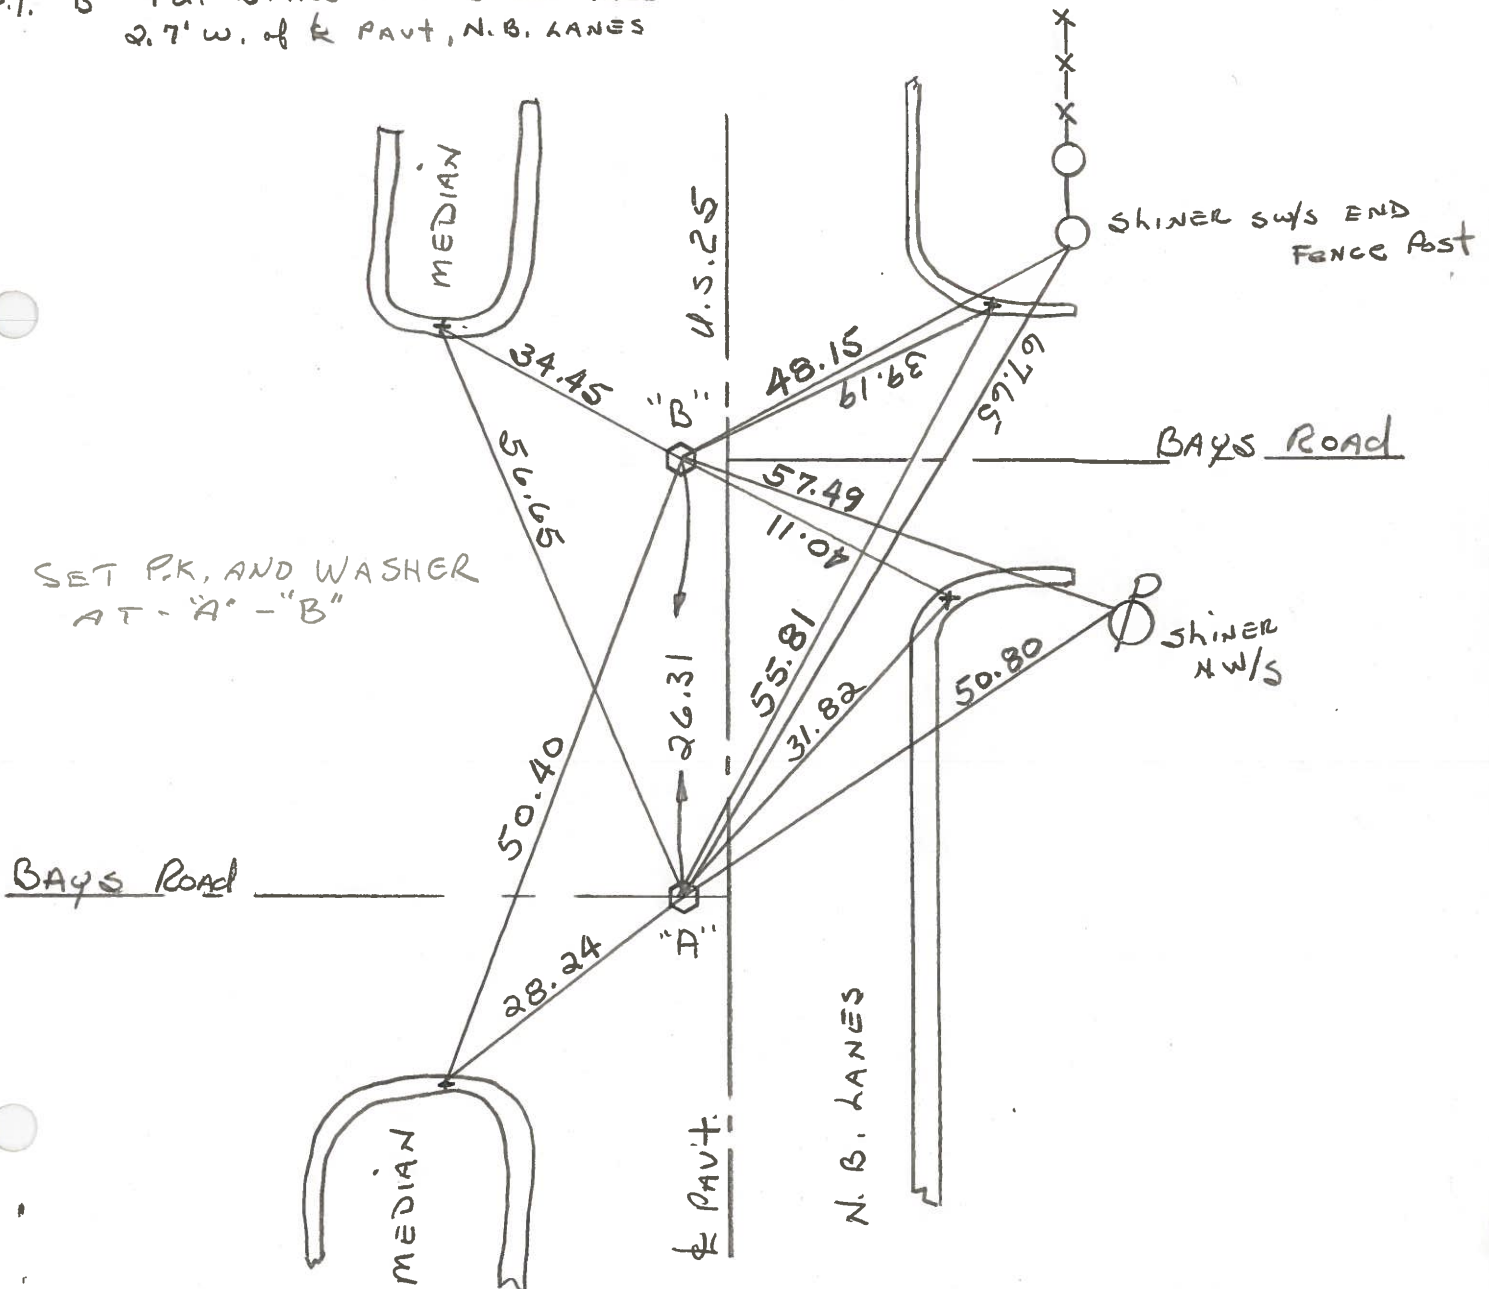

O.D.O.T. DISTRICT 2 SURVEY OFFICE

SHEET

OF

County WOOD ^{U.S.} ~~S.R.~~ 25

Township LIBERTY

Section 36

T4N, R10E

Personnel BURNSIDE


SMITH

BOWERS

Date 7-6-71

Weather CLEAR

Temp. 80°

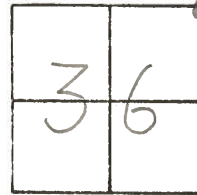

(3)

