

O.D.O.T. DISTRICT 2 SURVEY OFFICE (USE ONLY)

PERSONNEL

REFERENCE NO. 3A

SHEET OF

NOTES NIESE
H.C. NIESE
R.C. AUBLE

DATE 11/16/23
WEATHER WINDY
TEMP. 65°

ROUTE SR 25
COUNTY WOOD
TOWNSHIP PORTAGE
SECTION 36

DWG BY BARRIERE PID 92133

T 4 N R 11 E

TYPE MONUMENT MONBOX W/ 1" IPIN

ON SURFACE - BELOW ON

OFFSET Q PAVEMENT 1' RT OF EP LT : RT


 TO EDGE PAVEMENT

STATION: 106+99.59

HORIZ.DATUM: NAD83(11)/WOOD LDP GEOID: 18


GRID: NORTHING: 585668.432 EASTING: 1652353.638

LDP: NORTHING: 407510.220 EASTING: 164015.749

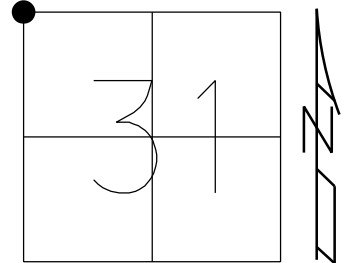

RECORD:
N.W. COR. SEC 31

SET PK/WASHER
10-31-01, SAH
FD PK NAIL
RECA3
5-30-18, JFO
FD PK
REFA3
10-1-18, JFO
FD BRASS DISK
FD MAG NAIL
REFA3
3-17-22, JFO
FD NEW MONBOX
W/ 1" IPIN
NEWREFA3
11/16/23, TDN

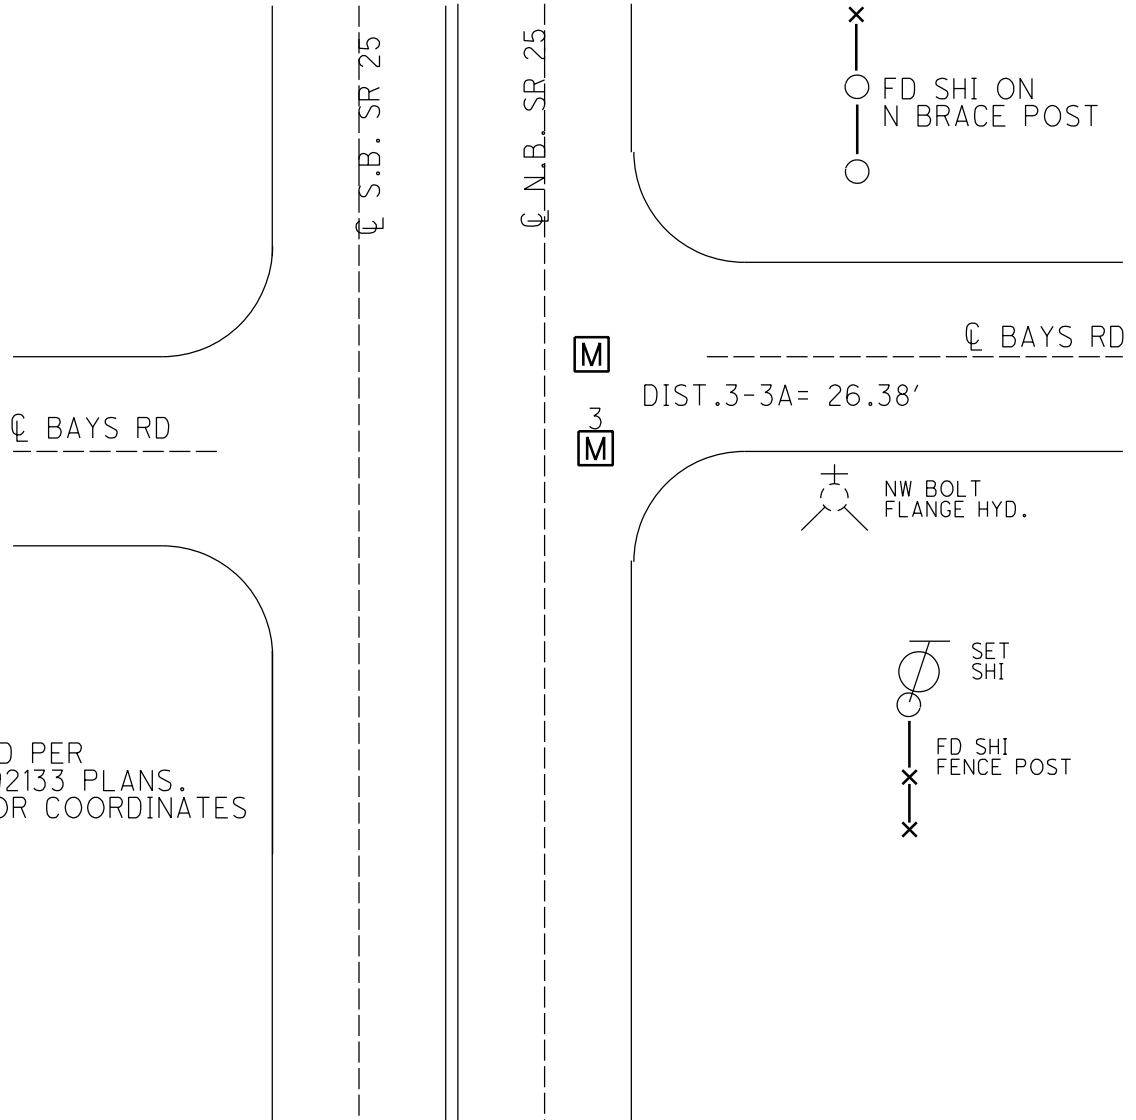

****NOTE****
POINT WAS ADJUSTED PER
WOO-25-0.75, PID 92133 PLANS.
SEE PLANS FOR PRIOR COORDINATES
AND INFORMATION.
**** ****

O.D.O.T. DISTRICT 2 SURVEY OFFICE (USE ONLY)

PERSONNEL

REFERENCE NO. 3A

SHEET 11 OF 36

NOTES RHOADES

DATE 5/30/18

ROUTE SR 25

H.C. O'DONNELL

WEATHER CLOUDY

COUNTY WOOD

R.C. TRENKA

TEMP. 77°

TOWNSHIP LIBERTY

SECTION 36

DWG BY MILLER

PID NO PID

T 4 N R 10 E

TYPE MONUMENT P.K.NAIL

ON SURFACE - ~~BELOW~~ ON

OFFSET CL PAVEMENT 2.8' LT : ~~RT~~

- TO - EDGE PAVEMENT


STATION: 134+55

HORZ.DATUM: NAD83(2011)


GEOID: NAVD88 2012A

GRID: NORTHING: 585668.412

EASTING: 1652354.031

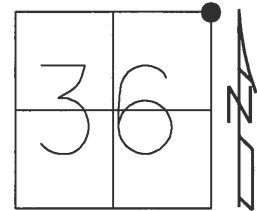

RECORD:
SET PK/WASHER
10-31-01, SAH
FD PK NAIL
RECA3
5-30-18, JFO
FD PK
REFA3
10-1-18, JFO

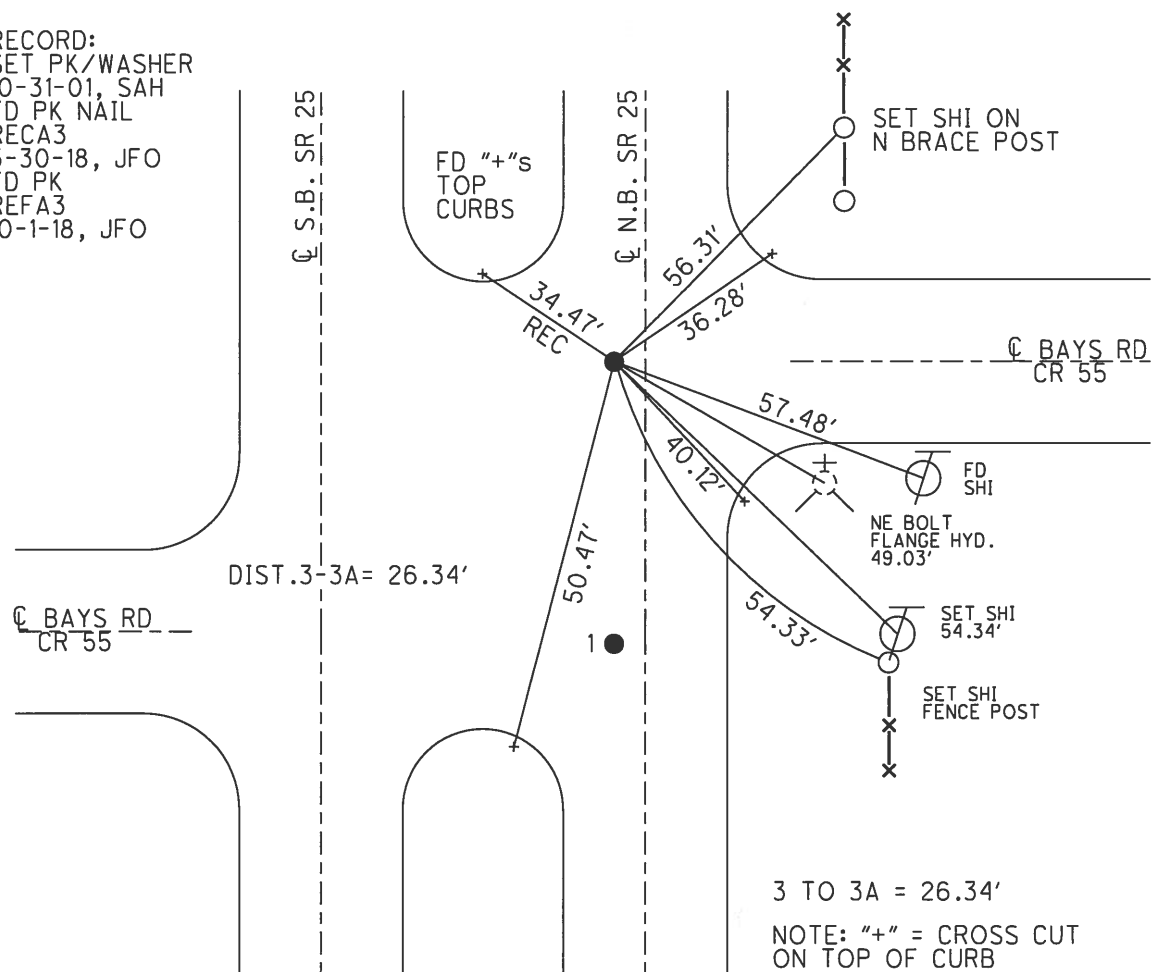

O.D.O.T. DISTRICT 2 SURVEY OFFICE

PERSONNEL

REFERENCE NO. 3

SHEET 6 OF 23

NOTES House

H.C. Rowe Soc

R.C. Van Dusen

DATE 4-12-61

WEATHER pt. Cldy - Windy

TEMP. 72°F

ROUTE SE-25

COUNTY Wood

TOWNSHIP Liberty

SECTION 36

T 4 N R 10 E



TYPE MONUMENT (A) PK/W (S) PK/W

ON SURFACE - BELOW Surface

(LEFT - & PAV'T. - RIGHT) (A) 2.6' (B) 2.8'

 JO EDGE PAVEMENT

S.L.M. (A) 134 + 29 (B) 134 + 55

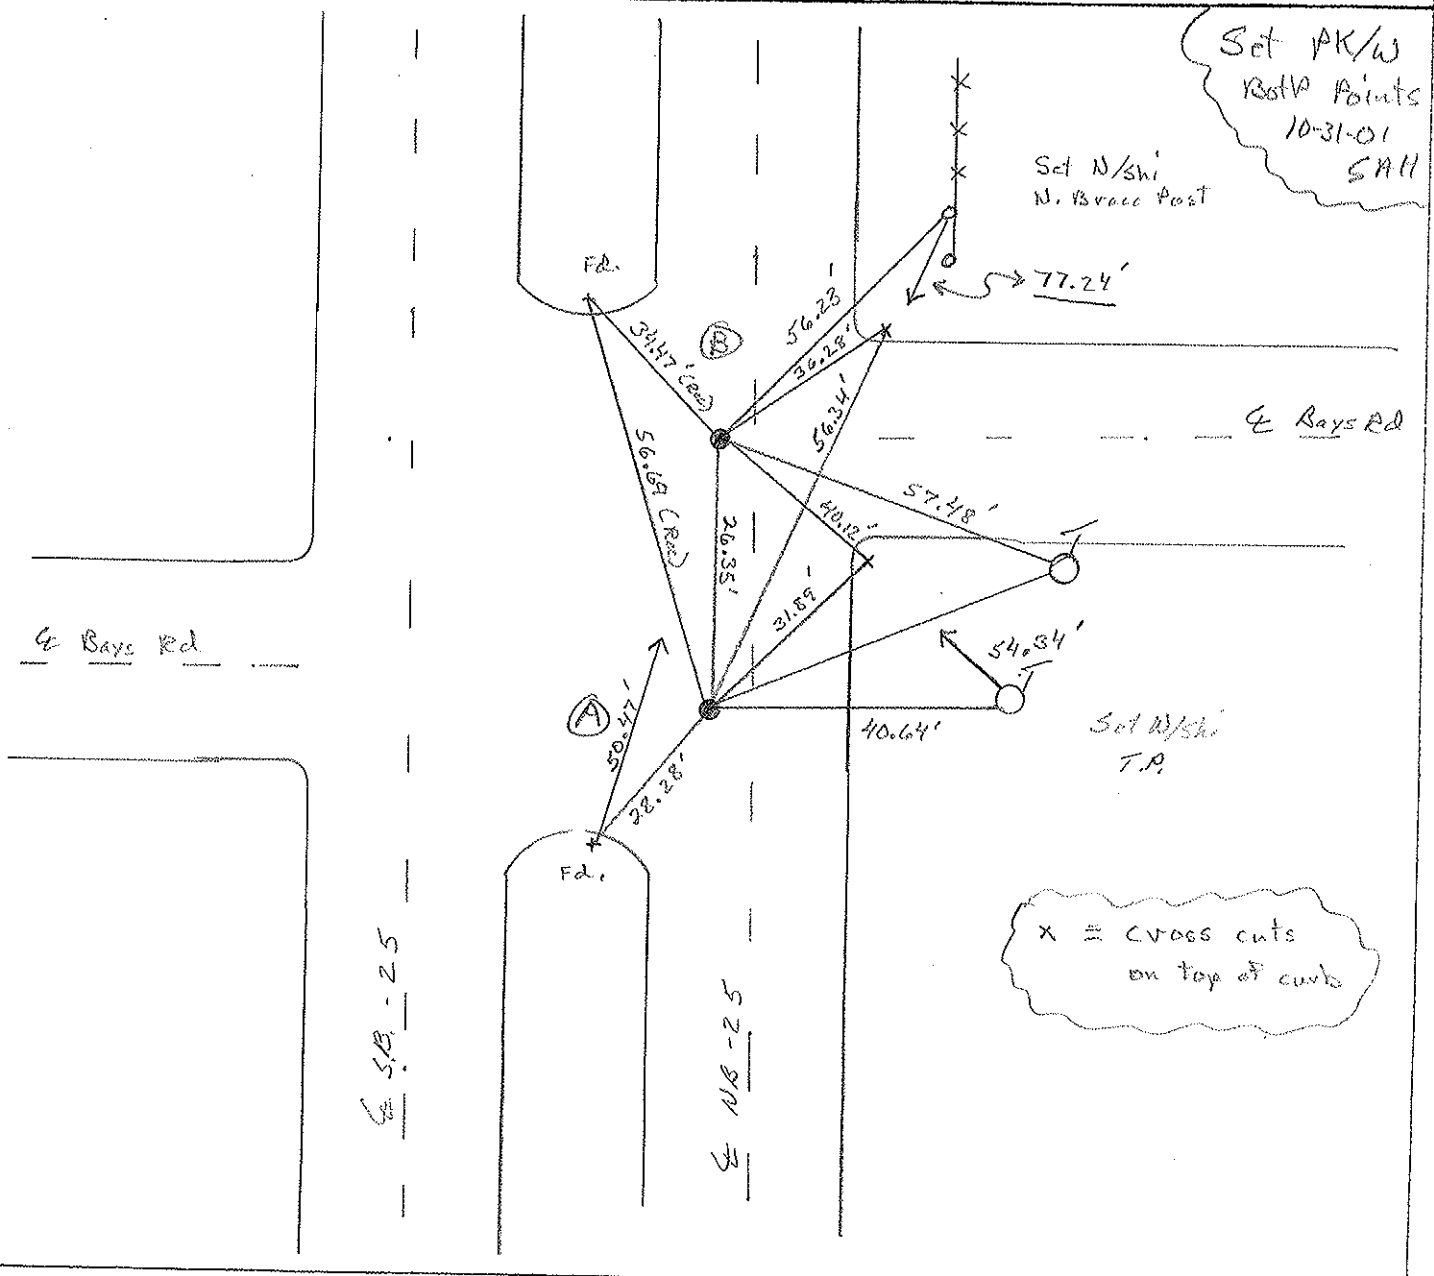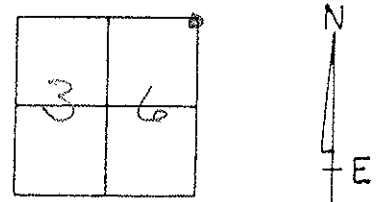

O.D.O.T. DISTRICT 2 SURVEY OFFICE

PERSONNEL

REFERENCE NO. 3

SHEET 6 OF 23

NOTES Huss

H.C. Rousos

R.C. Van Dusen

DATE 4-12-01

WEATHER pt. Cldy - Windy

TEMP. 72°F

ROUTE SR-25

COUNTY Wood

TOWNSHIP Liberty

SECTION 36

T 4 N R 10 E



TYPE MONUMENT (A) PK/W (B) PK/W

ON SURFACE - BELOW Surface

LEFT - & PAV'T. - RIGHT (A) 2.6' (B) 2.8'

TO EDGE PAVEMENT

S.L.M. (A) 134+29 (B) 134+55

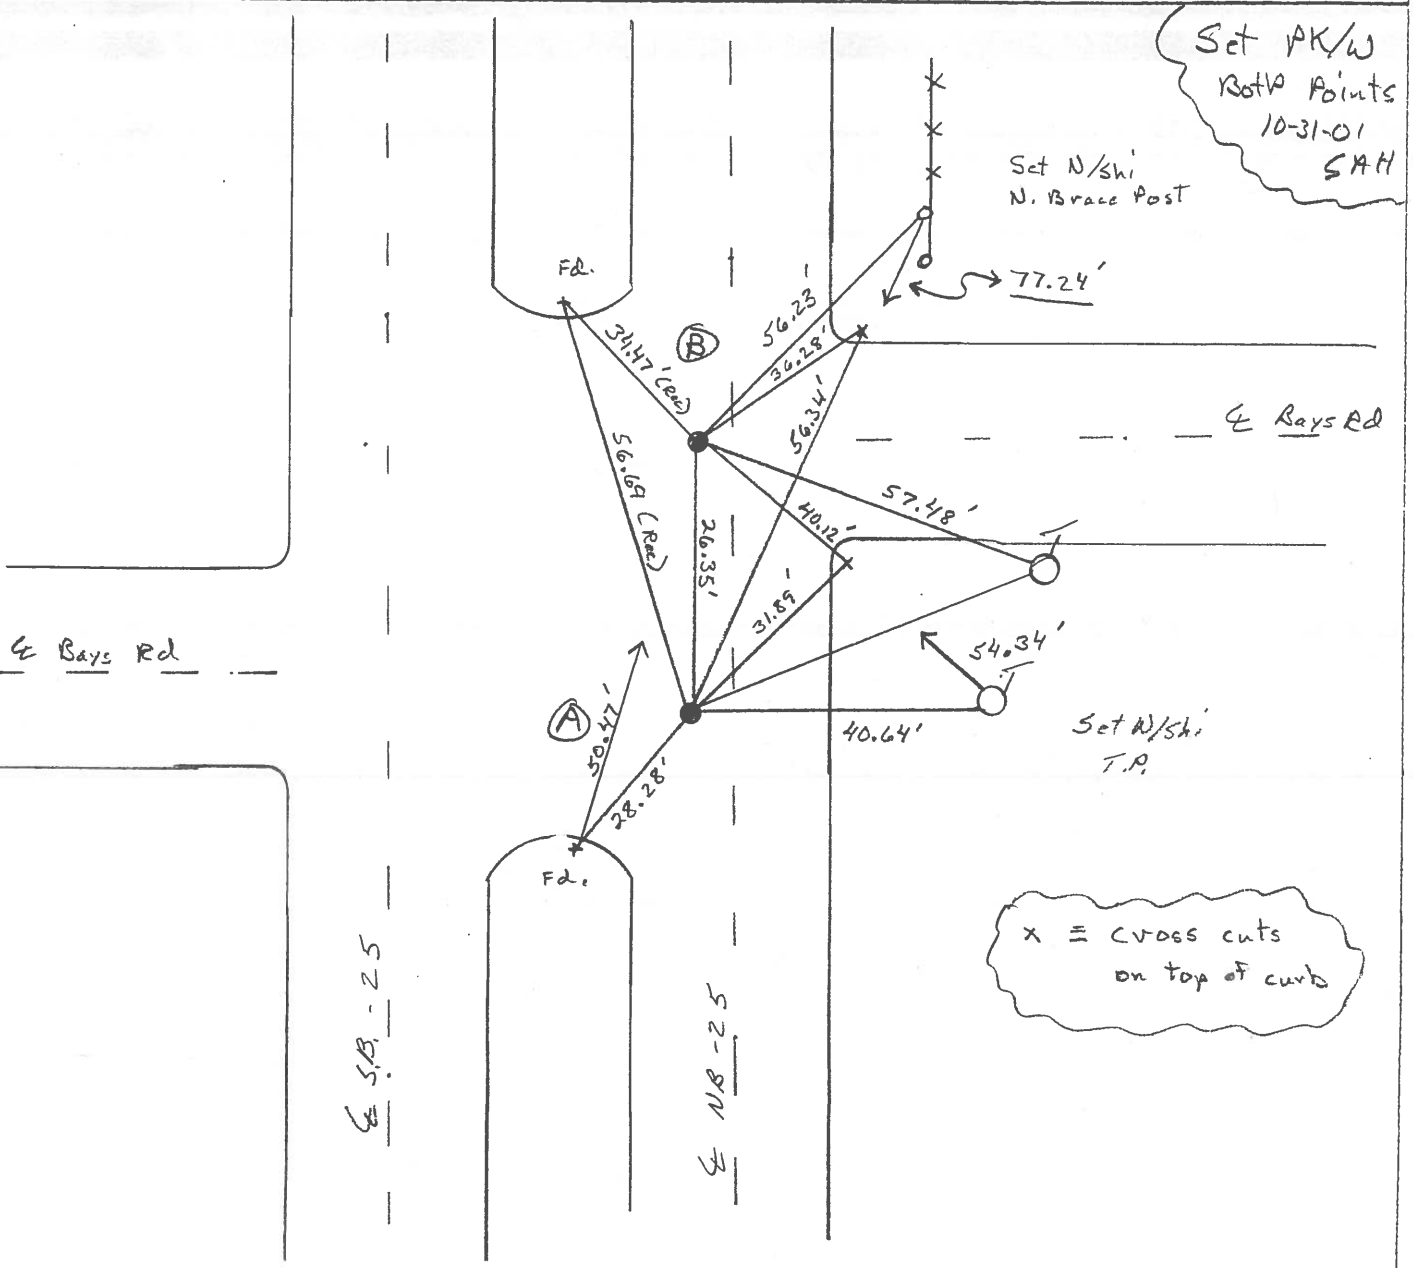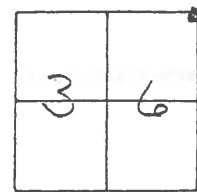

O.D.O.T. DISTRICT 2 SURVEY OFFICE

PERSONNEL

REFERENCE NO. 3

SHEET 6 OF 23

NOTES HOFFMAN

H.C. LOEHRIKE

R.C. BARNHISEL

DATE 3-22-91

WEATHER CLOUDY

TEMP. 55°

ROUTE SR 25

COUNTY WOOD

TOWNSHIP LIBERTY

SECTION 36

T4 N R 10 E


TYPE MONUMENT BRASS MONUMENT ^(A) P.K. / WASHER ^(B)

ON SURFACE - BELOW 1 1/2" down f surface


LEFT - PAV'T. - RIGHT 2.6' f 2.8'

8.7 TO LT. EDGE PAVEMENT

S.L.M. (A) = 134 + 29

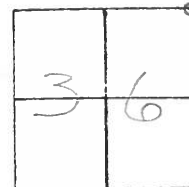

Set P.K.'s & Washers
5-31-91
mB

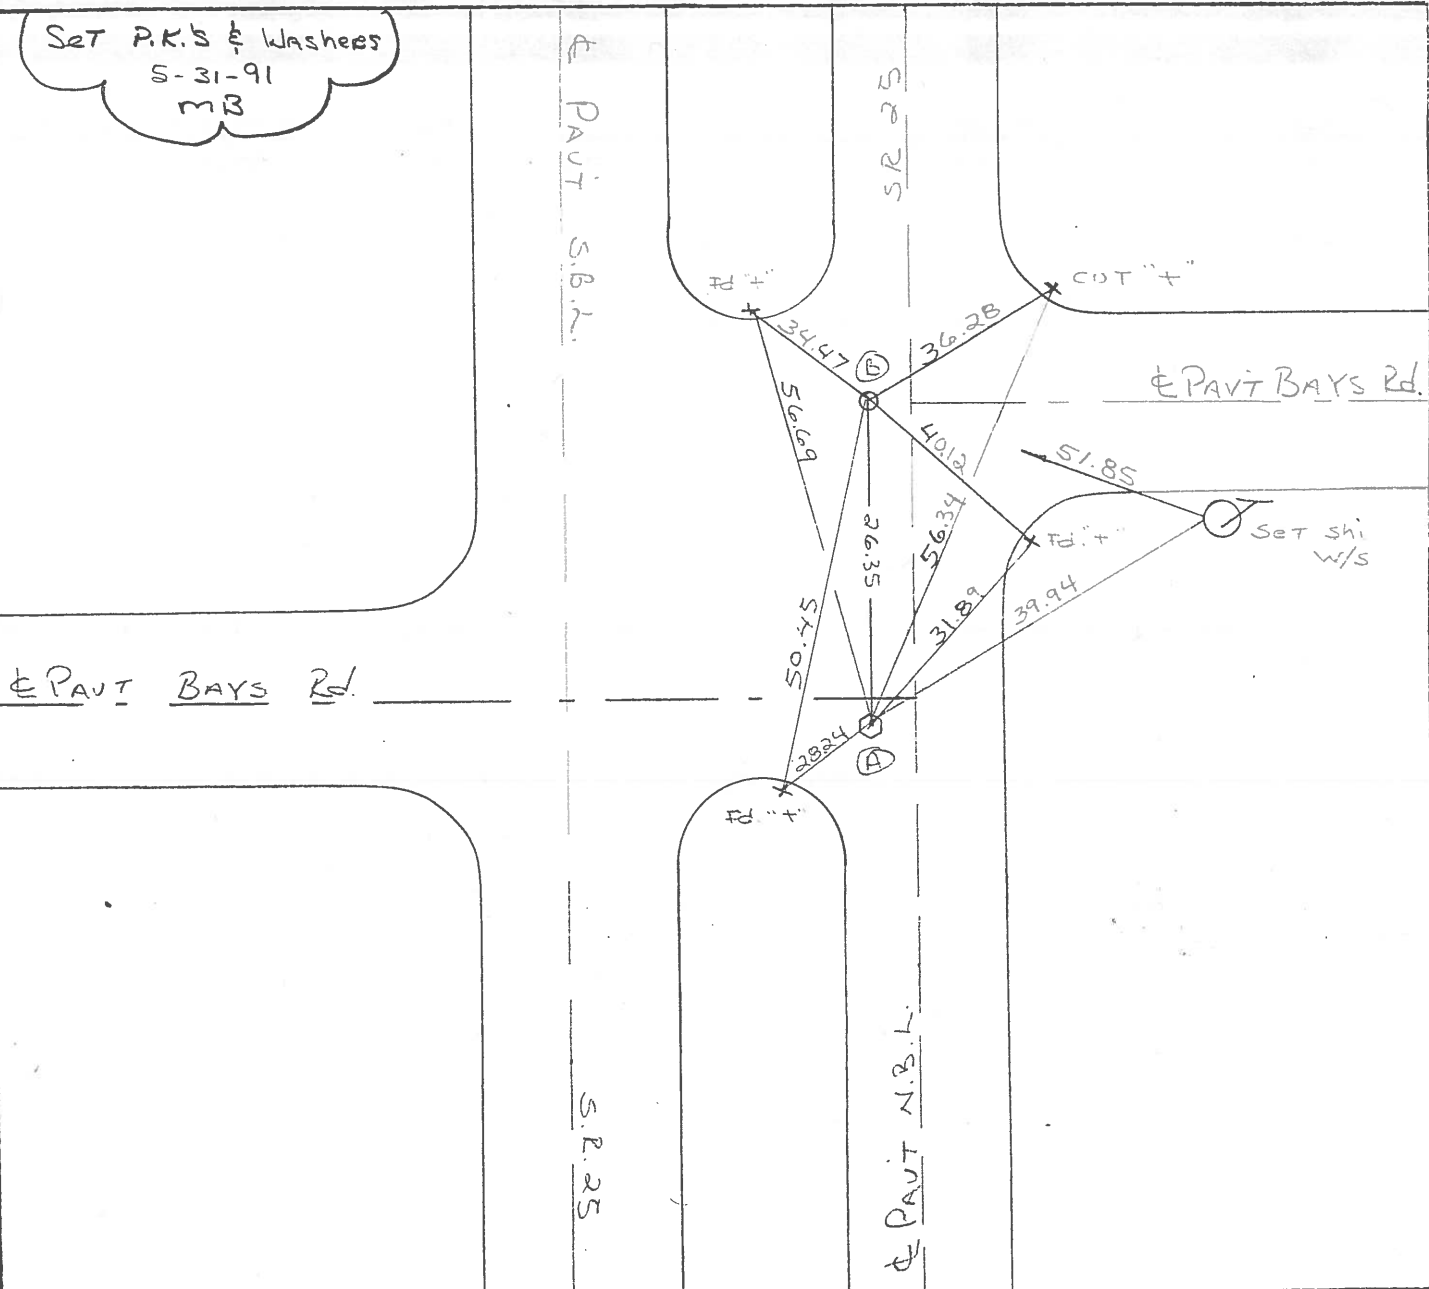


County WOOD S.R. - U.S. 25Township LIBERTYSection 36

T4N, R10E

Personnel HoffmanLochrkeHouseholder


(3)

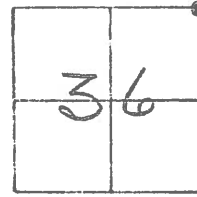Date 6-9-81 8-25-81Weather CloudyTemp. + 75°

Pt. "A" Fd. BRASS MON. @ SURFACE
2.5' W. of & PAVT, N.B. LANES

PROJECT STA. ± 134 + 76

Pt. "B" Fd. BRASS MON. @ SURFACE
2.7' W. of & PAVT, N.B. LANES

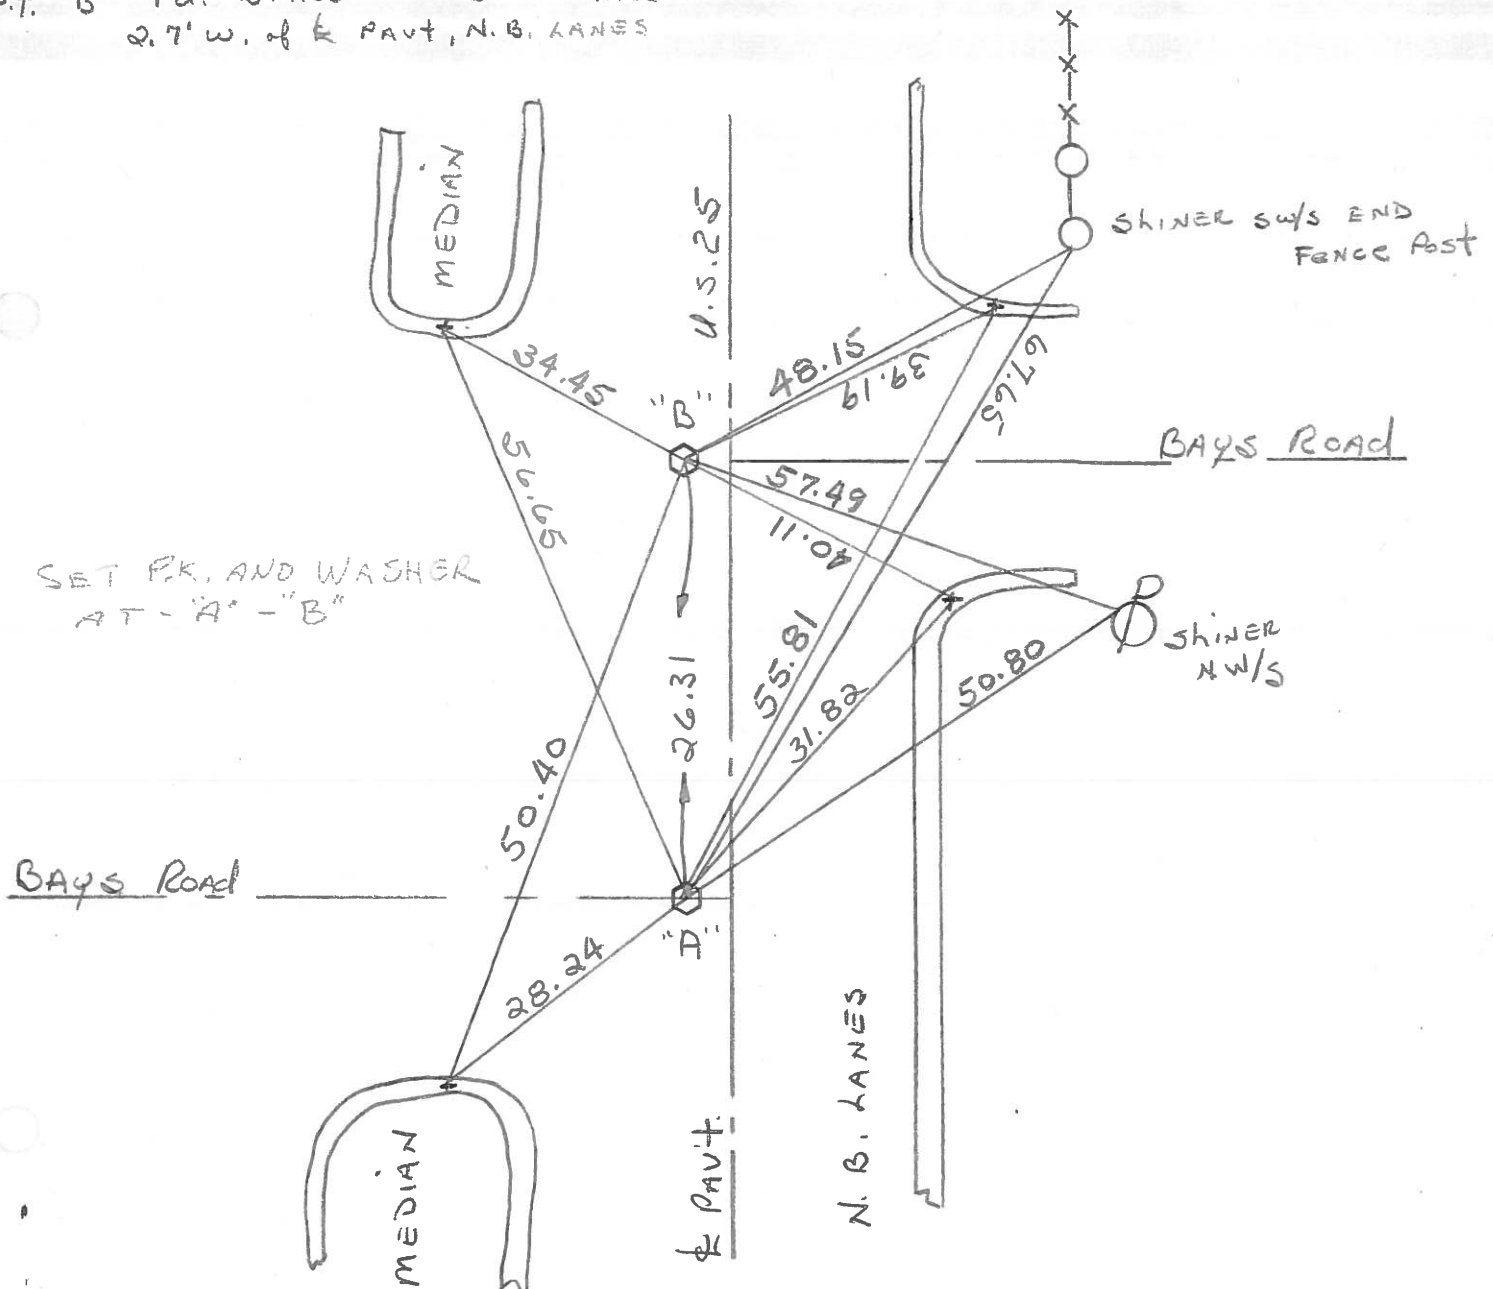

O.D.O.T. DISTRICT 2 SURVEY OFFICE

SHEET

OF

County WOOD ^{U.S.} ~~S.R.~~ 25

Township LIBERTY

Section 36

T4N, R10E

Personnel BURNSIDE

SMITH



BOWERS

(3)

Date 7-6-71

Weather CLEAR

Temp. 80°

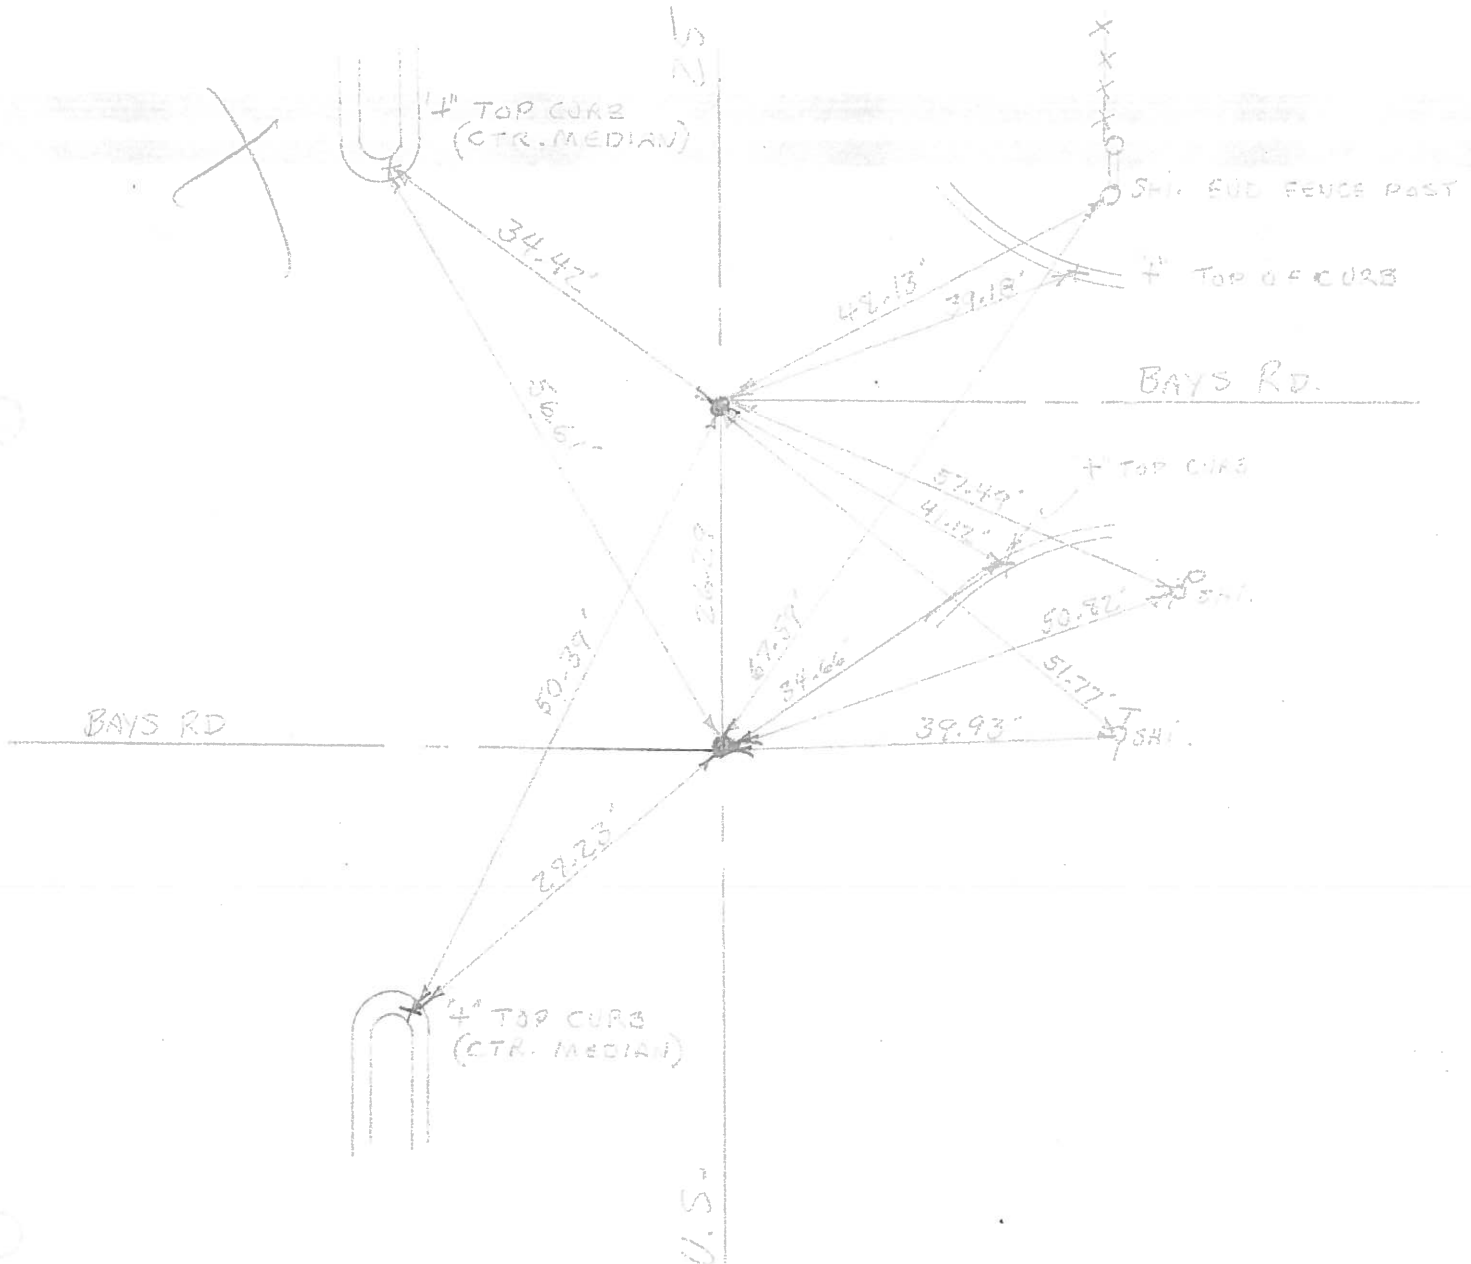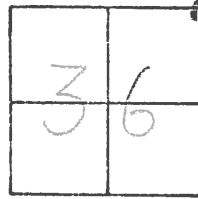

PERSONNEL

TITLE

PERSONNEL

TITLE

COUNTY

Wood

DATE

checked 4/1/60

S. R.

U.S. #25

WEATHER

SEC.

TEMP.

DESCRIPTION

LEFT

CENTER LINE

RIGHT

JOB NO.

Sta. 350+21.7
E. 1/4 post sec. 36 Liberty
Twp.
Iron pipe

#229

X on E. end conc. Hdwl. W.N.W. 34.60'
Shiner in T.P. S.E. 58.40
Shiner in T.P. N.E. 70.34
N.E. cor. house fdn. S.W. 60.70

Sta. 376+60.2
N.E. Cor. sec. 36 Liberty
Twp. Bays Road West
Brass plate

#230

Shiner Core ^{Fence} Post N.E. 67.60
X on E. end conc. hdwl. N.W. 55.30
Shiner in P.P. S.W. 45.92
Shiner in T.P. S.E. 39.91 39.80
E. edge of pavement 14.5
W. edge of pavement 5.5
Shiner P. Pole E. 51.07

Sta. 376+86.7
N.W. cor. sec. 31 Portage
Twp. Bays Road East
Brass plate

③

#231

X E. end conc. hdwl. W. 48.63'
Shiner in P.P. S.W. 67.20'
Shiner in T.P. S.E. 51.58
Shiner in Cor. Post N.E. 48.15
Shiner in P. Pole S.E. 57.44
Shiner in T. Pole S.S.E. 51.69

Sta. 403+07.8
E. 1/4 post sec. 25 Liberty
Twp. W. edge N. Bound line
Iron pipe over stone

#232

Shiner in P.P. N.W. 60.90
Shiner in twin T.P. S.E. 69.08
P.W. mon. W. 65.15
W. edge of pavement E. 3.45
Shiner Core Post S.E. 39.07
Shiner Cor. Post N.E. 39.18
Shiner T. Pole N.N.E. 88.76