

O.D.O.T. DISTRICT 2 SURVEY OFFICE (USE ONLY)

PERSONNEL

REFERENCE NO. 4

SHEET OF

NOTES ASTON
H.C. NIESE
R.C. MILLER

DATE 11/15/23
WEATHER CLEAR
TEMP. 60°

ROUTE SR 25
COUNTY WOOD
TOWNSHIP LIBERTY
SECTION 25

DWG BY BARRIERE PID 92133

T 4 N R 10 E

TYPE MONUMENT MAG NAIL/WASHER

ON SURFACE - BELOW ON

OFFSET $\varnothing$ PAVEMENT 19' RT LT : RT


 TO EDGE PAVEMENT

STATION: 128+56.31

HORZ.DATUM: NAD83(11)/WOOD LDP GEOID: 18

GRID: NORTHING: EASTING:


LDP: NORTHING: 409666.841 EASTING: 164001.557

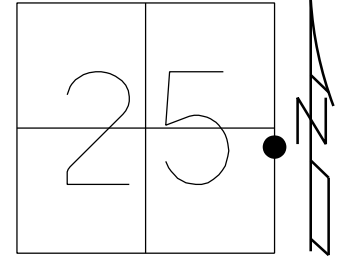

RECORD:

FD P.K./WASHER
4/12/01, TMR
SET P.K./WASHER
10-31-01, SAH
FD P.K./SHANK
REF 4
5-30-18, JFO
SET MAG/WASHER
10-1-18, JFO
FD MAG NAIL
REF 4
3/17/22, JFO
SET MAG/WASHER
11/15/23, TDN

TOP BONNET
BOLT HYD

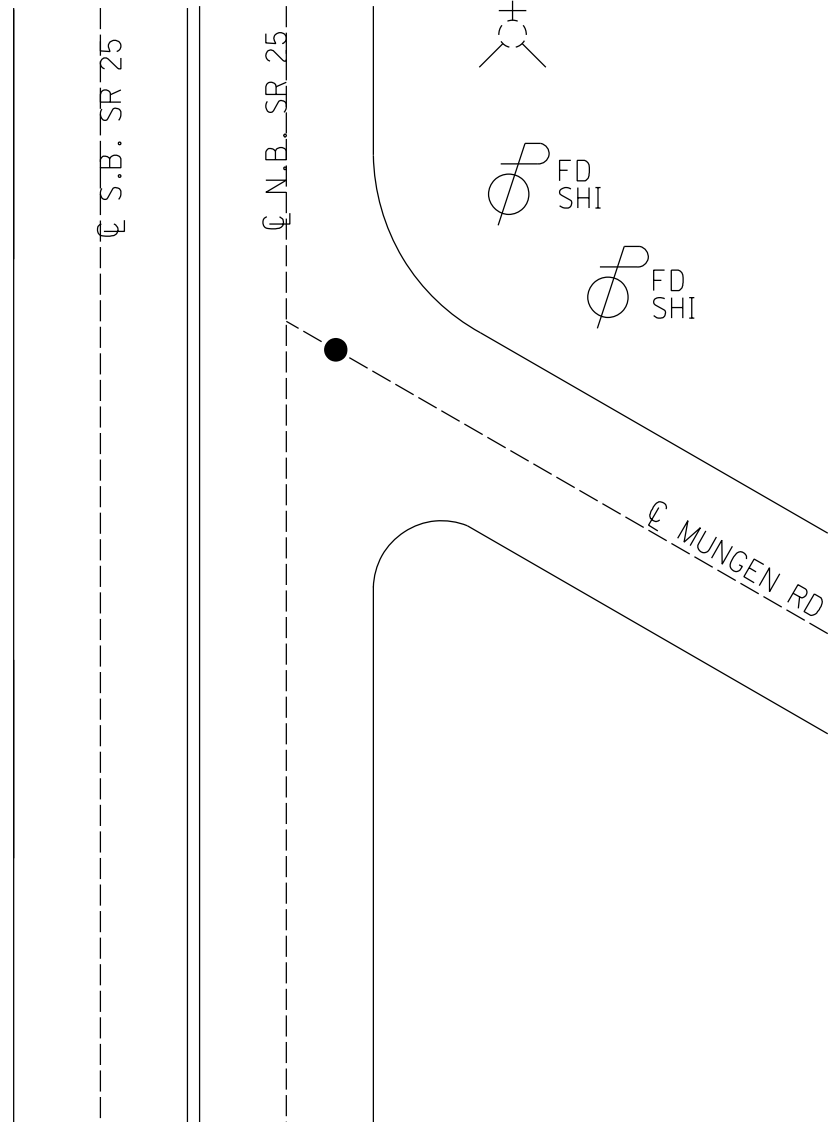

O.D.O.T. DISTRICT 2 SURVEY OFFICE (USE ONLY)

PERSONNEL

REFERENCE NO. 4

SHEET 12 OF 36

NOTES RHOADES

DATE 5/30/18

ROUTE SR 25

H.C. O'DONNELL

WEATHER CLOUDY

COUNTY WOOD

R.C. TRENKA

TEMP. 77°

TOWNSHIP LIBERTY

SECTION 25

DWG BY MILLER

PID NO PID

T 4 N R 10 E

TYPE MONUMENT P.K.SHANK

ON SURFACE - ~~BELOW~~ ON

OFFSET Q PAVEMENT 10.3' LT : ~~RT~~

1' LT TO LT EDGE PAVEMENT


STATION: 156+10

HORZ.DATUM: NAD83(2011)

GEOID: NAVD88 2012A

GRID: NORTHING: 587824.888

EASTING: 1652367.858

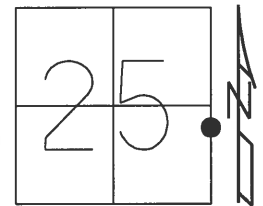

RECORD:
FD P.K./WASHER
4/12/01, TMR
SET P.K./WASHER
10-31-01, SAH
FD P.K./SHANK
REF4
5-30-18, JFO
SET MAG/WASHER
10-1-18, JFO

Q S.B. SR 25

Q N.B. SR 25

TOP BONNET
BOLT HYD

49.89'

40.41' FD
SHI

62.98' FD
SHI

38.10' REC

13.19'

Q MUNGEN RD

FD "+"s
TOP
CURBS

O.D.O.T. DISTRICT 2 SURVEY OFFICE

PERSONNEL

REFERENCE NO. 4

SHEET 7 OF 23

NOTES Huss

H.C. Rousos

R.C. Van Duern

DATE 4-12-01

WEATHER Pt Cldy-Wind

TEMP. +72°F

ROUTE SR-25

COUNTY Wash

TOWNSHIP Liberty

SECTION 25

T 4 N R 10 E



TYPE MONUMENT PK/W

ON SURFACE - ~~BELOW~~ Surface

LEFT - C PAV'T - RIGHT 10.3'

1' Lt. TO Lt. EDGE PAVEMENT

S.L.M. _____ 156710

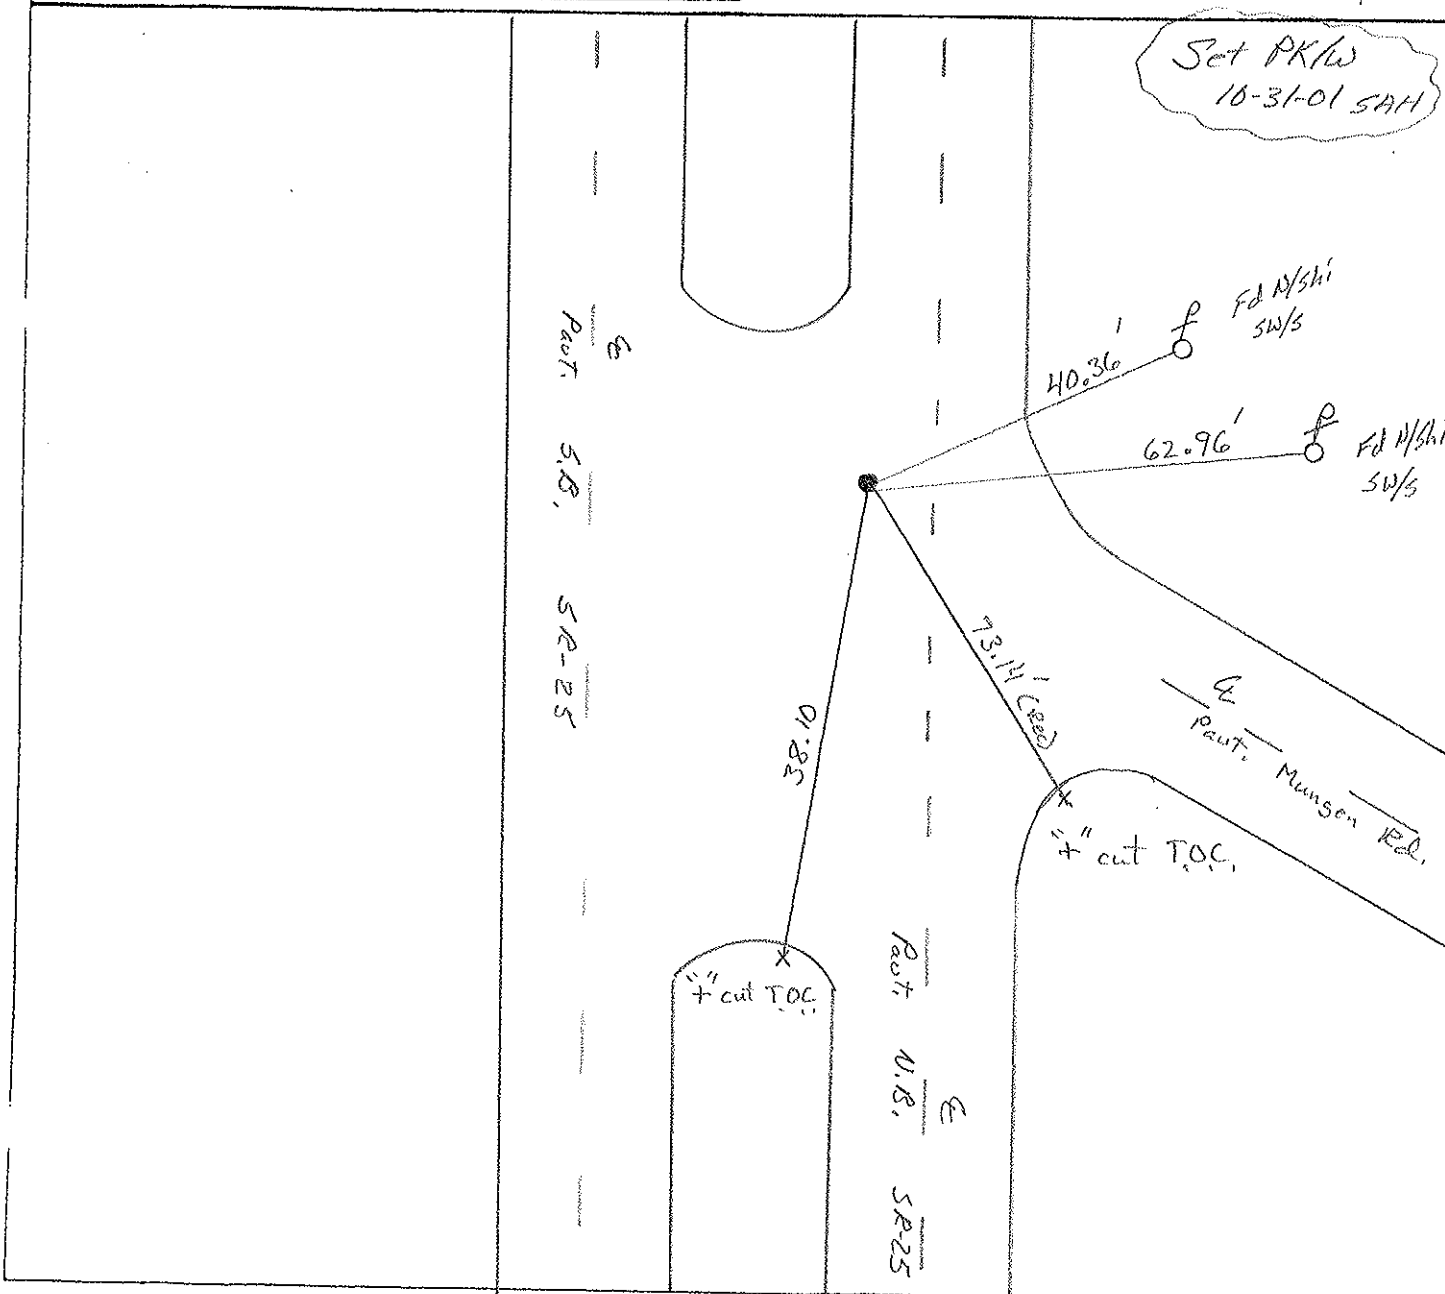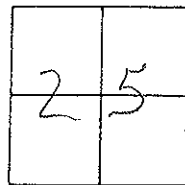

O.D.O.T. DISTRICT 2 SURVEY OFFICE

PERSONNEL

REFERENCE NO. 4

SHEET 7 OF 23

NOTES HOFFMAN

H.C. LOENRKE

R.C. BARNISSEL

DATE 3-22-91

WEATHER CLOUDY

TEMP. 55°

ROUTE SR 25

COUNTY WOOD

TOWNSHIP LIBERTY

SECTION 25

T4 N R 10 E


TYPE MONUMENT P.K. / WASHER

ON SURFACE - BELOW YES

LEFT- & PAW'T. - RIGHT 10.9

0.0 TO LT EDGE PAVEMENT

S.L.M. 156 +10

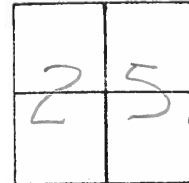

Set P.K. & Washer
6-5-91
MB

PAWT S.B.L.

SR 25

40.36 P.F. Shi SW/S

62.96 P.F. Shi SW/S

73.14

PAWT MONGEN Rd.

38.10

Pd. +

CUT "4"
4' FROM
END OF CURB

SR 25

PAWT N.B.L.

O.D.O.T. DISTRICT 2 SURVEY OFFICE

SHEET 4 OF

County WOOD S.R.-U.S. 25

Township Liberty

Section 25

T4N, R10E

Personnel Hoffman

Loehrke


Householder

4

Date 6-9-81 8-25-81


Weather Cloudy

Temp. +75°

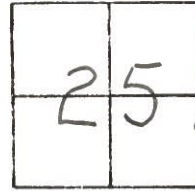

Fd. P.K. @ SURFACE
11.0' W. of & PAVT, N.B. LANES

PROJECT STA. ± 156 + 62

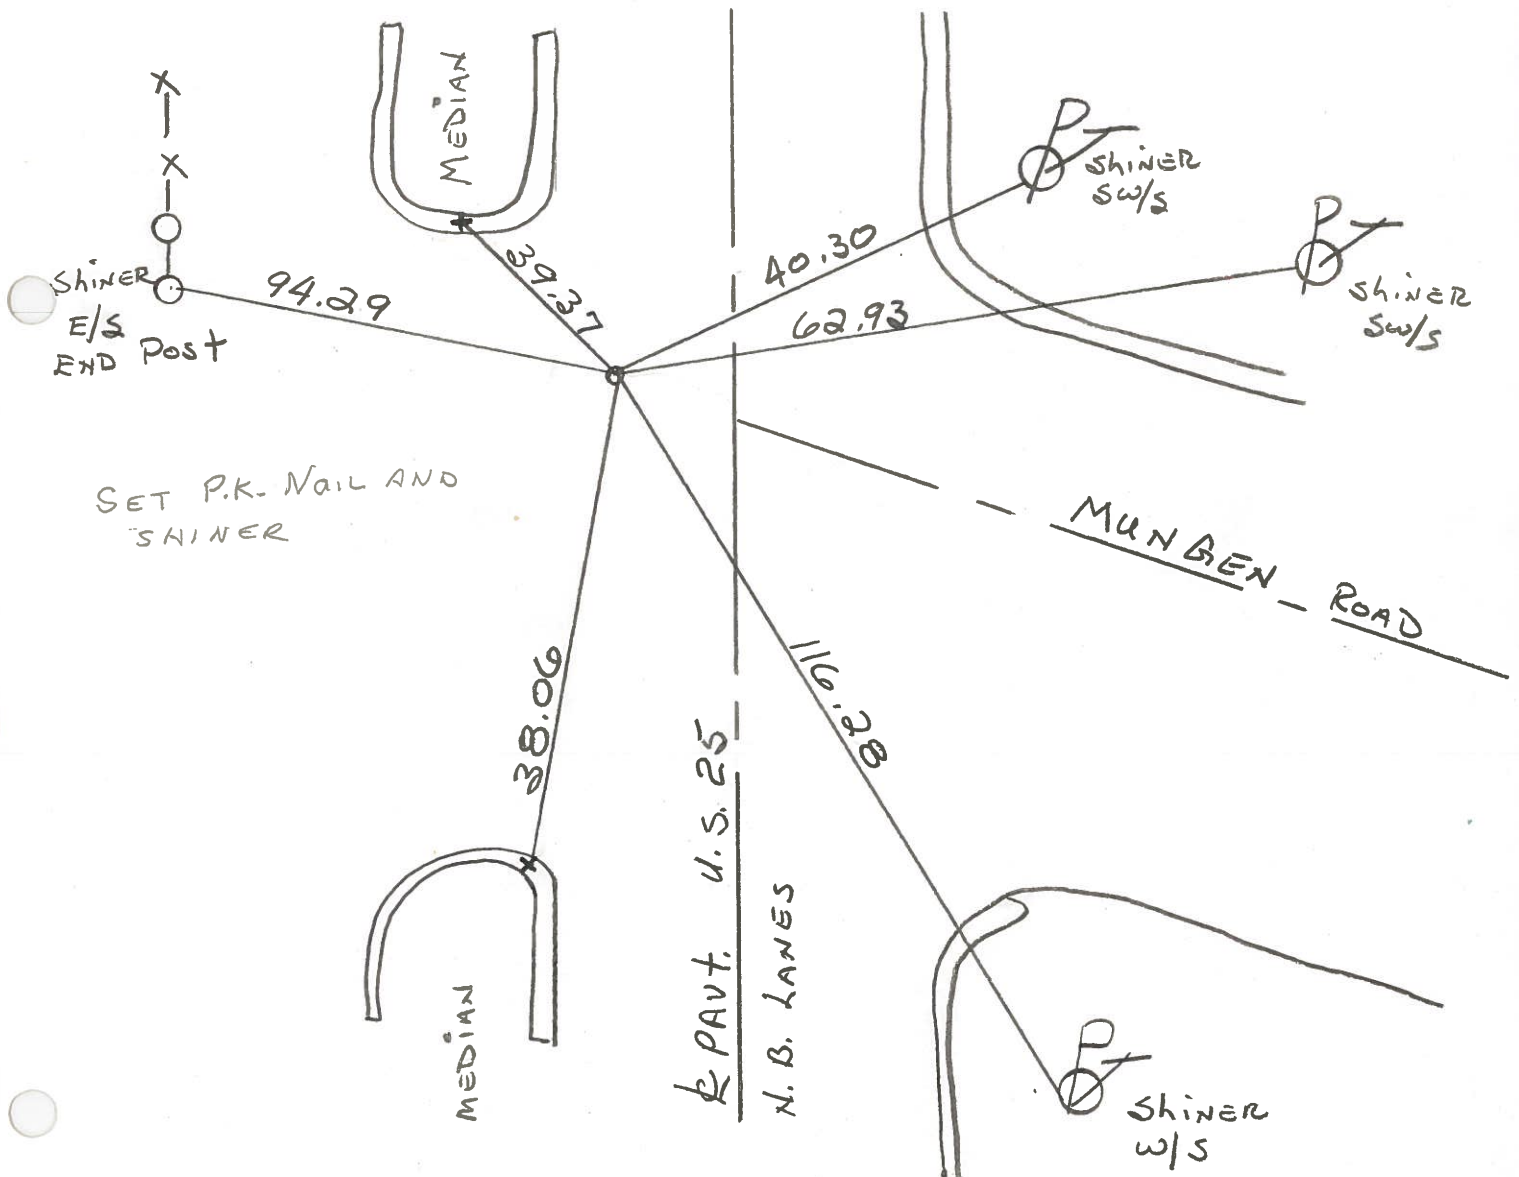

OF

