

O.D.O.T. DISTRICT 2 SURVEY OFFICE (USE ONLY)

PERSONNEL

REFERENCE NO. 5

SHEET OF

NOTES NIESE
H.C. ASTON
R.C. ASTON

DATE 11/20/23
WEATHER CLEAR
TEMP. 37°

ROUTE SR 25
COUNTY WOOD
TOWNSHIP PORTAGE
SECTION 25

DWG BY BARRIERE PID 92133

T 4 N R 11 E

TYPE MONUMENT MONBOX W/ 1" IPIN

ON SURFACE - BELOW ON

OFFSET $\varnothing$ PAVEMENT 19.6' RT LT : RT


 TO EDGE PAVEMENT

STATION: 133+25.93

HORIZ.DATUM: NAD83(11)/WOOD LDP GEOID: 18

GRID: NORTHING: 588294.446 EASTING: 1652370.907

LDP: NORTHING: 410136.442 EASTING: 163998.389

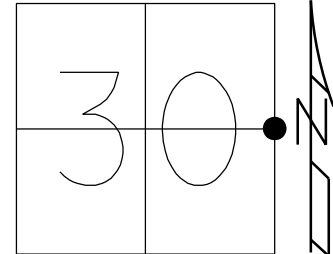

RECORD: P.I.
E 1/4 SEC 25

STA.403+07.8
FD BRASS MON
FD P.K./WASHER
4/12/01, TMR
SET P.K./WASHER
10-31-01, SAH
D.N.F POINT
FD HOLE
REF5
5-30-18
10-1-18, JFO
FD BRASS DISK
FD MAG NAIL
REF5
3/17/22, JFO
FD NEW MONBOX
W/ 1" IPIN
CHECKED W/ GPS
DID NOT PULL TIES
NEWREF5
11/20/23, TDN

FD SHI
FENCE POST

GRAVEL DRIVE

$\varnothing$ S.B. SR 25

$\varnothing$ N.B. SR 25

SET MAG NAIL
BY GPS
(ORIGIN UNKNOWN)

FD MONBOX
W/ 1" IPIN

DIST. 5-5A=5.30'

FD MONBOX
W/ 1" IPIN



O.D.O.T. DISTRICT 2 SURVEY OFFICE (USE ONLY)

PERSONNEL

REFERENCE NO. 5

SHEET 13 OF 36

NOTES HUSS
H.C. ROUSOS
R.C. VAN DUSEN

DATE 4/12/01
WEATHER CLOUDY/WINDY
TEMP. 72°

ROUTE SR 25
COUNTY WOOD
TOWNSHIP LIBERTY
SECTION 25
T 4 N R 10 E

DWG BY MILLER PID NO PID

TYPE MONUMENT CNPT

ON SURFACE - ~~BELOW~~ ON

OFFSET Q PAVEMENT - LT : ~~RT~~

ON TO LT EDGE PAVEMENT


STATION: 160+75

HORIZ.DATUM: NAD83(2011)

GEOID: NAVD88 2012A

GRID: NORTHING: 588289.174

EASTING: 1652370.837

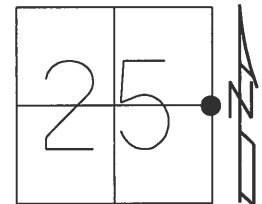

RECORD:
STA. 403+07.8
FD BRASS MON
FD P.K./WASHER
4/12/01, TMR
SET P.K./WASHER
10-31-01, SAH
D.N.F POINT
FD HOLE
REF5
5-30-18
10-1-18, JFO

Q N.B. SR 25

Q N.B. SR 25

FD SHI
FEN POST  95.52' REC ● 5A

DIST. 5-5A = 5.29' REC

O.D.O.T. DISTRICT 2 SURVEY OFFICE

PERSONNEL

REFERENCE NO. 5

SHEET 8 OF 23

NOTES Huss

H.C. Rousos

R.C. VanDusen

DATE 4-12-01

WEATHER Pt Cldy - Windy

TEMP. +72°F

ROUTE SR-25

COUNTY Wood

TOWNSHIP Liberty

SECTION 25

T 4 N R 10 E


TYPE MONUMENT (A) PK/W (B) PK

ON SURFACE - ~~BELOW~~ Surface

LEFT - & PAW'T - ~~RIGHT~~ On Lt. EOP

0 TO Lt. EDGE PAVEMENT

S.L.M. (A) 160+75 B 160+80

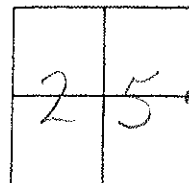


Record:

Point (A) - Brass Mon.
Sta 403+07.8

Point (B) Origin
Unknown

Set PK/W
Both Points
10-31-01
SAH

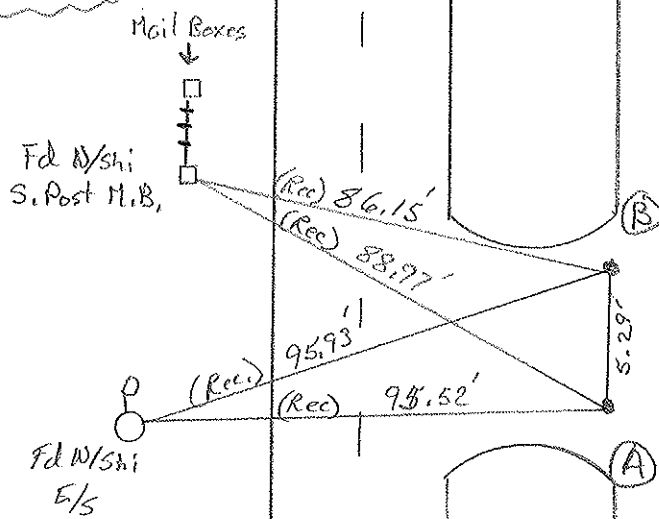

W Post.
S.B. SR-25

W Post.
N.B. SR 25

O.D.O.T. DISTRICT 2 SURVEY OFFICE

PERSONNEL

REFERENCE NO. 5

SHEET 8 OF 23

NOTES HOFFMAN

H.C. LOENRCE

R.C. BARNHISEL

DATE 3-22-91

WEATHER CLOUDY

TEMP. 55°

ROUTE SR 25

COUNTY WOOD

TOWNSHIP LIBERTY

SECTION 25

T 4 N R 10 E


TYPE MONUMENT P.K. / WASHER & P.K. (ORIGIN UNKNOWN)

ON SURFACE - BELOW

LEFT- & PAV'T. - RIGHT


ON TO LT. EDGE PAVEMENT

S.L.M. 160+75 - PT "A"

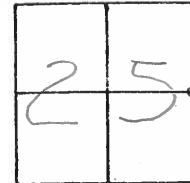

Set P.K. & Washer
6-5-91
MB

RECORD: POINT "A"
BRASS MONUMENT
Sta 403+07.8

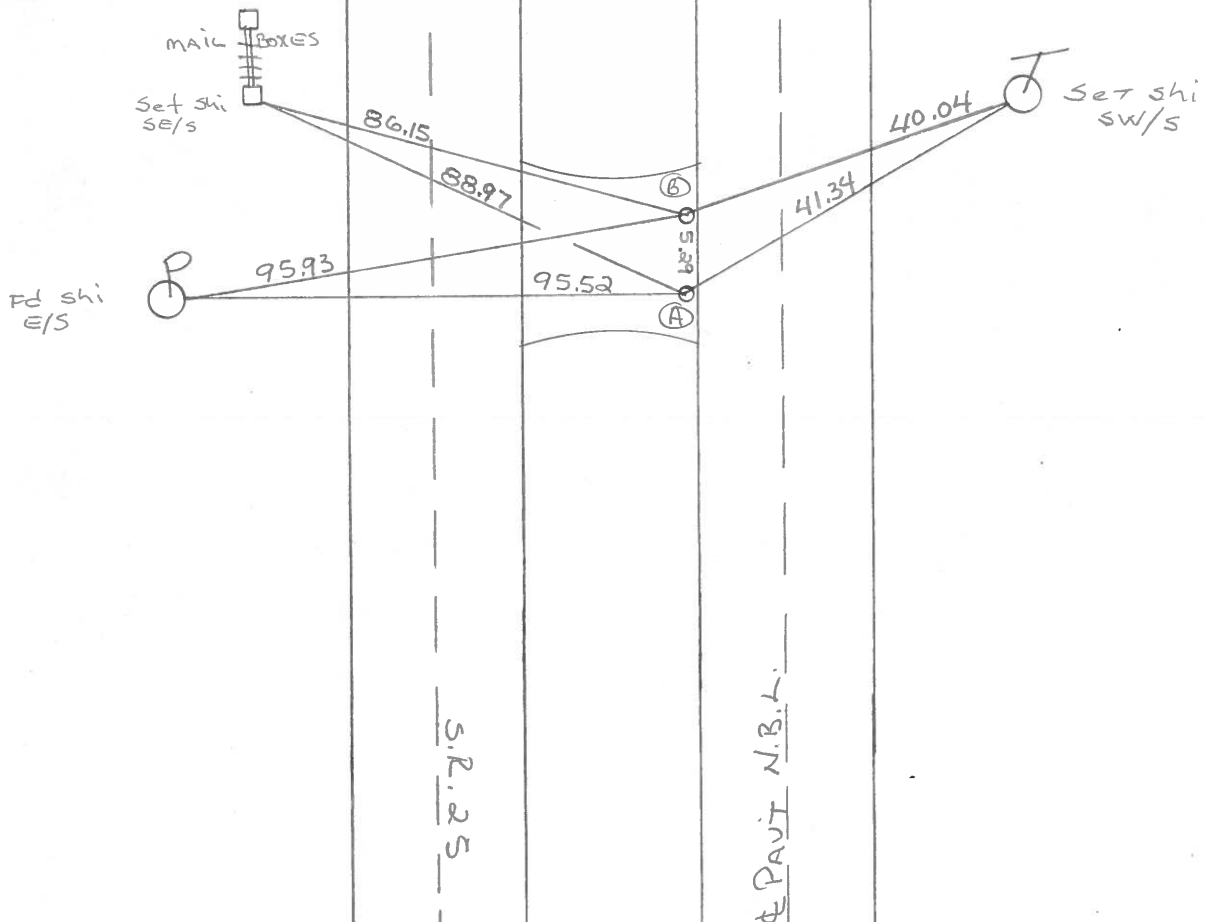


County Wood S.R.-U.S. 25Township LibertySection 25

T4N, R10E

Personnel HoffmanLochkeHouseholder

(5)

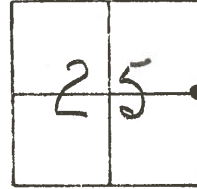
Date 6-10-81 8-25-81Weather cloudyTemp. + 70°

Fd. BRASS MON. @ SURFACE

PROJECT STA. $\pm$ 161+27

11.8' W. of & PAUT, N.B. LANES

SET P.K. AND SHINER

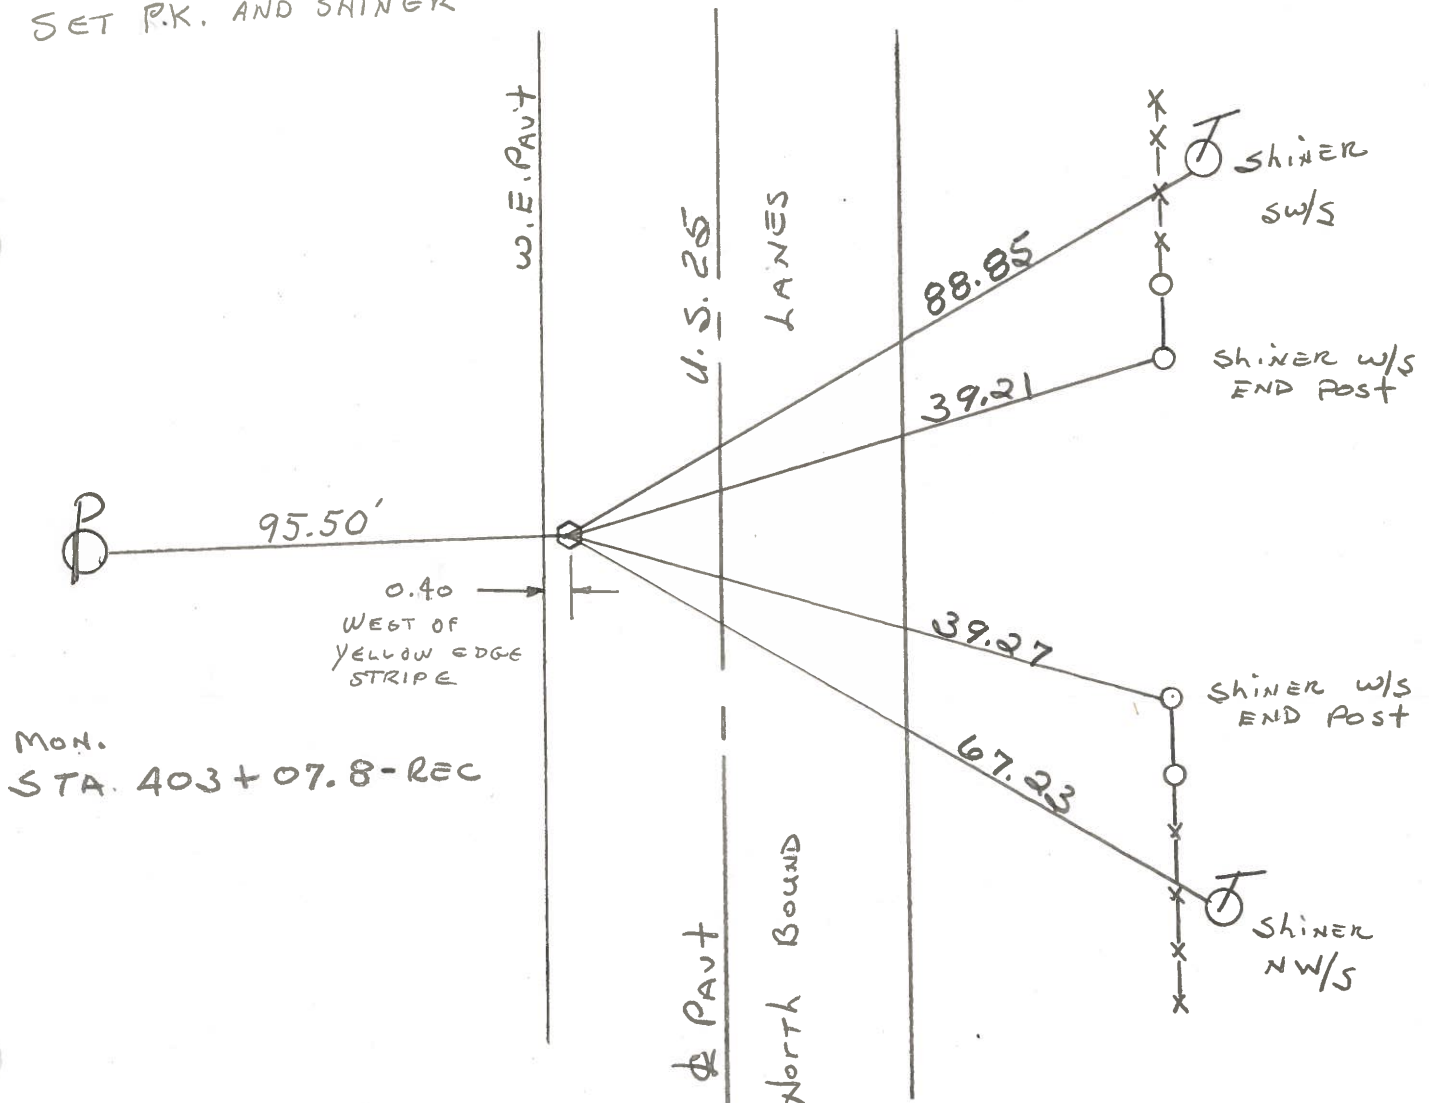

Q.D.O.T. DISTRICT 2 SURVEY OFFICE

SHEET

OF

County WOOD ^{U.S.} ~~S.R.~~ 25

Township LIBERTY

Section 25

T4N, R10E

Personnel BURNSIDE

SMITH

BOWERS

Date 7-6-71

Weather CLEAR

Temp. 80°

