

O.D.O.T. DISTRICT 2 SURVEY OFFICE (USE ONLY)

PERSONNEL

REFERENCE NO. 5A

SHEET OF

NOTES NIESE
H.C. NIESE
R.C. ASTON

DATE 11/20/23
WEATHER CLEAR
TEMP. 37°

ROUTE SR 25
COUNTY WOOD
TOWNSHIP LIBERTY
SECTION 25

DWG BY BARRIERE PID 92133

T 4 N R 10 E

TYPE MONUMENT MONBOX W/ 1" IPIN

ON SURFACE - BELOW ON

OFFSET Q PAVEMENT 19.6' RT LT : RT


 TO EDGE PAVEMENT

STATION: 133+20.64

HORIZ.DATUM: NAD83(11)/WOOD LDP GEOID: 18

GRID: NORTHING: 588289.188 EASTING: 1652370.795

LDP: NORTHING: 410131.183 EASTING: 163998.347

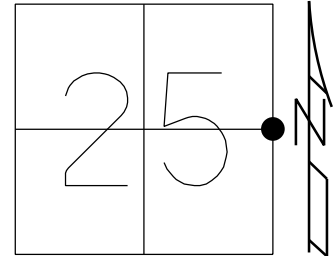

RECORD:
W 1/4 SEC 30

ORIGIN UNKNOWN
FD P.K.NAIL
4/12/01, TMR
SET P.K./WASHER
10-31-01, SAH
D.N.F POINT
FD HOLE
REFA5
5-30-18
10-1-18, JFO
FD PK NAIL
FD MAG NAIL
REFA5
3-17-22, JFO
FD NEW MONBOX
W/ 1" IPIN
POINT WAS ADJUSTED
PER WOO-25-0.75, PID 92133 PLANS.
SEE PLANS FOR PRIOR COORD.
AND INFORMATION
NEWREF5A
11/20/23, TDN

FD SHI
FENCE POST

GRAVEL DRIVE

Q S.B. SR 25

Q N.B. SR 25

SET MAG NAIL
BY GPS
(ORIGIN UNKNOWN)

FD MONBOX
W/ 1" IPIN

DIST. 5-5A=5.30'

FD MONBOX
W/ 1" IPIN

****NOTE****
NEW LOCATION.
REFERENCE TIES DO NOT MATCH

O.D.O.T. DISTRICT 2 SURVEY OFFICE (USE ONLY)

PERSONNEL

REFERENCE NO. 5 A

SHEET 14 OF 36

NOTES HUSS
H.C. ROUSOS
R.C. VAN DUSEN

DATE 4/12/01
WEATHER CLOUDY/WINDY
TEMP. 72°

ROUTE SR 25
COUNTY WOOD
TOWNSHIP LIBERTY
SECTION 25

DWG BY MILLER PID NO PID

T 4 N R 10 E

TYPE MONUMENT CNPT

ON SURFACE - ~~BELOW~~ ON

OFFSET Q PAVEMENT - LT : ~~RT~~

ON TO LT EDGE PAVEMENT


STATION: 160+80

HORZ.DATUM: NAD83(2011)

GEOID: NAVD88 2012A

GRID: NORTHING: 588294.444

EASTING: 1652370.927

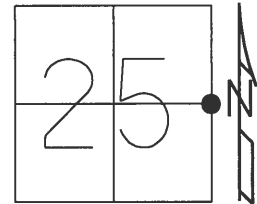

RECORD:
ORIGIN UNKNOWN
FD P.K.NAIL
4/12/01, TMR
SET P.K./WASHER
10-31-01, SAH
D.N.F POINT
FD HOLE
REFA5
5-30-18
10-1-18, JFO

Q N.B. SR 25

Q N.B. SR 25

FD SHI
FEN POST



95.93' REC

5

DIST .5-5A= 5.29' REC

O.D.O.T. DISTRICT 2 SURVEY OFFICE

PERSONNEL

REFERENCE NO. 5

SHEET 8 OF 23

NOTES Huss

H.C. Rousos

R.C. VanDusen

DATE 4-12-01

WEATHER Pt Cldy - Windy

TEMP. +72°F

ROUTE SR-25

COUNTY Wood

TOWNSHIP Liberty

SECTION 25

T 4 N R 10 E


TYPE MONUMENT (A) PK/W (B) PK

ON SURFACE - ~~BELOW~~ Surface

LEFT - & PAW'T - ~~RIGHT~~ On Lt. EOP

0 TO Lt. EDGE PAVEMENT

S.L.M. (A) 160+75 B 160+80

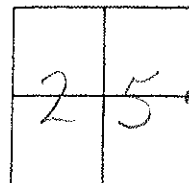


Record:

Point (A) - Brass Mon.
Sta 403+07.8

Point (B) Origin
Unknown

Set PK/W
Both Points
10-31-01
SAH

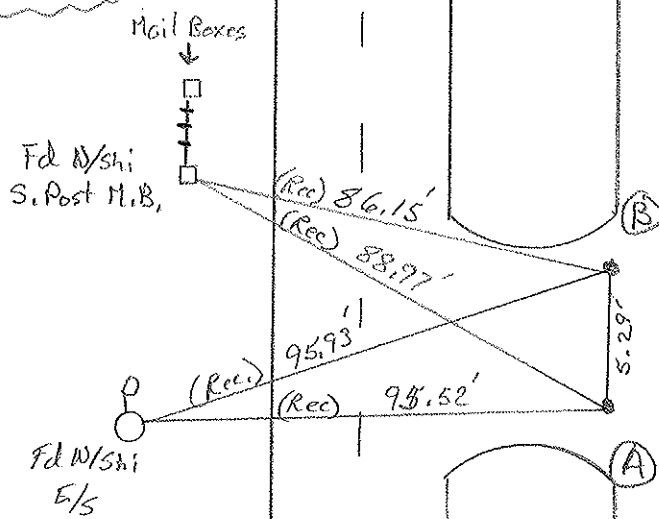

W Post.
S.B. SR-25

W Post.
N.B. SR 25

O.D.O.T. DISTRICT 2 SURVEY OFFICE

PERSONNEL

REFERENCE NO. 5

SHEET 8 OF 23

NOTES HOFFMAN

H.C. LOENRKE

R.C. BARNHISEL

DATE 3-22-91

WEATHER CLOUDY

TEMP. 55°

ROUTE SR 25

COUNTY WOOD

TOWNSHIP LIBERTY

SECTION 25

T 4 N R 10 E


TYPE MONUMENT P.K. WASHER & P.K. (ORIGIN UNKNOWN)

ON SURFACE - BELOW YES

LEFT- & PAV'T. - RIGHT

ON TO LT. EDGE PAVEMENT

S.L.M. 160+75 - PT "A"

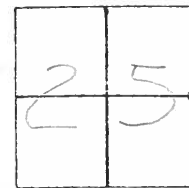

Set P.K. & Washer

6-5-91

MB

RECORD: POINT "A"

BRASS MONUMENT

Sta 403+07.8

