



O.D.O.T. DISTRICT 2 SURVEY OFFICE (USE ONLY)

PERSONNEL

REFERENCE NO. 6

SHEET 15 OF 36

NOTES RHOADES

DATE 5/30/18

ROUTE SR 25

H.C. O'DONNELL

WEATHER CLOUDY

COUNTY WOOD

R.C. TRENKA

TEMP. 77°

TOWNSHIP LIBERTY

SECTION 24

DWG BY MILLER

PID NO PID

T 4 N R 10 E

TYPE MONUMENT CNPT

ON SURFACE - ~~BELOW~~ ON

OFFSET Q PAVEMENT 2.2' LT : RT

- TO - EDGE PAVEMENT


STATION: 30+62.40

HORZ.DATUM: NAD83(2011)

GEOID: NAVD88 2012A


GRID: NORTHING: 590920.741

EASTING: 1652388.770

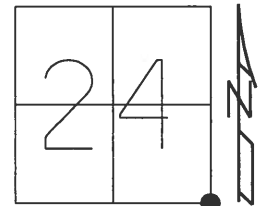

RECORD:  
STA. 429+39.2  
FD BRASS MON  
FD P.K./WASHER  
4/12/01, TMR  
SET P.K./WASHER  
10-31-01, SAH  
D.N.F  
SHOT CNTR TIES  
REF6  
5-30-18  
10-1-18, JFO

NOTE: PORTAGE TWP  
N.W. COR SEC 30

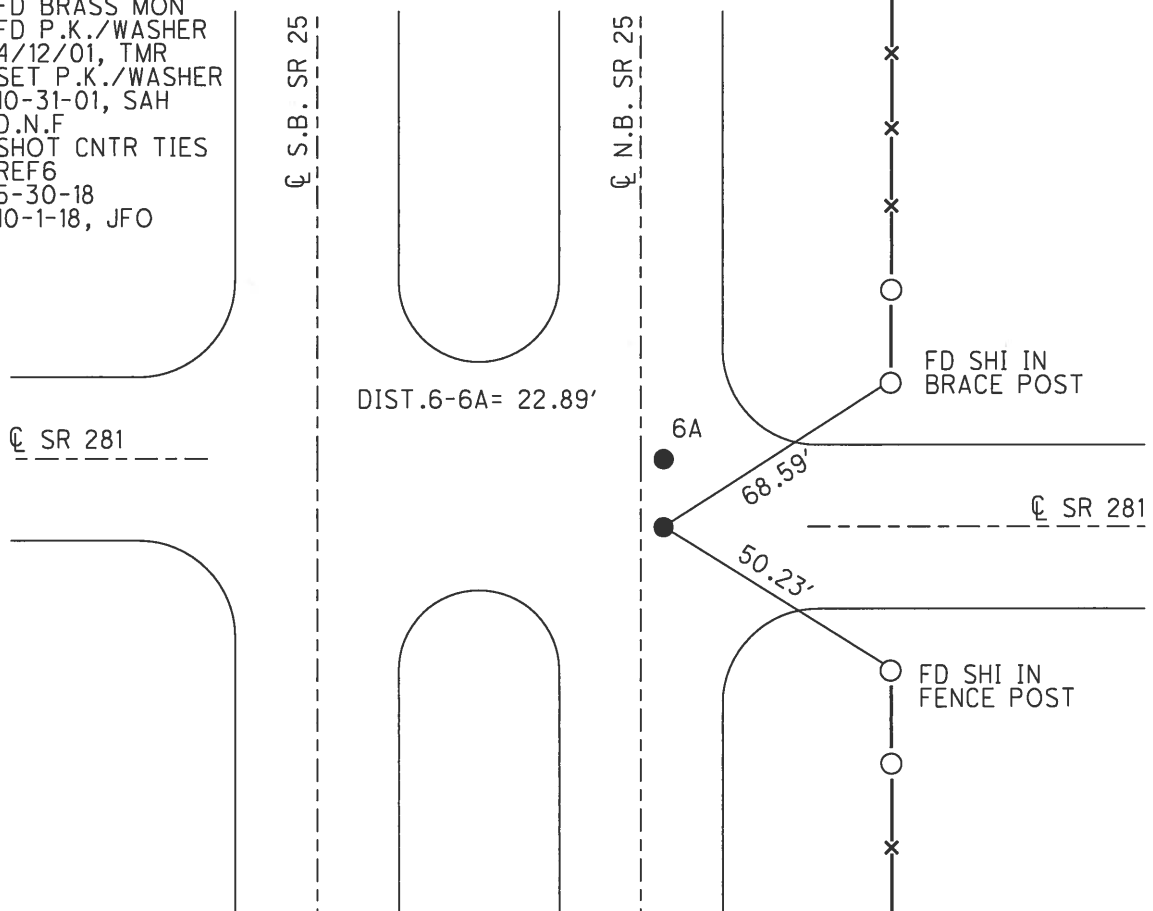

# O.D.O.T. DISTRICT 2 SURVEY OFFICE

PERSONNEL

REFERENCE NO. 6

SHEET 9 OF 23

NOTES Huss

H.C. Rousos

R.C. VanDusen

DATE 4-12-01

WEATHER Pt. Cldy. - Windy

TEMP. +72°F

ROUTE SR-25

COUNTY Wood

TOWNSHIP Liberty

SECTION 24

T 4 N R 10 E


TYPE MONUMENT (A) PK/W (B) PK/W

ON SURFACE - ~~BELOW~~ Surface

~~LEFT~~ PAV'T. - RIGHT (A) 2.2' (B) 2.2'

TO EDGE PAVEMENT

S.L.M. (A) 187+06 (B) 187+29

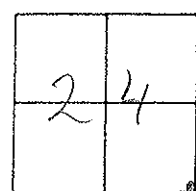

Record:

(A) Portage Twp  
N.W. Cor. Sec. 30  
Brass Mon.  
Sta 429+139.2

(B) Liberty Twp.  
S.E. Cor Sec 24  
Brass Mon.  
429+61.95

Set PK/W  
Both Points  
10-31-01  
SAH


E Paut.  
SR-281

Set N/Shi  
S/W Side  
Brace Pole

E Paut.  
SR-281

Set N/Shi  
N/W Side  
Fence brace  
pole

Dist. Between (A) - (B) = 22.89'

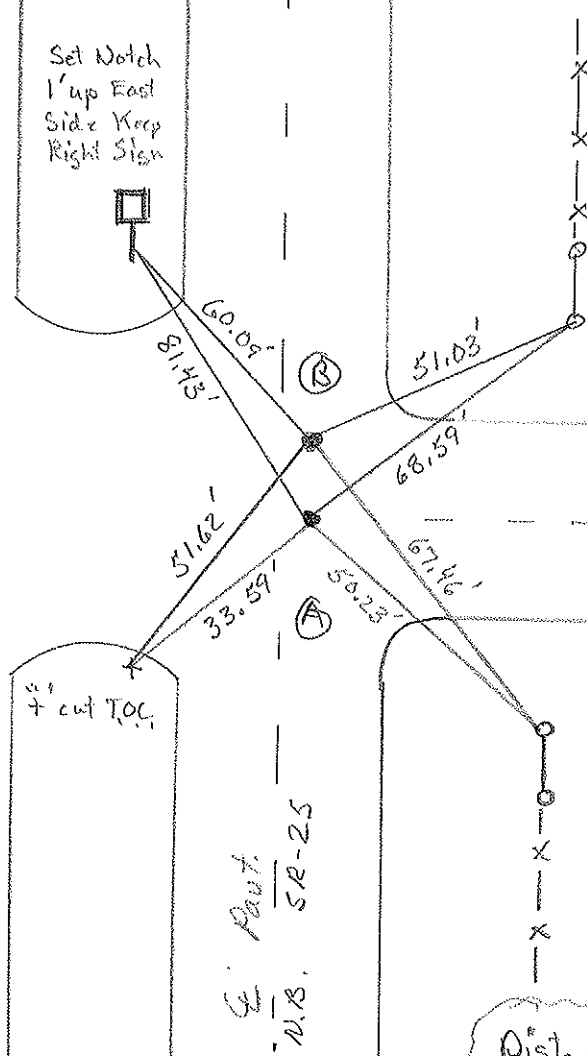

E Paut.  
SR-25

E Paut.  
SR-25

# O.D.O.T. DISTRICT 2 SURVEY OFFICE

PERSONNEL

REFERENCE NO. 6

SHEET 9 OF 23

NOTES HOFFMAN

H.C. LOEHRKE

R.C. BARNHISEL

DATE 3-26-91

WEATHER OVERCAST

TEMP. 55°

ROUTE SR 25

COUNTY WOOD

TOWNSHIP LIBERTY

SECTION 24

T 4 N R 10 E

"A" & "B"


TYPE MONUMENT PK/WASHER P.K./washer

ON SURFACE - BELOW YES YES

LEFT-~~C~~ PAVT. - RIGHT 9.3' 9.3'

TO EDGE PAVEMENT

S.L.M. PT. "A" = 187+06

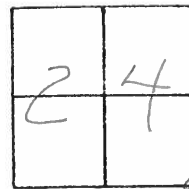

Set P.K.'s & Washers  
6-5-91  
MB

PAVT S.B.L.

SR 25

CUT "+"  
TOP OF CURB

FD. SHI  
SW/S  
ENO POST

PAVT SR 281 WEST

POINT "B"

RECORD: LIBERTY TWP  
S.E. COR. SEC. 24  
BRASS MONUMENT  
Sta. 429+61.95

PAVT  
SR 281 EAST  
IS NORTH of  
POINT "A"

FD "+"  
TOP OF CURB

FD "+" TOP  
OF CURB

POINT "A"

RECORD: PORTAGE TWP  
N.W. COR. SEC. 30  
BRASS MONUMENT  
Sta 429+39.2

SR 25

PAVT N.B.L.

# O.D.O.T. DISTRICT 2 SURVEY OFFICE

SHEET 6 OF   

County Wood S.R.-U.S. 25

Township Liberty

Section 24

T4N, R10E

Personnel HOFFMAN


Householder

# 6

Date 6-10-81 8-25-81

Weather cloudy

Temp. +70°

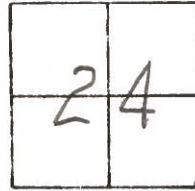


Pt. "A" Fd. BRASS MON. @ SURFACE  
2.2' E. of & PAUT, N.B. LANES

PROJECT STA. 187+64

Pt. "B" Fd. BRASS MON. @ SURFACE  
2.2' E. of & PAUT, N.B. LANES

SET P.K. & WASHER @  
"A" & "B"

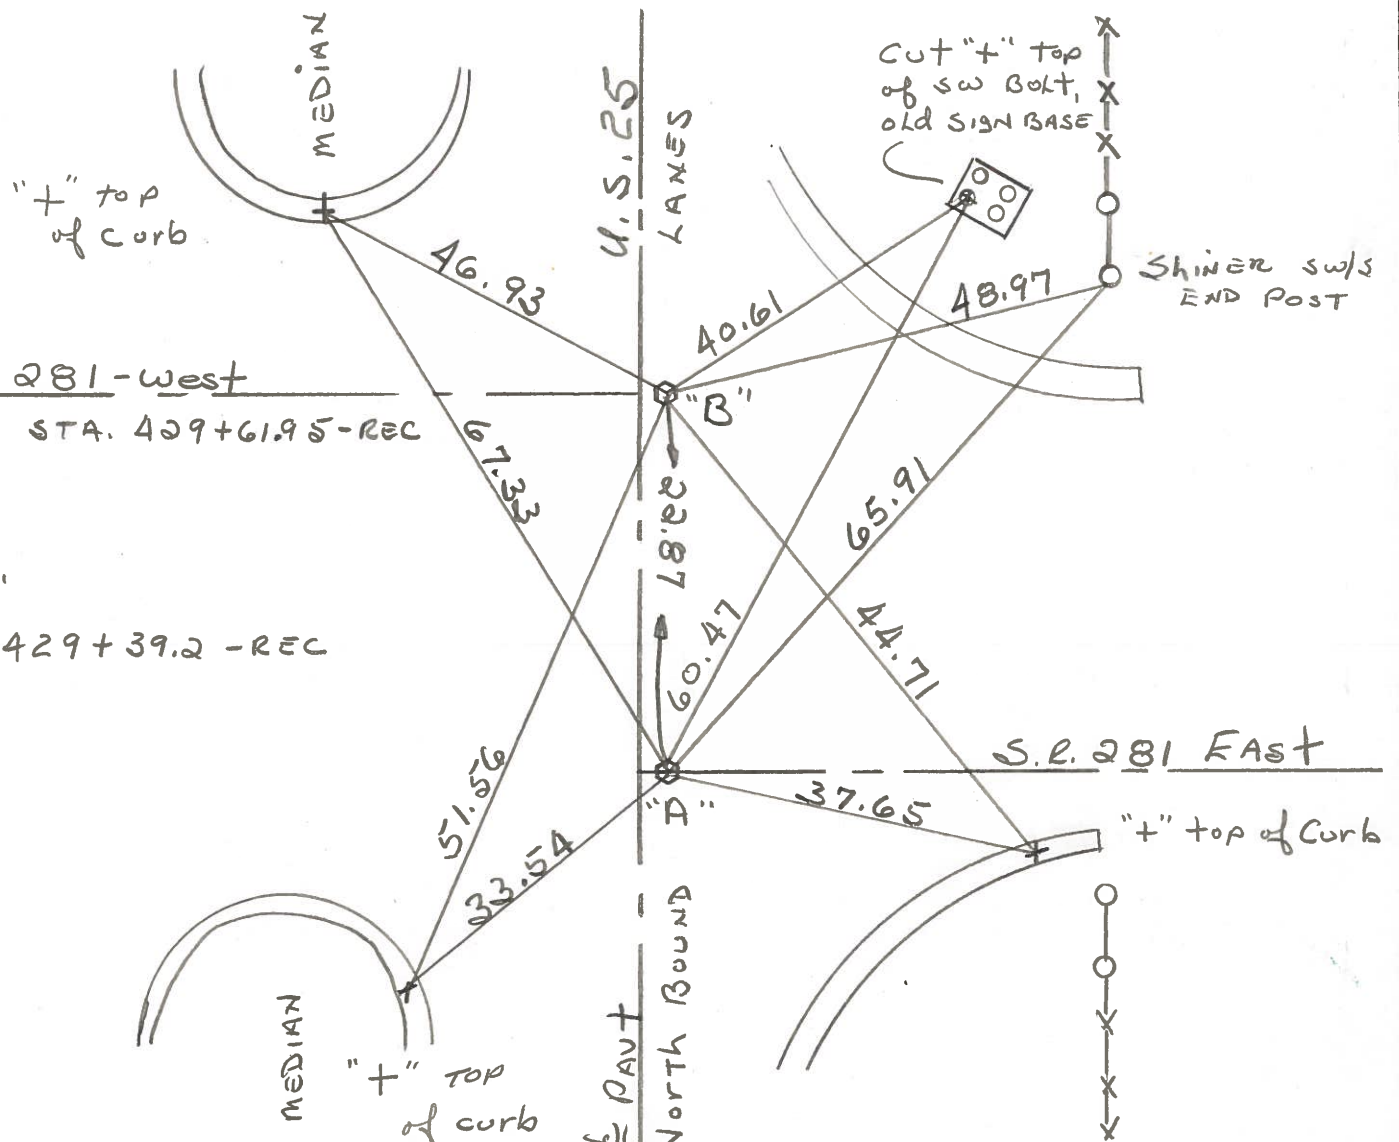

S.R. 281 - West  
Pt. "B" STA. 429+61.95 - REC

Pt. "A"  
STA. 429+39.2 - REC

S.R. 281 East

# ODOT. DISTRICT 2 SURVEY OFFICE

SHEET

OF

County WOOD <sup>U.S.</sup> ~~S.R.~~ 25

Township LIBERTY

Section 24

T4N, R10E

Personnel BURNSIDE


SMITH

BOWERS

Date 7-6-71

Weather CLEAR

Temp. 82°

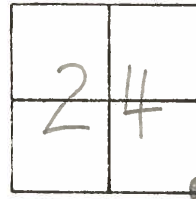

#6

X S-E. COR. SEC. 24  
LIBERTY TWP.

BRASS MON.  
STA. 429+61.95

S.R. 281 - WEST

NEAR EDGE  
12" STEEL LIGHT POLE

SHI. IN. END  
FENCE POST

S.R. 281 - EAST

N.W. COR. SEC. 30  
PORTAGE TWP.

BRASS MON.  
STA. 429+39.2

SHI. IN END  
FENCE POST

U.S.

25

22.87

40.19'

59.88'

48.93'

65.79'

66.27'

44.65'

37.63'

49.85'

PERSONNEL

TITLE

PERSONNEL

TITLE

COUNTY

Wood

DATE

4-5-60

S. R.

U.S. #25

WEATHER

SEC.

TEMP.

DESCRIPTION

LEFT

CENTER LINE

RIGHT

JOB NO.

|                                 |  |                                      |        |
|---------------------------------|--|--------------------------------------|--------|
| 22.84 South of Point #234       |  | Shiner in End Post N.E.              | 64.73  |
| Sta. 429+39.2                   |  | Shiner in P.P. W.S.W.                | 41.29  |
| N.W. cor. sec. 30. Bridge       |  | Shiner in T.P. N.E. 67.20            | 66.93  |
| Twp.                            |  | X on E. pt. Hdwl. N.W.               | 63.80  |
| Brass plate in &                |  | Conc. Flw mon. S.E. 53.10            | 52.90  |
| Pavement. S.R. #281             |  | Shiner in End Post S.E.              | 49.77  |
| <del>6-A</del> #233             |  | Shiner in Twin T. Pole S.S.E.        | 91.81  |
| 6                               |  |                                      |        |
| Sta. 429+61.95 22.84 North #233 |  | Shiner in T.P. N.E.                  | 50.34  |
| S.E. cor. sec. 24 Liberty       |  | Shiner in P.P. S.W.                  | 49.33  |
| Twp.                            |  | X on E. pt. Hdwl. W.N.W.             | 51.22  |
| Brass plate & of pavement.      |  | Conc. Flw mon. S.E. 70.20            | 69.88  |
| ok 12-9-57 S.R. #281            |  | Shiner in End Post S.E.              | 66.15  |
| <del>6-A</del> #234             |  | Shiner in End Post N.E.              | 48.18  |
| 6                               |  |                                      |        |
| Sta. 455+74.5                   |  | Shiner in T.P. S.S.E.                | 79.25  |
| E. 1/4 post sec. 24 Liberty     |  | Shiner in T.P. 79.20 N.N.E.          | 81.46  |
| Twp.                            |  | Shiner in P.P. W.N.W.                | 77.33  |
| Brass plug, top of              |  | W. edge part. 5.9 E. edge part. 14.0 | 38.03  |
| plate gone                      |  | Shiner in End Post N.N.E.            | 51.89  |
| 7 #235                          |  | Shiner in End Post N.E.              | 52.04  |
| 6-A                             |  |                                      | 40.70  |
|                                 |  |                                      | 40.63  |
| Sta. 482+71.65                  |  | Shiner in P.P. N.W.                  | 55.22  |
| S.E. cor. sec. 13 Liberty       |  | Shiner in P.P. E.N.E.                | 73.29  |
| Twp. MERMILL Rd.                |  | S.E. cor. brick chimney of gas       |        |
| Brass plate in & part.          |  | Walnut station N.W.                  | 101.15 |
| 8 #236                          |  | Shiner 10' Ash N.N.W.                | 68.38  |
|                                 |  | Shiner T. Pole S.E.                  | 49.66  |