

O.D.O.T. DISTRICT 2 SURVEY OFFICE (USE ONLY)

PERSONNEL

REFERENCE NO. A6

SHEET OF

NOTES NIESE

DATE 11/16/23

ROUTE SR 25

H.C. NIESE

WEATHER WINDY

COUNTY WOOD

R.C. AUBLE

TEMP. 65°

TOWNSHIP PORTAGE

DWG BY BARRIERE

PID 92133

SECTION 19

T 4 N R 11 E

TYPE MONUMENT MONBOX W/ 1" IPIN

ON SURFACE - BELOW ON

OFFSET $\varnothing$ PAVEMENT 30' RT LT : RT


 TO EDGE PAVEMENT

STATION: 159+75.34

HORIZ.DATUM: NAD83(11)/WOOD LDP GEOID: 18


GRID: NORTHING: 590943.642 EASTING: 1652388.969

LDP: NORTHING: 412785.856 EASTING: 163981.517

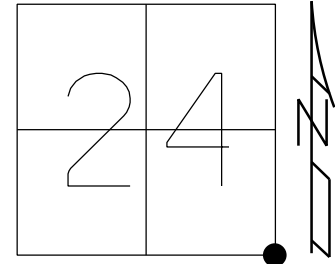

RECORD: P.I.
NE COR. SEC. 25

STA.429+61.952
FD BRASS MON
FD P.K./WASHER
4/12/01, TMR
SET P.K./WASHER
10-31-01, SAH
D.N.F
SHOT CNTR TIES
REFA6
5-30-18
10-1-18, JFO
FD BRASS DISK
FD NEW MONBOX
W/ 1" IPIN
CHECKED W/ GPS
DID NOT PULL TIES
NEWREFA6
11/20/23, TDN

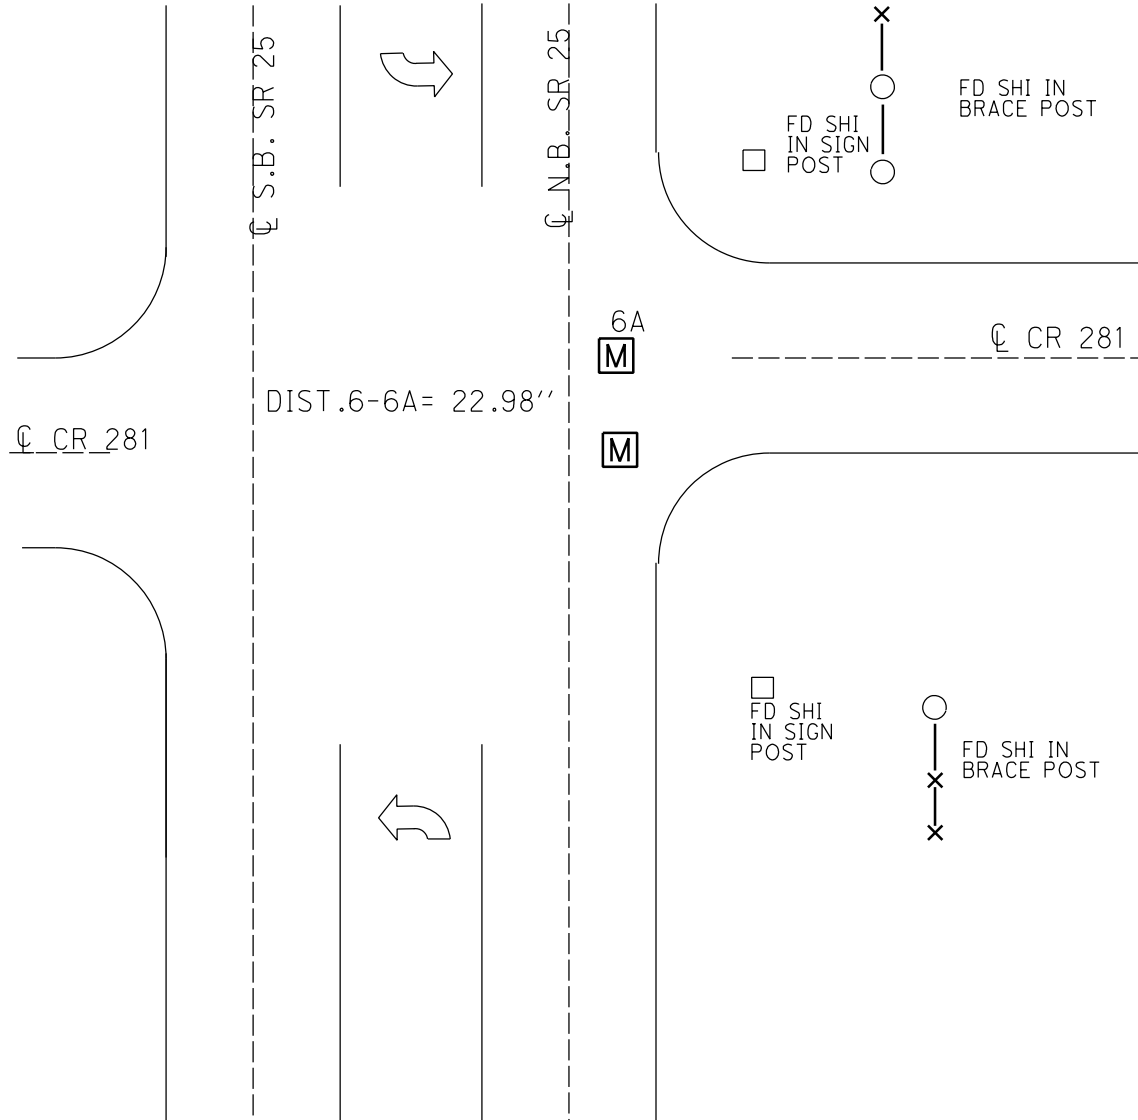

****NOTE****
POINT WAS ADJUSTED PER
WOO-25-0.75, PID 92133
PLANS. SEE PLANS FOR
PRIOR COORDINATES
AND INFORMATION.
**** ****

O.D.O.T. DISTRICT 2 SURVEY OFFICE (USE ONLY)

PERSONNEL

REFERENCE NO. 6 A

SHEET 16 OF 36

NOTES RHOADES

DATE 5/30/18

ROUTE SR 25

H.C. O'DONNELL

WEATHER CLOUDY

COUNTY WOOD

R.C. TRENKA

TEMP. 77°

TOWNSHIP LIBERTY

DWG BY MILLER

PID NO PID

SECTION 24

T 4 N R 10 E

TYPE MONUMENT CNPT

ON SURFACE - ~~BELOW~~ ON

OFFSET CL PAVEMENT 2.2' ~~LT~~ : RT

- TO - EDGE PAVEMENT


STATION: 187+29

HORZ.DATUM: NAD83(2011)

GEOID: NAVD88 2012A


GRID: NORTHING: 590943.665

EASTING: 1652388.927

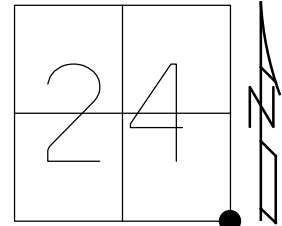

RECORD:
STA. 429+61.95
FD BRASS MON
FD P.K./WASHER
4/12/01, TMR
SET P.K./WASHER
10-31-01, SAH
D.N.F
SHOT CNTR TIES
REFA6
5-30-18
10-1-18, JFO

NOTE: LIBERTY TWP
S.E. COR SEC 24

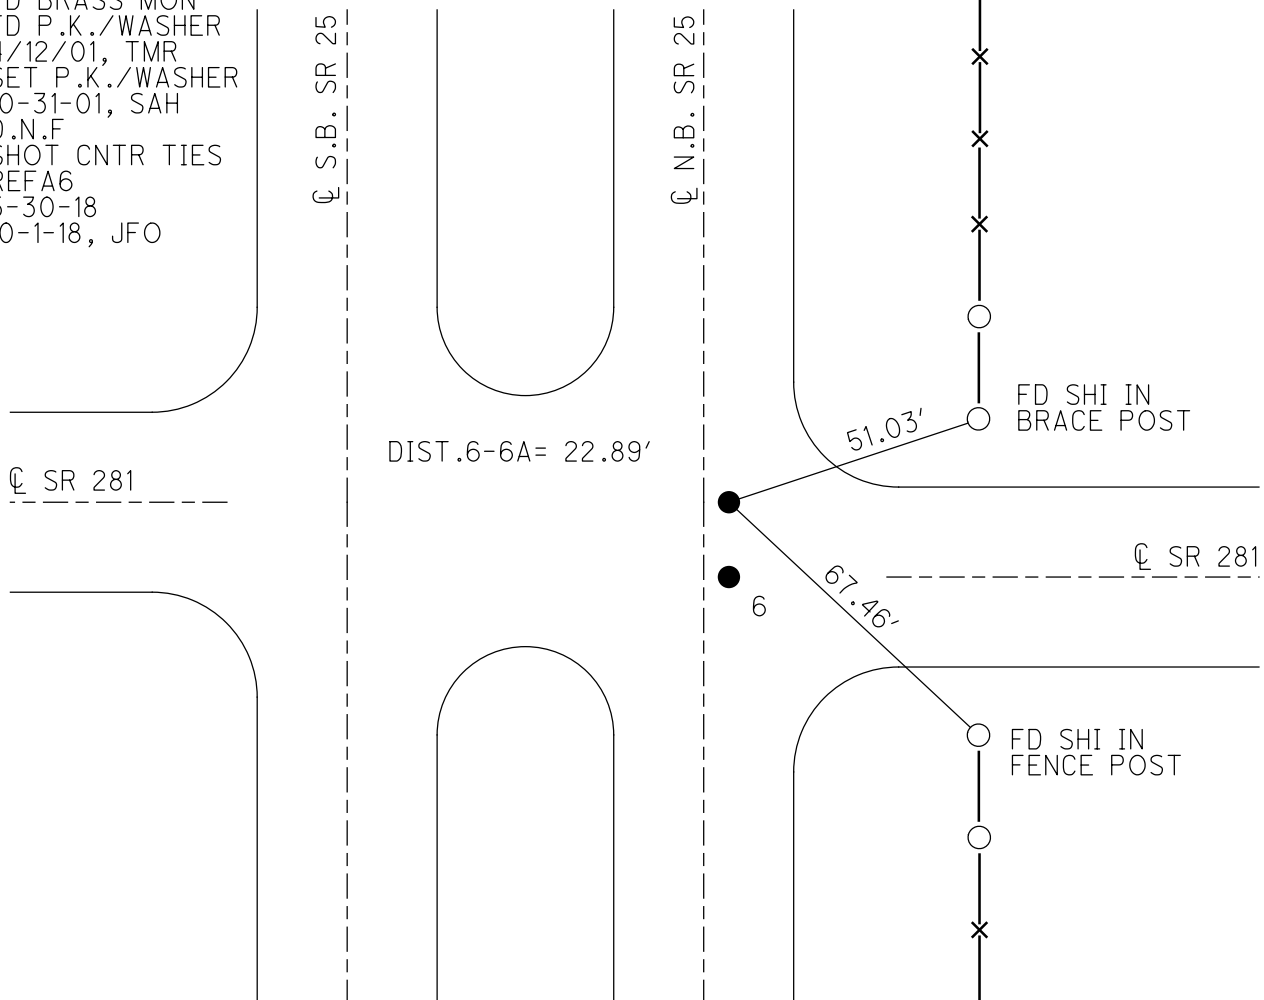

O.D.O.T. DISTRICT 2 SURVEY OFFICE

PERSONNEL

REFERENCE NO. 6

SHEET 9 OF 23

NOTES Huss

H.C. Rowson

R.C. VanDusen

DATE 4-12-01

WEATHER Pt. Cldy.-Win

TEMP. +72°F

ROUTE SR-25

COUNTY Wood

TOWNSHIP Liberty

SECTION 24

T 4 N R 10 E


TYPE MONUMENT (A) PK/w (B) PK/w

ON SURFACE - ~~BELOW~~ Surface

~~LEFT~~ - C PAV'T. - RIGHT (A) 2.2' (B) 2.2'

TO _____ EDGE PAVEMENT

S.L.M. (A) 187+06 (B) 187+20

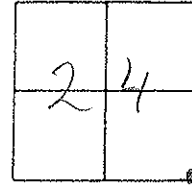

Record:

(A) Portage Twp
N.W. Cor. Sec. 30
Brass Mon.
Sta. 429+39.2

~~XXXXXXXXXXXX~~

(B) Liberty Twp.
S.E. Cor Sec 24
Grass Man.
429+61.95


Set PK/w
Both Points
10-31-01
SAH

Set N/Shi
S/w Side
Brace Pole

4 Part,
SR 281

Set N/shi
N/w side
fence brace
pole

Dist. Between (A) - (B) = 22.89

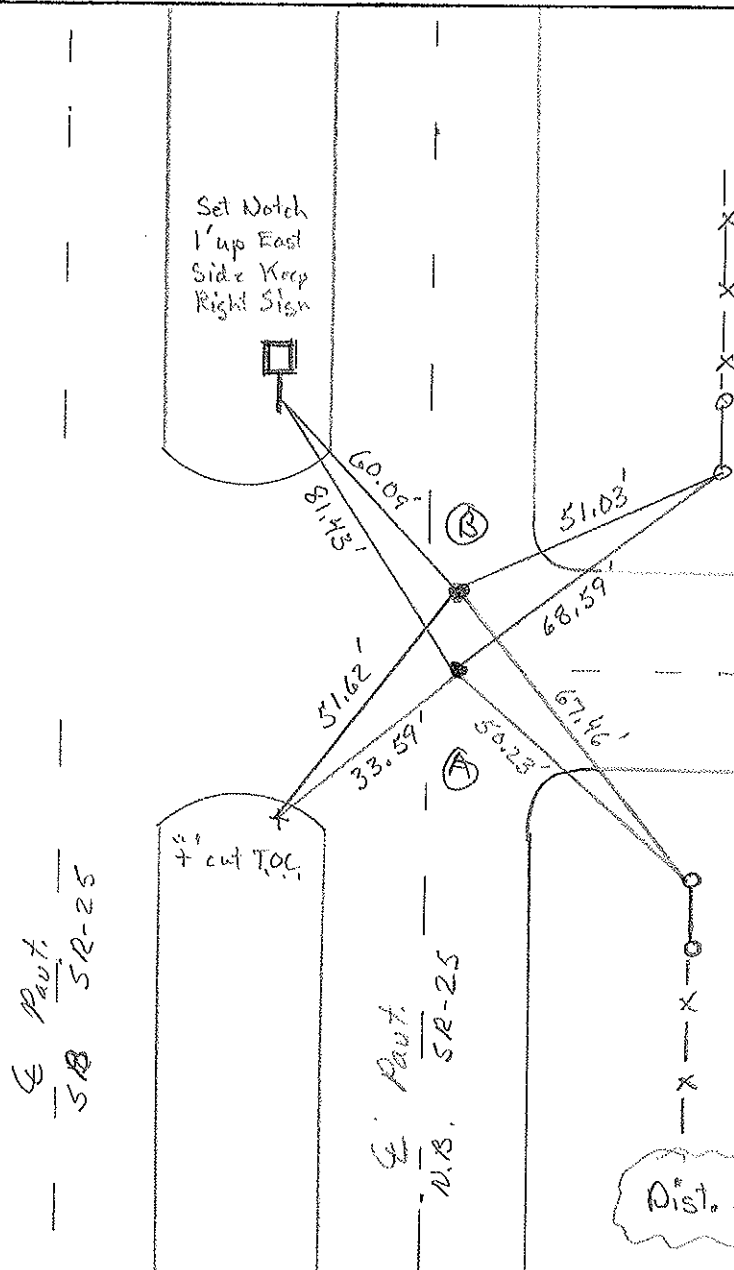

O.D.O.T. DISTRICT 2 SURVEY OFFICE

PERSONNEL

REFERENCE NO. 6

SHEET 9 OF 23

NOTES HOFFMAN

H.C. LOEHRKE

R.C. BARNHISEL

DATE 3-26-91

WEATHER OVERCAST

TEMP. 55'

ROUTE SR 25

COUNTY WOOD

TOWNSHIP LIBERTY

SECTION 24

T 4 N R 10 E

"A" & "B"


TYPE MONUMENT PK/WASHER P.K./washer

ON SURFACE - BELOW YES YES

LEFT - C PAVT. - RIGHT 9.3' 9.3'

TO EDGE PAVEMENT

S.L.M. PT. "A" = 187+06

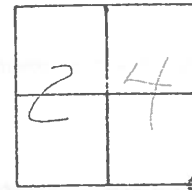

SET P.K.'S & Washers
6-5-91
MB

PAVT S.B.L.

SR 25

CUT "+"
TOP OF CURB

54.59

74.27

49.13

66.14

FD. Shi
SW/S
END POST

PAVT SR 281 WEST

POINT "B"

RECORD: LIBERTY TWP
S.E. COR. SEC. 24
BRASS MONUMENT
Sta. 429+61.95

PAVT
SR 281 EAST
15 NORTH of
POINT "A"

FD "+"
TOP OF CURB

51.60

33.51

37.68

14.75

FD "+" TOP
OF CURB

POINT "A"


RECORD: PORTAGE TWP
N.W. COR. SEC. 30
BRASS MONUMENT
Sta 429+39.2

SR 25

PAVT N.B.L.

County Wood S.R.-U.S. 25Township LibertySection 24

T4N, R10E

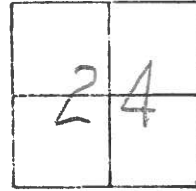
Personnel HOFFMANHouseholder# (6)Date 6-10-81 8-25-81Weather cloudyTemp. +70°

Pt. "A" Fd. BRASS MON. @ SURFACE
2.2' E. of $\frac{1}{2}$ PAUT, N.B. LANES

Project STA. 187+64

Pt. "B" Fd. BRASS MON. @ SURFACE
2.2' E. of $\frac{1}{2}$ PAUT, N.B. LANES

SET PK. & WASHER @
"A" & "B"

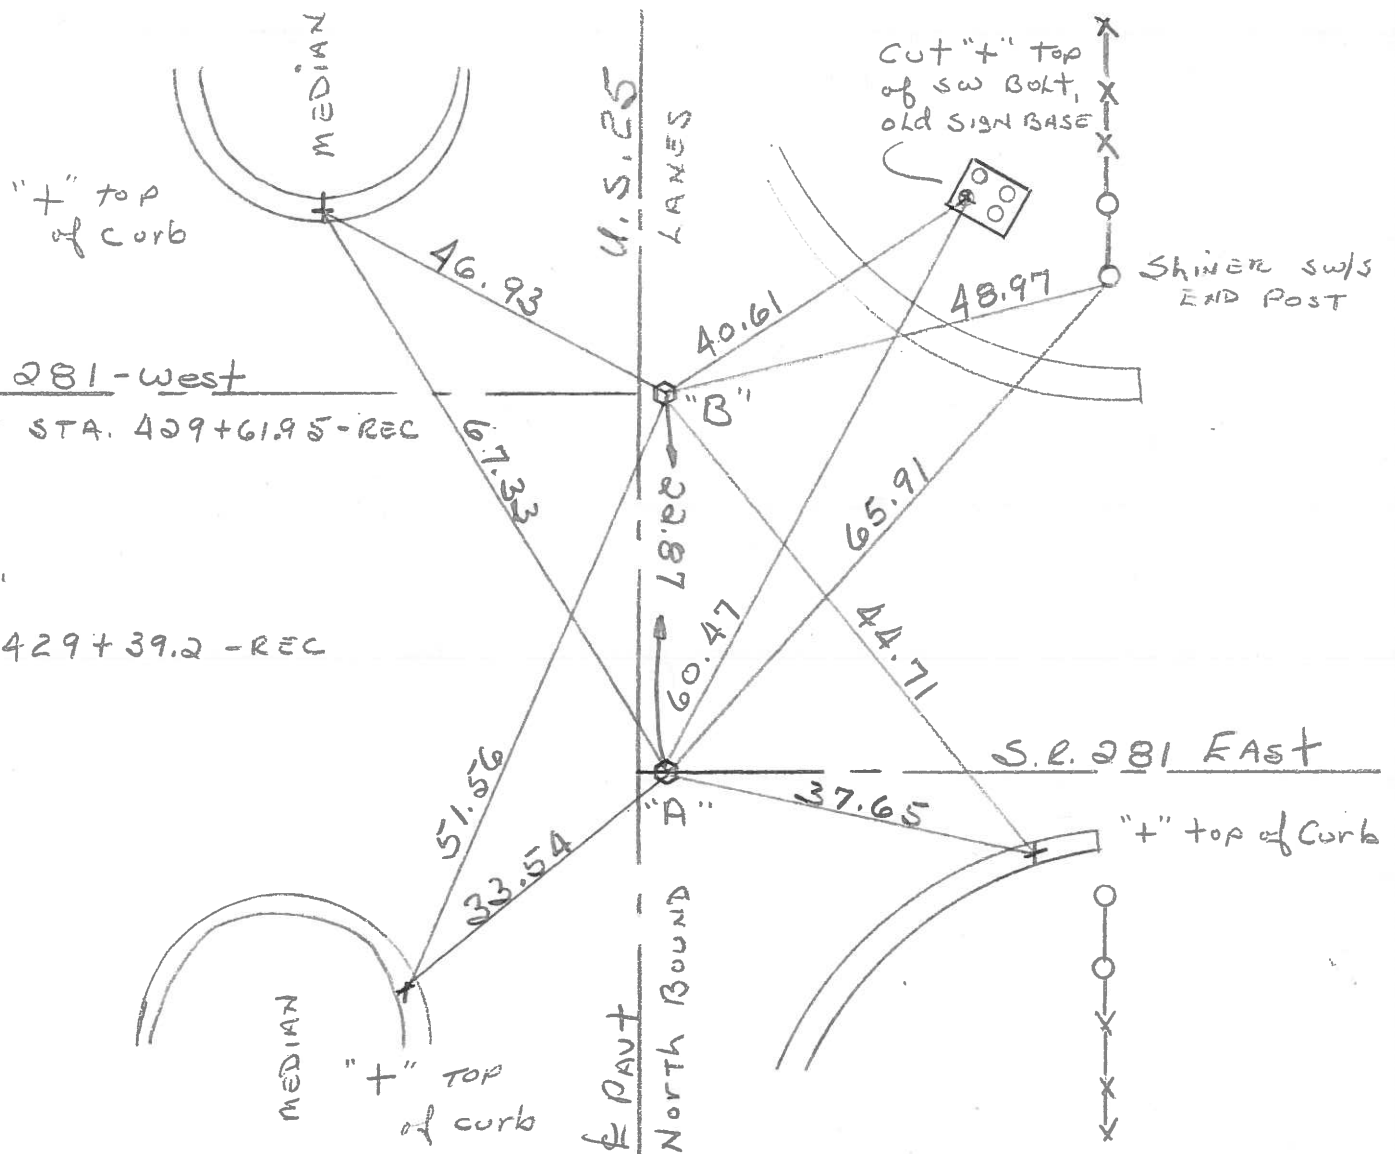

O.D.O.T. DISTRICT 2 SURVEY OFFICE

SHEET

OF

County WOOD ^{U.S.} S.R. 25

Date 7-6-71

Township LIBERTY

Weather CLEAR

Section 24


Temp. 82°

T4N, R10E

Personnel BURNSIDE

SMITH

BOWERS

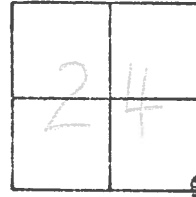

#6

NEAR. EDGE
12" STEEL L-SHAPED

S-E. COR. SEC. 24
LIBERTY TWP.

BRASS MON.
STA. 429+61.95

SH. IN. END
FENCE POST

S.R. 281 - WEST

S.R. 281 - EAST

N.W. COR. SEC. 30
PORTAGE TWP.

BRASS MON.
STA. 429+39.2

SH. IN. END
FENCE POST

U.S.



25

25

PERSONNEL	TITLE	PERSONNEL	TITLE	COUNTY	DATE	WEATHER	TEMP.
				Wood	4-5-60		
				S. R. U.S. #25			
				SEC.			
DESCRIPTION	LEFT	CENTER LINE	RIGHT	JOB NO.			
22.84 South of Point #234			Shiner in End Post N.E.	64.72			
Sta. 429+39.2			Shiner in P.P. W.S.W.	41.29			
N.W. cor. sec. 30. Portage			Shiner in T.P. N.E. 67.20	66.92			
Twp.			X on E. pt. Hdwl. N.W.	63.8			
Brass plate in &			Conc. F/W mon. S.E. 53.10	52.90			
Pavement. S.R. #281			Shiner in End Post S.E.	49.77			
(6-A) #233			Shiner in Twin T. Pole S.S.E.	91.81			
(6)							
Sta. 429+61.95 22.84 North #233			Shiner in t.p. N.E.	50.34			
S.E. cor. sec. 24 Liberty			Shiner in P.P. S.W.	49.35			
Twp.			X on E. pt. Hdwl. W.N.W.	51.2			
Brass plate & of pavement.			Conc. F/W mon. S.E. 70.20	69.81			
OK 12-9-57 S.R. #281			Shiner in End Post S.E.	66.15			
(6) #234			Shiner in End Post N.E.	48.18			
(6-A)							
Sta. 455+74.5			Shiner in T.P. S.S.E.	79.2			
E. 1/4 post sec. 24 Liberty			Shiner in T.P. 79.20 N.N.E.	81.4			
Twp.			Shiner in P.P. W.N.W.	77.3			
Brass plug, top of			W. edge pavt. 5.9 E. edge pavt. 14.1	38.0			
plate gone			Shiner in End Post N.N.E.	51.89			
(7) #235			Shiner in End Post N.E.	52.0			
				40.70			
				40.63			
Sta. 482+71.65			Shiner in P.P. N.W.	55.2			
S.E. cor. sec. 13 Liberty			Shiner in P.P. E.N.E.	73.2			
Twp. McMill Rd.			S.E. cor. brick chimney of gas				
Brass plate in & pavt.			Station N.W. 101.1				
(8) #236			Shiner 10' ^{walnut} Ash N.N.W.	68.36			
			Shiner T. Pole S.E.	49.66			