

O.D.O.T. DISTRICT 2 SURVEY OFFICE (USE ONLY)

PERSONNEL

REFERENCE NO. 7/B6

SHEET OF

NOTES NIESE
H.C. NIESE
R.C. ASTON

DATE 11/20/23
WEATHER CLEAR
TEMP. 37°

ROUTE SR 25
COUNTY WOOD
TOWNSHIP LIBERTY
SECTION 25

DWG BY BARRIERE PID 92133

T 4 N R 10 E

TYPE MONUMENT MONBOX W/ 1" IPIN

ON SURFACE - BELOW ON

OFFSET Q PAVEMENT 23.8' RT LT : RT


 TO EDGE PAVEMENT

STATION: 185+87.60

HORIZ.DATUM: NAD83(11)/WOOD LDP GEOID: 18

GRID: NORTHING: 593555.721 EASTING: 1652404.879

LDP: NORTHING: 415398.123 EASTING: 163962.983

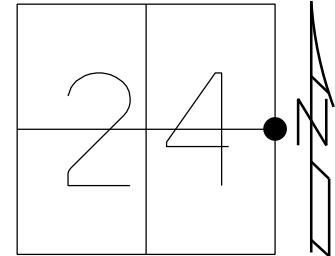


RECORD: P.I.
E 1/4 SEC 24

RECORD:

STA.466+74.5
FD BRASS MON
FD P.K./WASHER
4/12/01, TMR
SET P.K./WASHER
10-31-01, SAH
FD HOLE
REF7
5-30-18, JFO
FD MAG NAIL
SET BY OTHERS
NEWREF7
10-1-18, JFO
FD BRASS DISK
FD MAG NAIL
REF 7
3-17-22, JFO
FD NEW MONBOX
W/ 1" IPIN
CHECKED W/ GPS
DID NOT PULL TIES
NEWREF7
11/20/23, TDN

WOOD LDP
N 415325.176
E 163963.500

FD NEW MONBOX
W/ 1" IPIN
NEWREFB6
11/20/23, TDN

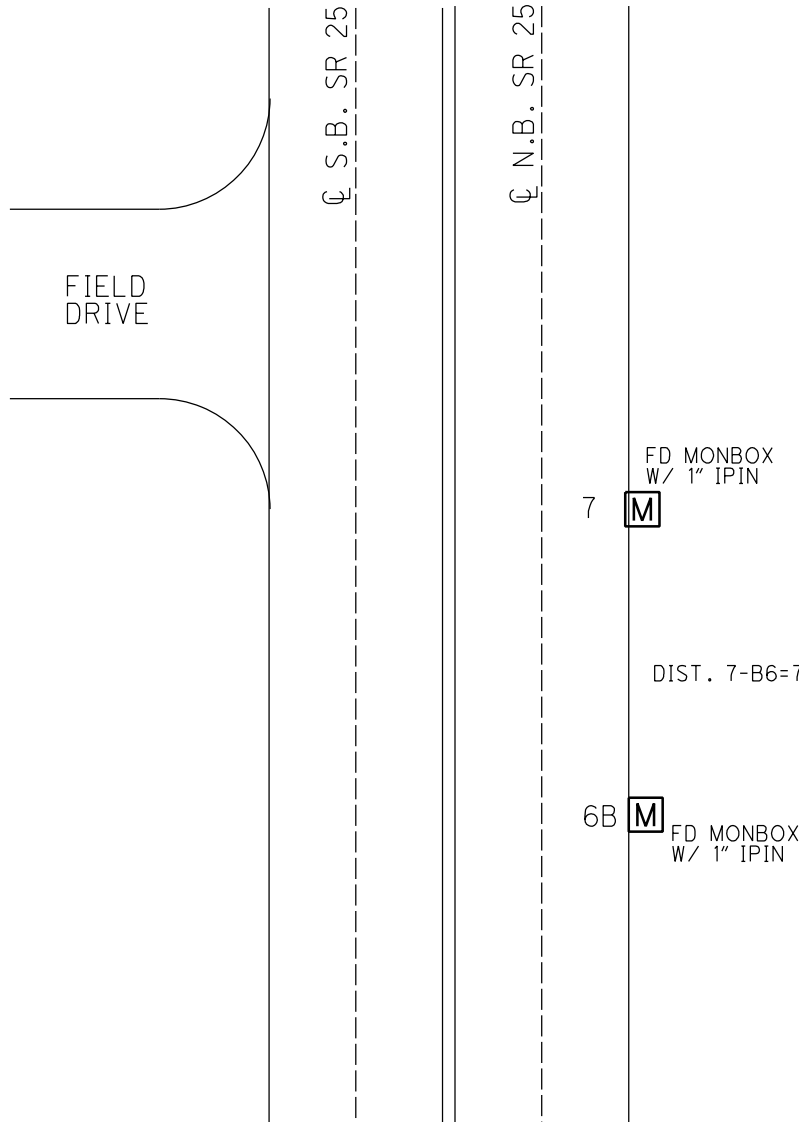

O.D.O.T. DISTRICT 2 SURVEY OFFICE (USE ONLY)

PERSONNEL

REFERENCE NO. 7

SHEET 17 OF 36

NOTES RHOADES

DATE 5/30/18

ROUTE SR 25

H.C. O'DONNELL

WEATHER CLOUDY/WINDY

COUNTY WOOD

R.C. TRENKA

TEMP. 77°

TOWNSHIP LIBERTY

SECTION 24

DWG BY MILLER

PID NO PID

T 4 N R 10 E

TYPE MONUMENT MAG NAIL

ON SURFACE - ~~BELOW~~ ON

OFFSET Q PAVEMENT 2.4' LT : ~~RT~~

9.2' TO LT EDGE PAVEMENT


STATION: 213+38

HORZ. DATUM: NAD83(2011)

GEOID: NAVD88 2012A

GRID: NORTHING: 593555.616


EASTING: 1652405.026

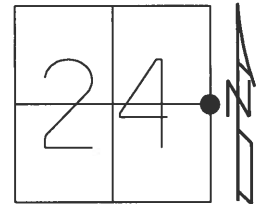

RECORD:
STA. 466+74.5
FD BRASS MON
FD P.K./WASHER
4/12/01, TMR
SET P.K./WASHER
10-31-01, SAH
FD HOLE
REF 7
5-30-18, JFO
FD MAG NAIL
SET BY OTHERS
NEW REF 7
10-1-18, JFO

Q S.B. SR 25

Q N.B. SR 25

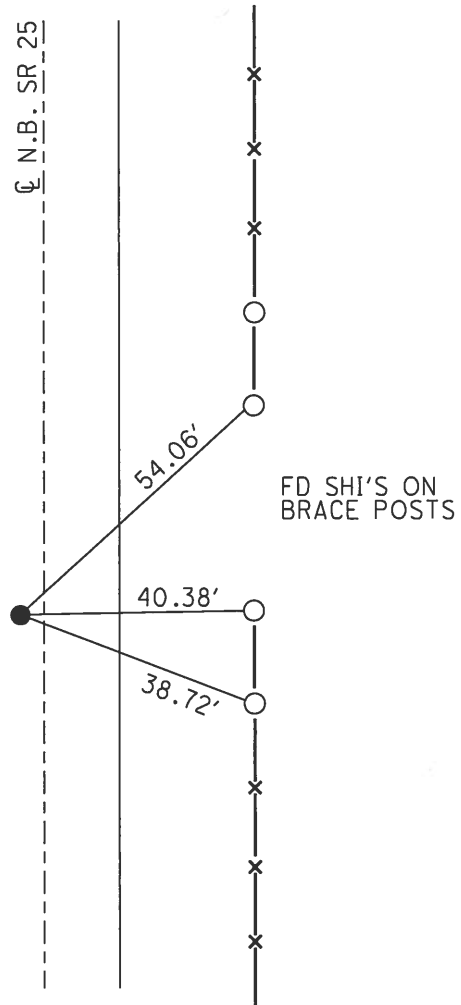

O.D.O.T. DISTRICT 2 SURVEY OFFICE

PERSONNEL

REFERENCE NO. 7

SHEET 10 OF 23

NOTES Huss

H.C. Rousos

R.C. Dan Dugan

DATE 4-12-01

WEATHER Pt. Cldy. Windy

TEMP. 72°F

ROUTE SR 25

COUNTY Wood

TOWNSHIP Liberty

SECTION 24

T 4 N R 10 E


TYPE MONUMENT PK/w

ON SURFACE - ~~BELOW~~ Surface

LEFT - ~~E~~ PAV'T - ~~RIGHT~~ 2.4' Lt.

9.2' TO LT. EDGE PAVEMENT

S.L.M. 213+38

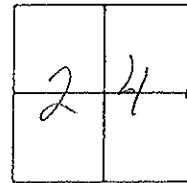

Record:

Brass Mon
Sta 455+74.5

Set PK/WASHER
10-31-01 SAM

E Pav't.
SR 25

W Pav't.
SR 25

Set N/shi
S/O Side
Brace Post

Set N/shi
W side of
both brace
posts

54.06'

40.38'

38.72'

O.D.O.T. DISTRICT 2 SURVEY OFFICE

PERSONNEL

REFERENCE NO. 7

SHEET 10 OF 23

NOTES HOFFMAN

H.C. LOEHKE

R.C. BARNHISEL

DATE 3-26-91

WEATHER OVERCAST

TEMP. 55°

ROUTE SR 25

COUNTY WOOD

TOWNSHIP LIBERTY

SECTION 24

T 4 N R 10 E


TYPE MONUMENT P.K. / WASHER

ON SURFACE - BELOW YES

LEFT-C PAVT. - RIGHT 2.2'

9.2 TO LT. EDGE PAVEMENT

S.L.M. 213+38

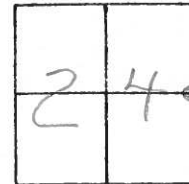

Set P.K. & Washer
6-5-91
MB

RECORD:
BRASS
MON. Sta. 455+74.5

PAVT S.B.L.

SR 25

Fd 11" x 11" Top
N. SIDE of
C.B.

Fd Shi
SW/S

79.04

37.07

71.66

Set Shi
W/S 12"


Fd Shi
NW/S

SR 25

PAVT N.B.L.

County Wood S.R. - U.S. 25Township LibertySection 24

T4N, R10E

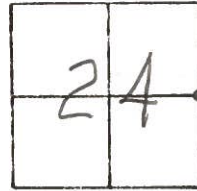Personnel HoffmanHouseholder# 7Date 6-10-81Weather CloudyTemp. +70°

Fd. BRASS MON. @ SURFACE
 2.3' W. of & of N.B. LANES
 14.3' TO E. Edge PAVT.


S.L.M.
 214+07

MON. STA.
 455+74.5 - REC.

SET P.K./WASHER
 11-9-82
 S.W.H.

CUT IN
 C.B.
 26.23
 (P)

SHINER
 SET TOP OF
 BRACE POLE

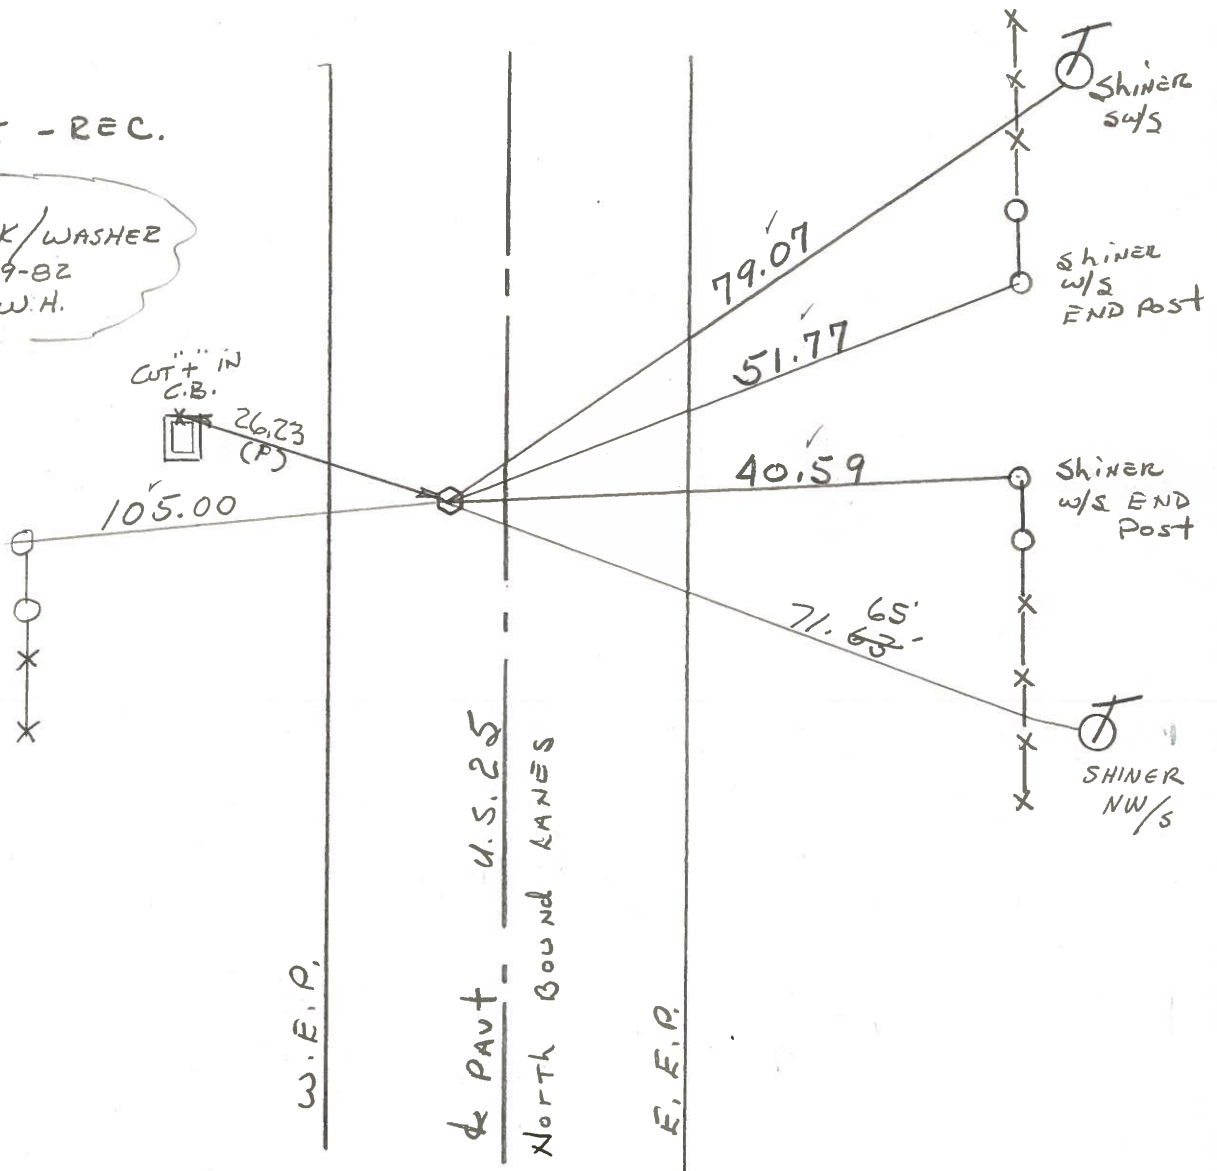

O.D.O.T. DISTRICT 2 SURVEY OFFICE

SHEET

OF

County WOOD ^{U.S.} S.R. 25

Township LIBERTY

Section 24

T4N, R10E

Personnel BURNSIDE


SMITH

BOWERS

Date 7-6-71


Weather CLEAR

Temp. 83°

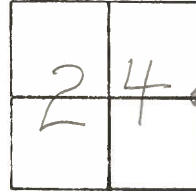

#7

BRASS MON.
STA. 455+74.5

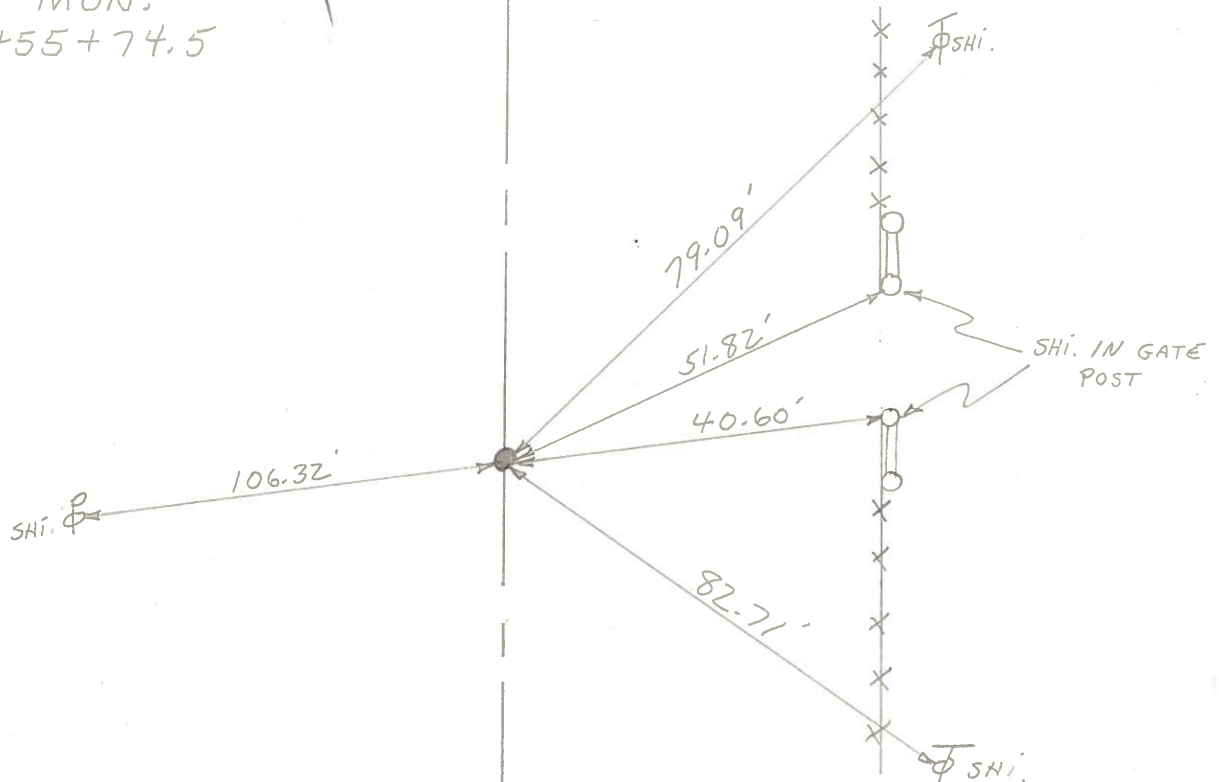

PERSONNEL

TITLE

PERSONNEL

TITLE

COUNTY

Wood

DATE

4-5-60

S. R.

U.S. #25

WEATHER

SEC.

TEMP.

DESCRIPTION

LEFT

CENTER LINE

RIGHT

JOB NO.

22.84 South of Point #234

Sta. 429+39.2

N.W. cor. sec. 30. Br tag
Twp.Brass plate in &
Pavement.

S.R. #281

#233

Shiner in End Post N.E.

64.72

Shiner in P.P. W.S.W.

41.29

Shiner in T.P. N.E. 67.20

66.92

X on E. pt. Hdwl. N.W.

63.88

Conc. F/w mon. S.E. 53.10

52.90

Shiner in End Post S.E.

49.77

Shiner in Twin T. Pole S.S.E.

91.81

Sta. 429+61.95 22.84 North #233

S.E. cor. sec. 24 Liberty

Twp.

Brass plate & of pavement.

ok 12-9-57

S.R. #281

#234

Shiner in t.P. N.E.

50.34

Shiner in P.P. S.W.

49.33

X on E. pt. Hdwl. W.N.W.

51.20

Conc. F/w mon. S.E. 70.20

69.81

Shiner in End Post S.E.

66.15

Shiner in End Post N.E.

48.18

Sta. 455+74.5

E. 1/4 post sec. 24 Liberty

Twp.

Brass plug, top of
plate gone

#235

Shiner in T.P. S.S.E.

79.20

Shiner in T.P. 79.20 N.N.E.

81.41

Shiner in P.P. W.N.W.

77.30

W. edge pavt. 5.9 E. edge pavt. 14.1

51.89

Shiner in End Post N.N.E.

52.10

Shiner in End Post N.E.

40.70

40.63

Sta. 482+71.65

S.E. cor. sec. 13 Liberty

Twp. MERMILL RD.

Brass plate in & pavt.

#236

Shiner in P.P. N.W.

55.20

Shiner in P.P. S.N.E.

73.20

S.E. cor. brick chimney of gas

walnut station N.W. 101.1

Shiner 10' Ash N.N.W.

68.38

Shiner T. Pole S.E.

49.66